

DURABLE 4 INCH WHITE LINE (SEE OPTION ITEMS)
 STA. 146+75 - STA. 151+75 (SOLID LT & RT)

TEMPORARY 4 INCH WHITE LINE, PAINT
 STA. 146+75 - STA. 151+75 (SOLID LT & RT)

6 INCH UNDERDRAIN PIPE
 STA. 146+75 - STA. 147+00-LT
 148+81

DURABLE 4 INCH YELLOW LINE (SEE OPTION ITEMS)
 STA. 146+75 - STA. 151+75 (SOLID LT & RT)

TEMPORARY 4 INCH YELLOW LINE, PAINT
 STA. 146+75 - STA. 151+75 (SOLID LT & RT)



RELOCATE MAILBOX, SINGLE SUPPORT
 STA. 147+27 LT

ENVIRONMENTALLY SENSITIVE LOCATIONS:

NO.	LIMITS	POS.	TYPE
18.	STA. 146+75 - STA. 150+55	LT	-
19.	STA. 149+24 - STA. 151+14	RT	-

BARRIER FENCE
 STA. 146+75 - STA. 150+55 LT
 STA. 149+24 - STA. 151+14 RT

EROSION LOG
 STA. 146+75 - STA. 150+55 LT
 STA. 149+24 - STA. 151+14 RT

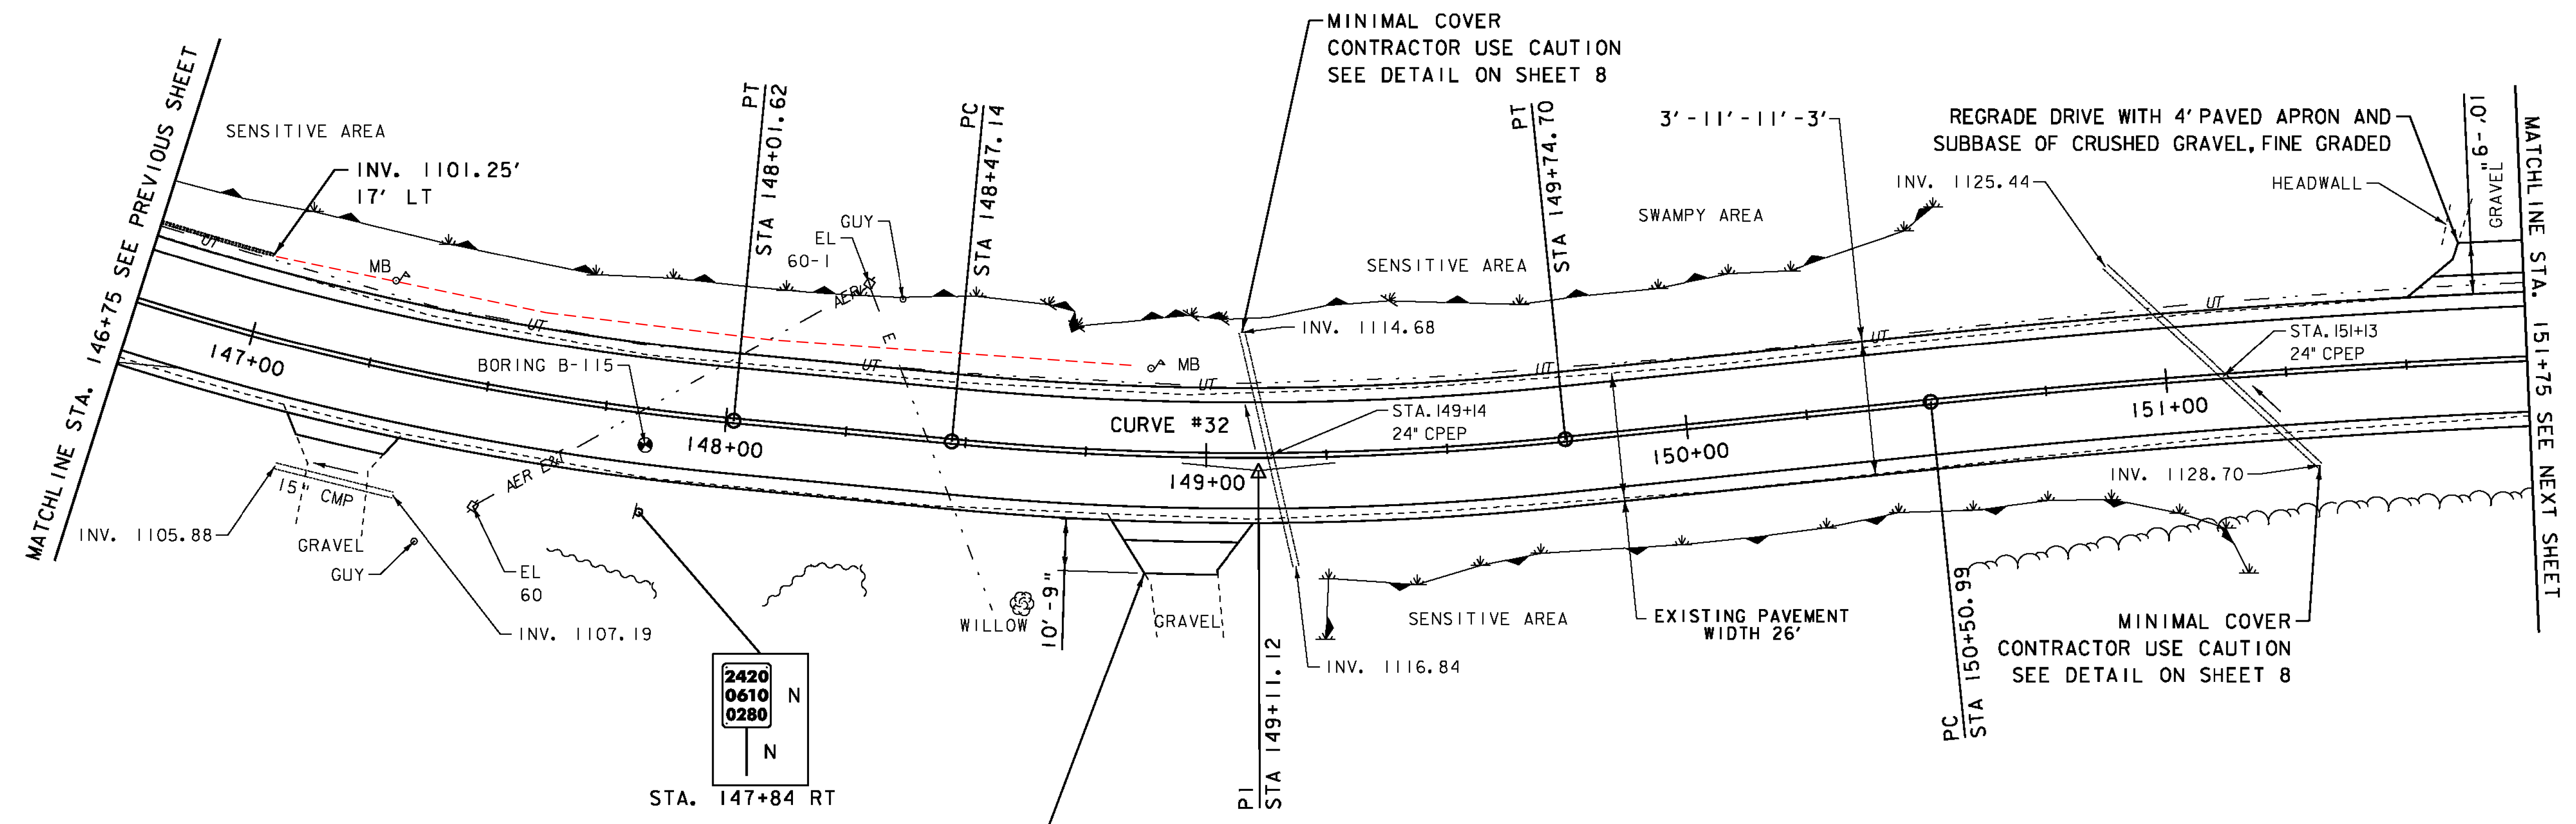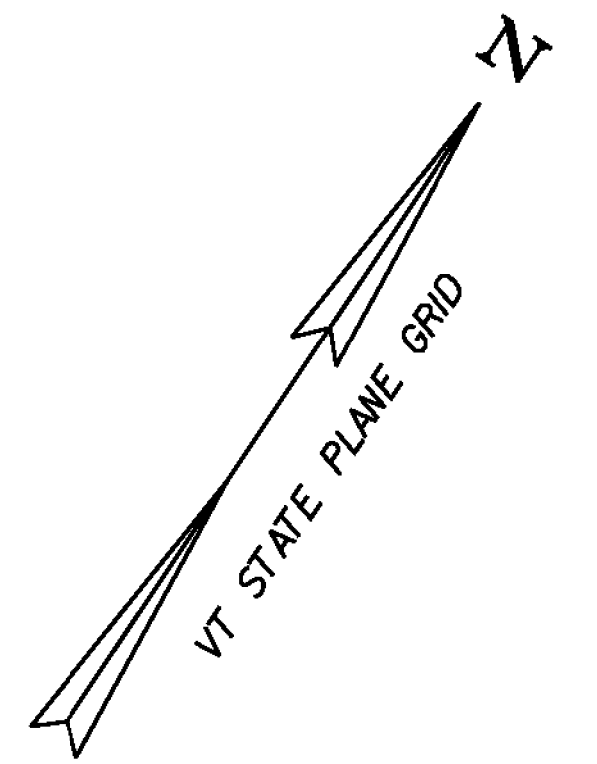

CURVE #32
 DELTA = 11° 14' 40"
 D = 8° 48' 53"
 R = 650.00'
 T = 63.99'
 L = 127.56'
 E = 3.14'
 BANKING 0.080 FT/FT
 DESIGN SPEED 45 MPH
 SEE SUPERELEVATION DIAGRAMS
 FOR BANKING INFORMATION


SIGN LEGEND

- R = REMOVE
- R&S = REMOVE AND SALVAGE
- RET = RETAIN
- S = SALVAGED
- N = NEW
- B-B = BACK TO BACK
- = EXISTING
- = NEW
- = MANHOLE
- ⊙ = WATER SHUT OFF (WSO)
- ⊙ = GAS PIPELINE MARKER
- ⊠ = CATCH BASIN / DROP INLET
- = CURB INLET
- ⊠ = TRAFFIC CONTROL BOX
- ⊕ = PARKING METER
- ⊠ = UTILITY POLE

LEGEND

- = MAILBOX
- ⊙ = BORING
- ⊙ = SIGN
- ⊠ = HYDRANT
- = MANHOLE
- ⊙ = WATER SHUT OFF (WSO)
- ⊙ = GAS PIPELINE MARKER
- ⊠ = CATCH BASIN / DROP INLET
- = CURB INLET
- ⊠ = TRAFFIC CONTROL BOX
- ⊕ = PARKING METER
- ⊠ = UTILITY POLE

DATUM	NAV D 88
	NAD 83

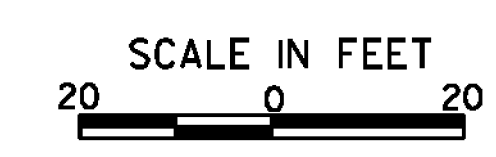

PROJECT LAYOUT SHEET 27	PROJECT NAME: MONTGOMERY-WESTFIELD	PLOT DATE: 9/5/12
	PROJECT NUMBER: STP 2906(I)	DRAWN BY: SJL
	FILE NAME: p10CI90.dgn	CHECKED BY: EPD
	DESIGNED BY: SJL	SHEET 48 OF 178
	PLOT FILE: p10CI90_48.I	

SEH
2-25-14