

DURABLE 4 INCH WHITE LINE (SEE OPTION ITEMS)
 STA. 168+75 - STA. 174+25 (SOLID LT & RT)

TEMPORARY 4 INCH WHITE LINE, PAINT
 STA. 168+75 - STA. 174+25 (SOLID LT & RT)

6 INCH UNDERDRAIN PIPE
 STA. ~~170+00~~ - STA. ~~172+50~~ RT
 170+72 174+25

DURABLE 4 INCH YELLOW LINE (SEE OPTION ITEMS)
 STA. 168+75 - STA. 174+25 (SOLID LT & RT)

TEMPORARY 4 INCH YELLOW LINE, PAINT
 STA. 168+75 - STA. 174+25 (SOLID LT & RT)

RELOCATE MAILBOX, SINGLE SUPPORT
 STA. 172+56 LT
 STA. 172+58 LT


BARRIER FENCE
 STA. 172+97 - STA. 174+25 LT

EROSION LOG
 STA. 172+97 - STA. 174+25 LT

ENVIRONMENTALLY SENSITIVE LOCATIONS:

NO.	LIMITS	POS.	TYPE
20.	STA. 172+97 - STA. 174+25	LT	-


CURVE #37
 DELTA = 3°20'44"
 D = 1°08'45"
 R = 5000.00'
 T = 146.02'
 L = 291.96'
 E = 2.13'
 BANKING 0.024 FT/FT
 DESIGN SPEED 50 MPH
 SEE SUPERELEVATION DIAGRAMS
 FOR BANKING INFORMATION

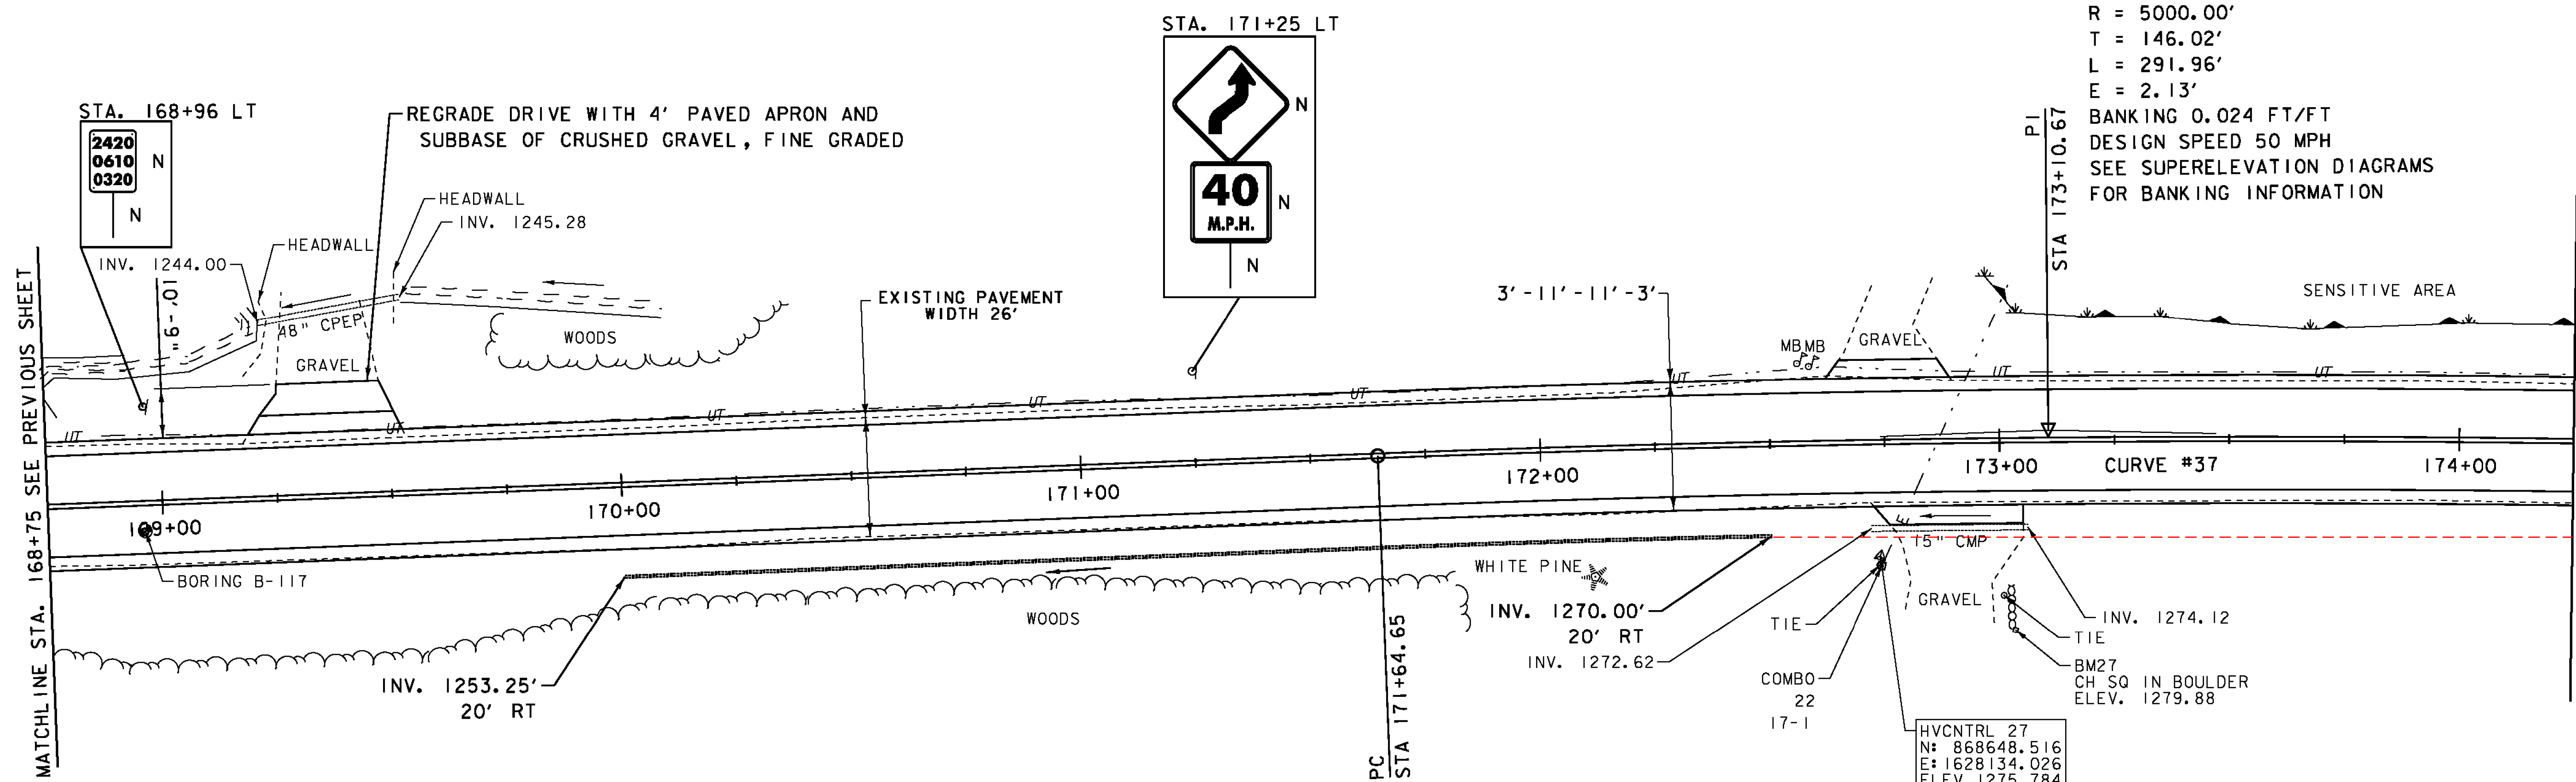

- LEGEND**
- MAILBOX
 - BORING
 - SIGN
 - HYDRANT
 - MANHOLE
 - WATER SHUT OFF (WSO)
 - GAS PIPELINE MARKER
 - CATCH BASIN / DROP INLET
 - CURB INLET
 - TRAFFIC CONTROL BOX
 - PARKING METER
 - UTILITY POLE

- SIGN LEGEND**
- R = REMOVE
 - R&S = REMOVE AND SALVAGE
 - RET = RETAIN
 - S = SALVAGED
 - N = NEW
 - B-B = BACK TO BACK
 - = EXISTING
 - = NEW

DATUM
 VERTICAL NAVD 88
 HORIZONTAL NAD 83

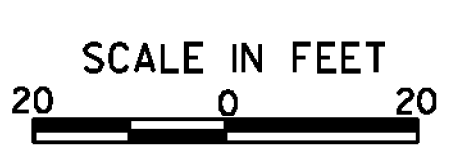

PROJECT LAYOUT SHEET 31	PROJECT NAME: MONTGOMERY-WESTFIELD
	PROJECT NUMBER: STP 2906(I)
	FILE NAME: pIOC190.dgn
	PLOT DATE: 9/5/12
PROJECT LEADER: CDL	DRAWN BY: SJL
DESIGNED BY: SJL	CHECKED BY: EPD
PLOT FILE: pIOC190_52.I	SHEET 52 OF 178

SEH
 2-25-14