

DURABLE 4 INCH WHITE LINE (SEE OPTION ITEMS)
 STA. 179+75 - STA. 185+50 (SOLID LT & RT)

DURABLE 4 INCH YELLOW LINE (SEE OPTION ITEMS)
 STA. 179+75 - STA. 185+25 (SOLID LT, DASHED RT)
 STA. 185+25 - STA. 185+50 (SOLID LT & RT)

STONE FILL, TYPE I
 STA. 183+52 - STA. 183+80 RT

GRUBBING MATERIAL
 STA. 183+52 - STA. 183+80 RT

GEOTEXTILE UNDER STONE FILL
 STA. 183+52 - STA. 183+80 RT

GEOTEXTILE FOR SILT FENCE
 STA. 183+52 - STA. 183+80 RT

TEMPORARY 4 INCH WHITE LINE, PAINT
 STA. 179+75 - STA. 185+50 (SOLID LT & RT)

TEMPORARY 4 INCH YELLOW LINE, PAINT
 STA. 179+75 - STA. 185+25 (SOLID LT, DASHED RT)
 STA. 185+25 - STA. 185+50 (SOLID LT & RT)

REMOVING SIGNS
 AS SHOWN - 2

BARRIER FENCE
 STA. 180+46 - STA. 185+50 RT
 STA. 183+64 - STA. 185+06 LT

EROSION LOG
 STA. 180+46 - STA. 185+50 RT
 STA. 183+64 - STA. 185+06 LT

CURVE #40
 DELTA = 1°37'52"
 D = 1°08'45"
 R = 5000.00'
 T = 71.18'
 L = 142.35'
 E = 0.51'
 BANKING 0.024 FT/FT
 DESIGN SPEED 50 MPH
 SEE SUPERELEVATION DIAGRAMS
 FOR BANKING INFORMATION

ENVIRONMENTALLY SENSITIVE LOCATIONS:

NO.	LIMITS	POS.	TYPE
21.	STA. 180+46 - STA. 185+50	RT	-
22.	STA. 183+64 - STA. 185+06	LT	-

CURVE #39
 DELTA = 1°43'12"
 D = 1°08'45"
 R = 5000.00'
 T = 75.06'
 L = 150.11'
 E = 0.56'
 BANKING 0.024 FT/FT
 DESIGN SPEED 50 MPH
 SEE SUPERELEVATION DIAGRAMS
 FOR BANKING INFORMATION

HVCNTRL 28
 N: 868918.061
 E: 1629132.923
 ELEV. 1302.828

REGRADE DRIVE WITH 4' PAVED APRON AND
 SUBBASE OF CRUSHED GRAVEL, FINE GRADED

SENSITIVE AREA

SWAMPY AREA

GRAVEL

10' - 9"

INV. 1301.36

STA. 183+64
 18" CPEP

PI
 STA 185+14.03

CURVE #40

INV. 1299.63

ELM

CAULT

SENSITIVE AREA

WOODS

SENSITIVE AREA

3' - 11' - 11' - 3'

EXISTING PAVEMENT
 WIDTH 26'

WOODS

POPLAR

TIE

TIE

POPLAR

BM28
 RRS1R M. POP
 ELEV. 1300.72



STA. 183+02 RT


SIGN LEGEND

- R = REMOVE
- R&S = REMOVE AND SALVAGE
- RET = RETAIN
- S = SALVAGED
- N = NEW
- B-B = BACK TO BACK
- = EXISTING
- = NEW

LEGEND

- | | | | | |
|---------|---|--------------------------|---|---------------------|
| MAILBOX | ○ | MANHOLE | — | CURB INLET |
| BORING | ⊙ | WATER SHUT OFF (WSO) | ⊗ | TRAFFIC CONTROL BOX |
| SIGN | ⊙ | GAS PIPELINE MARKER | ⊕ | PARKING METER |
| HYDRANT | ⊠ | CATCH BASIN / DROP INLET | ⊞ | UTILITY POLE |

DATUM
 NAVD 88
 NAD 83

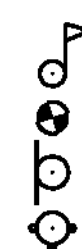

SCALE IN FEET
 20 0 20

PROJECT LAYOUT SHEET 33

PROJECT NAME: MONTGOMERY-WESTFIELD
 PROJECT NUMBER: STP 2906(I)

FILE NAME: p10ci90.dgn
 PROJECT LEADER: CDL
 DESIGNED BY: SJL
 PLOT FILE: p10ci90_54.1

PLOT DATE: 9/5/12
 DRAWN BY: SJL
 CHECKED BY: EPD
 SHEET 54 OF 178

MATCHLINE STA. 179+75 SEE PREVIOUS SHEET

MATCHLINE STA. 185+50 SEE NEXT SHEET