

DURABLE 4 INCH WHITE LINE (SEE OPTION ITEMS)
 STA. A 0+75 - STA. A 6+75 (SOLID LT & RT)

TEMPORARY 4 INCH WHITE LINE, PAINT
 STA. A 0+75 - STA. A 6+75 (SOLID LT & RT)

DURABLE 4 INCH YELLOW LINE (SEE OPTION ITEMS)
 STA. A 0+75 - STA. A 6+75 (SOLID LT & RT)

TEMPORARY 4 INCH YELLOW LINE, PAINT
 STA. A 0+75 - STA. A 6+75 (SOLID LT & RT)


6 INCH UNDERDRAIN PIPE
 STA. A 0+75 - STA. A 3+50 RT

STONE FILL, TYPE 1
 STA. A 3+95 - STA. A 5+40 LT


GRUBBING MATERIAL
 STA. A 3+95 - STA. A 5+40 LT

GEOTEXTILE UNDER STONE FILL
 STA. A 3+95 - STA. A 5+40 LT

GEOTEXTILE FOR SILT FENCE
 STA. A 3+95 - STA. A 5+40 LT

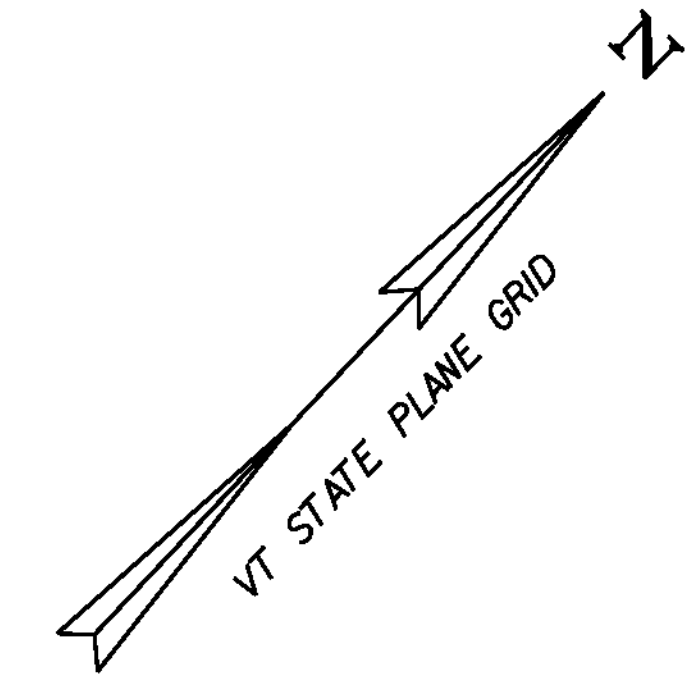

CURVE #42/#1
 DELTA = 8°47'22"
 D = 1°59'34"
 R = 2875.00'
 T = 220.95'
 L = 441.04'
 E = 8.48'
 BANKING 0.038 FT/FT
 DESIGN SPEED 50 MPH
 SEE SUPERELEVATION DIAGRAMS
 FOR BANKING INFORMATION

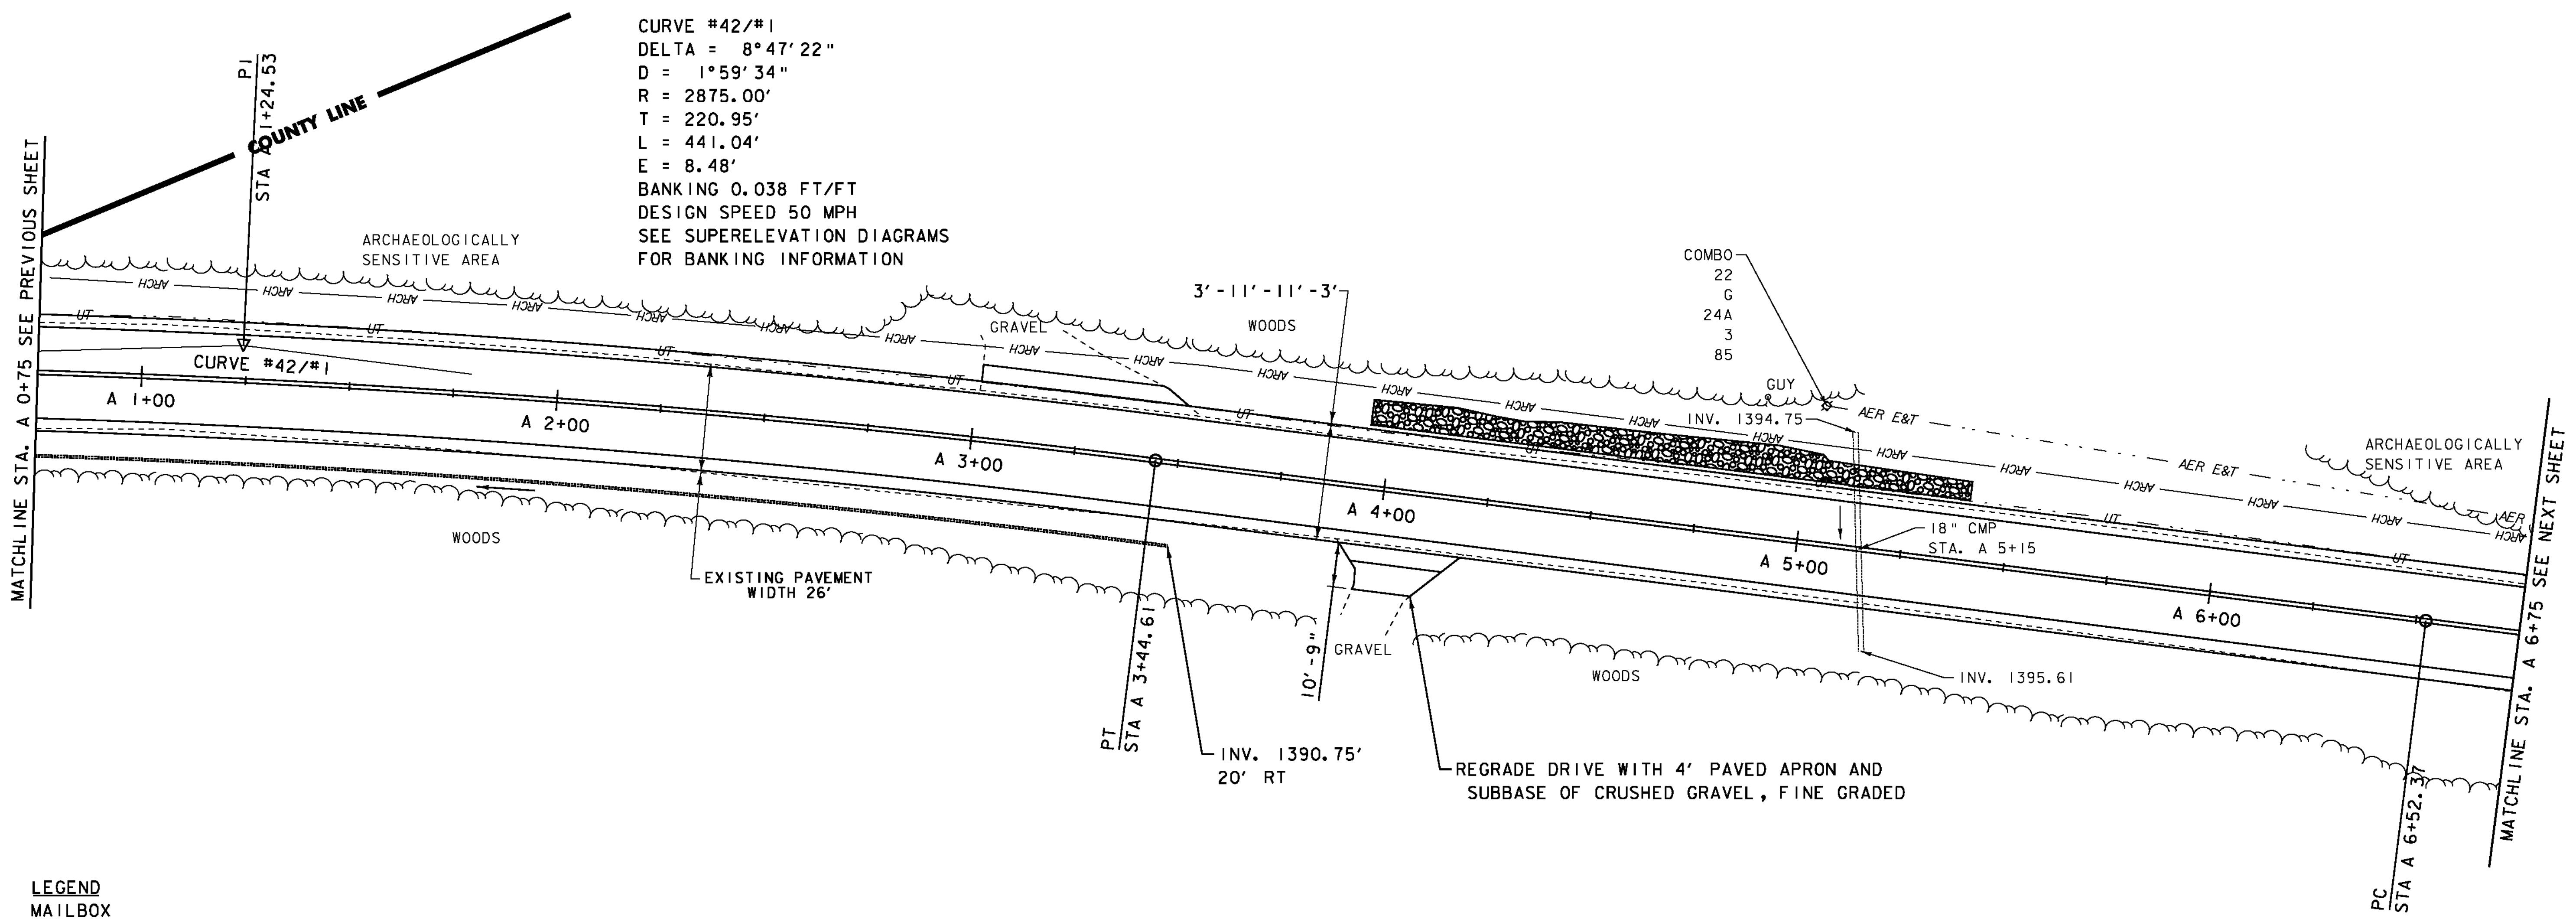

- LEGEND**
- MAILBOX
 - BORING
 - SIGN
 - HYDRANT
 - MANHOLE
 - WATER SHUT OFF (WSO)
 - GAS PIPELINE MARKER
 - CATCH BASIN / DROP INLET
 - CURB INLET
 - TRAFFIC CONTROL BOX
 - PARKING METER
 - UTILITY POLE

- SIGN LEGEND**
- R = REMOVE
 - R&S = REMOVE AND SALVAGE
 - RET = RETAIN
 - S = SALVAGED
 - N = NEW
 - B-B = BACK TO BACK
 - = EXISTING
 - = NEW

DATUM
 VERTICAL NAVD 88
 HORIZONTAL NAD 83



PROJECT LAYOUT SHEET 37	PROJECT NAME: MONTGOMERY-WESTFIELD	PLOT DATE: 9/5/12
	PROJECT NUMBER: STP 2906(I)	DRAWN BY: SJL
	FILE NAME: p10ci90.dgn	CHECKED BY: EPD
	DESIGNED BY: SJL	SHEET 58 OF 178
	PLOT FILE: p10ci90_58.i	