

DURABLE 4 INCH WHITE LINE (SEE OPTION ITEMS)  
 STA. A 23+25 - STA. A 29+25 (SOLID LT & RT)

TEMPORARY 4 INCH WHITE LINE, PAINT  
 STA. A 23+25 - STA. A 29+25 (SOLID LT & RT)


6 INCH UNDERDRAIN PIPE  
 STA. A ~~24+50~~ - STA. A ~~26+50~~ LT  
 25+00 27+70

DURABLE 4 INCH YELLOW LINE (SEE OPTION ITEMS)  
 STA. A 23+25 - STA. A 23+50 (SOLID LT & RT)  
 STA. A 23+50 - STA. A 29+25 (DASHED LT, SOLID RT)

TEMPORARY 4 INCH YELLOW LINE, PAINT  
 STA. A 23+25 - STA. A 23+50 (SOLID LT & RT)  
 STA. A 23+50 - STA. A 29+25 (DASHED LT, SOLID RT)


BARRIER FENCE  
 STA. A 23+25 - STA. A 28+46 LT  
 STA. A 23+36 - STA. A 26+10 RT

EROSION LOG  
 STA. A 23+25 - STA. A 28+46 LT  
 STA. A 23+36 - STA. A 26+10 RT

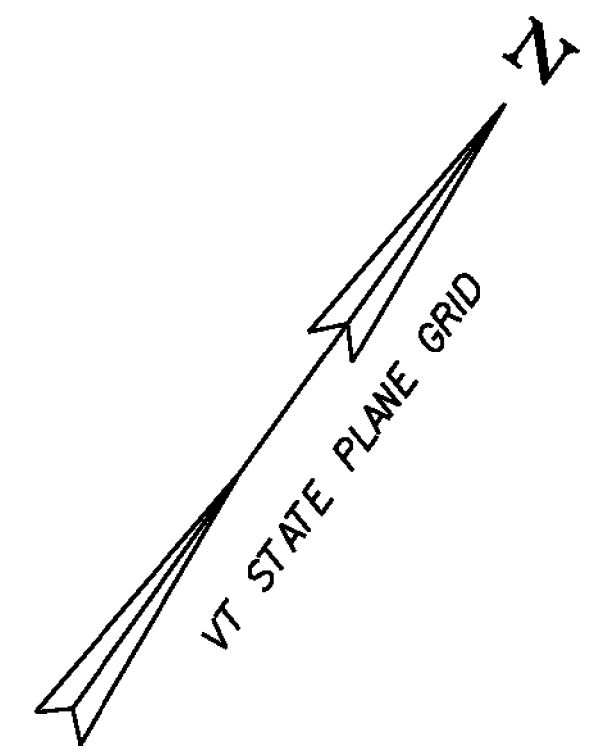

**ENVIRONMENTALLY SENSITIVE LOCATIONS:**

NO.	LIMITS	POS.	TYPE
24.	STA. A 23+25 - STA. A 28+46	LT	-
25.	STA. A 23+36 - STA. A 26+10	RT	-

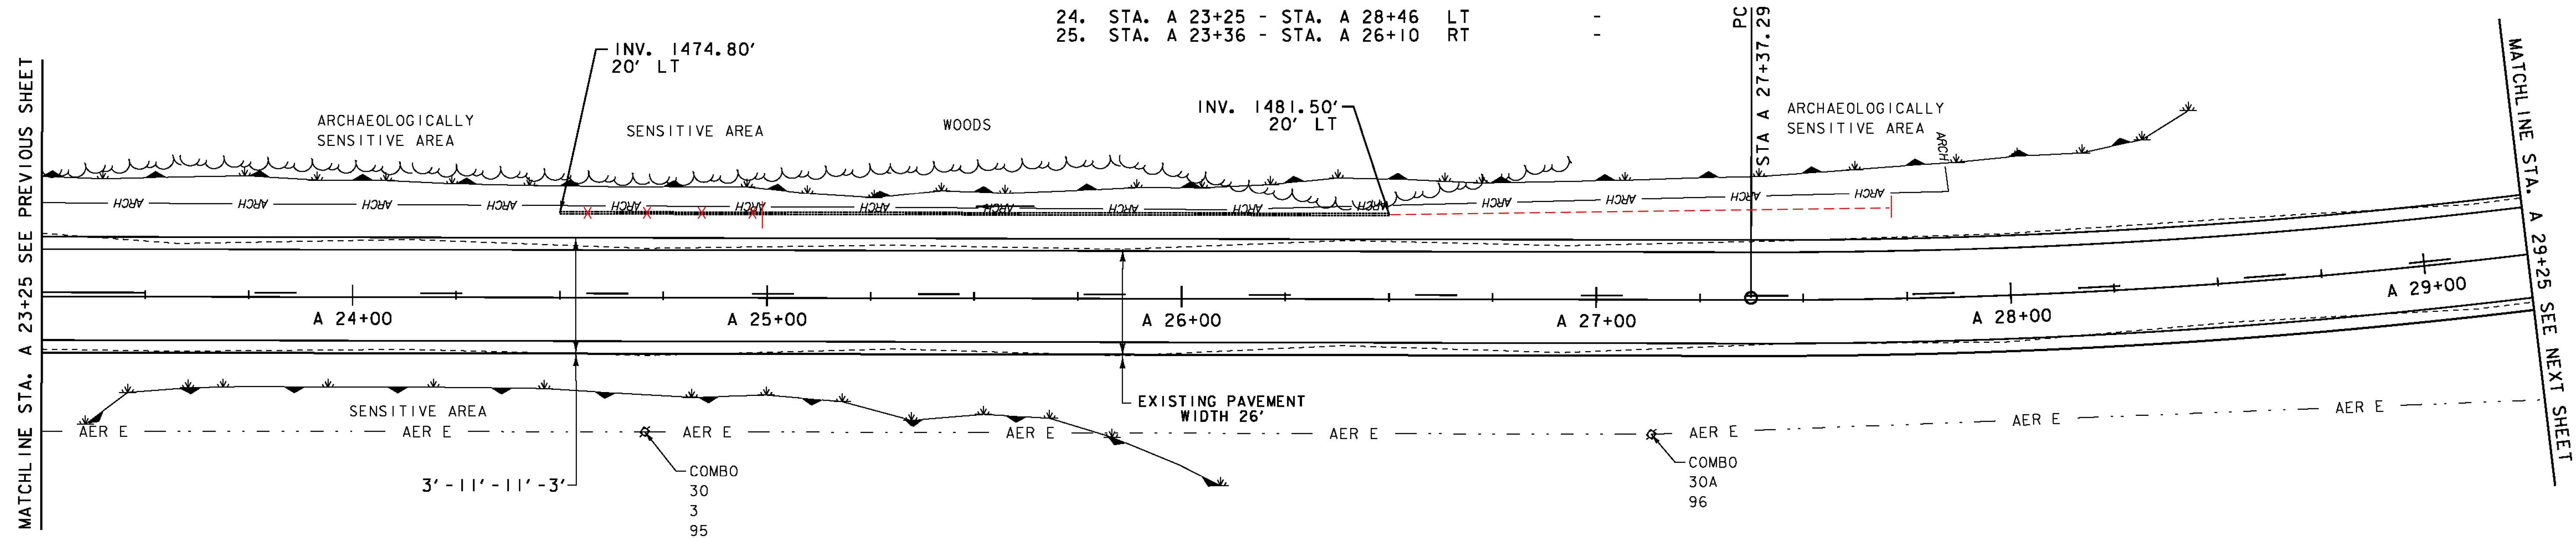

**LEGEND**

- MAILBOX
- BORING
- SIGN
- HYDRANT
- MANHOLE
- WATER SHUT OFF (WSO)
- GAS PIPELINE MARKER
- CATCH BASIN / DROP INLET
- CURB INLET
- TRAFFIC CONTROL BOX
- PARKING METER
- UTILITY POLE

**SIGN LEGEND**

- R = REMOVE
- R&S = REMOVE AND SALVAGE
- RET = RETAIN
- S = SALVAGED
- N = NEW
- B-B = BACK TO BACK
- = EXISTING
- = NEW

DATUM  
 NAVD 88  
 NAD 83



**PROJECT LAYOUT SHEET 41**

PROJECT NAME: MONTGOMERY-WESTFIELD  
 PROJECT NUMBER: STP 2906(I)

FILE NAME: pIOC190.dgn  
 PROJECT LEADER: CDL  
 DESIGNED BY: SJL  
 PLOT FILE: pIOC190\_62.1

PLOT DATE: 9/5/12  
 DRAWN BY: SJL  
 CHECKED BY: EPD  
 SHEET 62 OF 178

SEH  
 2-25-14