

DURABLE 4 INCH WHITE LINE (SEE OPTION ITEMS)
 STA. A 29+25 - STA. A 34+75 (SOLID LT & RT)



TEMPORARY 4 INCH WHITE LINE, PAINT
 STA. A 29+25 - STA. A 34+75 (SOLID LT & RT)

6 INCH UNDERDRAIN PIPE
 STA. A ~~31+00~~ - STA. A 34+75 LT
 30+76

DURABLE 4 INCH YELLOW LINE (SEE OPTION ITEMS)
 STA. A 29+25 - STA. A 30+00 (DASHED LT, SOLID RT)
 STA. A 30+00 - STA. A 30+75 (SOLID LT & RT)
 STA. A 30+75 - STA. A 34+75 (SOLID LT, DASHED RT)

TEMPORARY 4 INCH YELLOW LINE, PAINT
 STA. A 29+25 - STA. A 30+00 (DASHED LT, SOLID RT)
 STA. A 30+00 - STA. A 30+75 (SOLID LT & RT)
 STA. A 30+75 - STA. A 34+75 (SOLID LT, DASHED RT)

REMOVING SIGNS
 AS SHOWN - 1

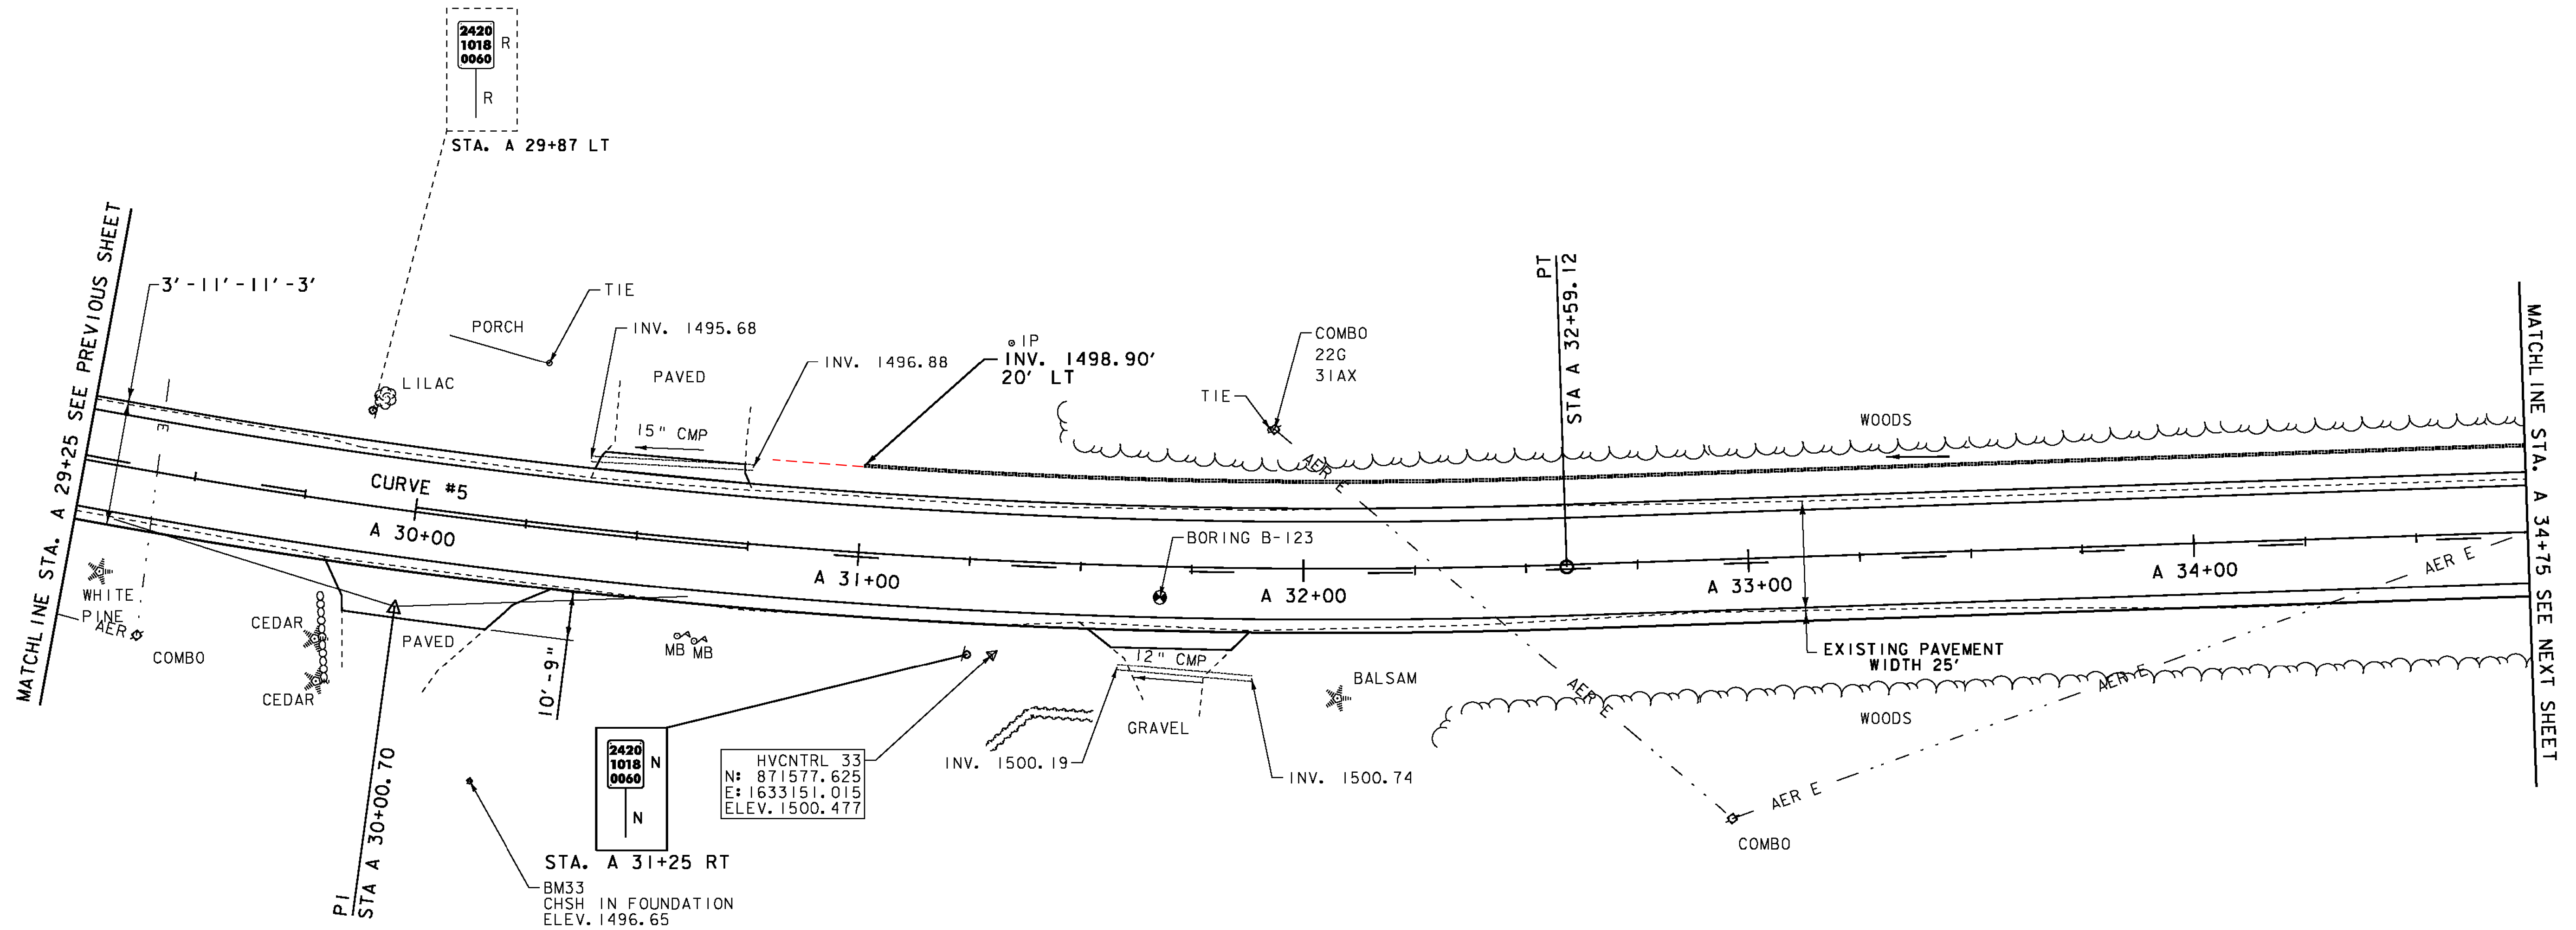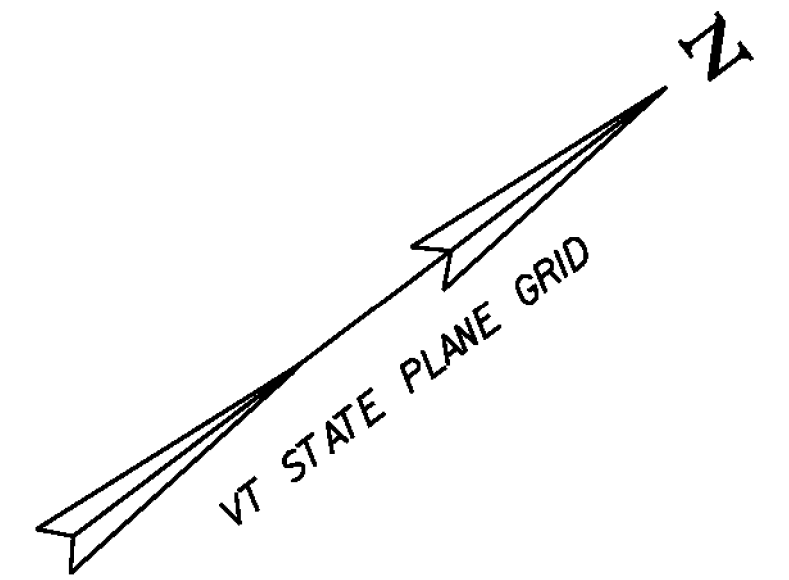

- LEGEND**
- MAILBOX
 - BORING
 - SIGN
 - HYDRANT
 - MANHOLE
 - WATER SHUT OFF (WSO)
 - GAS PIPELINE MARKER
 - CATCH BASIN / DROP INLET
 - CURB INLET
 - TRAFFIC CONTROL BOX
 - PARKING METER
 - UTILITY POLE

- SIGN LEGEND**
- R = REMOVE
 - R&S = REMOVE AND SALVAGE
 - RET = RETAIN
 - S = SALVAGED
 - N = NEW
 - B-B = BACK TO BACK
 - = EXISTING
 - = NEW

CURVE #5
 DELTA = 19° 17' 21"
 D = 3° 41' 47"
 R = 1550.00'
 T = 263.40'
 L = 521.82'
 E = 22.22'
 BANKING 0.060 FT/FT
 DESIGN SPEED 50 MPH
 SEE SUPERELEVATION DIAGRAMS
 FOR BANKING INFORMATION

DATUM
 NAVD 88
 NAD 83



PROJECT LAYOUT SHEET 42

PROJECT NAME: MONTGOMERY-WESTFIELD	PLOT DATE: 9/5/12
PROJECT NUMBER: STP 2906(I)	DRAWN BY: SJL
FILE NAME: piOC190.dgn	CHECKED BY: EPD
DESIGNED BY: SJL	SHEET 63 OF 178
PLOT FILE: piOC190_63.1	

HVCNTRL 100
 N: 871796.133
 E: 1633426.010
 ELEV. 1522.464

SEH
 2-25-14