

DURABLE 4 INCH WHITE LINE (SEE OPTION ITEMS)
 STA. A 40+25 - STA. A 45+75 (SOLID LT & RT)

DURABLE 4 INCH YELLOW LINE (SEE OPTION ITEMS)
 STA. A 40+25 - STA. A 45+75 (DASHED LT, SOLID RT)

TEMPORARY 4 INCH WHITE LINE, PAINT
 STA. A 40+25 - STA. A 45+75 (SOLID LT & RT)

TEMPORARY 4 INCH YELLOW LINE, PAINT
 STA. A 40+25 - STA. A 45+75 (DASHED LT, SOLID RT)

GEOTEXTILE FOR SILT FENCE
 STA. A 40+25 - STA. A 41+25 RT
 STA. A 41+25 - STA. A 42+50 LT



REMOVING SIGNS
 AS SHOWN - 1

6 INCH UNDERDRAIN PIPE
 STA. A ~~44+50~~ - STA. A 45+75 LT
 43+45

STONE FILL, TYPE I
 STA. A 40+25 - STA. A 41+25 RT
 STA. A 41+25 - STA. A 42+50 LT

GRUBBING MATERIAL
 STA. A 40+25 - STA. A 41+25 RT
 STA. A 41+25 - STA. A 42+50 LT

GEOTEXTILE UNDER STONE FILL
 STA. A 40+25 - STA. A 41+25 RT
 STA. A 41+25 - STA. A 42+50 LT

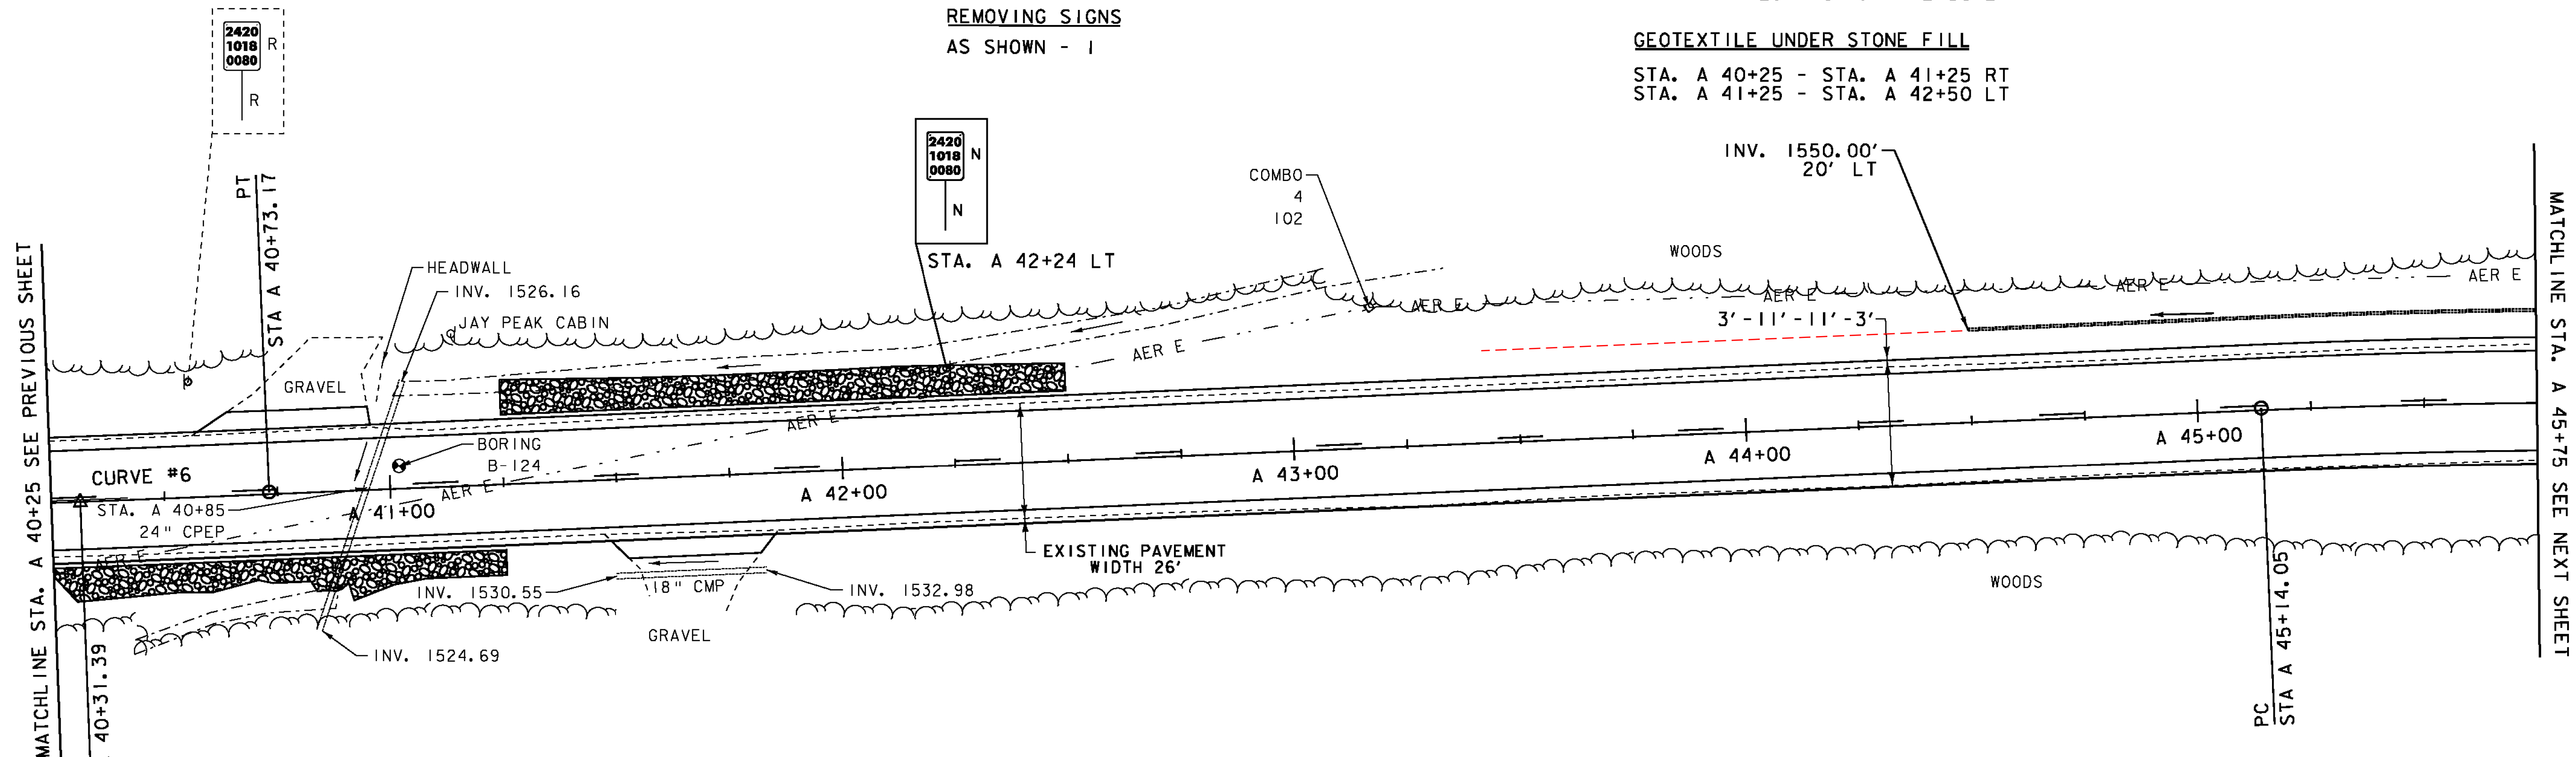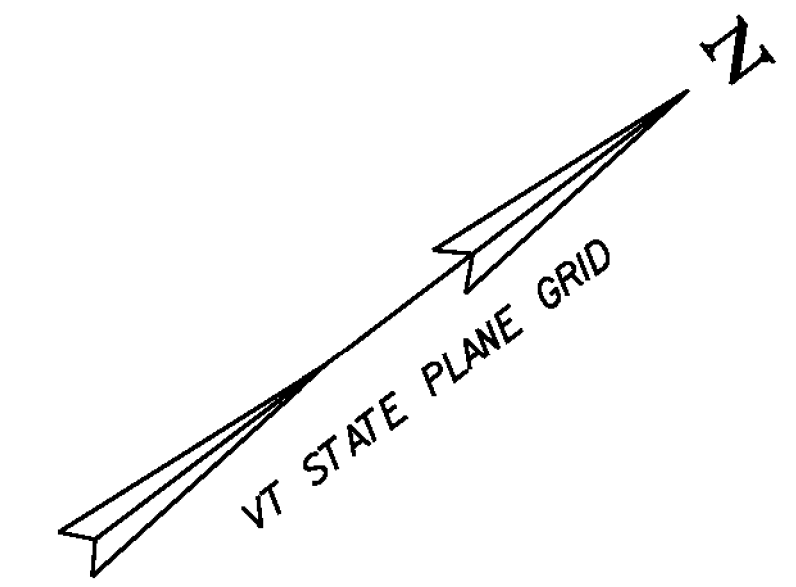


CURVE #6
 DELTA = 0°28'43"
 D = 0°34'23"
 R = 10000.00'
 T = 41.78'
 L = 83.55'
 E = 0.09'
 BANKING NORMAL CROWN
 DESIGN SPEED 50 MPH
 SEE SUPERELEVATION DIAGRAMS
 FOR BANKING INFORMATION

- LEGEND**
- MAILBOX
 - BORING
 - SIGN
 - HYDRANT
 - MANHOLE
 - WATER SHUT OFF (WSO)
 - GAS PIPELINE MARKER
 - CATCH BASIN / DROP INLET
 - CURB INLET
 - ⊠ TRAFFIC CONTROL BOX
 - ⊕ PARKING METER
 - ⊖ UTILITY POLE

- SIGN LEGEND**
- R = REMOVE
 - R&S = REMOVE AND SALVAGE
 - RET = RETAIN
 - S = SALVAGED
 - N = NEW
 - B-B = BACK TO BACK
 - = EXISTING
 - = NEW

DATUM
 VERTICAL NAVD 88
 HORIZONTAL NAD 83

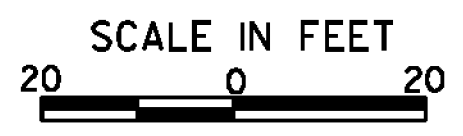

PROJECT LAYOUT SHEET 44	PROJECT NAME: MONTGOMERY-WESTFIELD	PLOT DATE: 9/5/12
	PROJECT NUMBER: STP 2906(I)	DRAWN BY: SJL
	FILE NAME: p10CI90.dgn	CHECKED BY: EPD
	DESIGNED BY: SJL	SHEET 65 OF 178
	PLOT FILE: p10CI90_65.I	

SEH
2-25-14