

DURABLE 4 INCH WHITE LINE (SEE OPTION ITEMS)
 STA. A 45+75 - STA. A 51+25 (SOLID LT & RT)

TEMPORARY 4 INCH WHITE LINE, PAINT
 STA. A 45+75 - STA. A 51+25 (SOLID LT & RT)

6 INCH UNDERDRAIN PIPE
 STA. A 45+75 - STA. A ~~46+00~~⁴⁶⁺⁶⁵ LT
 STA. A 47+50²⁸ - STA. A 51+00⁰⁸ LT

STONE FILL, TYPE I
 STA. A 46+70 - STA. A 47+30 RT
 STA. A 47+00 - STA. A 47+25 LT

DURABLE 4 INCH YELLOW LINE (SEE OPTION ITEMS)
 STA. A 45+75 - STA. A 47+00 (DASHED LT, SOLID RT)
 STA. A 47+00 - STA. A 51+25 (SOLID LT & RT)

TEMPORARY 4 INCH YELLOW LINE, PAINT
 STA. A 45+75 - STA. A 47+00 (DASHED LT, SOLID RT)
 STA. A 47+00 - STA. A 51+25 (SOLID LT & RT)

BARRIER FENCE
 STA. A 23+25 - STA. A 28+46 LT
 STA. A 23+36 - STA. A 26+10 RT

GRUBBING MATERIAL
 STA. A 46+70 - STA. A 47+30 RT
 STA. A 47+00 - STA. A 47+25 LT

EROSION LOG
 STA. A 23+25 - STA. A 28+46 LT
 STA. A 23+36 - STA. A 26+10 RT


GEOTEXTILE UNDER STONE FILL
 STA. A 49+28 - STA. A 50+45 RT
 STA. A 49+36 - STA. A 51+25 LT

GEOTEXTILE FOR SILT FENCE
 STA. A 49+28 - STA. A 50+45 RT
 STA. A 49+36 - STA. A 51+25 LT

CURVE #7
 DELTA = 18° 15' 08"
 D = 2° 56' 18"
 R = 1950.00'
 T = 313.25'
 L = 621.19'
 E = 25.00'
 BANKING 0.052 FT/FT
 DESIGN SPEED 50 MPH
 SEE SUPERELEVATION DIAGRAMS
 FOR BANKING INFORMATION

ENVIRONMENTALLY SENSITIVE LOCATIONS:

NO.	LIMITS	POS.	TYPE
26.	STA. A 49+28 - STA. A 50+45	RT	-
27.	STA. A 49+36 - STA. A 51+25	LT	-

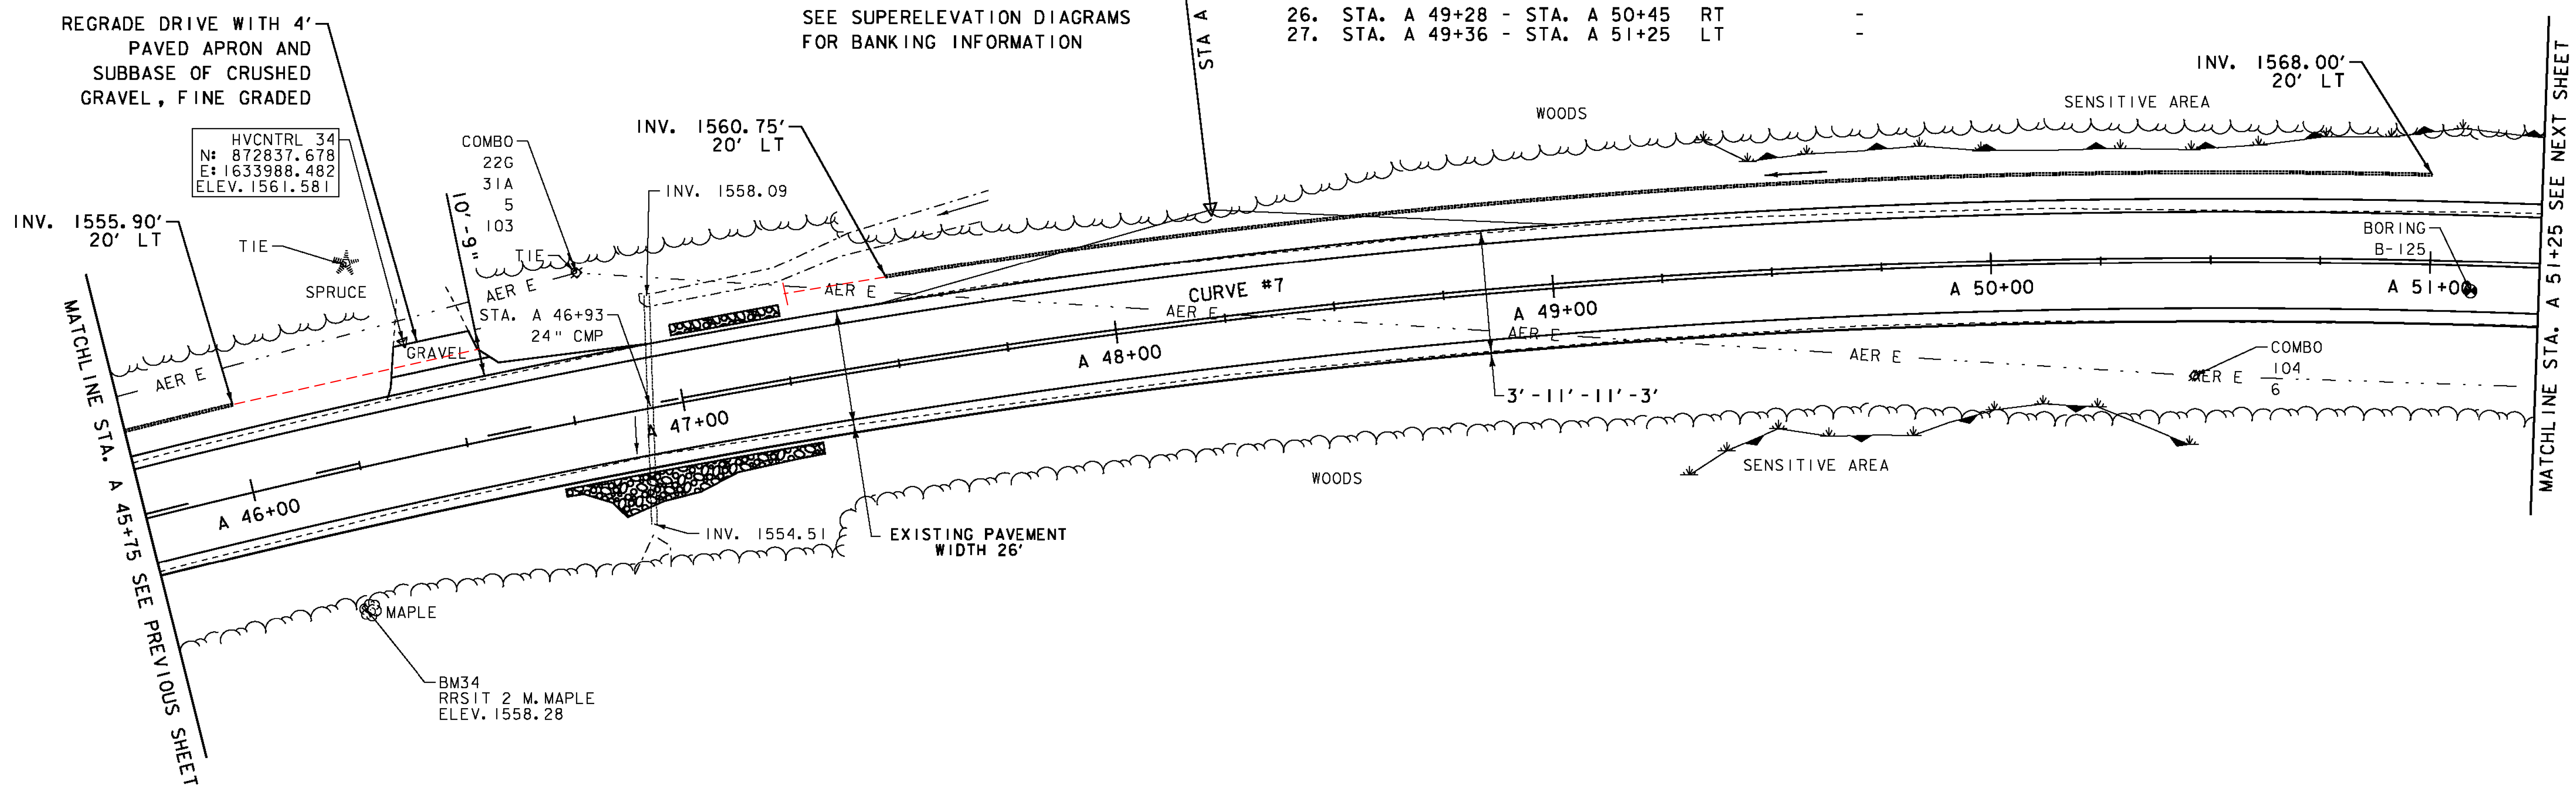

DATUM


NAVD 88
NAD 83

LEGEND

○	MAILBOX	○	MANHOLE	-	CURB INLET
○	BORING	○	WATER SHUT OFF (WSO)	⊠	TRAFFIC CONTROL BOX
○	SIGN	○	GAS PIPELINE MARKER	⊕	PARKING METER
○	HYDRANT	⊠	CATCH BASIN / DROP INLET	⊞	UTILITY POLE

SIGN LEGEND

R	= REMOVE
R&S	= REMOVE AND SALVAGE
RET	= RETAIN
S	= SALVAGED
N	= NEW
B-B	= BACK TO BACK
---	= EXISTING
---	= NEW

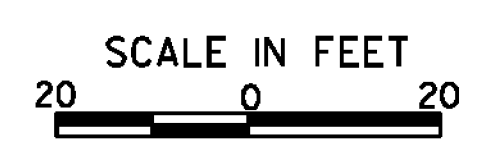

PROJECT LAYOUT SHEET 45	PROJECT NAME: MONTGOMERY-WESTFIELD	PLOT DATE: 9/5/12
	PROJECT NUMBER: STP 2906(I)	DRAWN BY: SJL
	FILE NAME: p10C190.dgn	CHECKED BY: EPD
	PROJECT LEADER: CDL	SHEET 66 OF 178

SEH
2-25-14