

**DURABLE 4 INCH WHITE LINE (SEE OPTION ITEMS)**  
 STA. A 45+75 - STA. A 51+25 (SOLID LT & RT)

**TEMPORARY 4 INCH WHITE LINE, PAINT**  
 STA. A 45+75 - STA. A 51+25 (SOLID LT & RT)

**6 INCH UNDERDRAIN PIPE**  
 STA. A 45+75 - STA. A 46+00 LT  
 STA. A 47+50 - STA. A 51+00 LT

**STONE FILL, TYPE I**  
 STA. A 46+70 - STA. A 47+30 RT  
 STA. A 47+00 - STA. A 47+25 LT

**DURABLE 4 INCH YELLOW LINE (SEE OPTION ITEMS)**  
 STA. A 45+75 - STA. A 47+00 (DASHED LT, SOLID RT)  
 STA. A 47+00 - STA. A 51+25 (SOLID LT & RT)

**TEMPORARY 4 INCH YELLOW LINE, PAINT**  
 STA. A 45+75 - STA. A 47+00 (DASHED LT, SOLID RT)  
 STA. A 47+00 - STA. A 51+25 (SOLID LT & RT)

**BARRIER FENCE**  
 STA. A 23+25 - STA. A 28+46 LT  
 STA. A 23+36 - STA. A 26+10 RT

**GRUBBING MATERIAL**  
 STA. A 46+70 - STA. A 47+30 RT  
 STA. A 47+00 - STA. A 47+25 LT

**EROSION LOG**  
 STA. A 23+25 - STA. A 28+46 LT  
 STA. A 23+36 - STA. A 26+10 RT



**GEOTEXTILE UNDER STONE FILL**  
 STA. A 49+28 - STA. A 50+45 RT  
 STA. A 49+36 - STA. A 51+25 LT

**GEOTEXTILE FOR SILT FENCE**  
 STA. A 49+28 - STA. A 50+45 RT  
 STA. A 49+36 - STA. A 51+25 LT

**CURVE #7**  
 DELTA = 18° 15' 08"  
 D = 2° 56' 18"  
 R = 1950.00'  
 T = 313.25'  
 L = 621.19'  
 E = 25.00'  
 BANKING 0.052 FT/FT  
 DESIGN SPEED 50 MPH  
 SEE SUPERELEVATION DIAGRAMS  
 FOR BANKING INFORMATION

**ENVIRONMENTALLY SENSITIVE LOCATIONS:**

NO.	LIMITS	POS.	TYPE
26.	STA. A 49+28 - STA. A 50+45	RT	-
27.	STA. A 49+36 - STA. A 51+25	LT	-

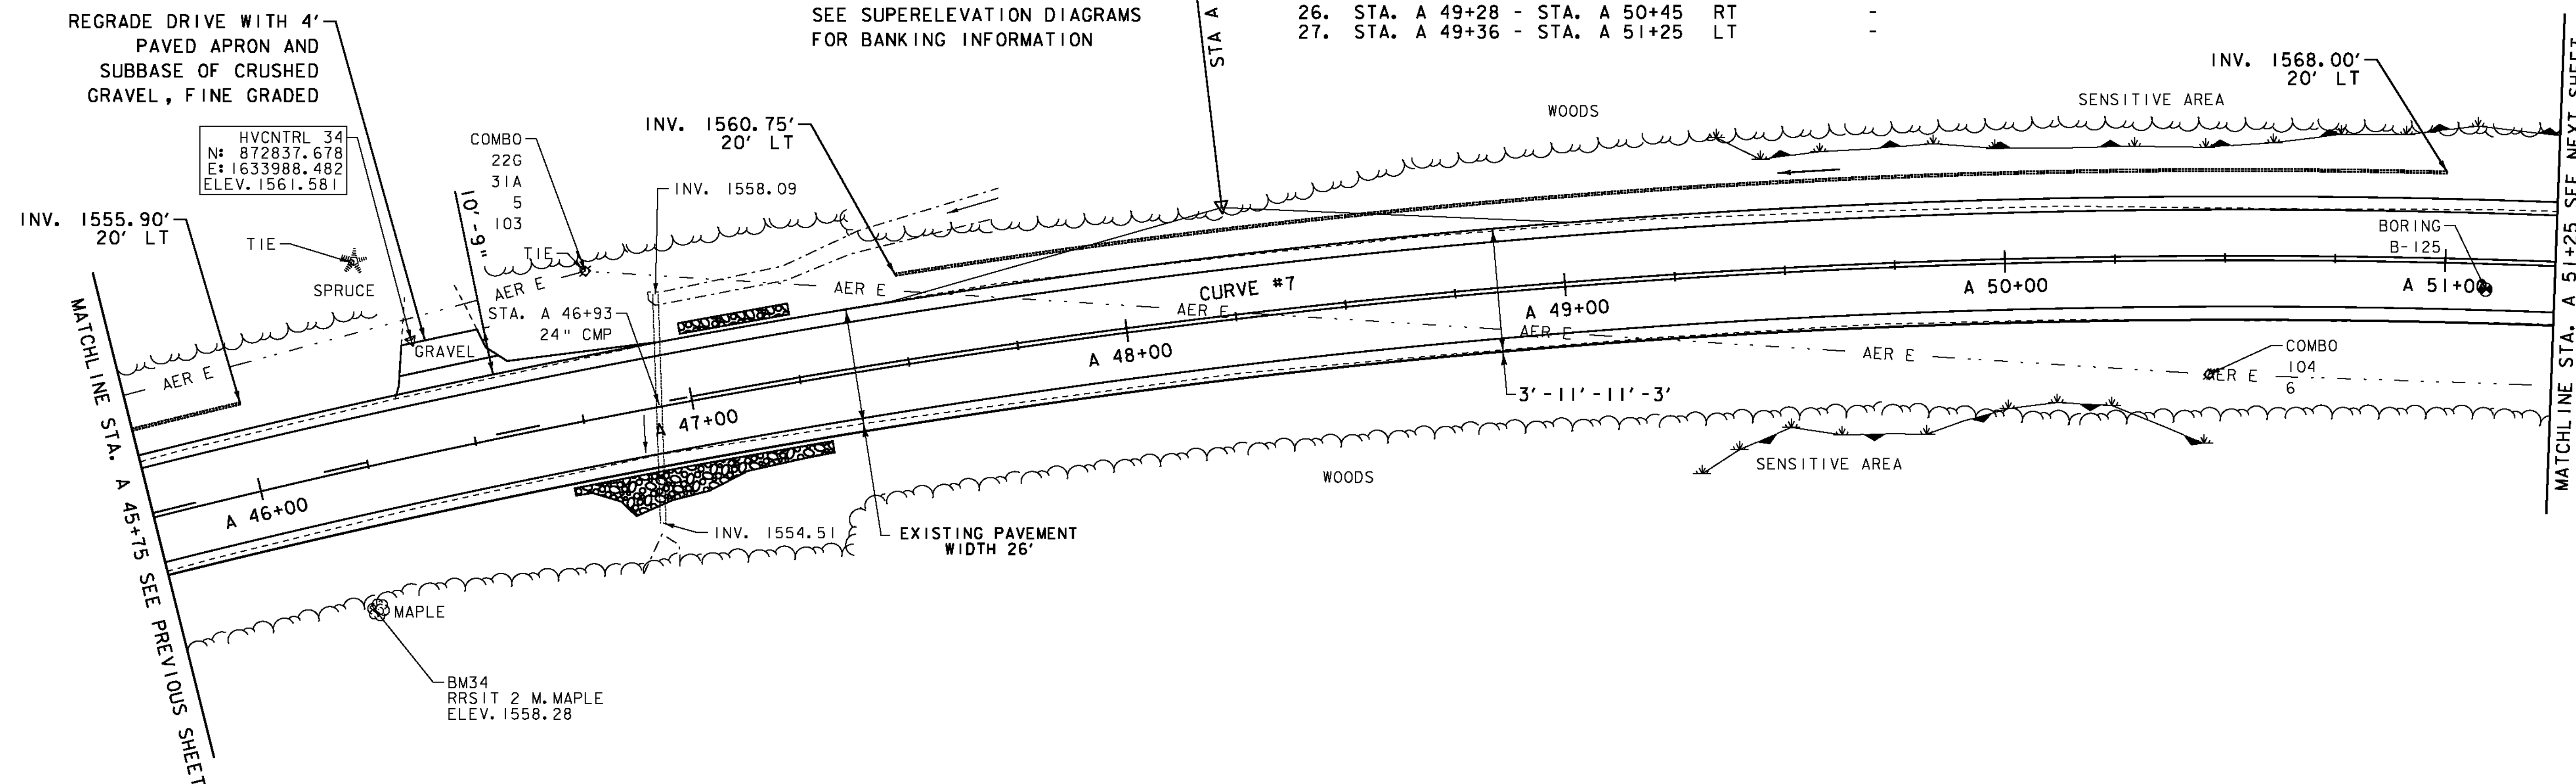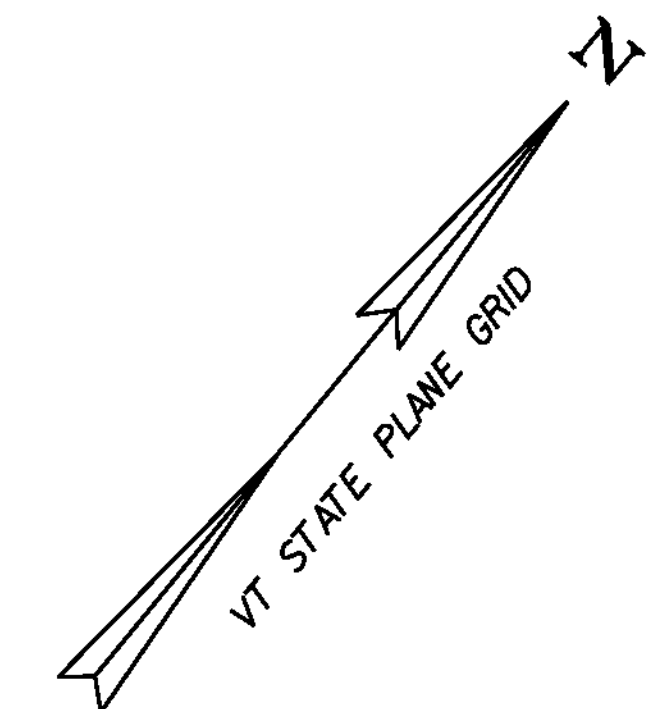

**SIGN LEGEND**

- R = REMOVE
- R&S = REMOVE AND SALVAGE
- RET = RETAIN
- S = SALVAGED
- N = NEW
- B-B = BACK TO BACK
- = EXISTING
- = NEW

**LEGEND**

- MAILBOX
- BORING
- SIGN
- HYDRANT
- MANHOLE
- WATER SHUT OFF (WSO)
- GAS PIPELINE MARKER
- CATCH BASIN / DROP INLET
- CURB INLET
- TRAFFIC CONTROL BOX
- PARKING METER
- UTILITY POLE

DATUM  
 NAVD 88  
 NAD 83

SCALE IN FEET  
 20 0 20

**PROJECT LAYOUT SHEET 45**

PROJECT NAME: MONTGOMERY-WESTFIELD

PROJECT NUMBER: STP 2906(I)

FILE NAME: p10ci90.dgn  
 PROJECT LEADER: CDL  
 DESIGNED BY: SJL  
 PLOT FILE: p10ci90\_66.1

PLOT DATE: 9/5/12  
 DRAWN BY: SJL  
 CHECKED BY: EPD  
 SHEET 66 OF 178