

DURABLE 4 INCH WHITE LINE (SEE OPTION ITEMS)

STA. A 57+25 - STA. A 62+75 (SOLID LT & RT)

DURABLE 4 INCH YELLOW LINE (SEE OPTION ITEMS)

STA. A 57+25 - STA. A 62+75 (SOLID LT & RT)

STEEL BEAM GUARDRAIL, GALVANIZED W/8 FEET POSTS

STA. A 61+60 - STA. A 62+75 RT

STA. A 61+75 - STA. A 62+75 LT

REMOVAL & DISPOSAL OF GUARDRAIL

STA. A 61+64 - STA. A 62+75 RT

STA. A 61+83 - STA. A 62+75 LT

ANCHOR FOR STEEL BEAM GUARDRAIL

STA. A 61+60 RT

STA. A 61+75 LT

GEOTEXTILE FOR SILT FENCE

STA. A 57+25 - STA. A 57+70 RT

STA. A 58+00 - STA. A 58+70 RT

STA. A 58+60 - STA. A 58+95 LT

STA. A 62+50 - STA. A 62+75 RT

TEMPORARY 4 INCH WHITE LINE, PAINT

STA. A 57+25 - STA. A 62+75 (SOLID LT & RT)

TEMPORARY 4 INCH YELLOW LINE, PAINT

STA. A 57+25 - STA. A 62+75 (SOLID LT & RT)

STONE FILL, TYPE I

STA. A 57+25 - STA. A 57+70 RT

STA. A 58+00 - STA. A 58+70 RT

STA. A 58+60 - STA. A 58+95 LT

STA. A 62+50 - STA. A 62+75 RT

GRUBBING MATERIAL

STA. A 57+25 - STA. A 57+70 RT

STA. A 58+00 - STA. A 58+70 RT

STA. A 58+60 - STA. A 58+95 LT

STA. A 62+50 - STA. A 62+75 RT

GEOTEXTILE UNDER STONE FILL

STA. A 57+25 - STA. A 57+70 RT

STA. A 58+00 - STA. A 58+70 RT

STA. A 58+60 - STA. A 58+95 LT

STA. A 62+50 - STA. A 62+75 RT

6 INCH UNDERDRAIN PIPE

STA. A 59+50 - STA. A 61+00 LT


REMOVING SIGNS

AS SHOWN - 1

REGRADE DRIVE WITH 4' PAVED APRON AND SUBBASE OF CRUSHED GRAVEL, FINE GRADED

CURVE #9
DELTA = 10°57'32"
D = 4°35'01"
R = 1250.00'
T = 119.91'
L = 239.08'
E = 5.74'

BANKING 0.068 FT/FT
DESIGN SPEED 50 MPH
SEE SUPERELEVATION DIAGRAMS FOR BANKING INFORMATION

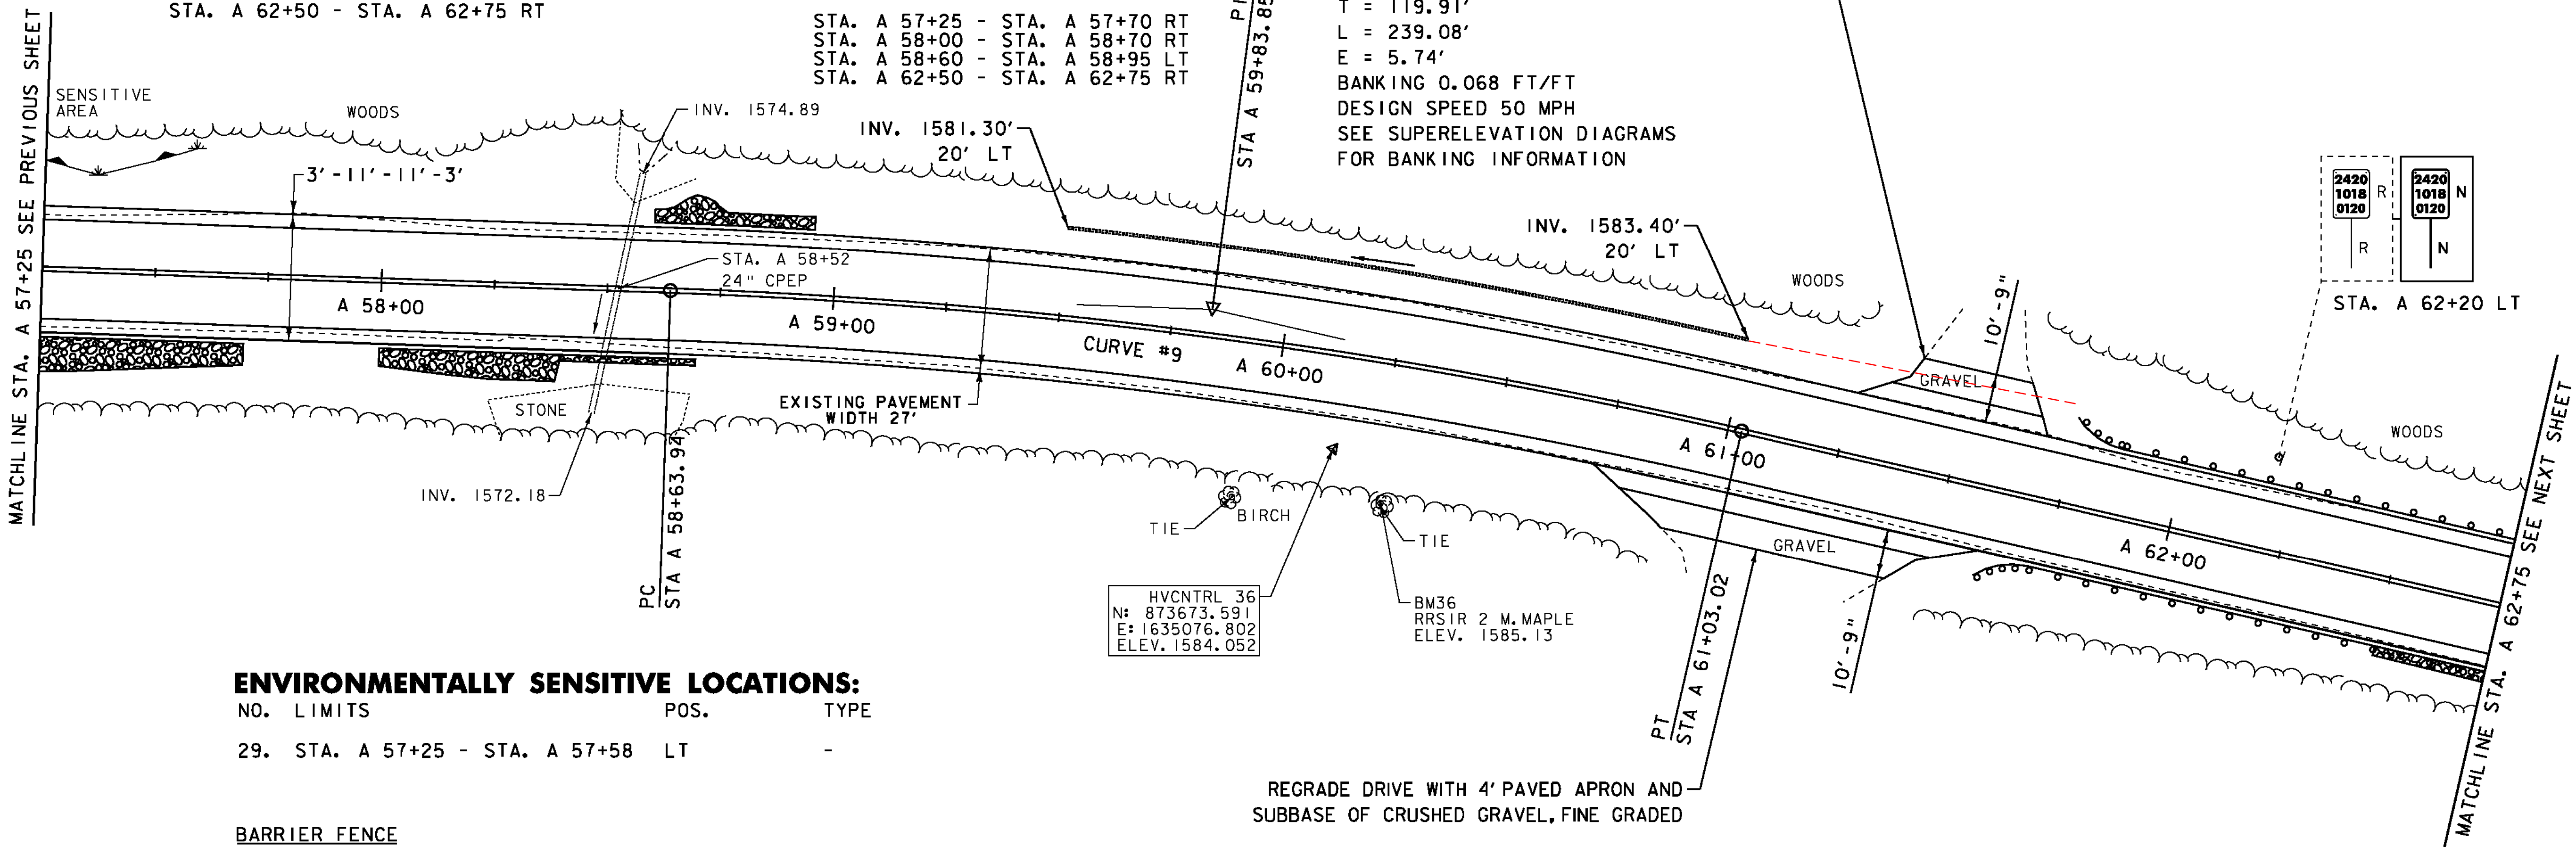

ENVIRONMENTALLY SENSITIVE LOCATIONS:

NO.	LIMITS	POS.	TYPE
29.	STA. A 57+25 - STA. A 57+58	LT	-

BARRIER FENCE

STA. A 57+25 - STA. A 57+58 LT

EROSION LOG

STA. A 57+25 - STA. A 57+58 LT

SIGN LEGEND

- R = REMOVE
- R&S = REMOVE AND SALVAGE
- RET = RETAIN
- S = SALVAGED
- N = NEW
- B-B = BACK TO BACK
- = EXISTING
- = NEW

LEGEND

- MAILBOX
- BORING
- SIGN
- HYDRANT
- MANHOLE
- WATER SHUT OFF (WSO)
- GAS PIPELINE MARKER
- CATCH BASIN / DROP INLET
- CURB INLET
- TRAFFIC CONTROL BOX
- PARKING METER
- UTILITY POLE

DATUM	NAVD 88
	NAD 83



PROJECT LAYOUT SHEET 47

PROJECT NAME:	MONTGOMERY-WESTFIELD
PROJECT NUMBER:	STP 2906(I)
FILE NAME:	pi0CI90.dgn
PROJECT LEADER:	CDL
DESIGNED BY:	SJL
PLOT FILE:	pi0CI90_68.1
PLOT DATE:	9/5/12
DRAWN BY:	SJL
CHECKED BY:	EPD
SHEET	68 OF 178

SEH
2-24-14

