

DURABLE 4 INCH WHITE LINE (SEE OPTION ITEMS)
 STA. A 62+75 - STA. A 68+25 (SOLID LT & RT)

TEMPORARY 4 INCH WHITE LINE, PAINT
 STA. A 62+75 - STA. A 68+25 (SOLID LT & RT)

DURABLE 4 INCH YELLOW LINE (SEE OPTION ITEMS)
 STA. A 62+75 - STA. A 68+25 (SOLID LT & RT)

TEMPORARY 4 INCH YELLOW LINE, PAINT
 STA. A 62+75 - STA. A 68+25 (SOLID LT & RT)

STEEL BEAM GUARDRAIL, GALVANIZED
 STA. ~~A 63+50~~ - STA. A 65+75 LT
 A 63+00

STONE FILL, TYPE I
 STA. A 62+75 - STA. A 65+70 RT
 STA. A 66+75 - STA. A 68+25 RT

STEEL BEAM GUARDRAIL, GALVANIZED W/8 FEET POSTS
 STA. A 62+75 - STA. ~~A 63+50~~ - STA. A 63+00 LT
 STA. A 62+75 - STA. A 66+10 RT


GRUBBING MATERIAL
 STA. A 62+75 - STA. A 65+70 RT
 STA. A 66+75 - STA. A 68+25 RT

REMOVAL & DISPOSAL OF GUARDRAIL
 STA. A 62+75 - STA. A 65+76 LT
 STA. A 62+75 - STA. A 66+10 RT

GEOTEXTILE UNDER STONE FILL
 STA. A 62+75 - STA. A 65+70 RT
 STA. A 66+75 - STA. A 68+25 RT

ANCHOR FOR STEEL BEAM GUARDRAIL
 STA. A 66+10 RT
 STA. A 65+75 LT

GEOTEXTILE FOR SILT FENCE
 STA. A 62+75 - STA. A 65+70 RT
 STA. A 66+75 - STA. A 68+25 RT

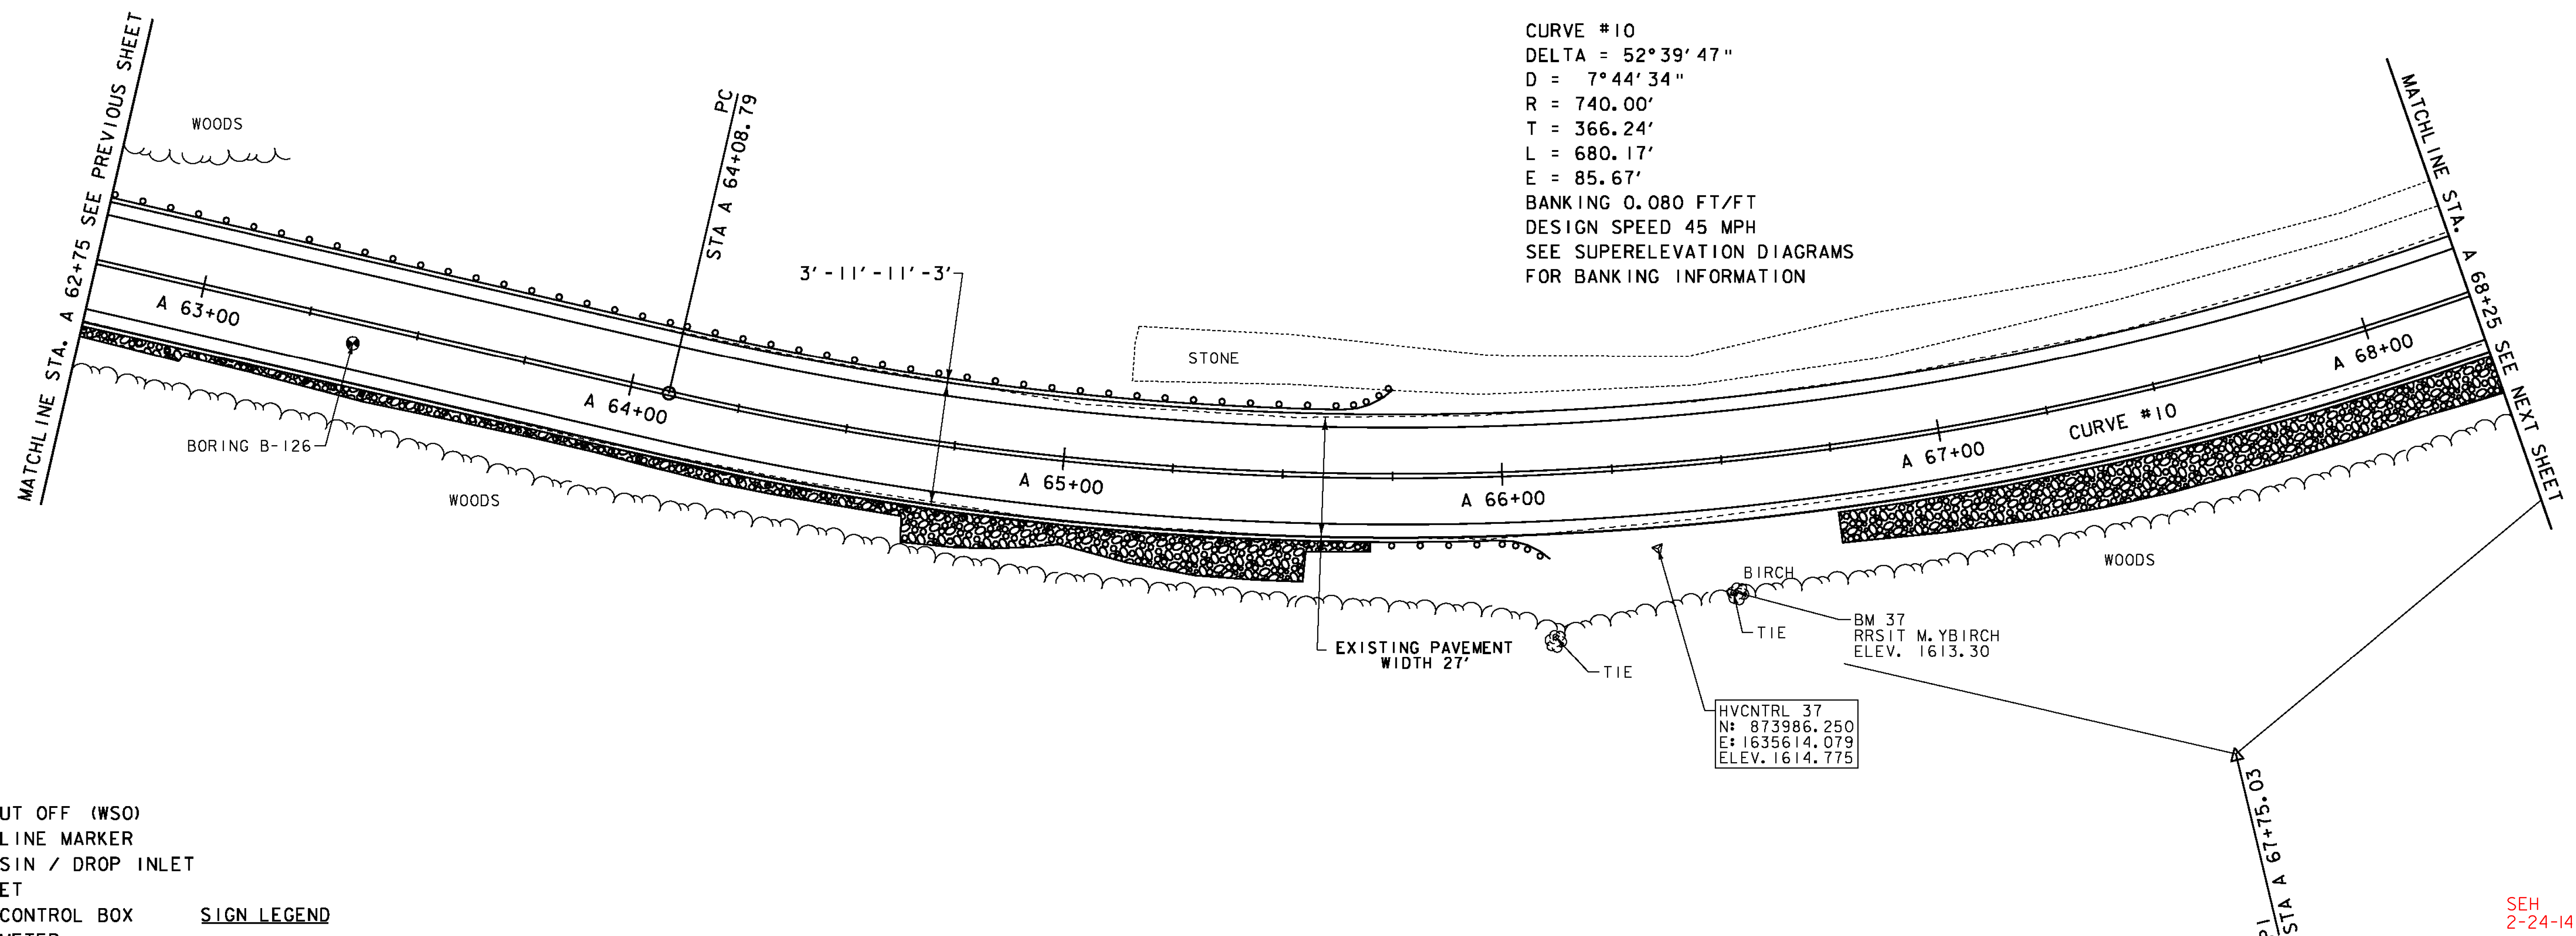

CURVE #10
 DELTA = 52°39'47"
 D = 7°44'34"
 R = 740.00'
 T = 366.24'
 L = 680.17'
 E = 85.67'
 BANKING 0.080 FT/FT
 DESIGN SPEED 45 MPH
 SEE SUPERELEVATION DIAGRAMS
 FOR BANKING INFORMATION

- LEGEND**
- MAILBOX
 - BORING
 - SIGN
 - HYDRANT
 - MANHOLE
 - WATER SHUT OFF (WSO)
 - GAS PIPELINE MARKER
 - CATCH BASIN / DROP INLET
 - CURB INLET
 - TRAFFIC CONTROL BOX
 - ⊕ PARKING METER
 - UTILITY POLE

- SIGN LEGEND**
- R = REMOVE
 - R&S = REMOVE AND SALVAGE
 - RET = RETAIN
 - S = SALVAGED
 - N = NEW
 - B-B = BACK TO BACK
 - = EXISTING
 - = NEW

DATUM
 NAVD 88
 NAD 83

PROJECT LAYOUT SHEET 48	PROJECT NAME: MONTGOMERY-WESTFIELD	FILE NAME: piOC190.dgn	PLOT DATE: 9/5/12
	PROJECT NUMBER: STP 2906(I)	PROJECT LEADER: CDL	DRAWN BY: SJL
	DESIGNED BY: SJL	CHECKED BY: EPD	SHEET 69 OF 178
	PLOT FILE: piOC190_69.I		

SEH
2-24-14