

DURABLE 4 INCH WHITE LINE (SEE OPTION ITEMS)
 STA. A 68+25 - STA. A 73+25 (SOLID LT & RT)

TEMPORARY 4 INCH WHITE LINE, PAINT
 STA. A 68+25 - STA. A 73+25 (SOLID LT & RT)

6 INCH UNDERDRAIN PIPE
 STA. A 68+50 - STA. A 73+25 LT
 48 69+68

REMOVING SIGNS
 AS SHOWN - 1

DURABLE 4 INCH YELLOW LINE (SEE OPTION ITEMS)
 STA. A 68+25 - STA. A 73+25 (SOLID LT & RT)

TEMPORARY 4 INCH YELLOW LINE, PAINT
 STA. A 68+25 - STA. A 73+25 (SOLID LT & RT)

STONE FILL, TYPE I
 STA. A 68+25 - STA. A 69+95 RT
 STA. A 70+75 - STA. A 71+20 RT

GRUBBING MATERIAL
 STA. A 68+25 - STA. A 69+95 RT
 STA. A 70+75 - STA. A 71+20 RT



GEOTEXTILE UNDER STONE FILL
 STA. A 68+25 - STA. A 69+95 RT
 STA. A 70+75 - STA. A 71+20 RT

GEOTEXTILE FOR SILT FENCE
 STA. A 68+25 - STA. A 69+95 RT
 STA. A 70+75 - STA. A 71+20 RT

STEEL BEAM GUARDRAIL, GALVANIZED W/8 FEET POSTS
 STA. A 72+85 - STA. A 73+25 RT

REMOVAL & DISPOSAL OF GUARDRAIL
 STA. A 72+83 - STA. A 73+25 RT

ANCHOR FOR STEEL BEAM GUARDRAIL
 STA. A 72+85 RT

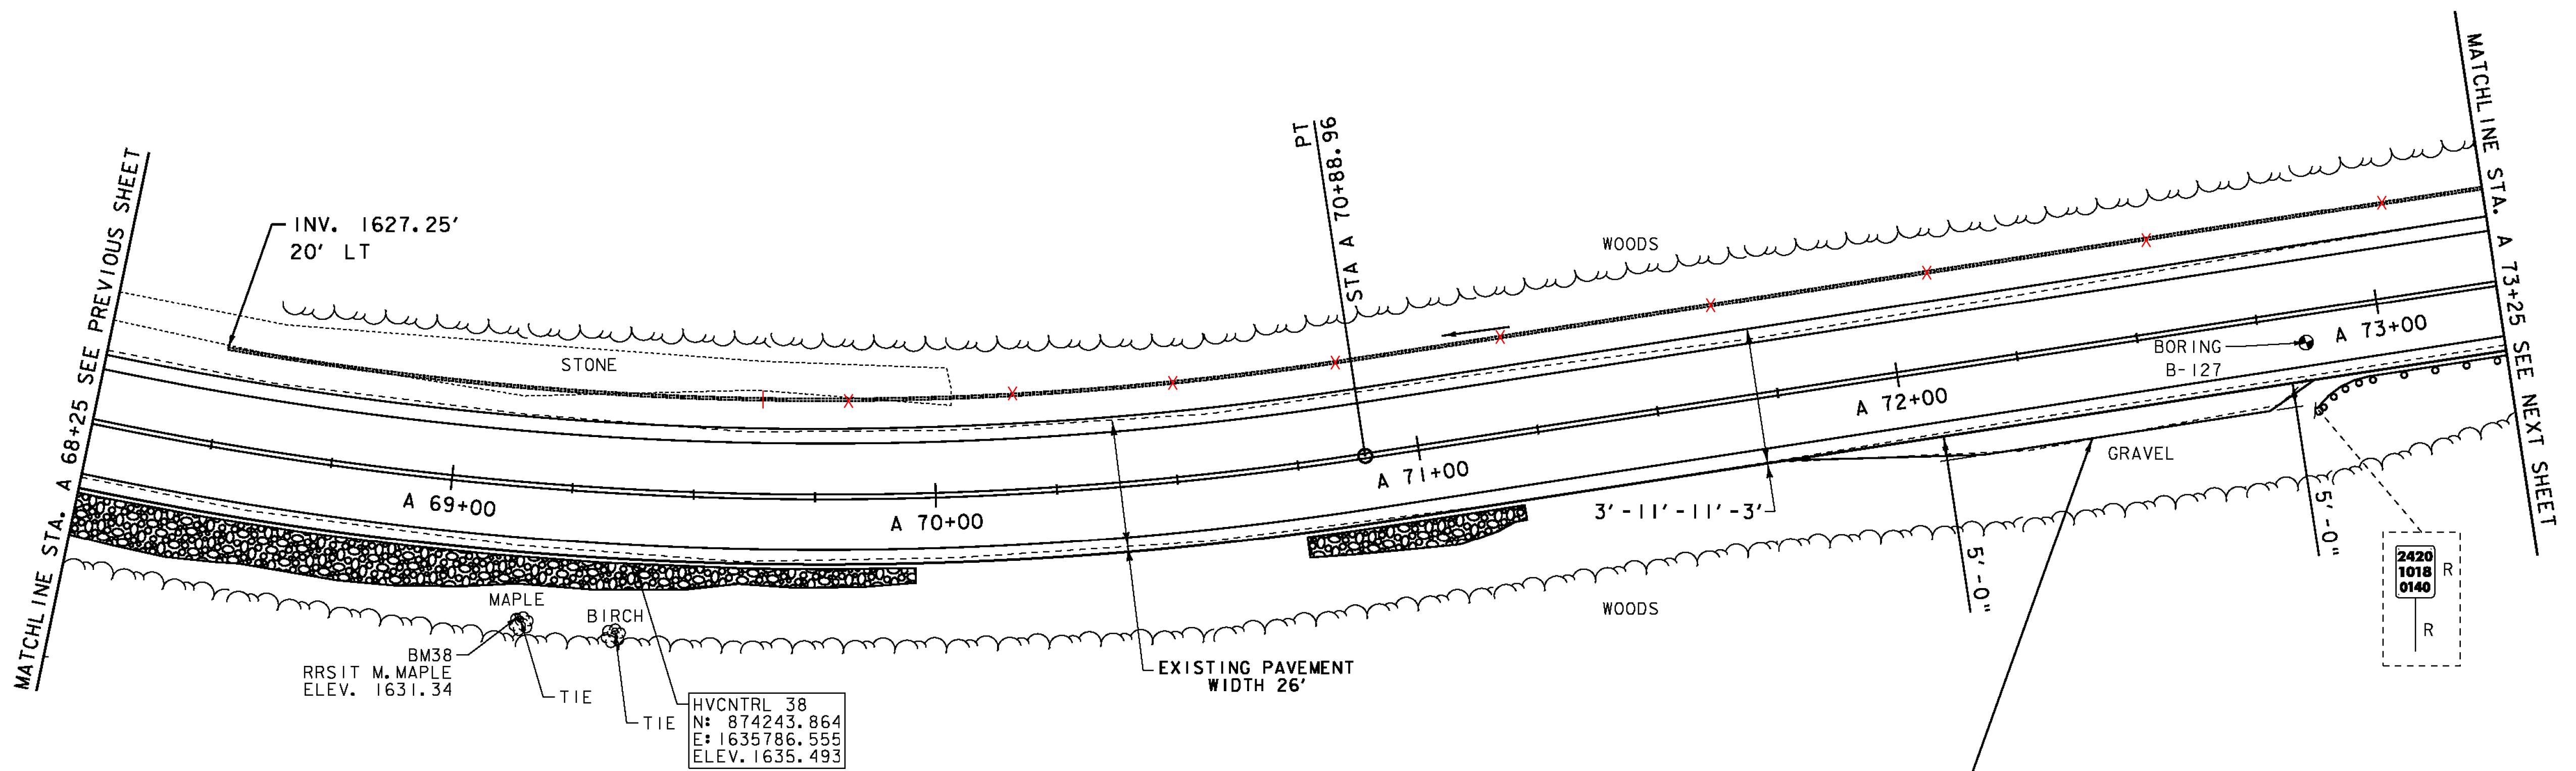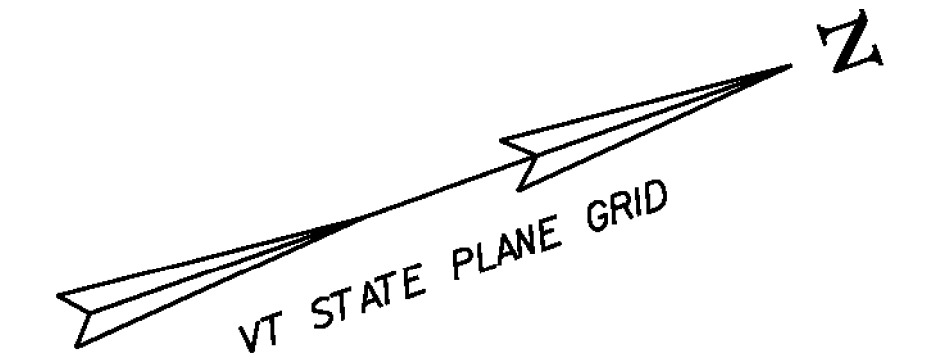

SEE PULL OFF AREA DETAIL ON SHEET 9 FOR ADDITIONAL INFORMATION

- LEGEND**
- MAILBOX
 - BORING
 - SIGN
 - HYDRANT
 - MANHOLE
 - WATER SHUT OFF (WSO)
 - GAS PIPELINE MARKER
 - CATCH BASIN / DROP INLET
 - CURB INLET
 - TRAFFIC CONTROL BOX
 - PARKING METER
 - UTILITY POLE

- SIGN LEGEND**
- R = REMOVE
 - R&S = REMOVE AND SALVAGE
 - RET = RETAIN
 - S = SALVAGED
 - N = NEW
 - B-B = BACK TO BACK
 - = EXISTING
 - = NEW

DATUM
 VERTICAL NAVD 88
 HORIZONTAL NAD 83



PROJECT LAYOUT SHEET 49	PROJECT NAME: MONTGOMERY-WESTFIELD	SEH 2-24-14
	PROJECT NUMBER: STP 2906(I)	
	FILE NAME: p10C190.dgn	PLOT DATE: 9/5/12
	PROJECT LEADER: CDL DESIGNED BY: SJL PLOT FILE: p10C190_70.I	DRAWN BY: SJL CHECKED BY: EPD SHEET 70 OF 178