

DURABLE 4 INCH WHITE LINE (SEE OPTION ITEMS)
 STA. A 73+25 - STA. A 79+25 (SOLID LT & RT)

DURABLE 4 INCH YELLOW LINE (SEE OPTION ITEMS)
 STA. A 73+25 - STA. A 79+25 (SOLID LT & RT)

TEMPORARY 4 INCH WHITE LINE, PAINT
 STA. A 73+25 - STA. A 79+25 (SOLID LT & RT)

TEMPORARY 4 INCH YELLOW LINE, PAINT
 STA. A 73+25 - STA. A 79+25 (SOLID LT & RT)

REMOVAL & DISPOSAL OF GUARDRAIL
 STA. A 73+25 - STA. A 77+99 RT
 STA. A 73+64 - STA. A 79+25 LT

ANCHOR FOR STEEL BEAM GUARDRAIL
 STA. A 73+65 LT
 STA. A 78+10 RT

~~6 INCH UNDERDRAIN PIPE~~
~~STA. A 73+25 - STA. A 73+50 LT~~

REMOVING SIGNS
 AS SHOWN - 2



STEEL BEAM GUARDRAIL, GALVANIZED
 STA. A 73+25 - STA. A 75+72.5 RT
 STA. A 77+72.5 - STA. A 78+10 RT

CURVE #11
 DELTA = 15° 16' 53"
 D = 5° 12' 31"
 R = 1100.00'
 T = 147.57'
 L = 293.38'
 E = 9.85'

BANKING 0.072 FT/FT
 DESIGN SPEED 50 MPH
 SEE SUPERELEVATION DIAGRAMS
 FOR BANKING INFORMATION

STEEL BEAM GUARDRAIL, GALVANIZED W/8 FEET POSTS

~~STA. A 73+25 - STA. A 74+28.75 RT~~
~~STA. A 73+65 - STA. A 74+40 LT A 79+25 LT~~
~~STA. A 74+53.75 - STA. A 78+10 RT~~
~~STA. A 74+65 - STA. A 79+25 LT~~
~~STA. A 75+72.5 - STA. A 77+72.5 RT~~
STEEL BEAM GUARDRAIL, GALVANIZED/NESTED
W/8 FEET POSTS
~~STA. A 74+28.75 - STA. A 74+53.75 RT~~
~~STA. A 74+40 - STA. A 74+65 LT~~

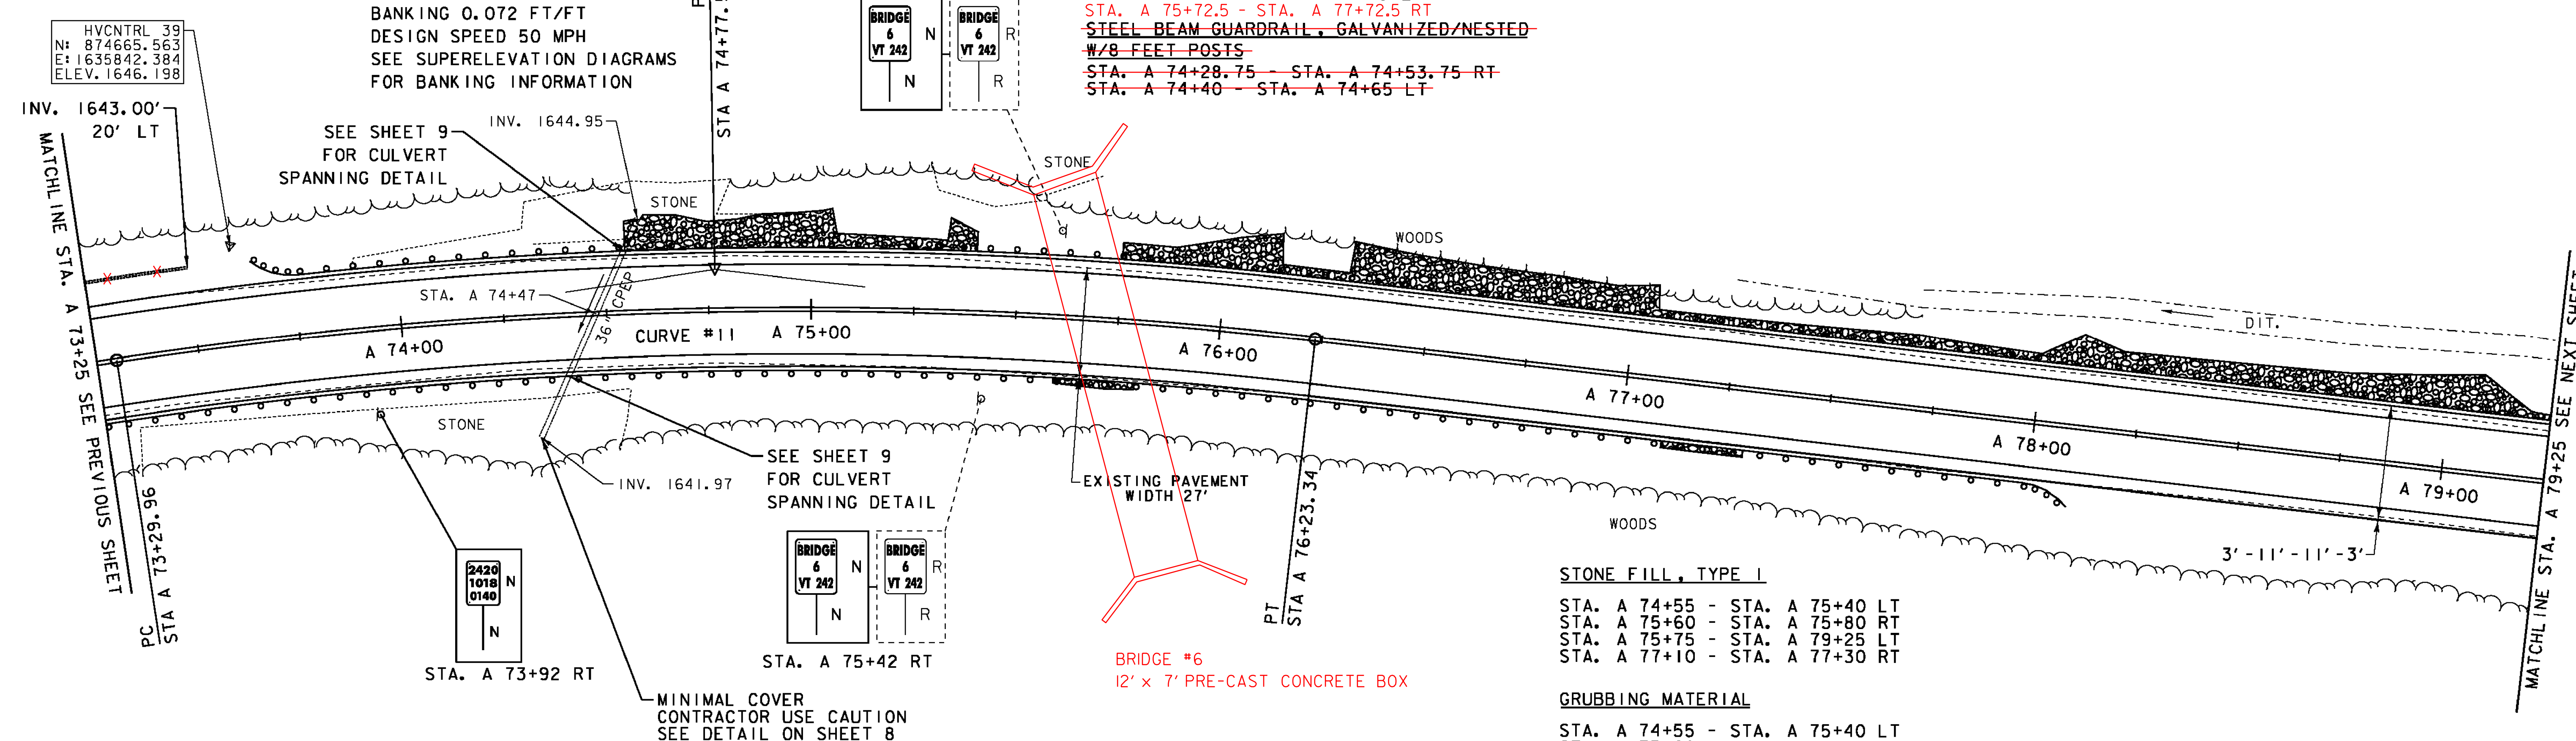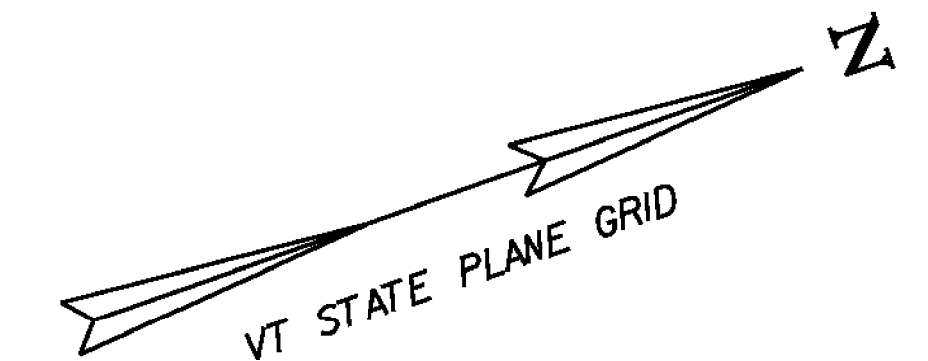

HVCNTRL 39
 N: 874665.563
 E: 1635842.384
 ELEV. 1646.198

INV. 1643.00'
 20' LT
 MATCHLINE STA. A 73+25 SEE PREVIOUS SHEET
 PC STA A 73+29.96

SEE SHEET 9
 FOR CULVERT
 SPANNING DETAIL

STA. A 74+00
 A 74+00
 CURVE #11
 A 75+00
 A 76+00
 A 77+00
 A 78+00
 A 79+00

2420
 1018 N
 0140 N
 STA. A 73+92 RT

BRIDGE #6
 VT 242
 STA. A 75+42 RT

BRIDGE #6
 12' x 7' PRE-CAST CONCRETE BOX

STONE FILL, TYPE I
 STA. A 74+55 - STA. A 75+40 LT
 STA. A 75+60 - STA. A 75+80 RT
 STA. A 75+75 - STA. A 79+25 LT
 STA. A 77+10 - STA. A 77+30 RT

GRUBBING MATERIAL
 STA. A 74+55 - STA. A 75+40 LT
 STA. A 75+60 - STA. A 75+80 RT
 STA. A 75+75 - STA. A 79+25 LT
 STA. A 77+10 - STA. A 77+30 RT

GEOTEXTILE UNDER STONE FILL
 STA. A 74+55 - STA. A 75+40 LT
 STA. A 75+60 - STA. A 75+80 RT
 STA. A 75+75 - STA. A 79+25 LT
 STA. A 77+10 - STA. A 77+30 RT

GEOTEXTILE FOR SILT FENCE
 STA. A 74+55 - STA. A 75+40 LT
 STA. A 75+60 - STA. A 75+80 RT
 STA. A 75+75 - STA. A 79+25 LT
 STA. A 77+10 - STA. A 77+30 RT

MINIMAL COVER
 CONTRACTOR USE CAUTION
 SEE DETAIL ON SHEET 8

- LEGEND**
- MAILBOX
 - BORING
 - SIGN
 - HYDRANT
 - MANHOLE
 - WATER SHUT OFF (WSO)
 - GAS PIPELINE MARKER
 - CATCH BASIN / DROP INLET
 - CURB INLET
 - TRAFFIC CONTROL BOX
 - PARKING METER
 - UTILITY POLE

- SIGN LEGEND**
- R = REMOVE
 - R&S = REMOVE AND SALVAGE
 - RET = RETAIN
 - S = SALVAGED
 - N = NEW
 - B-B = BACK TO BACK
 - = EXISTING
 - = NEW

DATUM
 VERTICAL NAVD 88
 HORIZONTAL NAD 83



PROJECT LAYOUT SHEET 50	PROJECT NAME: MONTGOMERY-WESTFIELD
	PROJECT NUMBER: STP 2906(I)
FILE NAME: ploci90.dgn	PLOT DATE: 9/5/12
PROJECT LEADER: CDL	DRAWN BY: SJL
DESIGNED BY: SJL	CHECKED BY: EPD
PLOT FILE: ploci90_71.I	SHEET 71 OF 178

SEH
 2-24-14