



- DURABLE 4 INCH WHITE LINE (SEE OPTION ITEMS)  
STA. A 96+25 - STA. A 101+75 (SOLID LT & RT)
- DURABLE 4 INCH YELLOW LINE (SEE OPTION ITEMS)  
STA. A 96+25 - STA. A 101+75 (SOLID LT & RT)
- STEEL BEAM GUARDRAIL, GALVANIZED  
STA. A 100+35 - STA. ~~A 101+75 LT~~ - A 101+22.5 LT  
STA. A 98+25 - STA. A 99+50 RT  
STA. A 100+12.5 - STA. A 101+00 RT  
REMOVAL & DISPOSAL OF GUARDRAIL  
STA. A 100+35 - STA. A 101+75 LT
- ANCHOR FOR STEEL BEAM GUARDRAIL  
STA. A 100+35 LT
- STEEL BEAM GUARDRAIL, GALVANIZED W/ 8 FOOT POSTS  
STA. A 101+22.5 - STA. A 101+75 LT  
STA. A 99+50 - STA. A 100+12.5 RT
- TEMPORARY 4 INCH WHITE LINE, PAINT  
STA. A 96+25 - STA. A 101+75 (SOLID LT & RT)
- TEMPORARY 4 INCH YELLOW LINE, PAINT  
STA. A 96+25 - STA. A 101+75 (SOLID LT & RT)
- STONE FILL, TYPE I  
STA. A 98+75 - STA. A 99+00 RT  
STA. A 101+30 - STA. A 101+75 LT
- GRUBBING MATERIAL  
STA. A 98+75 - STA. A 99+00 RT  
STA. A 101+30 - STA. A 101+75 LT
- GEOTEXTILE UNDER STONE FILL  
STA. A 98+75 - STA. A 99+00 RT  
STA. A 101+30 - STA. A 101+75 LT
- GEOTEXTILE FOR SILT FENCE  
STA. A 98+75 - STA. A 99+00 RT  
STA. A 101+30 - STA. A 101+75 LT
- 6 INCH UNDERDRAIN PIPE  
STA. A 96+25 - STA. A ~~98+50~~ <sup>96+30</sup> LT
- REMOVING SIGNS  
AS SHOWN - 2

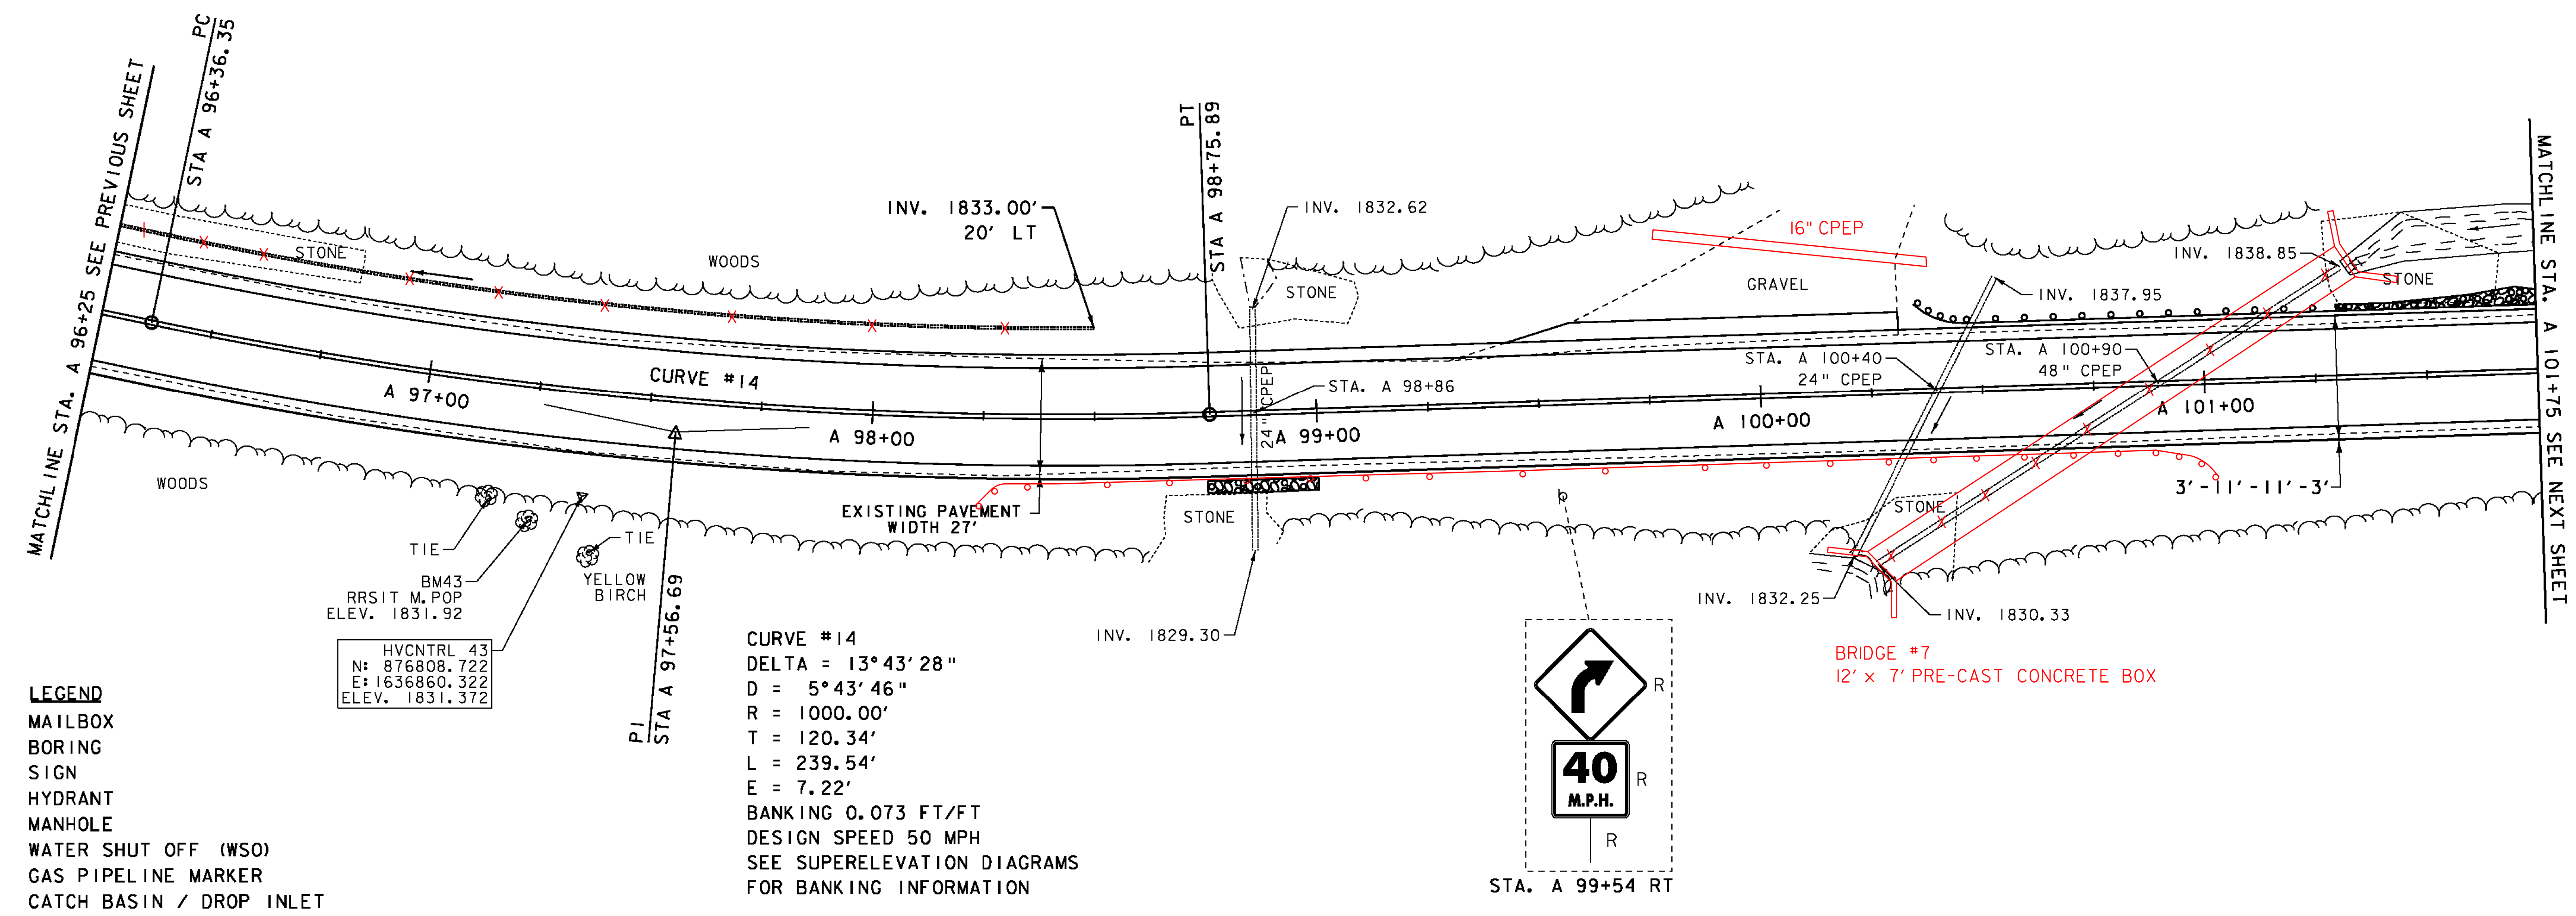

- LEGEND**
- MAILBOX
  - BORING
  - SIGN
  - HYDRANT
  - MANHOLE
  - WATER SHUT OFF (WSO)
  - GAS PIPELINE MARKER
  - CATCH BASIN / DROP INLET
  - CURB INLET
  - TRAFFIC CONTROL BOX
  - PARKING METER
  - UTILITY POLE

- SIGN LEGEND**
- R = REMOVE
  - R&S = REMOVE AND SALVAGE
  - RET = RETAIN
  - S = SALVAGED
  - N = NEW
  - B-B = BACK TO BACK
  - = EXISTING
  - = NEW

DATUM  
 NAVD 88  
 NAD 83

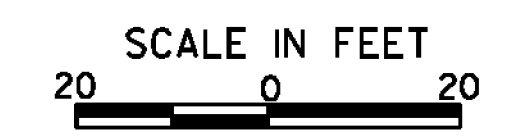

<b>PROJECT LAYOUT SHEET 54</b>	PROJECT NAME: MONTGOMERY-WESTFIELD	FILE NAME: p10C190.dgn	PLOT DATE: 9/5/12
	PROJECT NUMBER: STP 2906(1)	PROJECT LEADER: CDL	DRAWN BY: SJL
	DESIGNED BY: SJL	CHECKED BY: EPD	SHEET 75 OF 178
	PLOT FILE: p10C190_75.1		

SEH  
2-24-14