

DURABLE 4 INCH WHITE LINE (SEE OPTION ITEMS)
 STA. A 101+75 - STA. A 107+50 (SOLID LT & RT)

DURABLE 4 INCH YELLOW LINE (SEE OPTION ITEMS)
 STA. A 101+75 - STA. A 107+50 (SOLID LT & RT)

STEEL BEAM GUARDRAIL, GALVANIZED
 STA. A 101+75 - STA. A 102+85 LT
 A 102+60

REMOVAL & DISPOSAL OF GUARDRAIL
 STA. A 101+75 - STA. A 102+84 LT

ANCHOR FOR STEEL BEAM GUARDRAIL
 STA. A 102+85 LT

TEMPORARY 4 INCH WHITE LINE, PAINT
 STA. A 101+75 - STA. A 107+50 (SOLID LT & RT)

TEMPORARY 4 INCH YELLOW LINE, PAINT
 STA. A 101+75 - STA. A 107+50 (SOLID LT & RT)



STEEL BEAM GUARDRAIL, GALVANIZED W/ 8 FOOT POSTS
 STA. A 101+75 - STA. A 102+60 LT

STONE FILL, TYPE I
 STA. A 101+75 - STA. A 102+50 LT
 STA. A 106+90 - STA. A 107+50 LT

GRUBBING MATERIAL
 STA. A 101+75 - STA. A 102+50 LT
 STA. A 106+90 - STA. A 107+50 LT

GEOTEXTILE UNDER STONE FILL
 STA. A 101+75 - STA. A 102+50 LT
 STA. A 106+90 - STA. A 107+50 LT

GEOTEXTILE FOR SILT FENCE
 STA. A 101+75 - STA. A 102+50 LT
 STA. A 106+90 - STA. A 107+50 LT

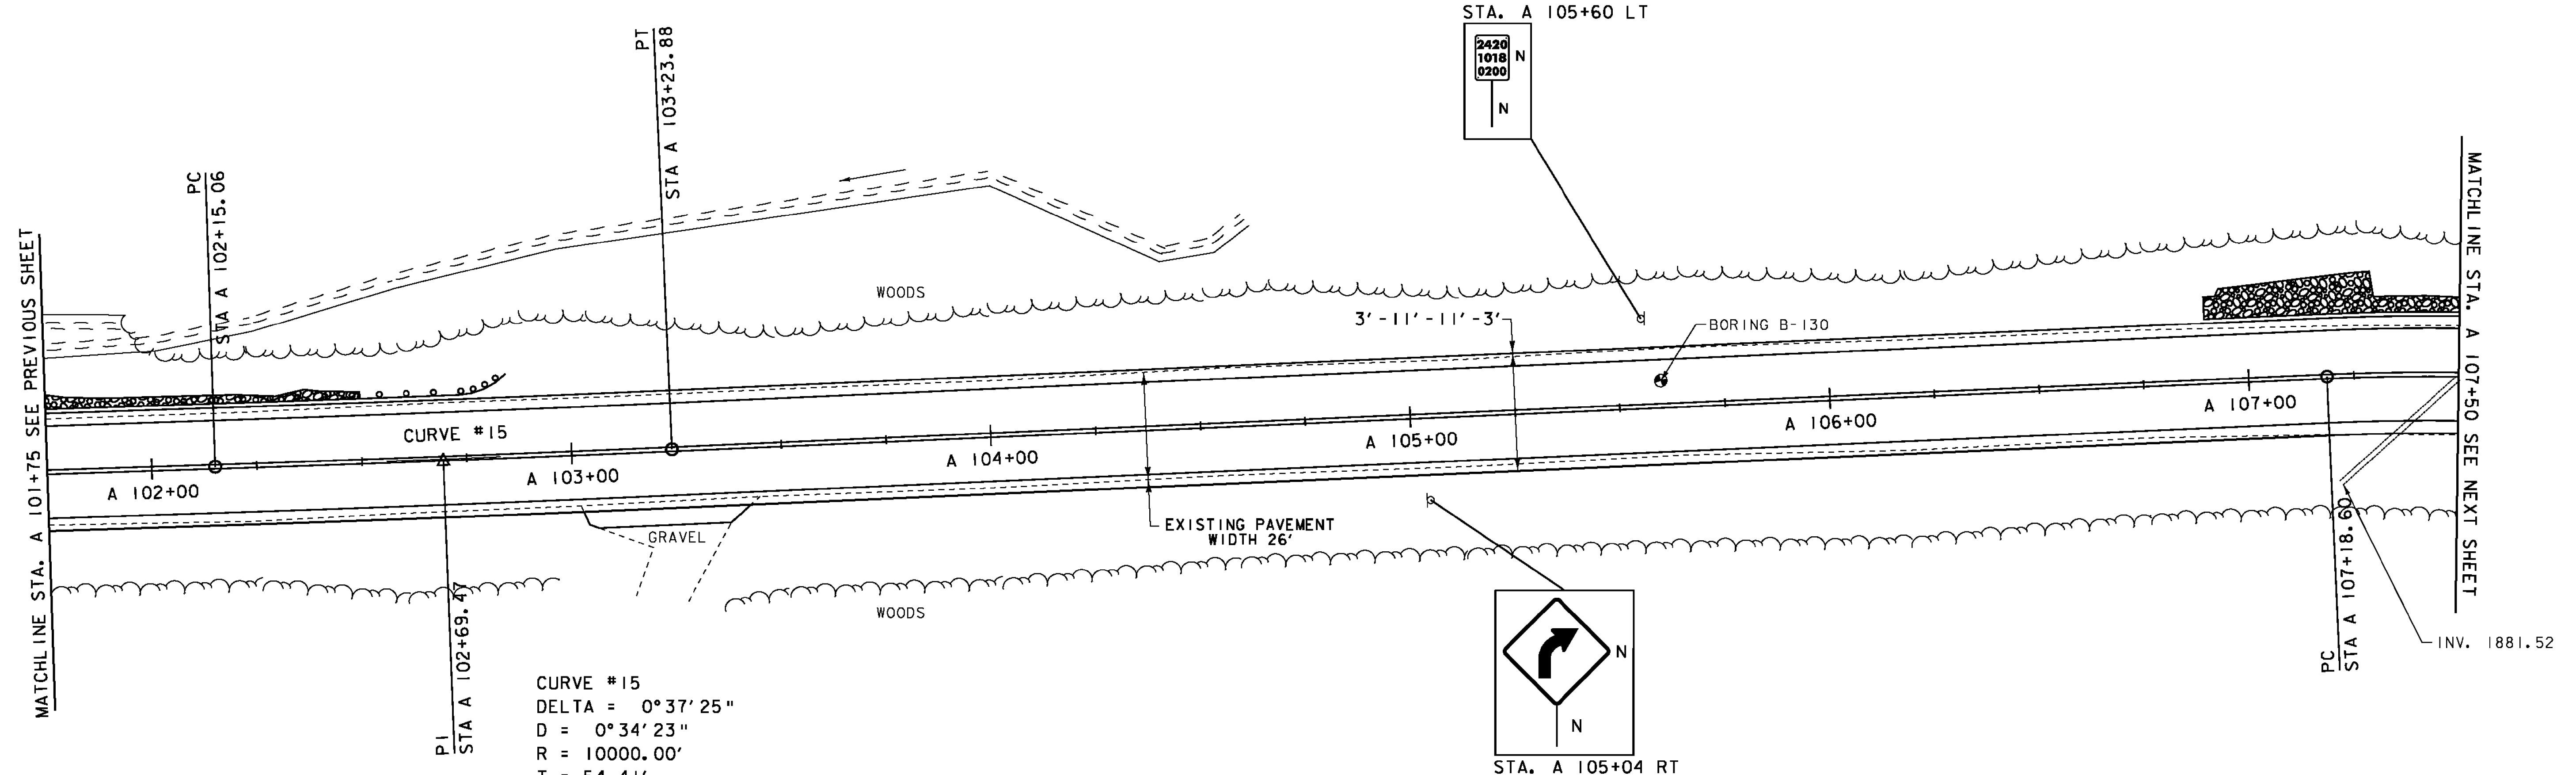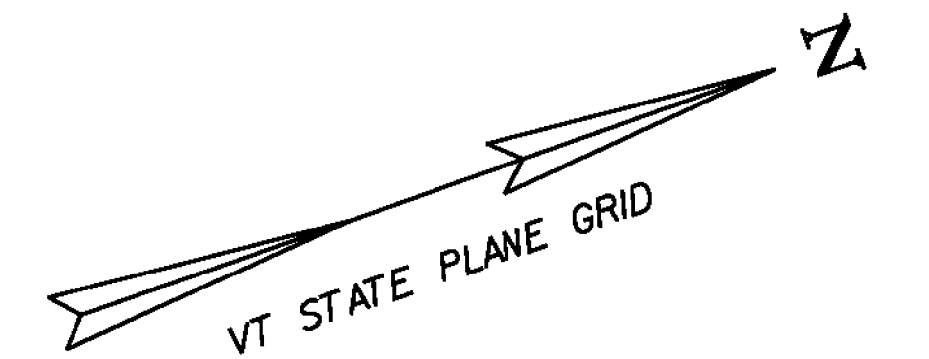

- LEGEND**
- MAILBOX
 - BORING
 - SIGN
 - HYDRANT
 - MANHOLE
 - WATER SHUT OFF (WSO)
 - GAS PIPELINE MARKER
 - CATCH BASIN / DROP INLET
 - CURB INLET
 - TRAFFIC CONTROL BOX
 - PARKING METER
 - UTILITY POLE

- SIGN LEGEND**
- R = REMOVE
 - R&S = REMOVE AND SALVAGE
 - RET = RETAIN
 - S = SALVAGED
 - N = NEW
 - B-B = BACK TO BACK
 - = EXISTING
 - = NEW

DATUM
 VERTICAL NAVD 88
 HORIZONTAL NAD 83



PROJECT LAYOUT SHEET 55	PROJECT NAME: MONTGOMERY-WESTFIELD	PLOT DATE: 9/5/12
	PROJECT NUMBER: STP 2906(1)	DRAWN BY: SJL
	FILE NAME: piOC190.dgn	CHECKED BY: EPD
	PROJECT LEADER: CDL	SHEET 76 OF 178
	DESIGNED BY: SJL	
	PLOT FILE: piOC190_76.I	

SEH
2-24-14