

DURABLE 4 INCH WHITE LINE (SEE OPTION ITEMS)
 STA. A 101+75 - STA. A 107+50 (SOLID LT & RT)

TEMPORARY 4 INCH WHITE LINE, PAINT
 STA. A 101+75 - STA. A 107+50 (SOLID LT & RT)

STONE FILL, TYPE I
 STA. A 101+75 - STA. A 102+50 LT
 STA. A 106+90 - STA. A 107+50 LT

DURABLE 4 INCH YELLOW LINE (SEE OPTION ITEMS)
 STA. A 101+75 - STA. A 107+50 (SOLID LT & RT)

TEMPORARY 4 INCH YELLOW LINE, PAINT
 STA. A 101+75 - STA. A 107+50 (SOLID LT & RT)

GRUBBING MATERIAL
 STA. A 101+75 - STA. A 102+50 LT
 STA. A 106+90 - STA. A 107+50 LT



STEEL BEAM GUARDRAIL, GALVANIZED
 STA. A 101+75 - STA. A 102+85 LT

GEOTEXTILE UNDER STONE FILL
 STA. A 101+75 - STA. A 102+50 LT
 STA. A 106+90 - STA. A 107+50 LT



REMOVAL & DISPOSAL OF GUARDRAIL
 STA. A 101+75 - STA. A 102+84 LT

GEOTEXTILE FOR SILT FENCE
 STA. A 101+75 - STA. A 102+50 LT
 STA. A 106+90 - STA. A 107+50 LT

ANCHOR FOR STEEL BEAM GUARDRAIL
 STA. A 102+85 LT

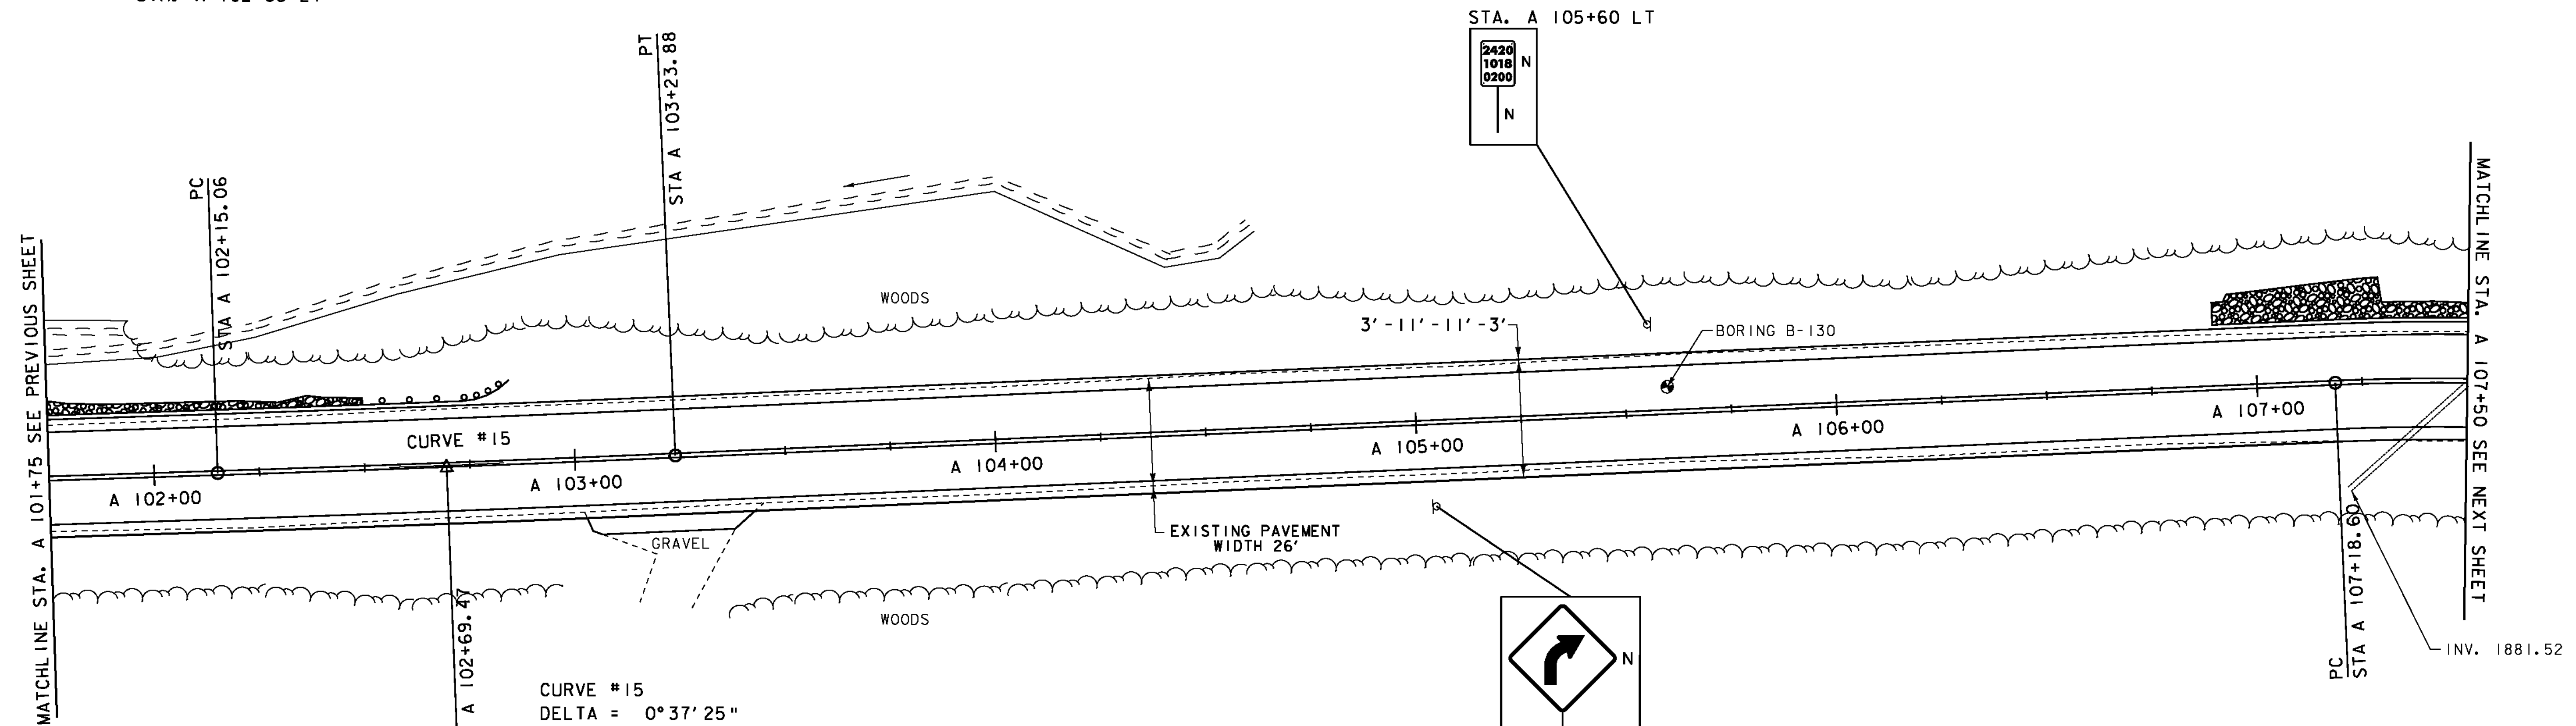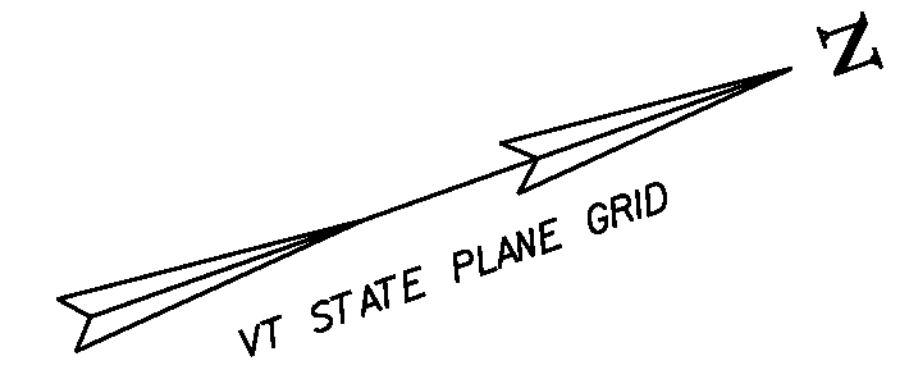

CURVE #15
 DELTA = 0° 37' 25"
 D = 0° 34' 23"
 R = 10000.00'
 T = 54.41'
 L = 108.82'
 E = 0.15'
 BANKING NORMAL CROWN
 DESIGN SPEED 50 MPH
 SEE SUPERELEVATION DIAGRAMS
 FOR BANKING INFORMATION

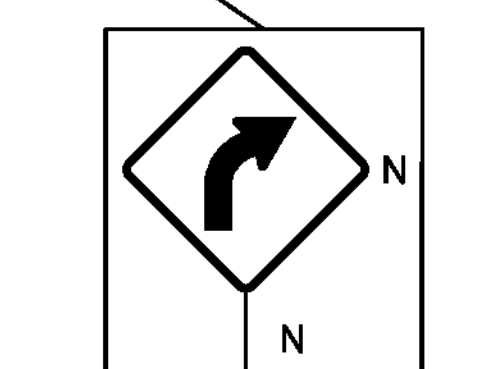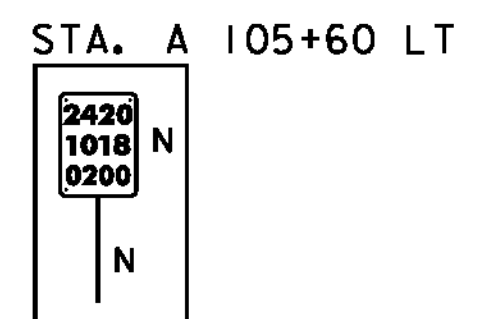

- LEGEND**
- MAILBOX
 - BORING
 - SIGN
 - HYDRANT
 - MANHOLE
 - WATER SHUT OFF (WSO)
 - GAS PIPELINE MARKER
 - CATCH BASIN / DROP INLET
 - CURB INLET
 - ⊠ TRAFFIC CONTROL BOX
 - ⊕ PARKING METER
 - ⊖ UTILITY POLE

- SIGN LEGEND**
- R = REMOVE
 - R&S = REMOVE AND SALVAGE
 - RET = RETAIN
 - S = SALVAGED
 - N = NEW
 - B-B = BACK TO BACK
 - = EXISTING
 - = NEW

DATUM
 VERTICAL NAVD 88
 HORIZONTAL NAD 83

SCALE IN FEET
 20 0 20

PROJECT LAYOUT SHEET 55

PROJECT NAME: MONTGOMERY-WESTFIELD
 PROJECT NUMBER: STP 2906(I)
 FILE NAME: p10ci90.dgn
 PROJECT LEADER: CDL
 DESIGNED BY: SJL
 PLOT FILE: p10ci90_76.1
 PLOT DATE: 9/5/12
 DRAWN BY: SJL
 CHECKED BY: EPD
 SHEET 76 OF 178