

DURABLE 4 INCH WHITE LINE (SEE OPTION ITEMS)  
 STA. A 124+75 - STA. A 130+75 (SOLID LT & RT)


TEMPORARY 4 INCH WHITE LINE, PAINT  
 STA. A 124+75 - STA. A 130+75 (SOLID LT & RT)

6 INCH UNDERDRAIN PIPE 73  
 STA. A 124+75 - STA. A 125+50 LT  
 STA. A 128+50 - STA. A 129+50 LT


DURABLE 4 INCH YELLOW LINE (SEE OPTION ITEMS)  
 STA. A 124+75 - STA. A 130+75 (SOLID LT & RT)

TEMPORARY 4 INCH YELLOW LINE, PAINT  
 STA. A 124+75 - STA. A 130+75 (SOLID LT & RT)

REMOVING SIGNS  
 AS SHOWN - 1

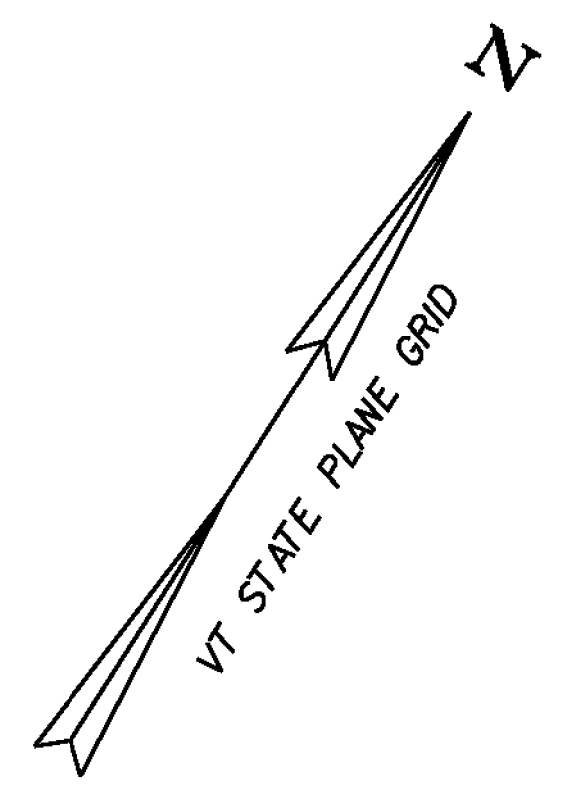

CURVE #20  
 DELTA = 9°01'18"  
 D = 3°34'52"  
 R = 1600.00'  
 T = 126.23'  
 L = 251.93'  
 E = 4.97'  
 BANKING 0.059 FT/FT  
 DESIGN SPEED 50 MPH  
 SEE SUPERELEVATION DIAGRAMS  
 FOR BANKING INFORMATION

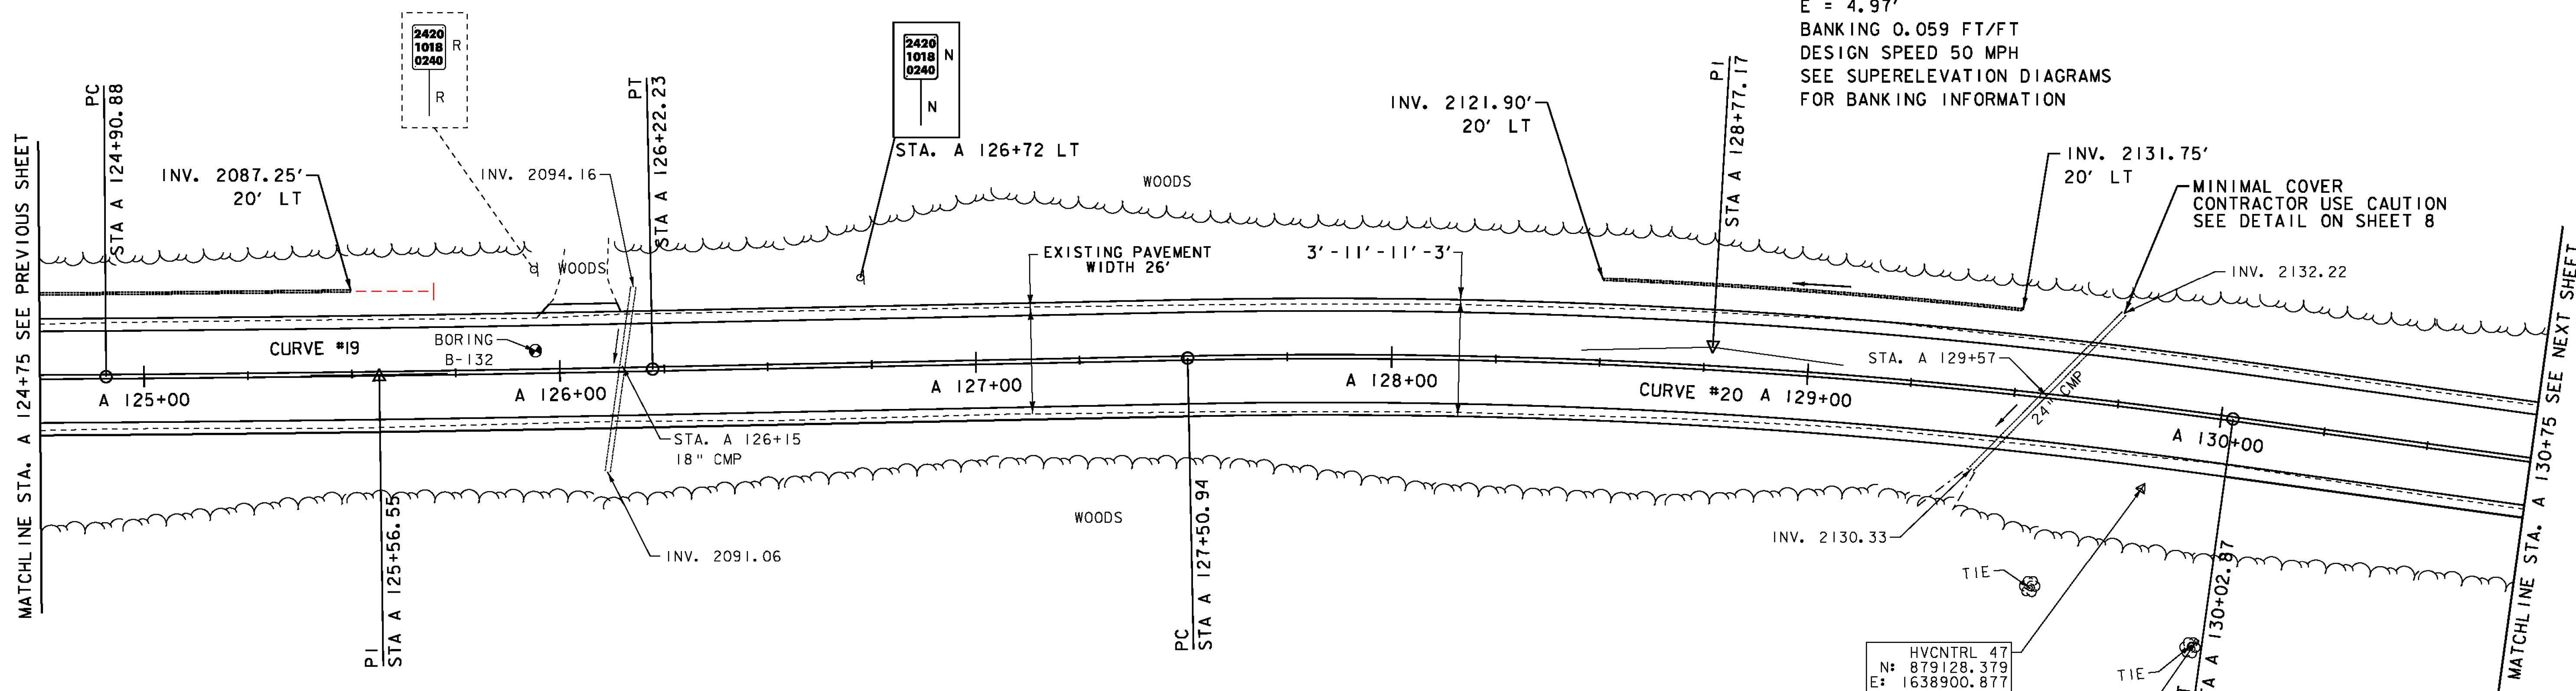

CURVE #19  
 DELTA = 0°45'09"  
 D = 0°34'23"  
 R = 10000.00'  
 T = 65.68'  
 L = 131.35'  
 E = 0.22'  
 BANKING NORMAL CROWN  
 DESIGN SPEED 50 MPH  
 SEE SUPERELEVATION DIAGRAMS  
 FOR BANKING INFORMATION

HVCNTRL 47  
 N: 879128.379  
 E: 1638900.877  
 ELEV. 2137.028

BM47  
 RRSIR M. BEECH  
 ELEV. 2134.46

- LEGEND**
- MAILBOX
  - BORING
  - SIGN
  - HYDRANT
  - MANHOLE
  - WATER SHUT OFF (WSO)
  - GAS PIPELINE MARKER
  - CATCH BASIN / DROP INLET
  - CURB INLET
  - TRAFFIC CONTROL BOX
  - PARKING METER
  - UTILITY POLE

- SIGN LEGEND**
- R = REMOVE
  - R&S = REMOVE AND SALVAGE
  - RET = RETAIN
  - S = SALVAGED
  - N = NEW
  - B-B = BACK TO BACK
  - = EXISTING
  - = NEW

DATUM  
 NAVD 88  
 NAD 83

SCALE IN FEET  
 20 0 20

**PROJECT LAYOUT SHEET 59**

PROJECT NAME: MONTGOMERY-WESTFIELD  
 PROJECT NUMBER: STP 2906(I)

FILE NAME: piOC190.dgn  
 PROJECT LEADER: CDL  
 DESIGNED BY: SJL  
 PLOT FILE: piOC190\_80.I

PLOT DATE: 9/5/12  
 DRAWN BY: SJL  
 CHECKED BY: EPD  
 SHEET 80 OF 178

SEH  
 2-24-14