

DURABLE 4 INCH WHITE LINE (SEE OPTION ITEMS)
 STA. A 130+75 - STA. A 136+75 (SOLID LT & RT)

DURABLE 4 INCH YELLOW LINE (SEE OPTION ITEMS)
 STA. A 130+75 - STA. A 136+75 (SOLID LT & RT)

6 INCH UNDERDRAIN PIPE
 STA. A 133+50 - STA. A 136+50-LT
 72 40

TEMPORARY 4 INCH WHITE LINE, PAINT
 STA. A 130+75 - STA. A 136+75 (SOLID LT & RT)

TEMPORARY 4 INCH YELLOW LINE, PAINT
 STA. A 130+75 - STA. A 136+75 (SOLID LT & RT)


STONE FILL, TYPE I
 STA. A 131+60 - STA. A 132+50 RT

GRUBBING MATERIAL
 STA. A 131+60 - STA. A 132+50 RT



GEOTEXTILE UNDER STONE FILL
 STA. A 131+60 - STA. A 132+50 RT

GEOTEXTILE FOR SILT FENCE
 STA. A 131+60 - STA. A 132+50 RT

REMOVING SIGNS
 AS SHOWN - 2

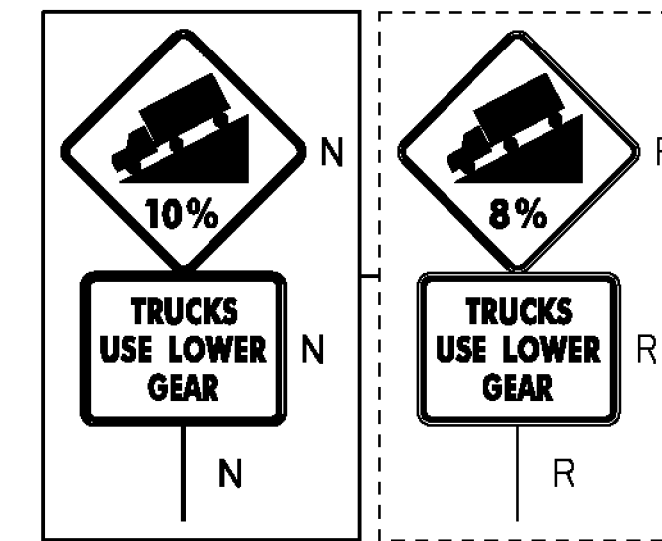

STA. A 136+00 LT

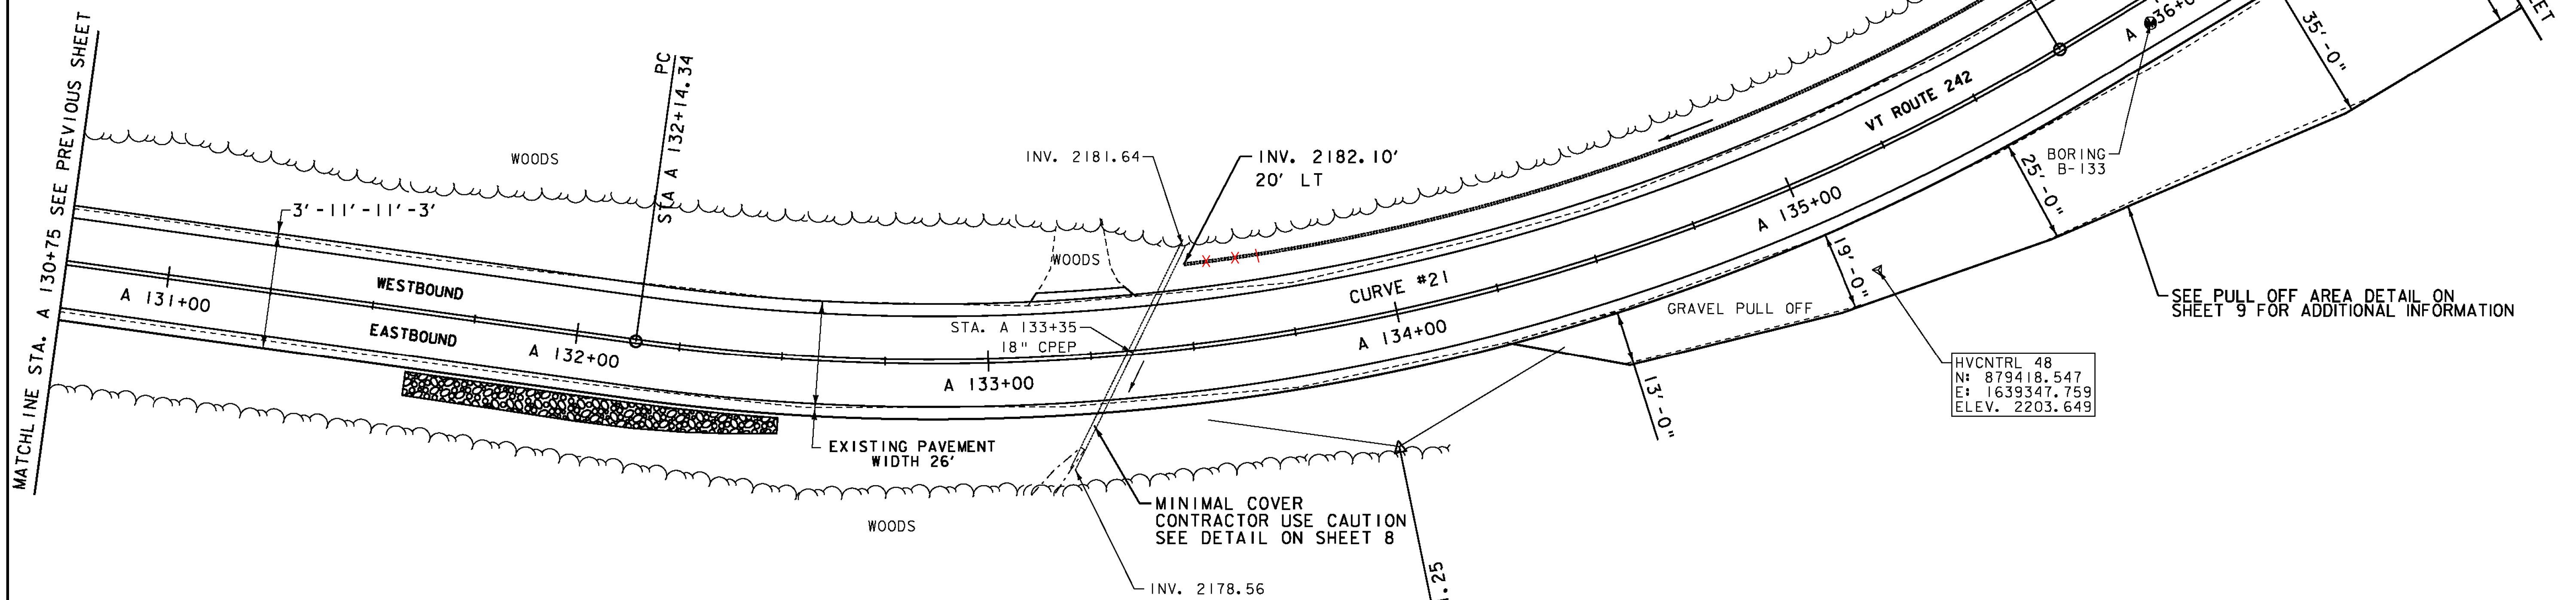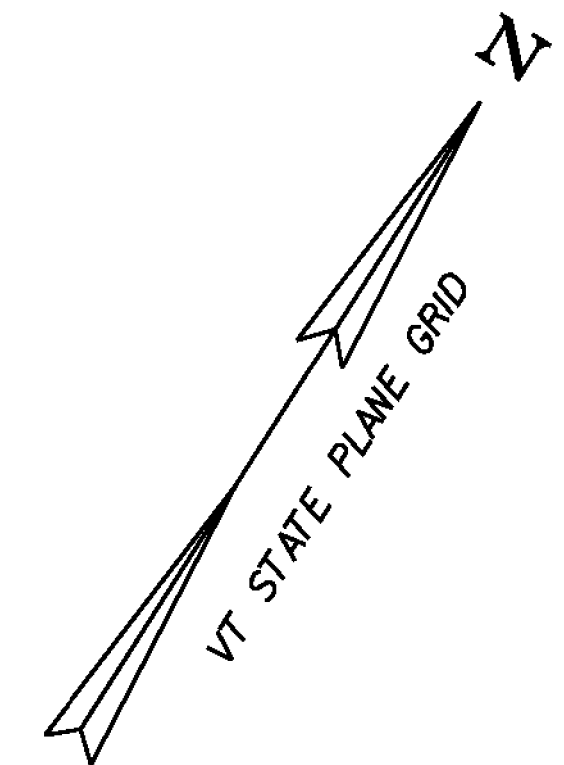

LEGEND

- MAILBOX
- BORING
- SIGN
- HYDRANT
- MANHOLE
- WATER SHUT OFF (WSO)
- GAS PIPELINE MARKER
- CATCH BASIN / DROP INLET
- CURB INLET
- TRAFFIC CONTROL BOX
- PARKING METER
- UTILITY POLE

SIGN LEGEND

- R = REMOVE
- R&S = REMOVE AND SALVAGE
- RET = RETAIN
- S = SALVAGED
- N = NEW
- B-B = BACK TO BACK
- = EXISTING
- = NEW

DATUM

NAVD 88
NAD 83

PROJECT LAYOUT SHEET 60	PROJECT NAME: MONTGOMERY-WESTFIELD
	PROJECT NUMBER: STP 2906(1)
FILE NAME: piOC190.dgn	PLOT DATE: 9/5/12
PROJECT LEADER: CDL	DRAWN BY: SJL
DESIGNED BY: SJL	CHECKED BY: EPD
PLOT FILE: piOC190_8IA.1	SHEET 8IA OF 178



SEH
 2-24-14