



1+50

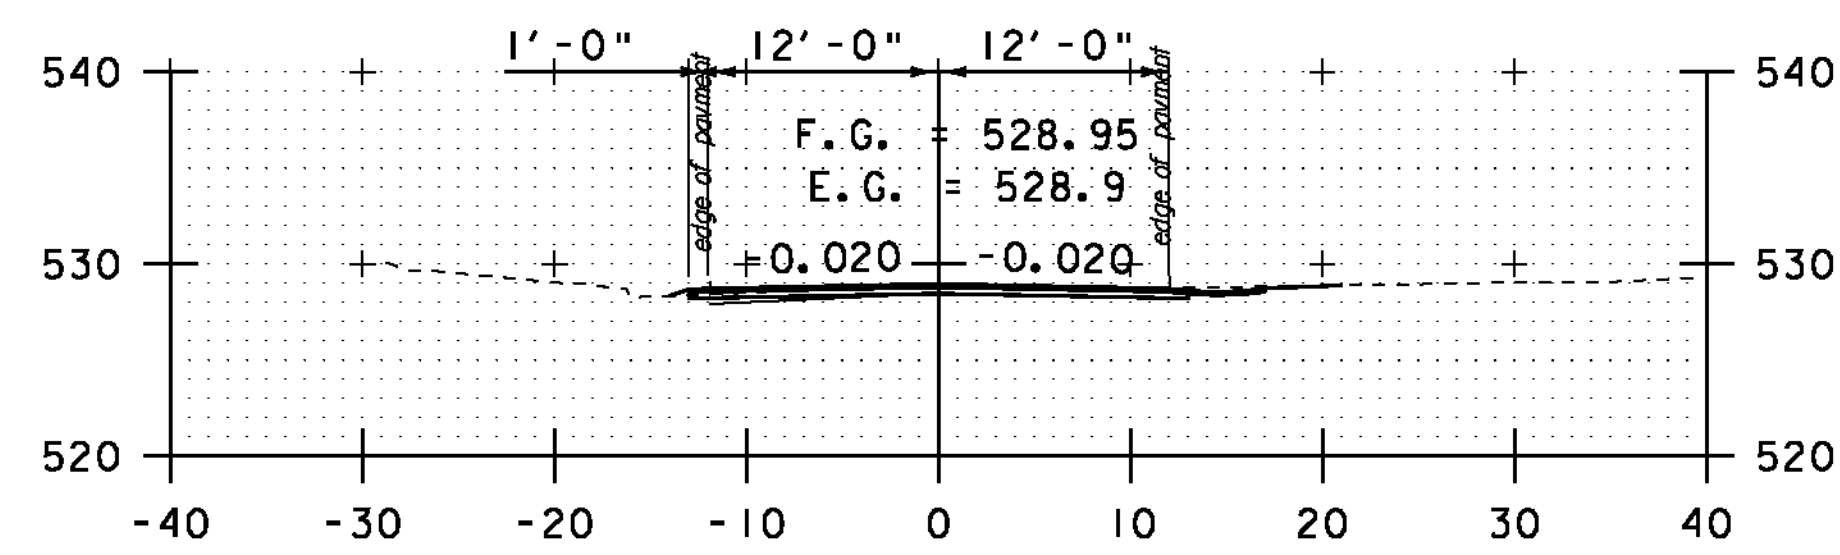


DRIVE RT

1+00

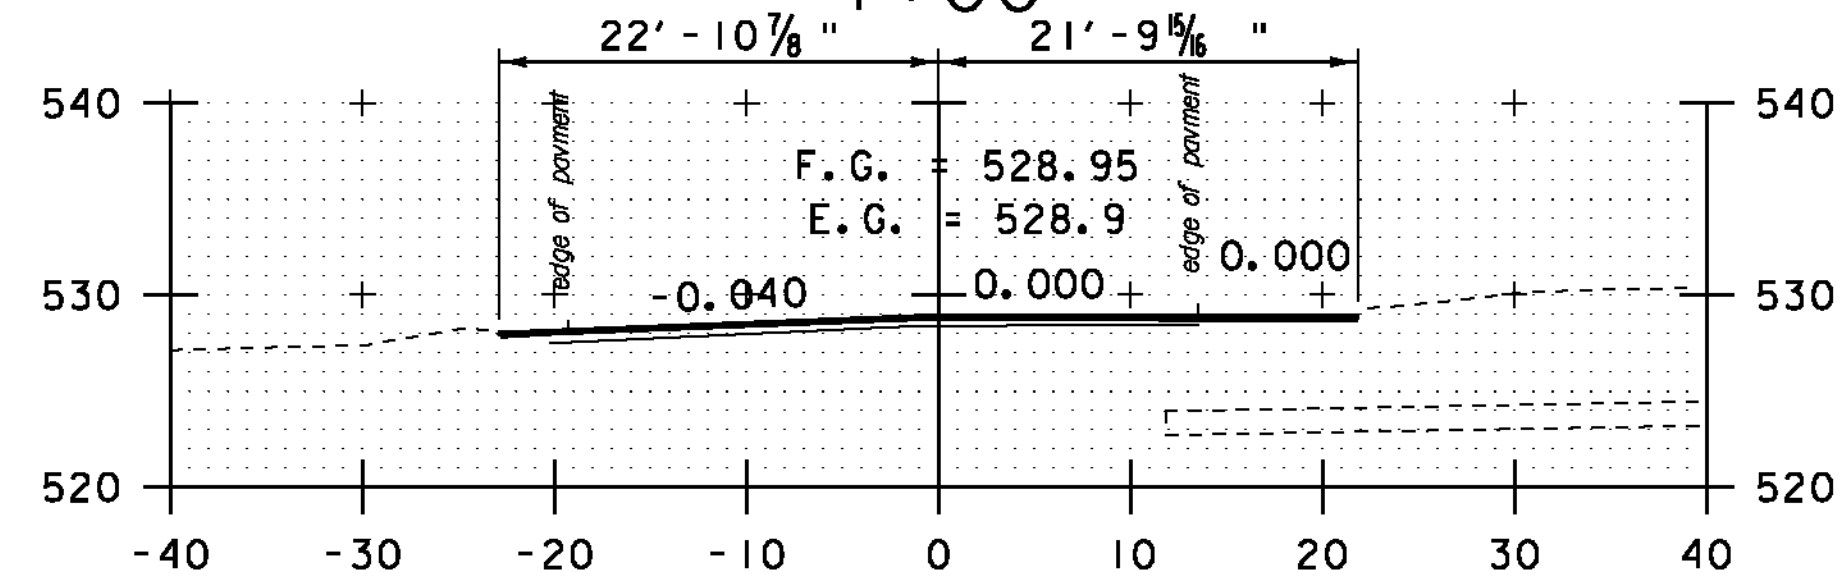


MATCH EXISTING  
0+20  
BEGIN PROJECT

0+50

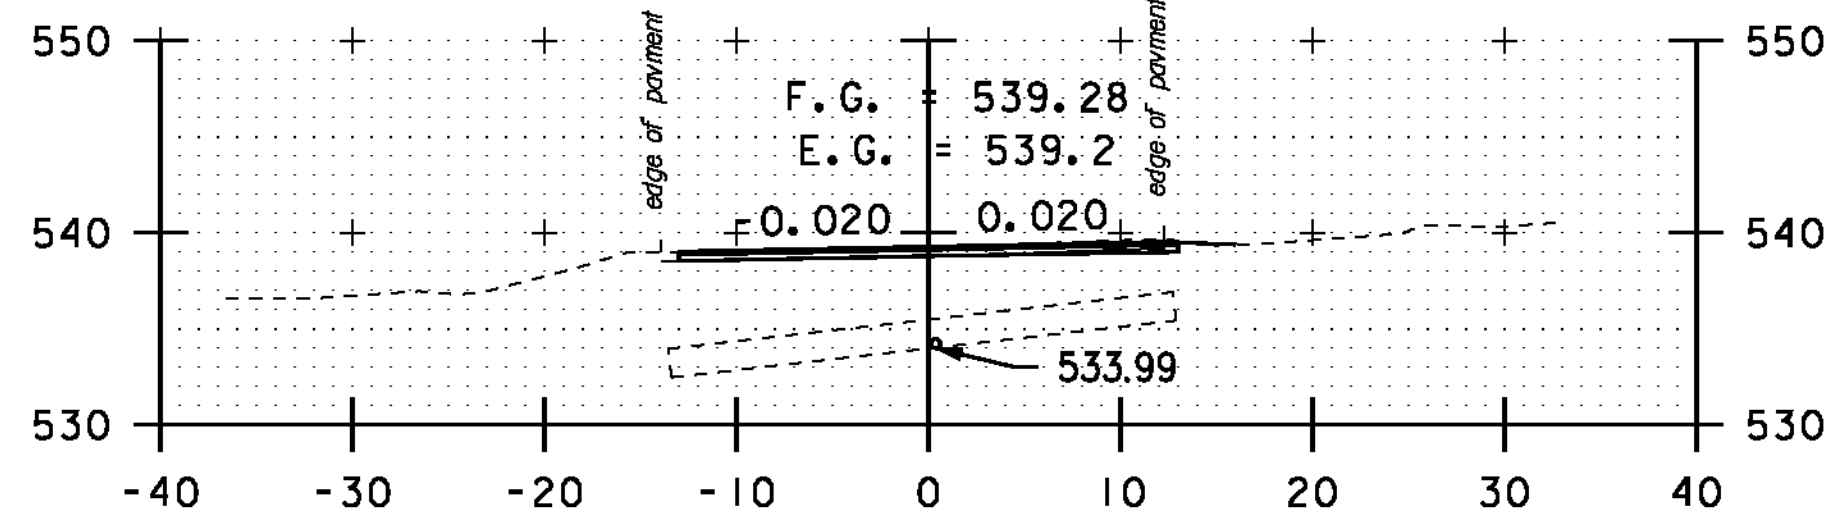


DRIVE RT

3+50

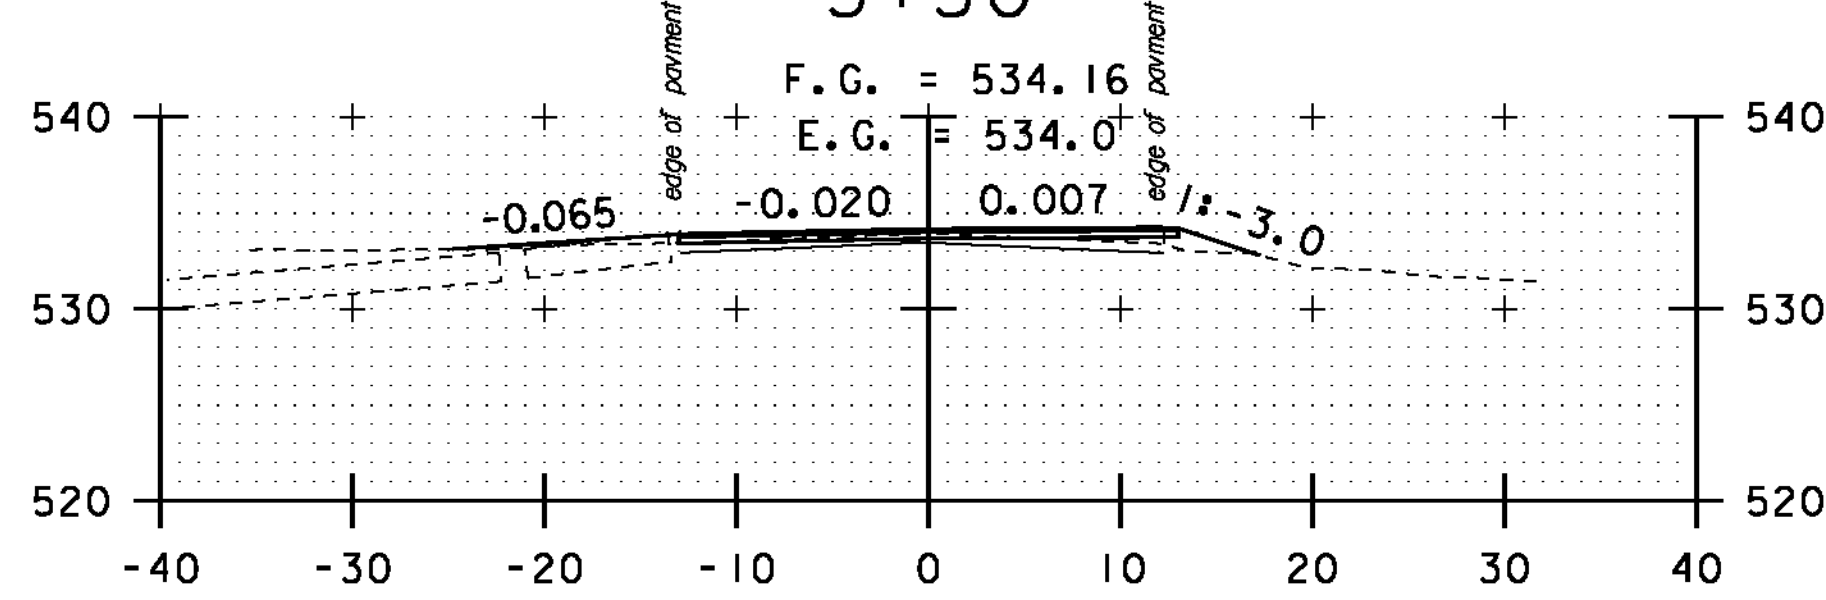


DRIVE LT

3+00

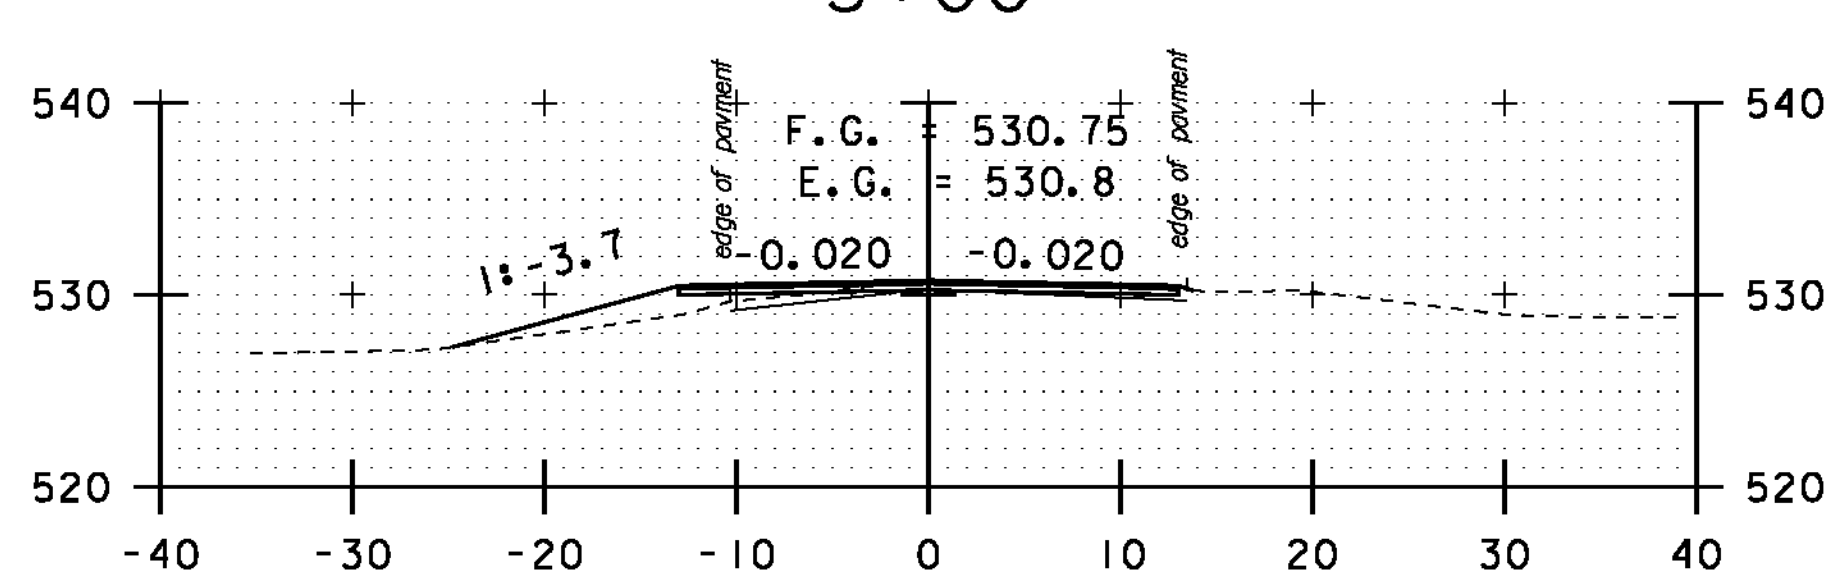


DRIVE LT


2+50

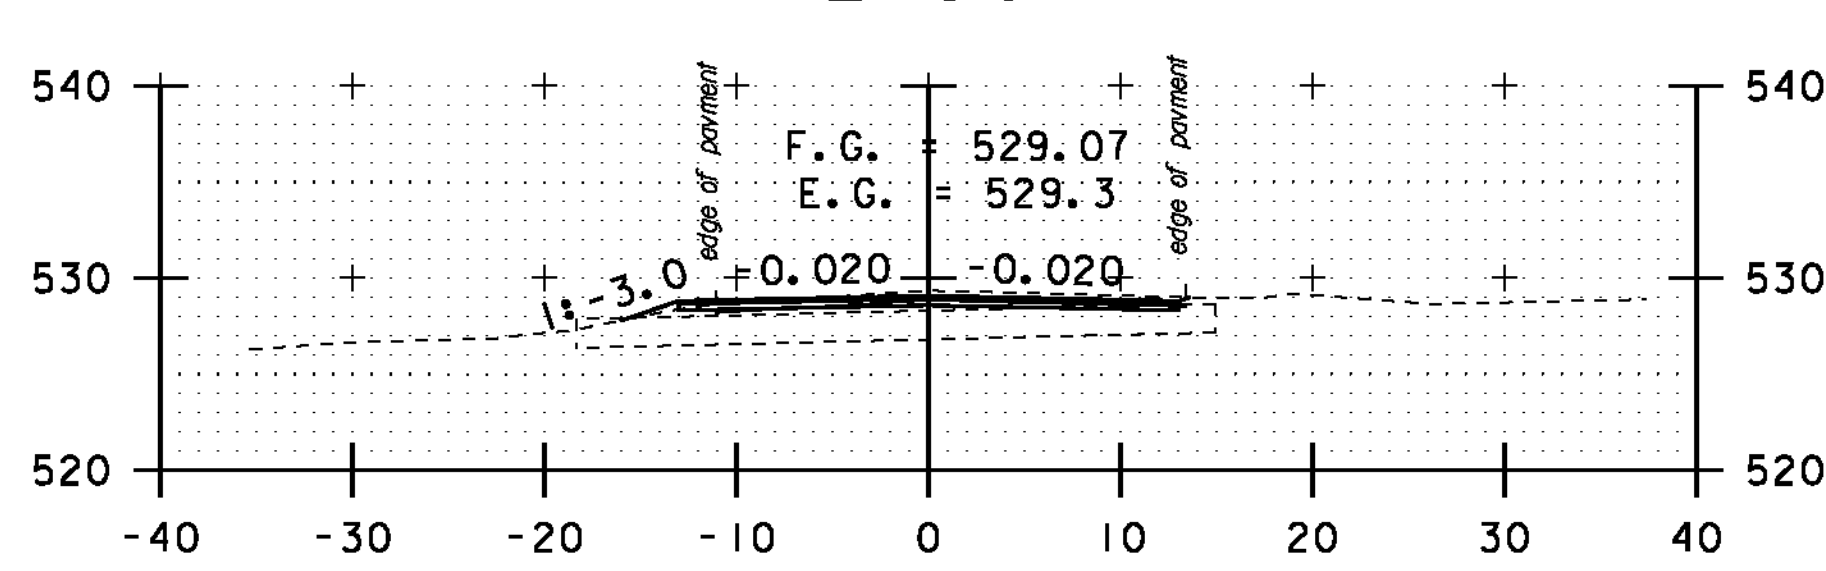


2+00

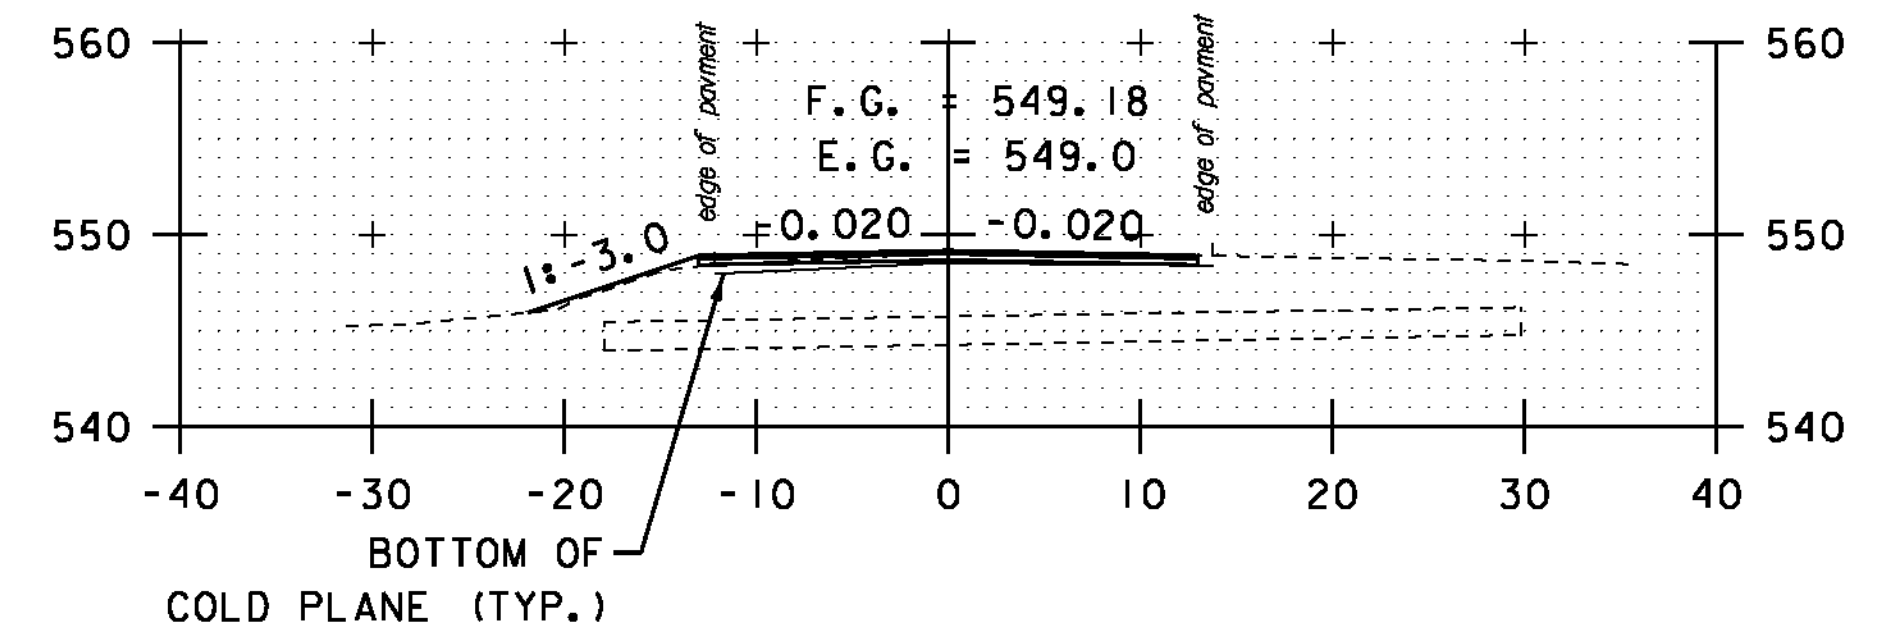

5+50

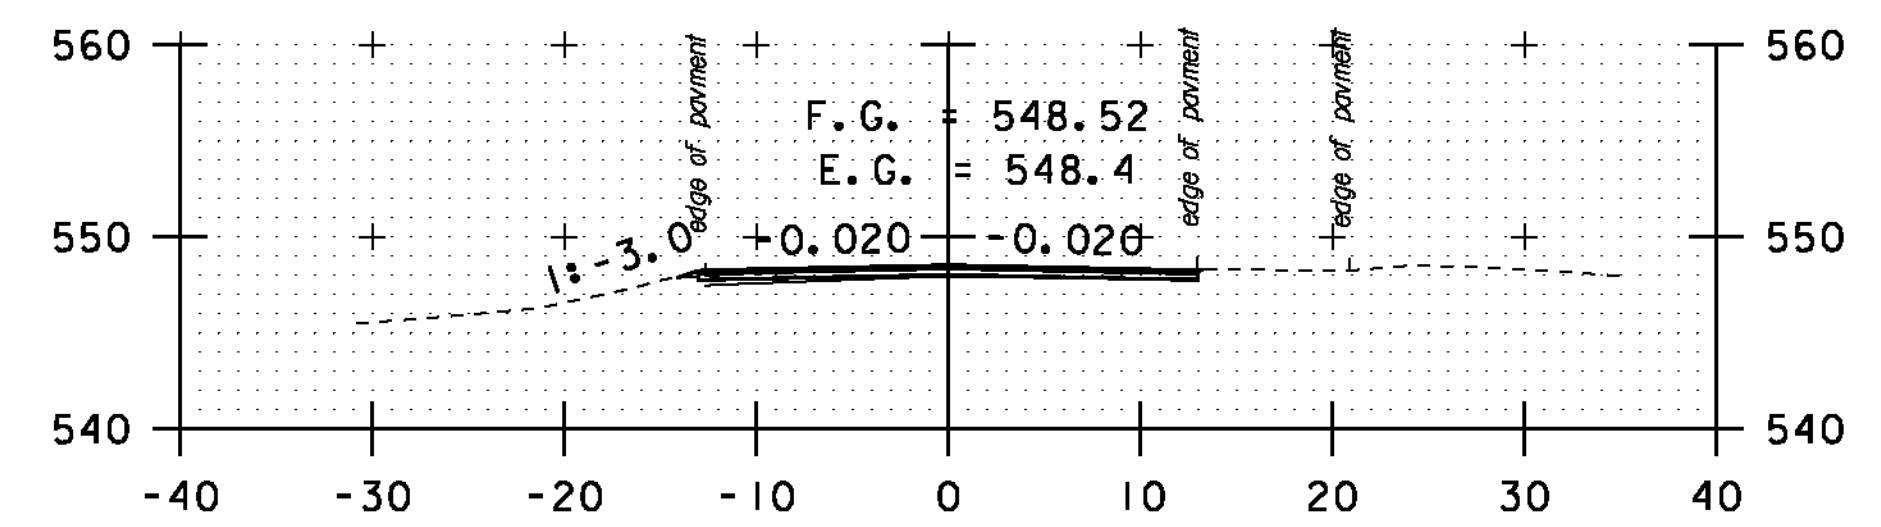


5+00

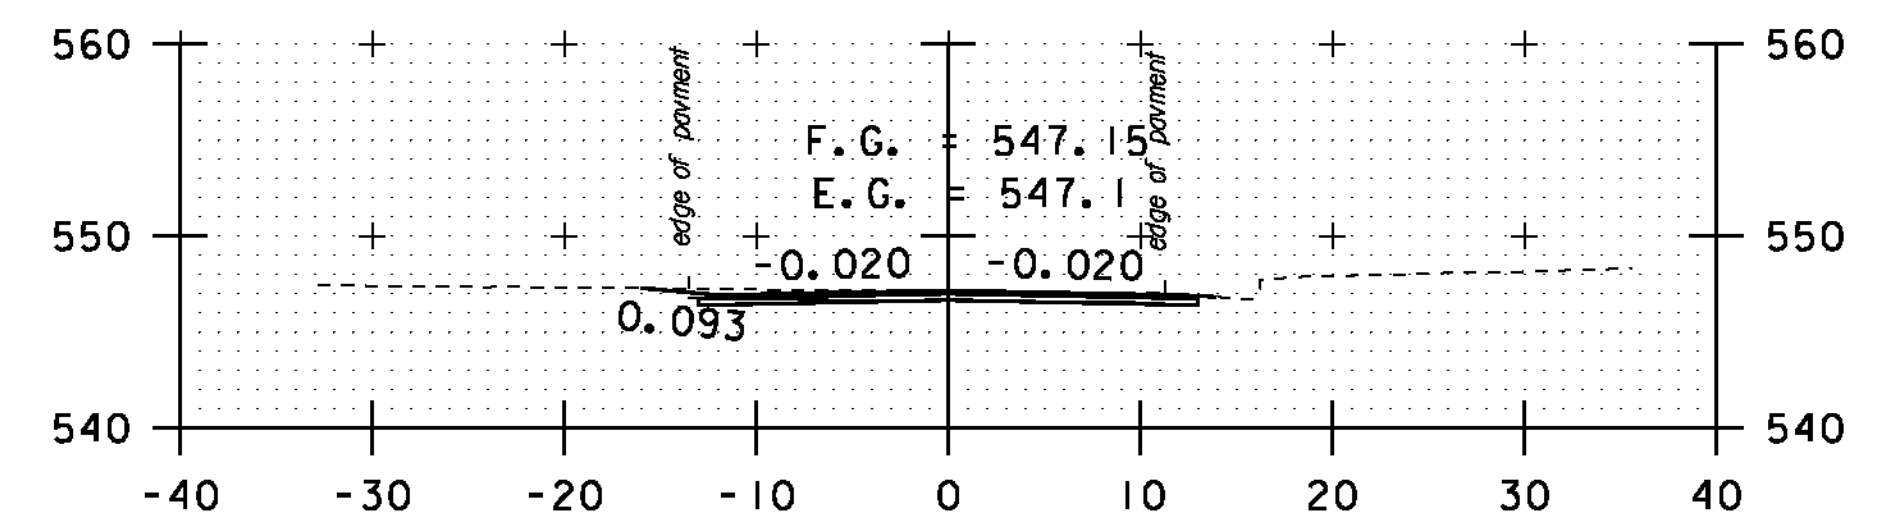

DRIVE LT

4+50

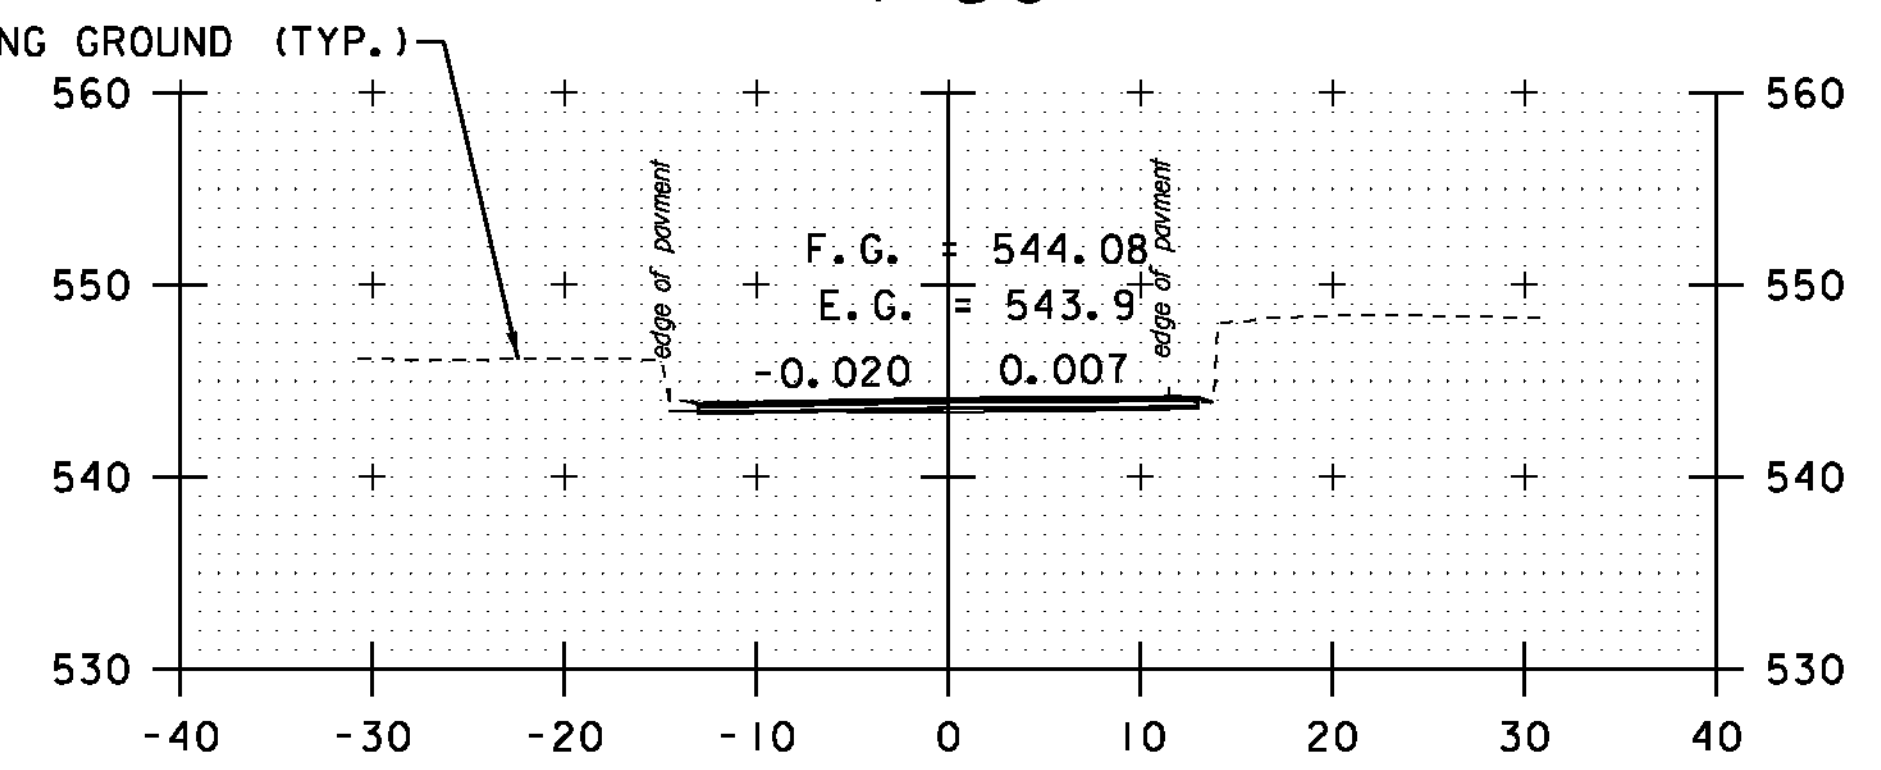

4+00

STA. 0+20 TO STA. 5+50



**CROSS SECTION SHEET 1**

PROJECT NAME: MONTGOMERY-WESTFIELD  
PROJECT NUMBER: STP 2906(I)  
FILE NAME: p10CI90.dgn  
PROJECT LEADER: CDL  
DESIGNED BY: SJL  
PLOT FILE: p10CI90.I16A.1  
PLOT DATE: 9/5/12  
DRAWN BY: SJL  
CHECKED BY: CDL  
SHEET 116A OF 178