




33+50

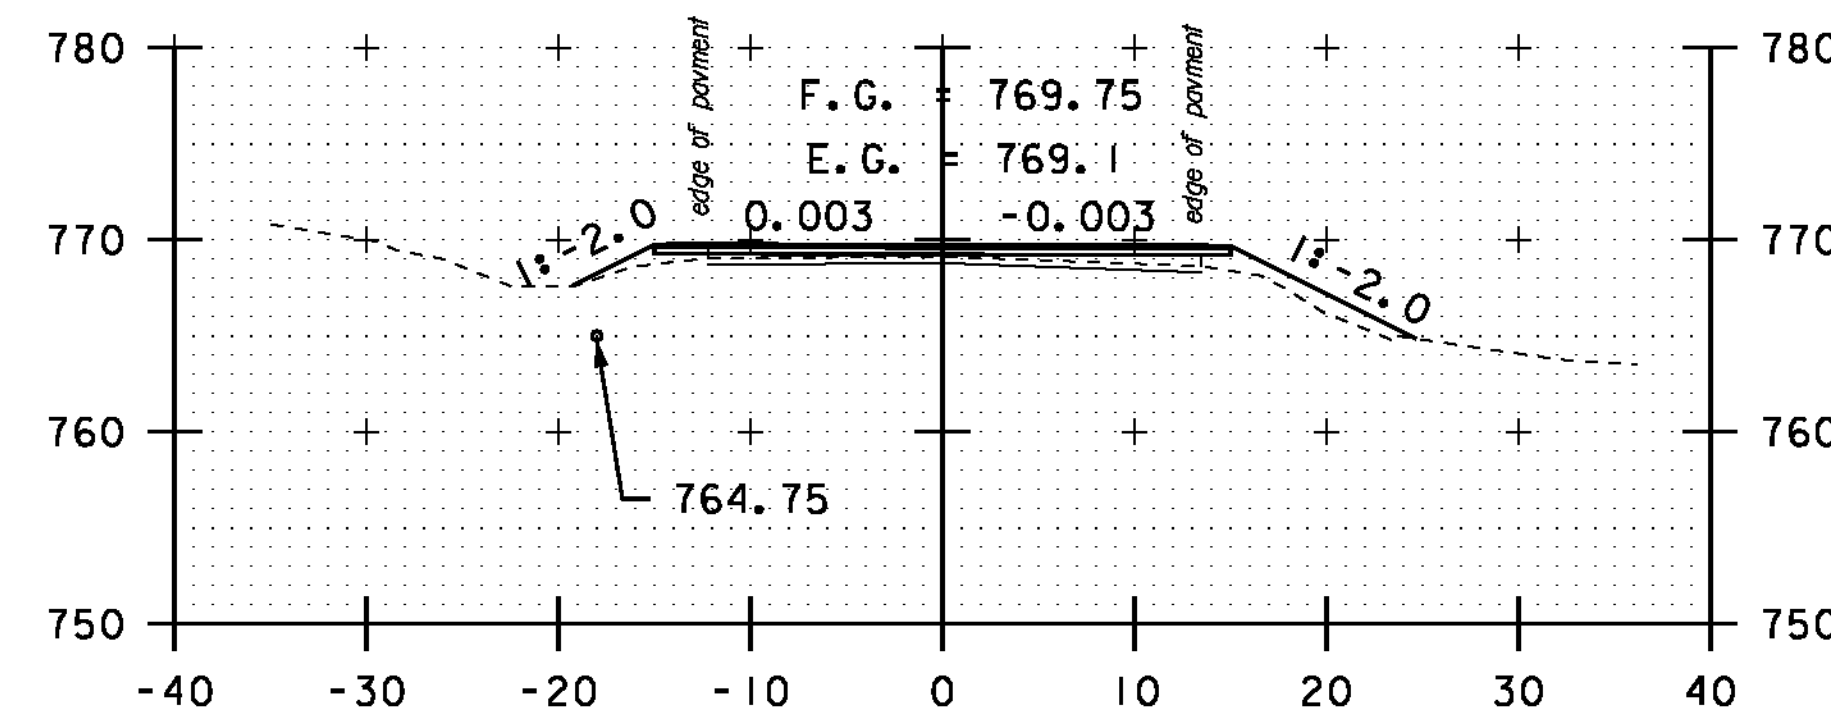


35+00

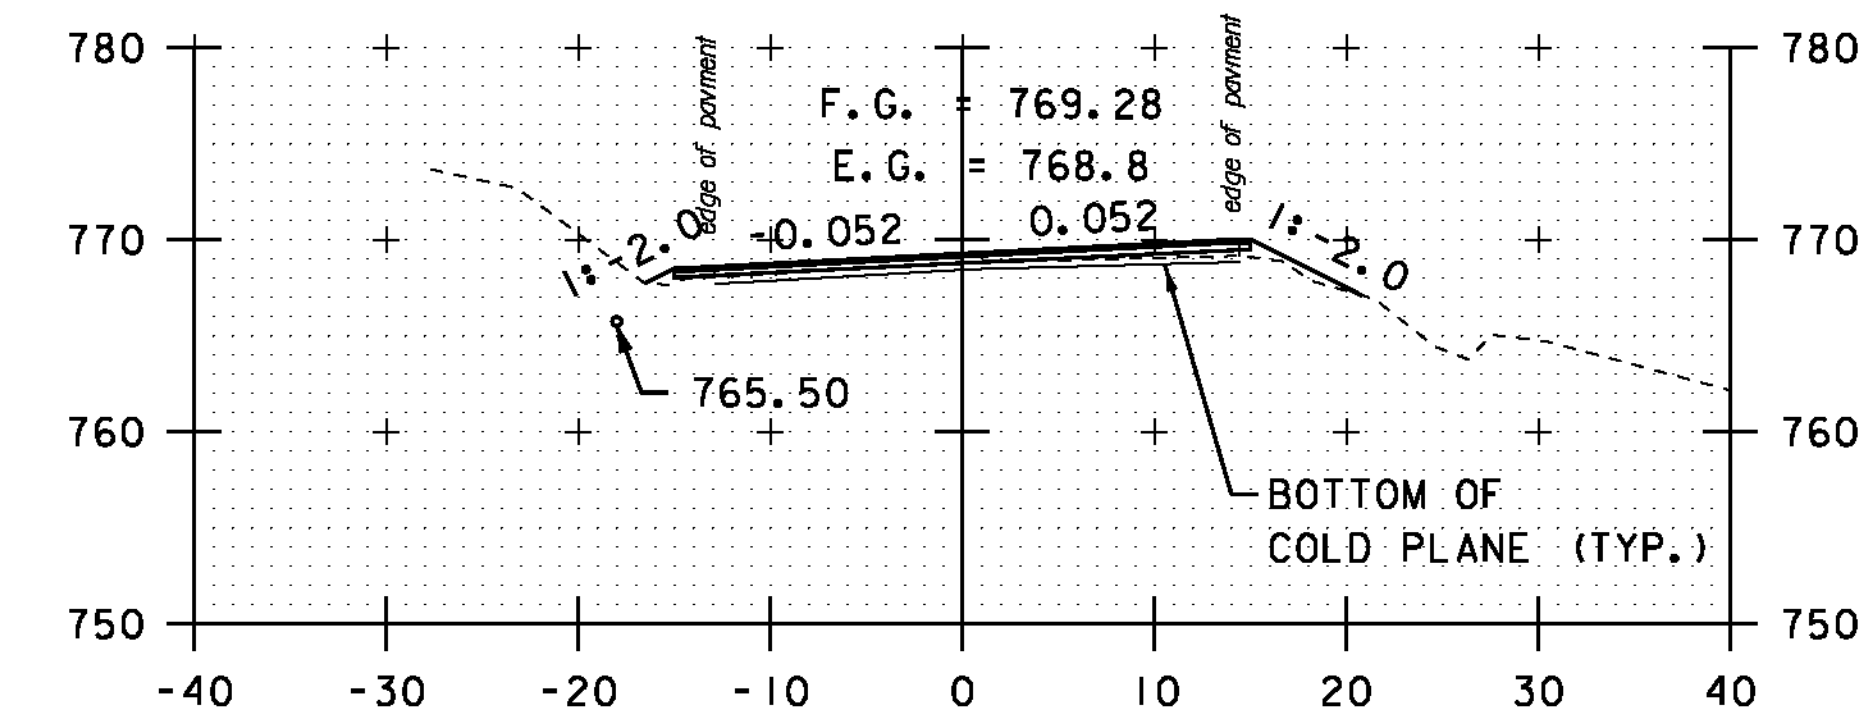


36+50

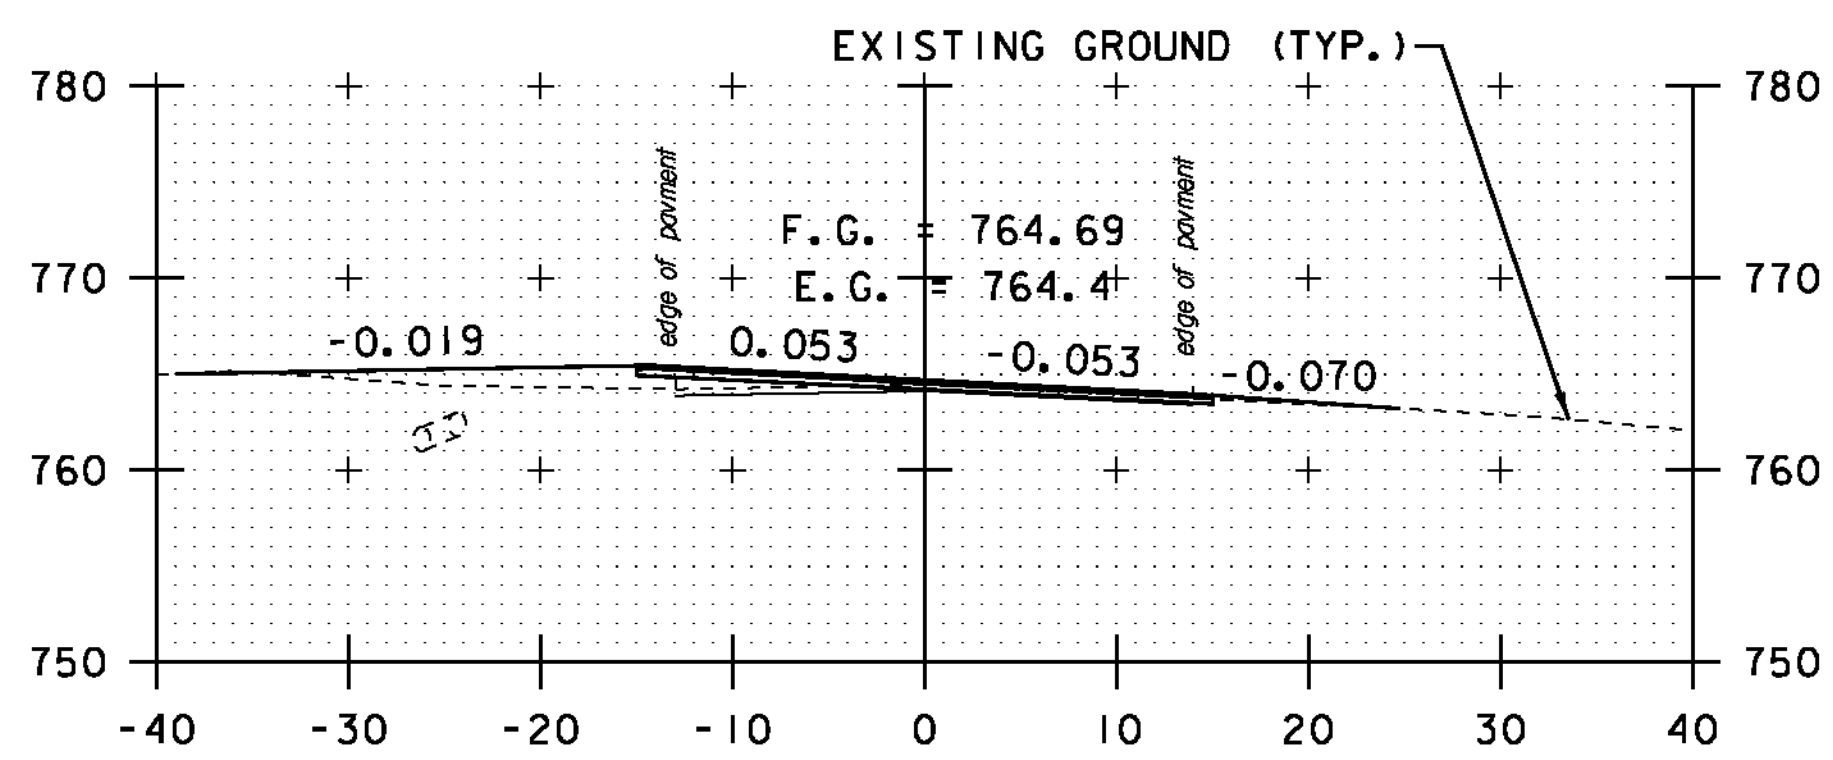


TH #5 LT/ DRIVE RT  
33+15

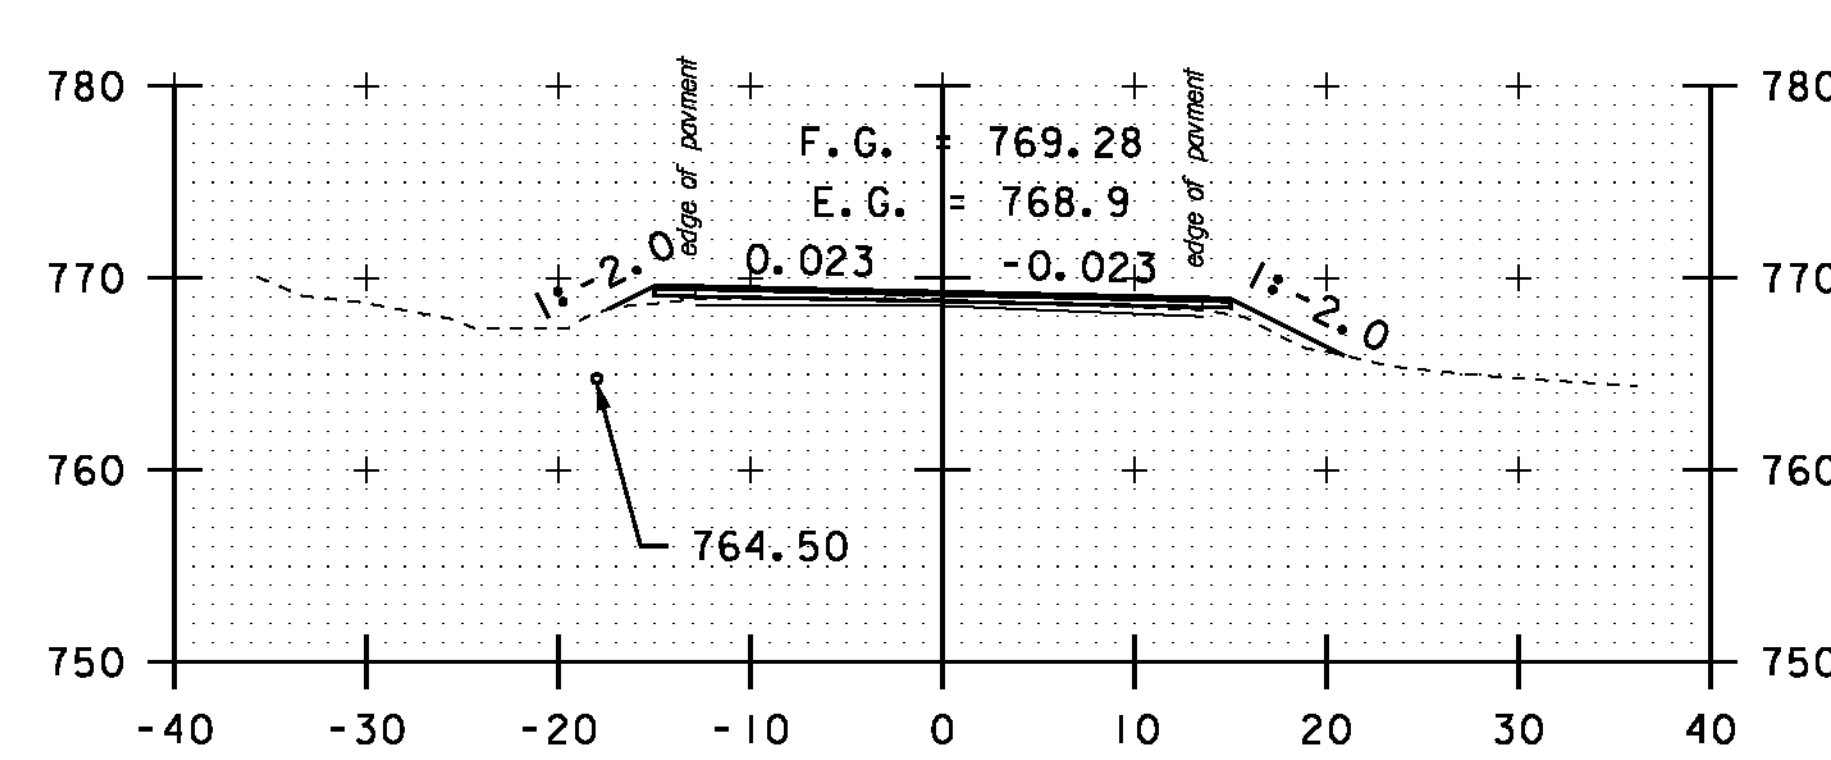


34+50

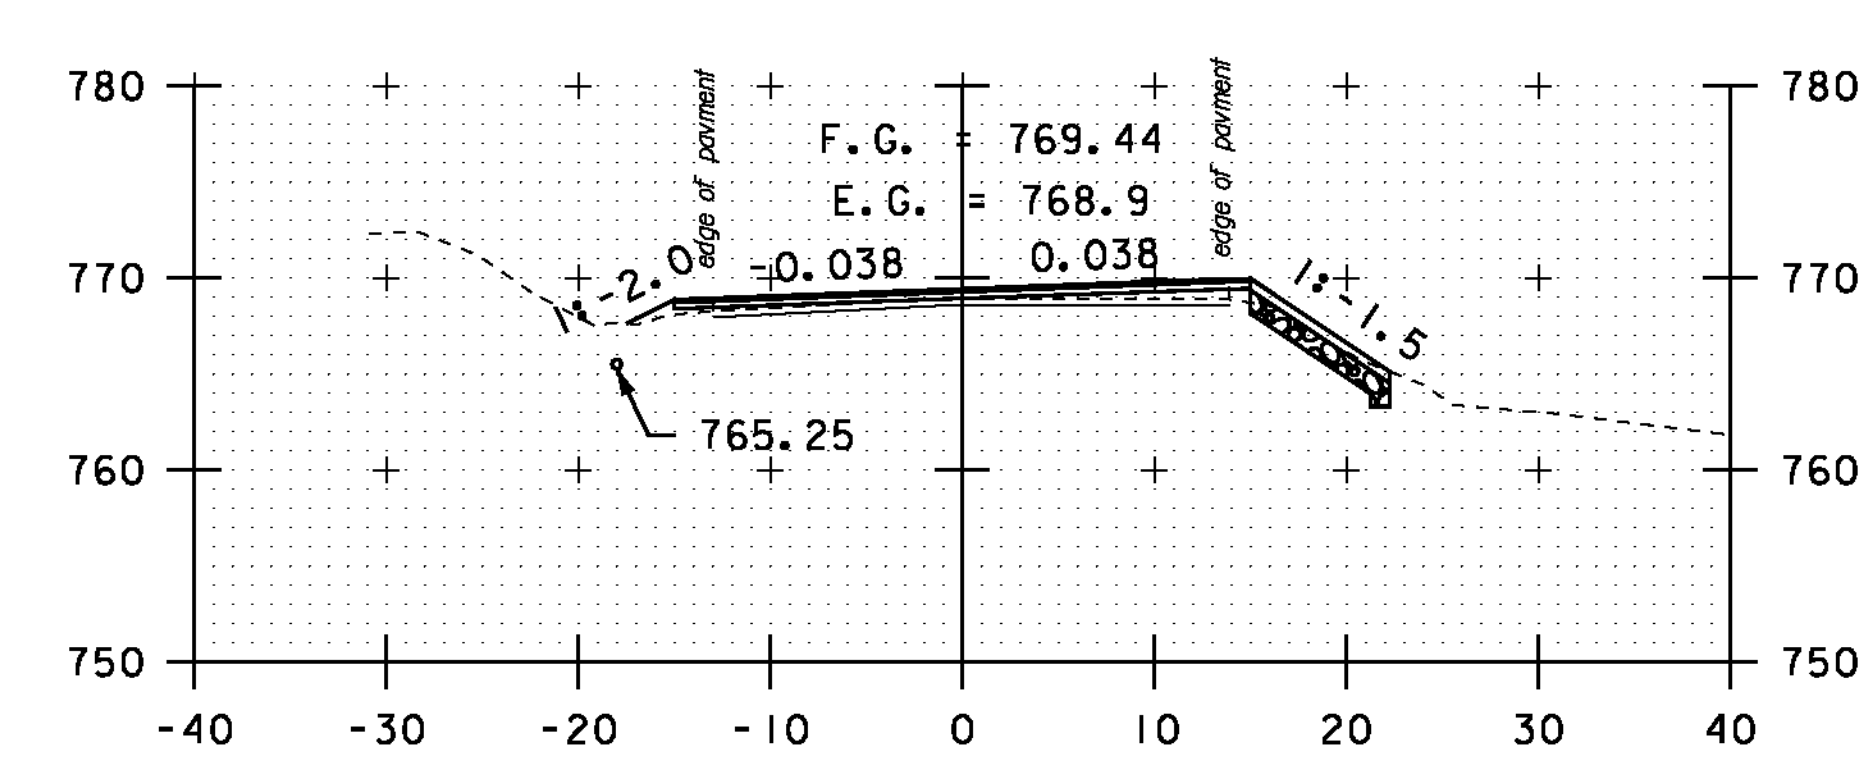


36+00

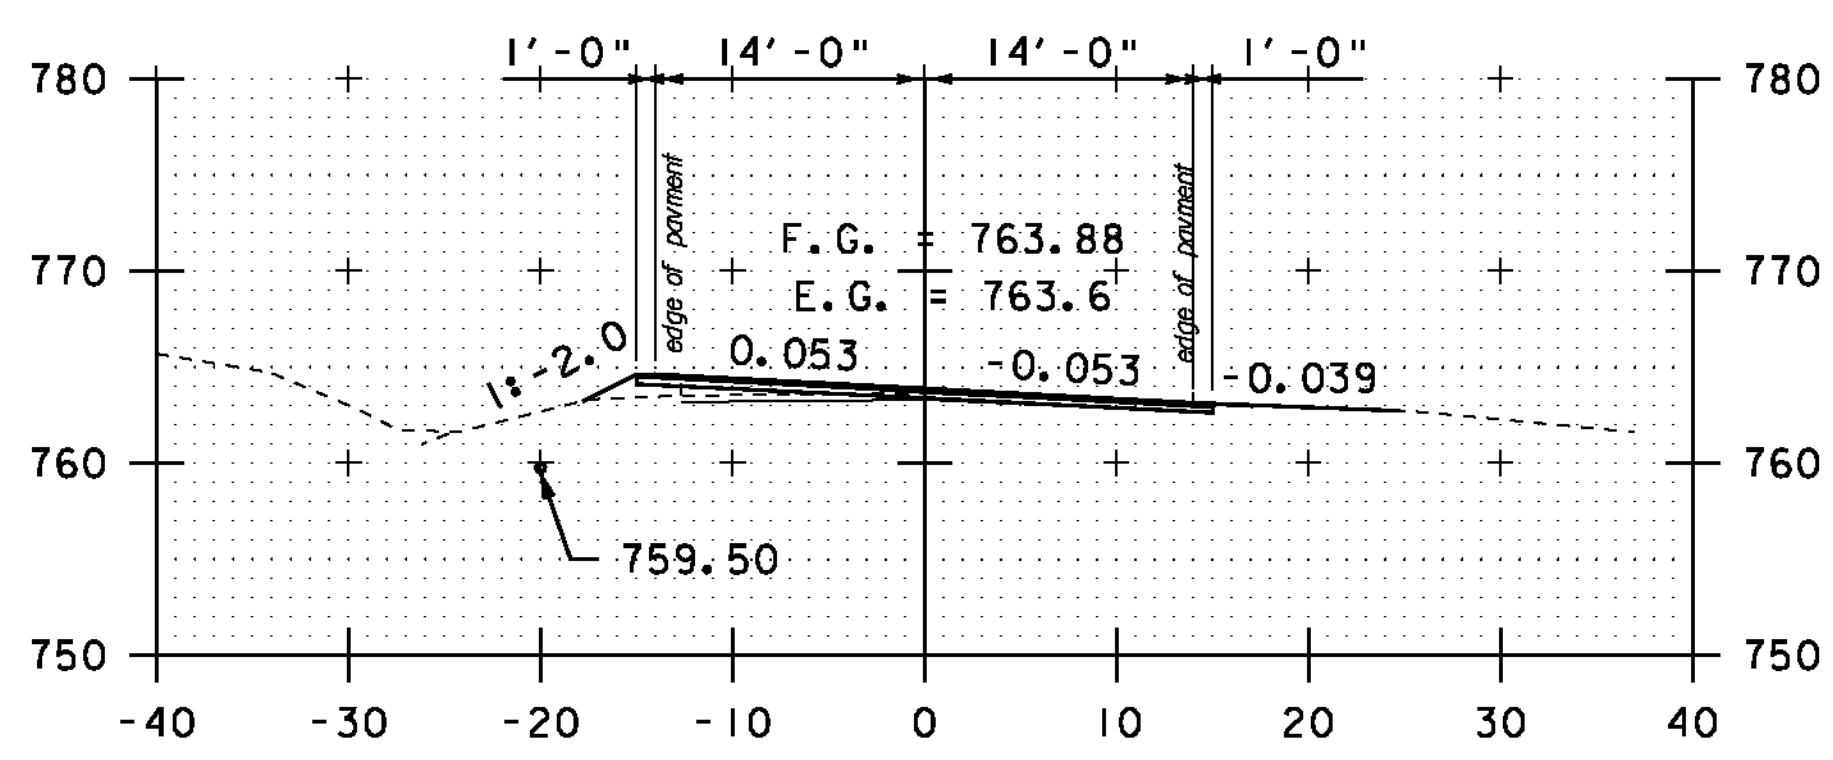

DRIVE RT  
33+00

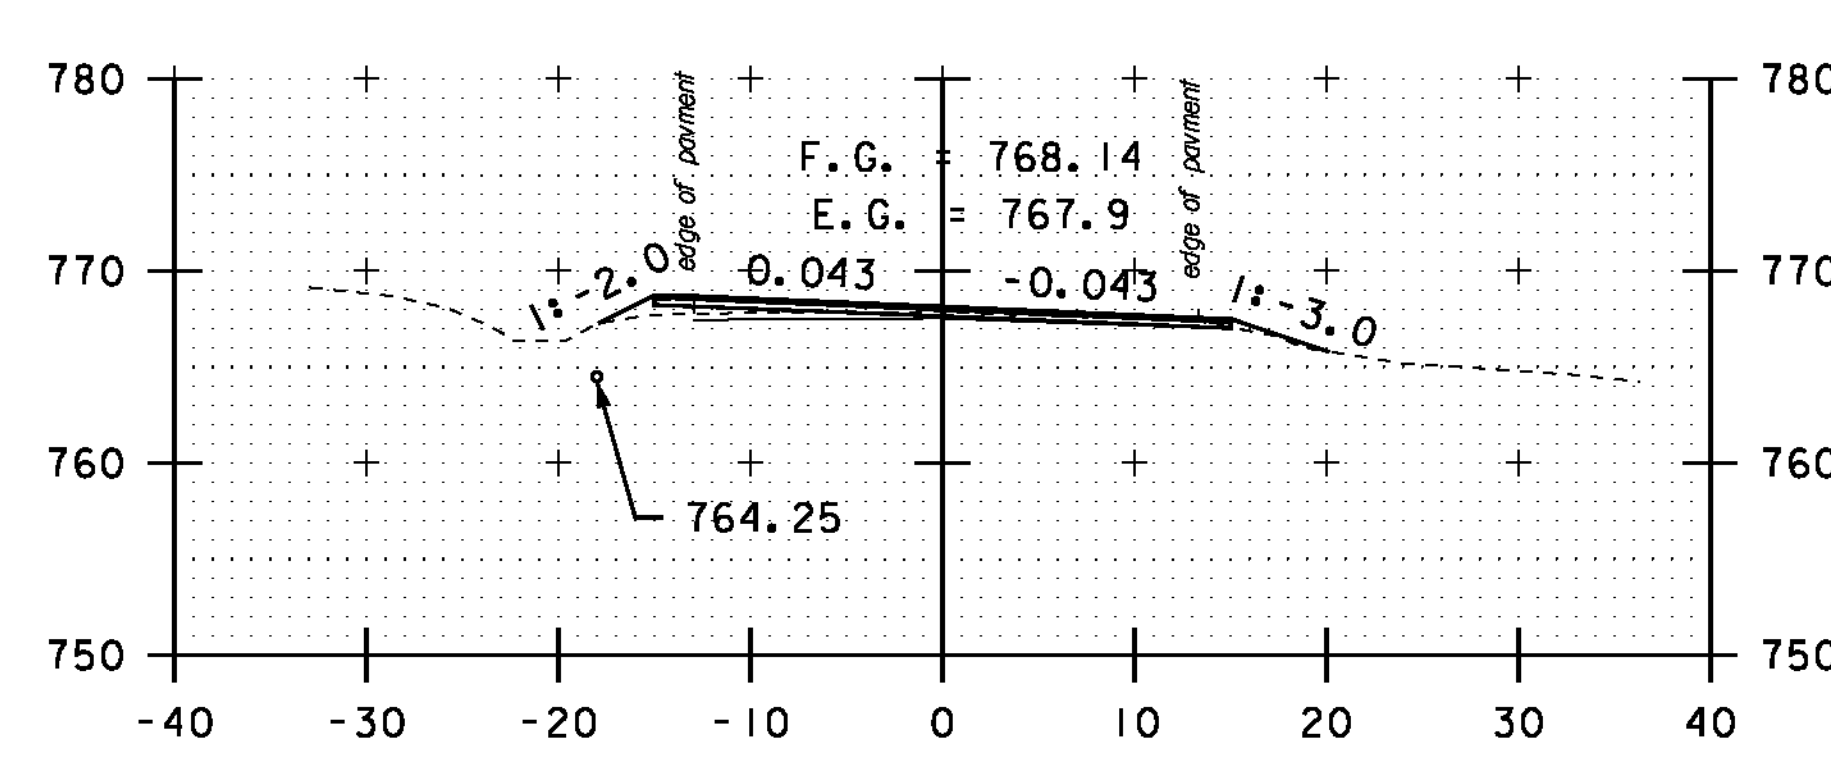


34+00

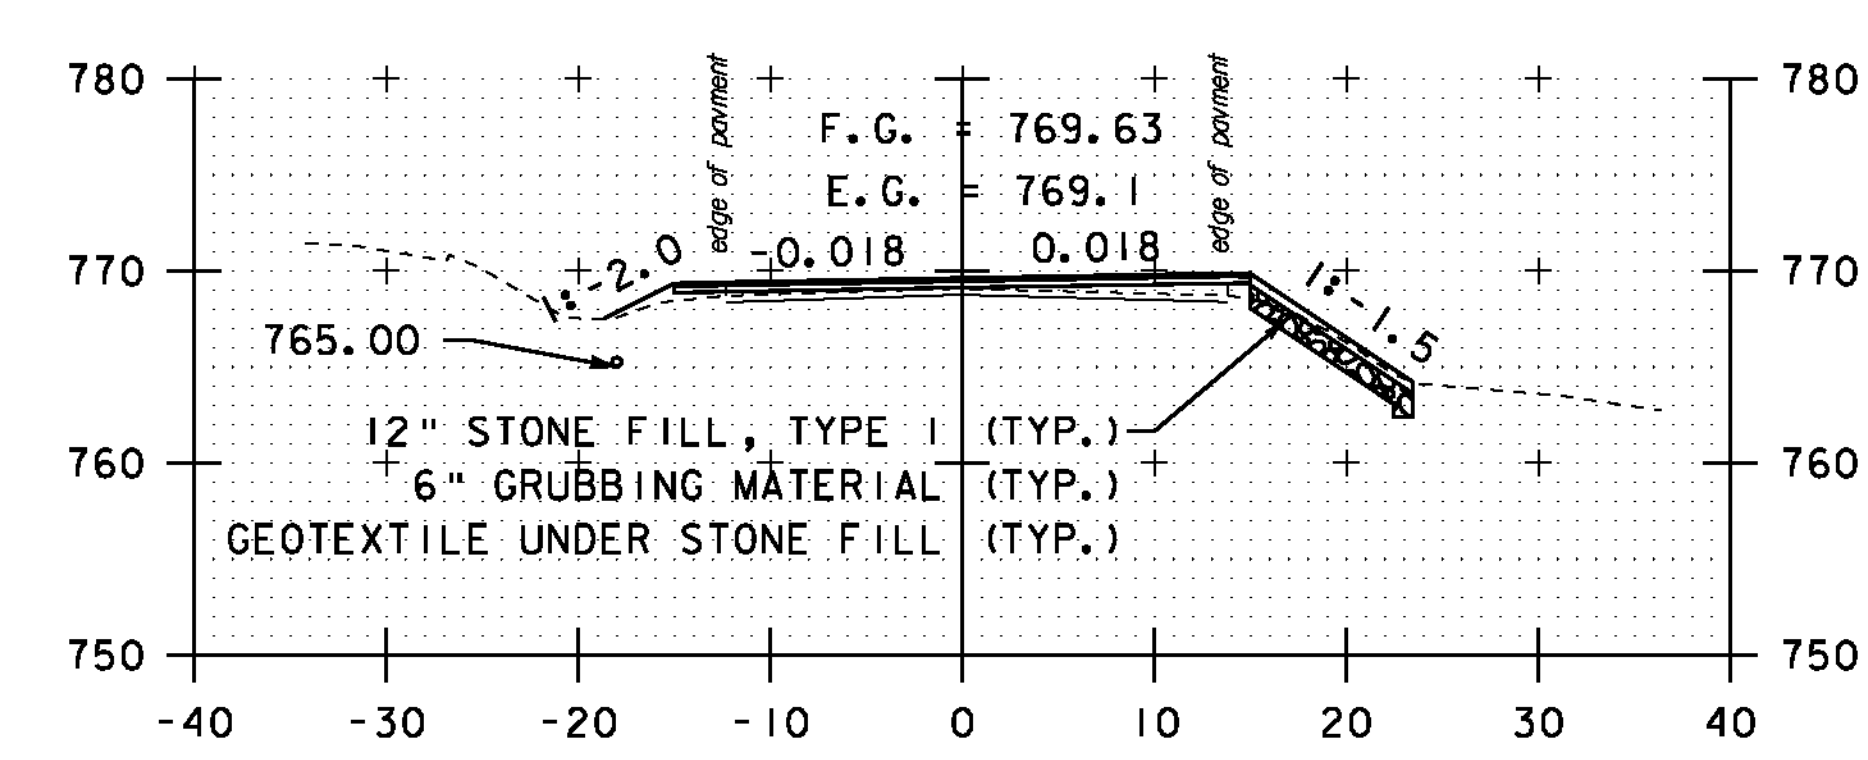

35+50

STA. 33+00 TO STA. 36+50

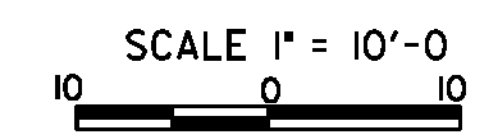

<b>CROSS SECTION SHEET 7</b>	PROJECT NAME: MONTGOMERY-WESTFIELD	PLOT DATE: 9/5/12
	PROJECT NUMBER: STP 2906(1)	DRAWN BY: SJL
	FILE NAME: p10ci90.dgn	CHECKED BY: CDL
	DESIGNED BY: SJL	SHEET 121 OF 178
	PLOT FILE: p10ci90_121.I	