


STA. 51+50 TO STA. 56+00

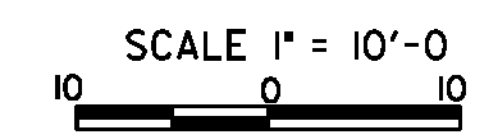

<b>CROSS SECTION SHEET 11</b>	PROJECT NAME: MONTGOMERY-WESTFIELD	PLOT DATE: 9/5/12
	PROJECT NUMBER: STP 2906(I)	DRAWN BY: SJL
	FILE NAME: p10ci90.dgn	CHECKED BY: CDL
	DESIGNED BY: SJL	SHEET 125 OF 178
	PLOT FILE: p10ci90.i25.l	