




58+00

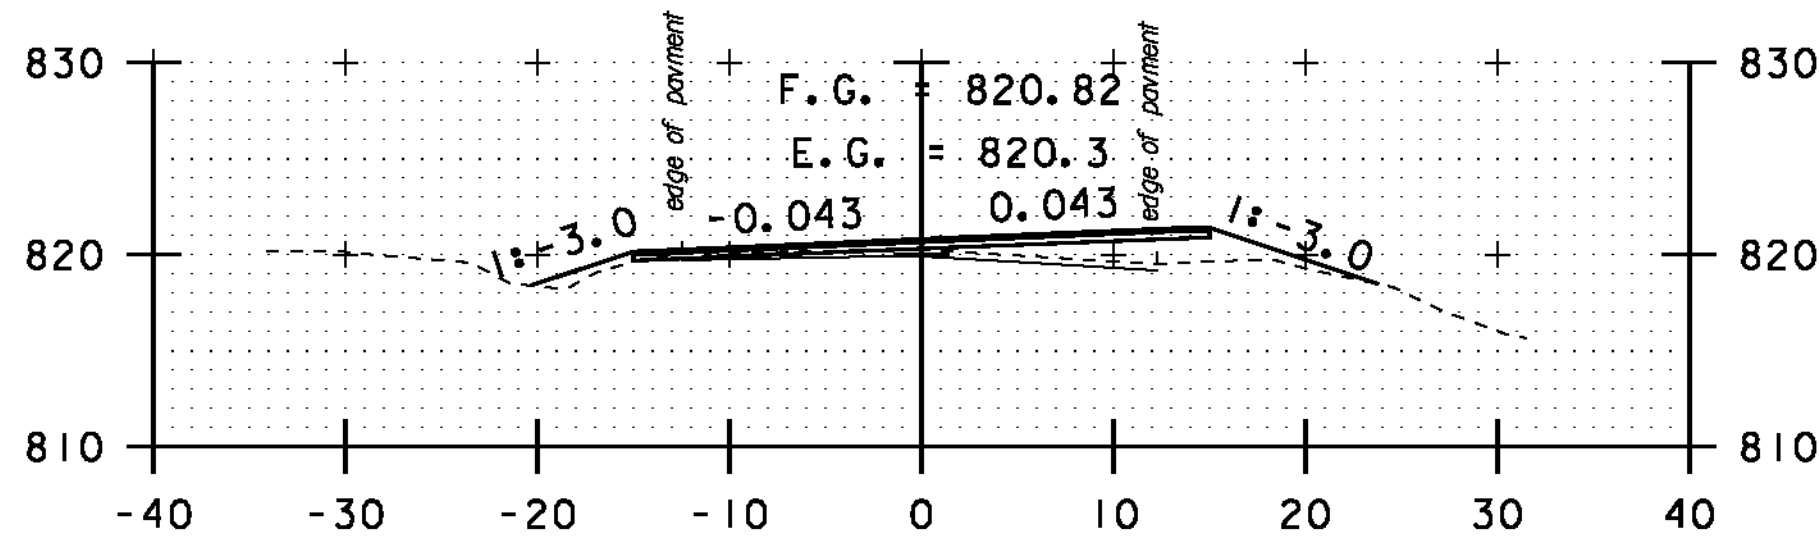


60+00

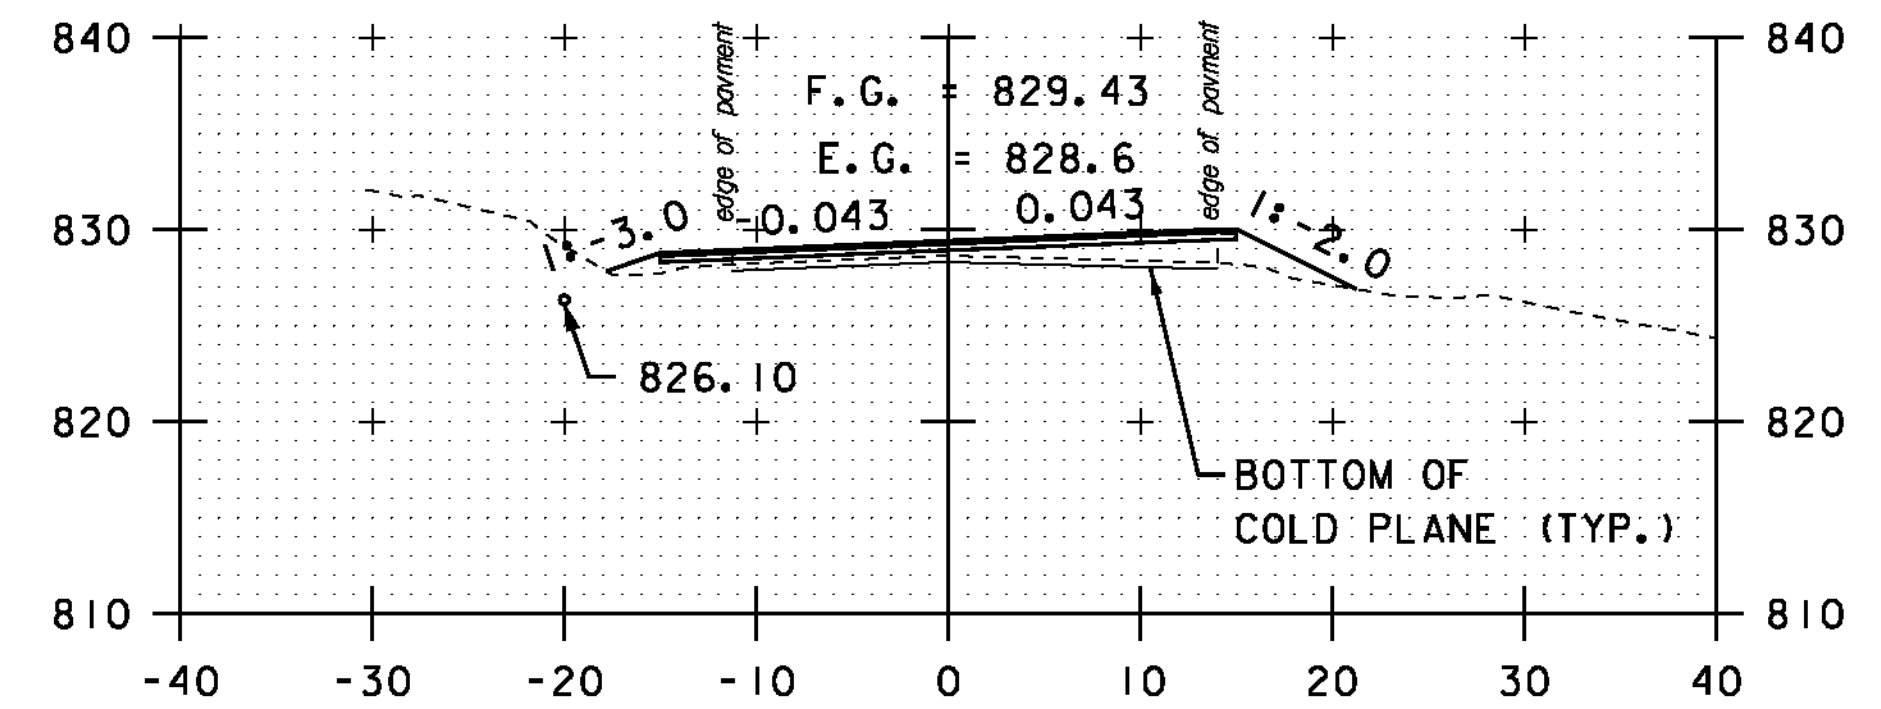



61+50

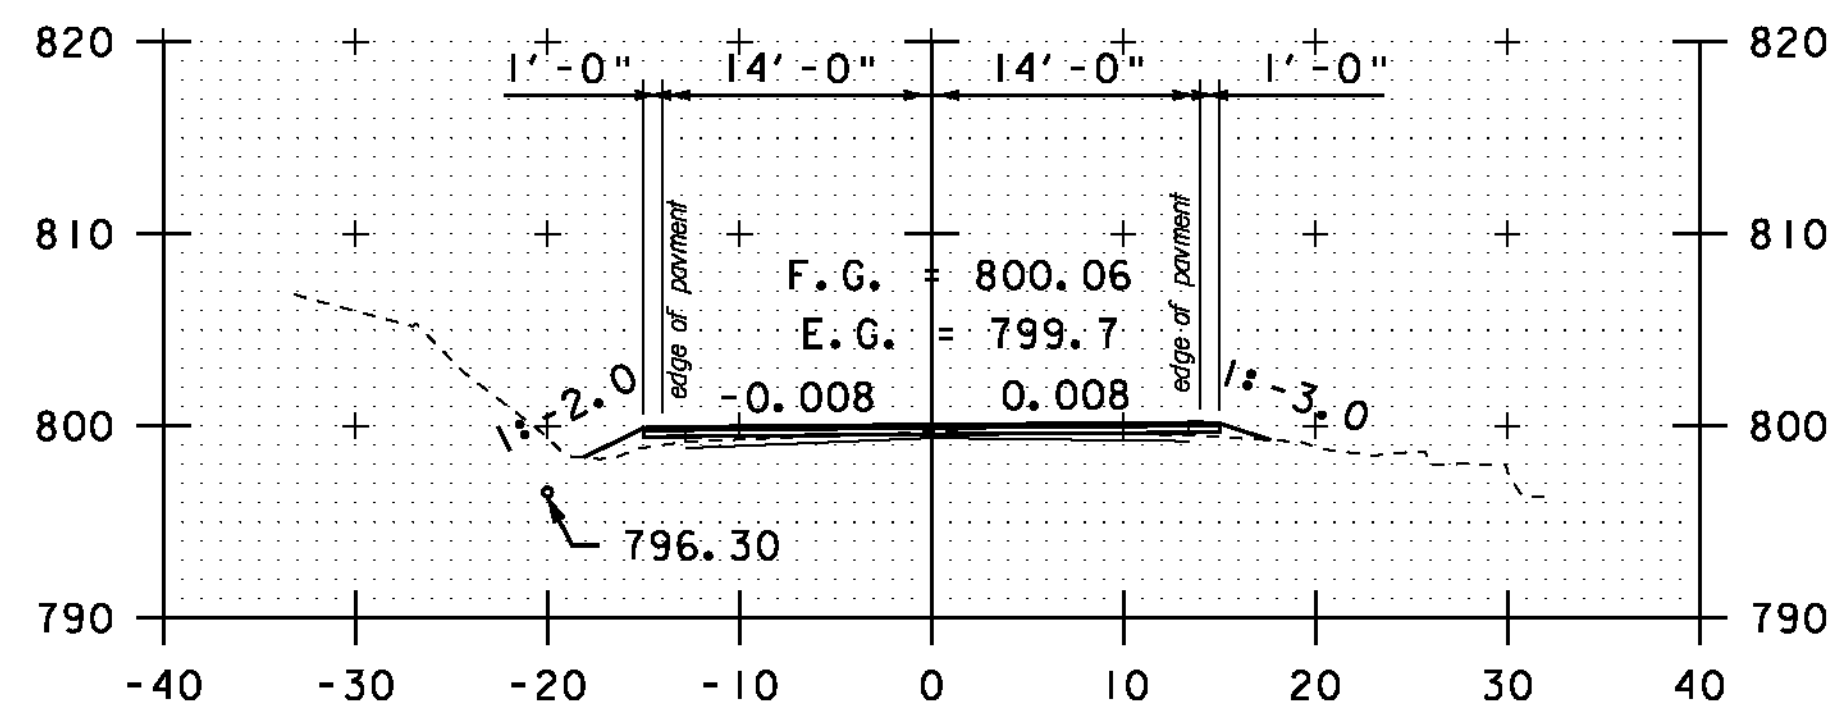


57+50

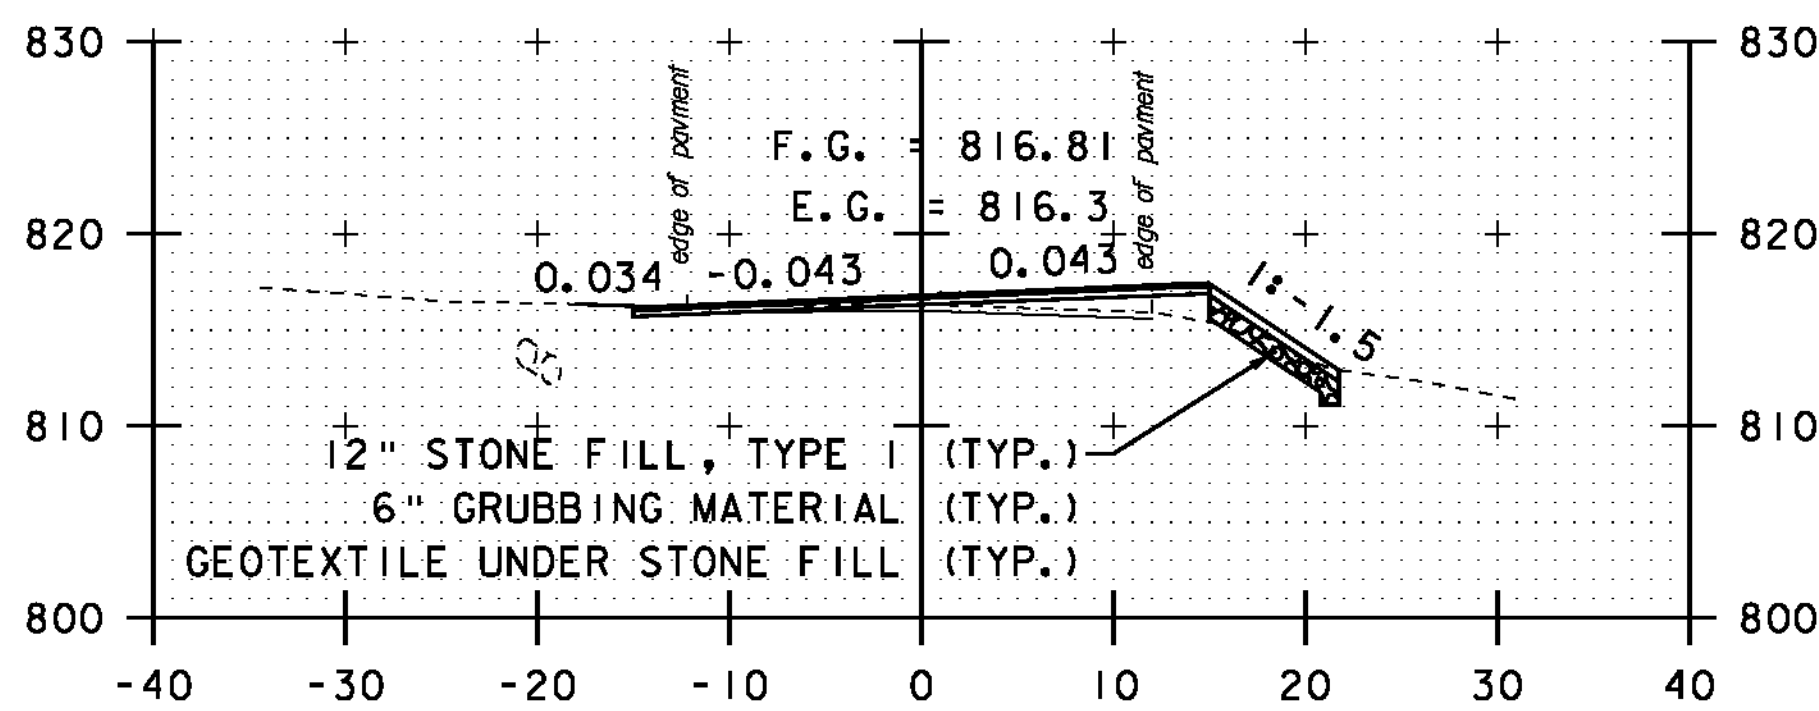



DRIVE LT
59+50

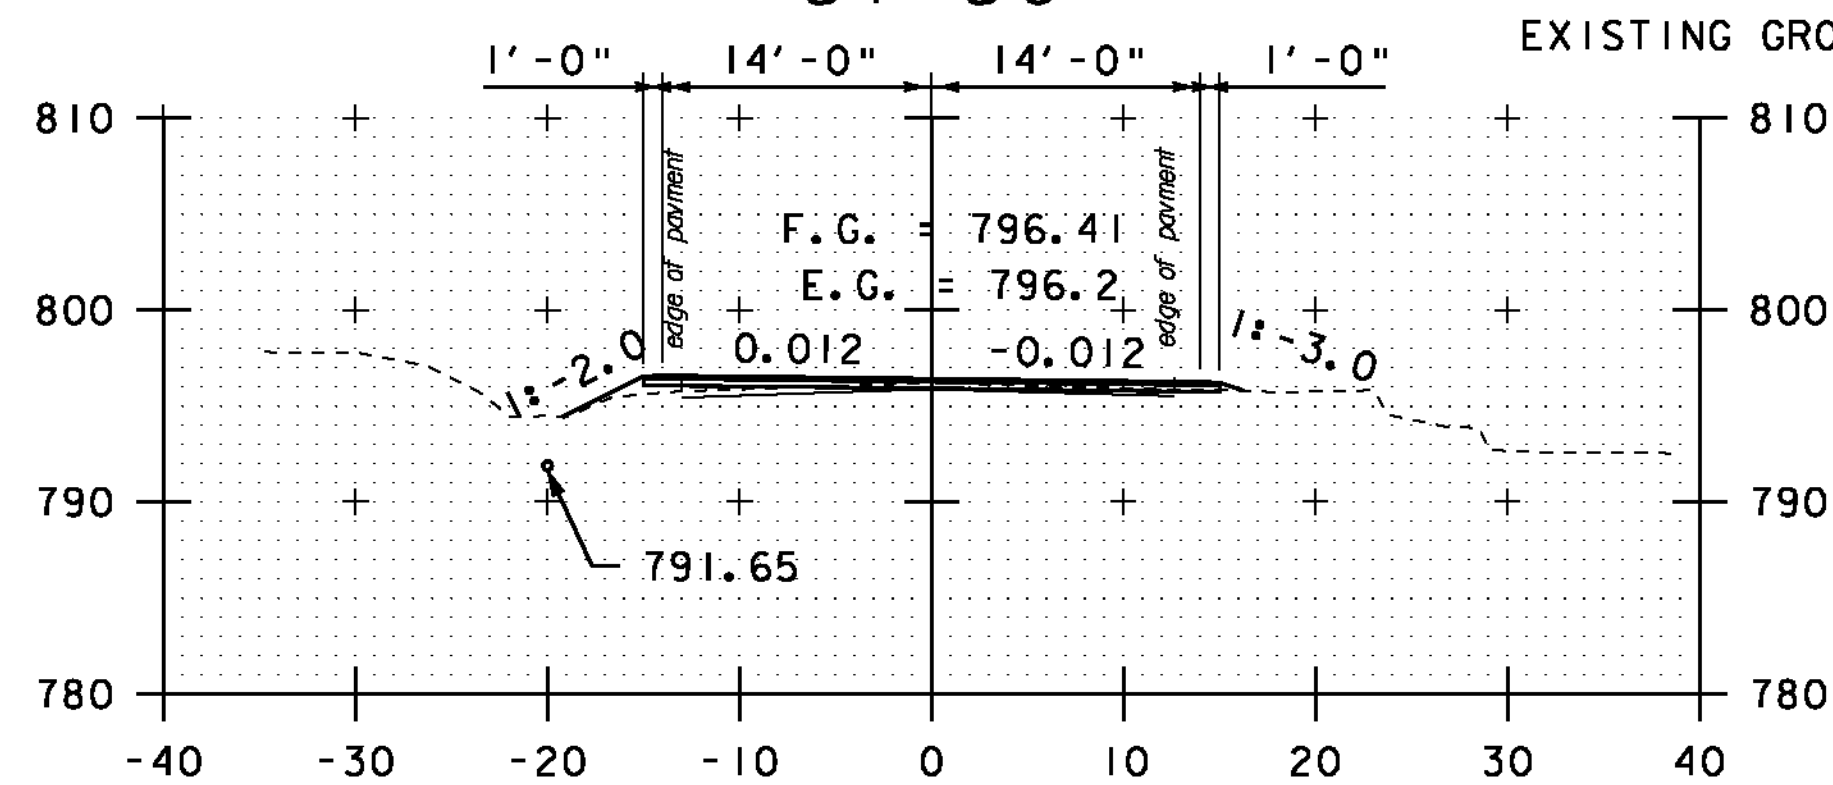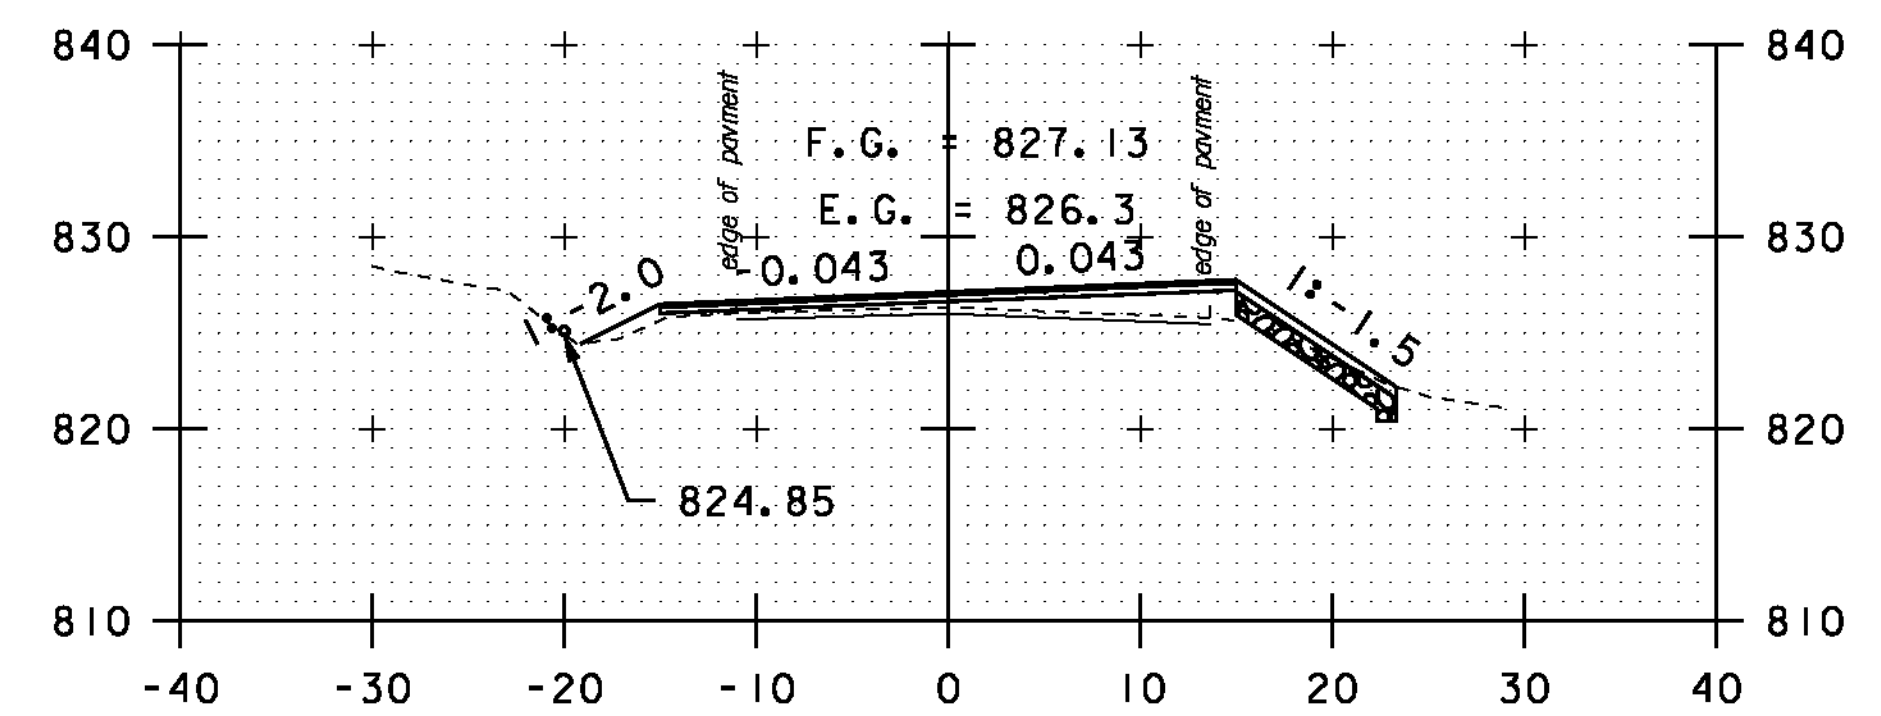


57+00

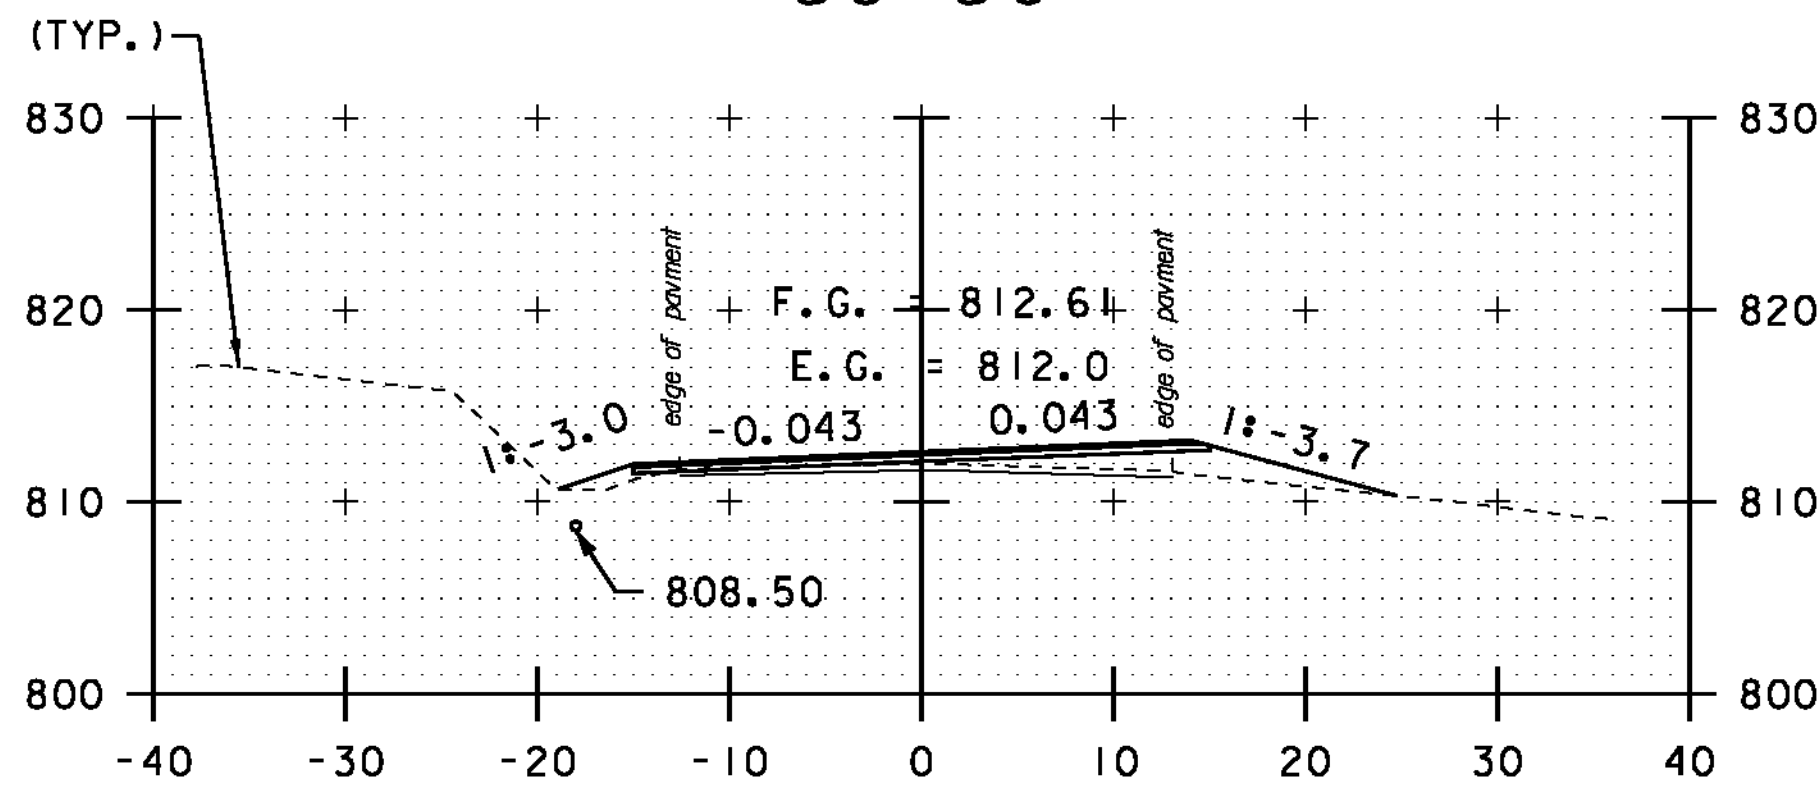


DRIVE RT
59+00

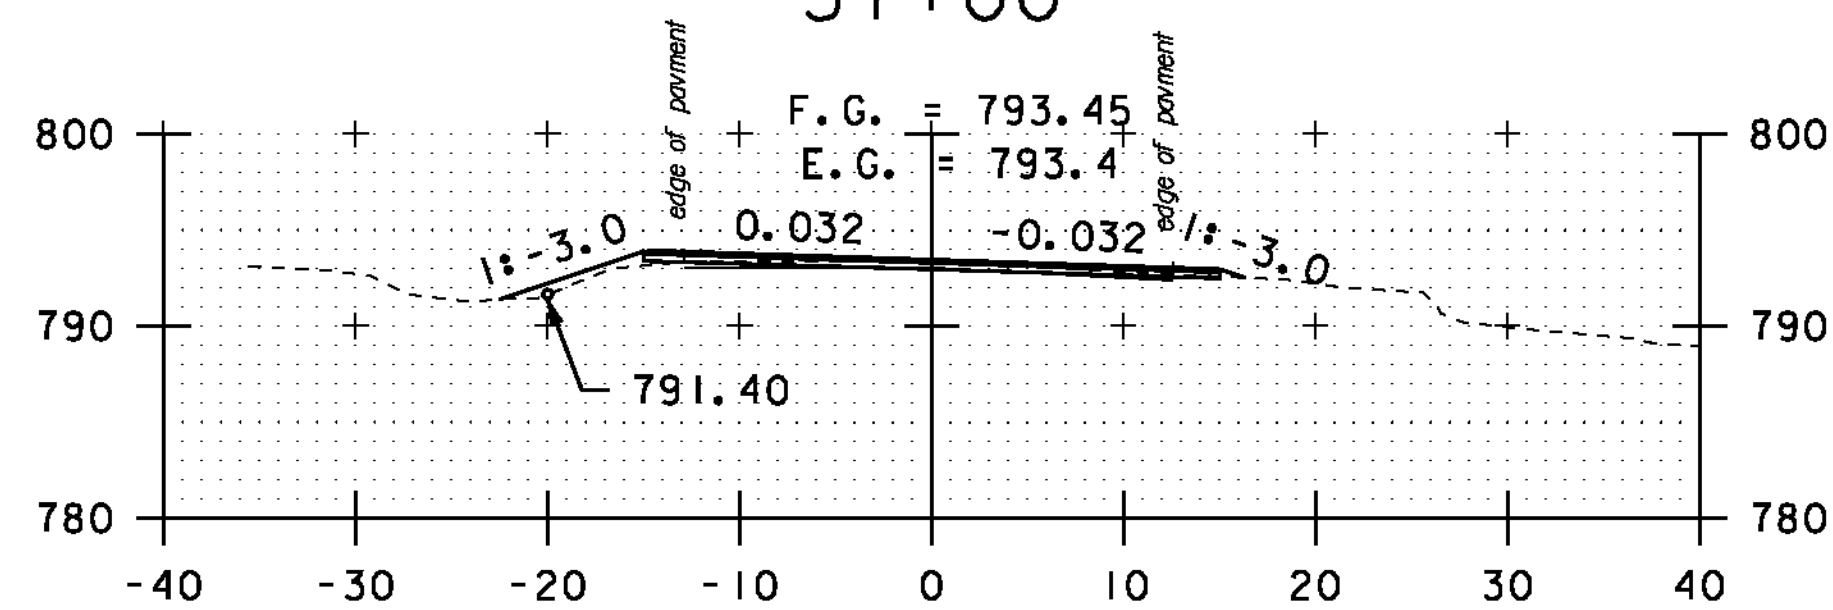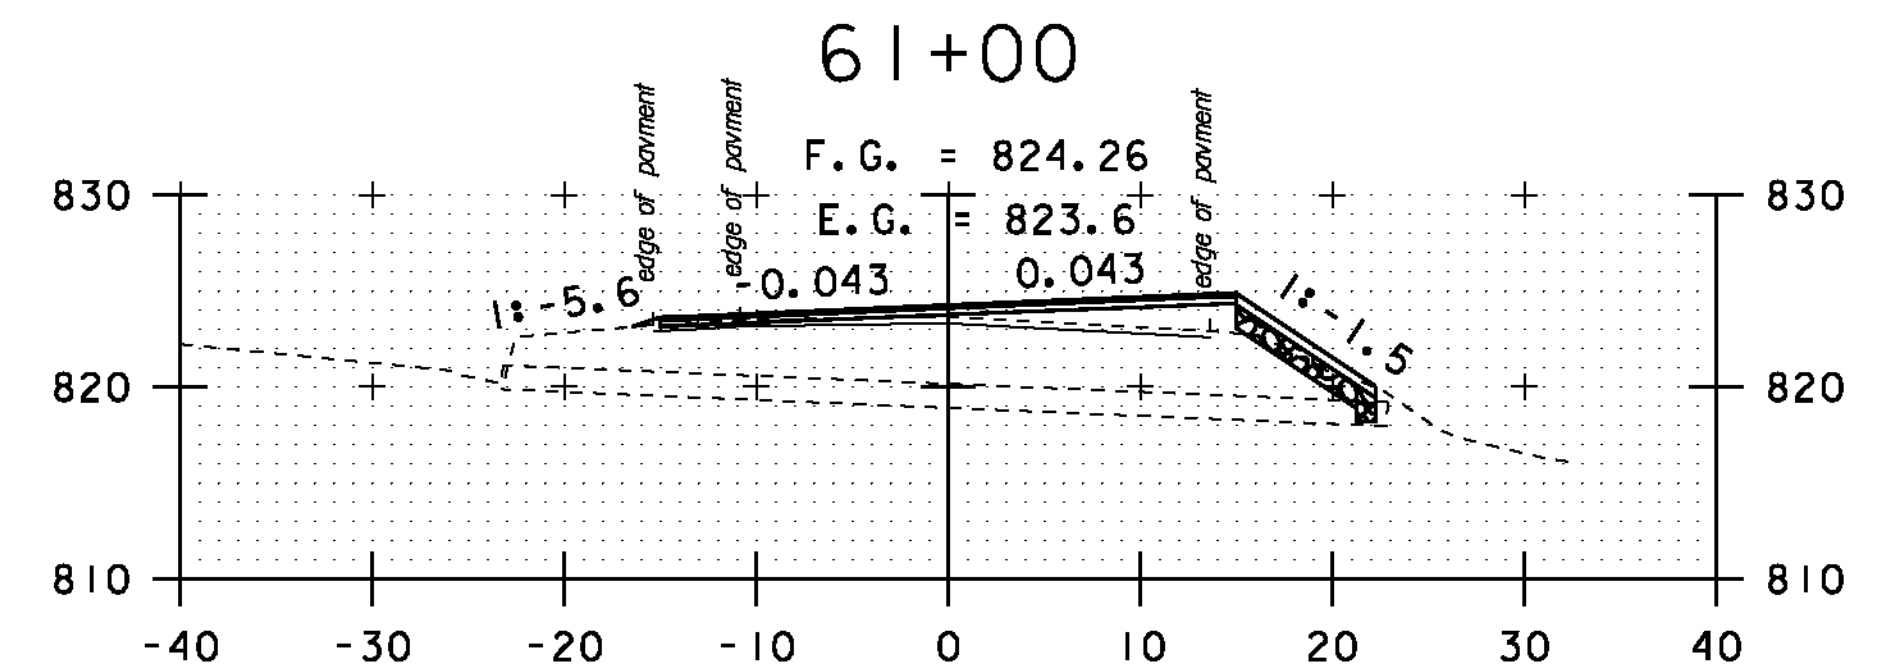

56+50

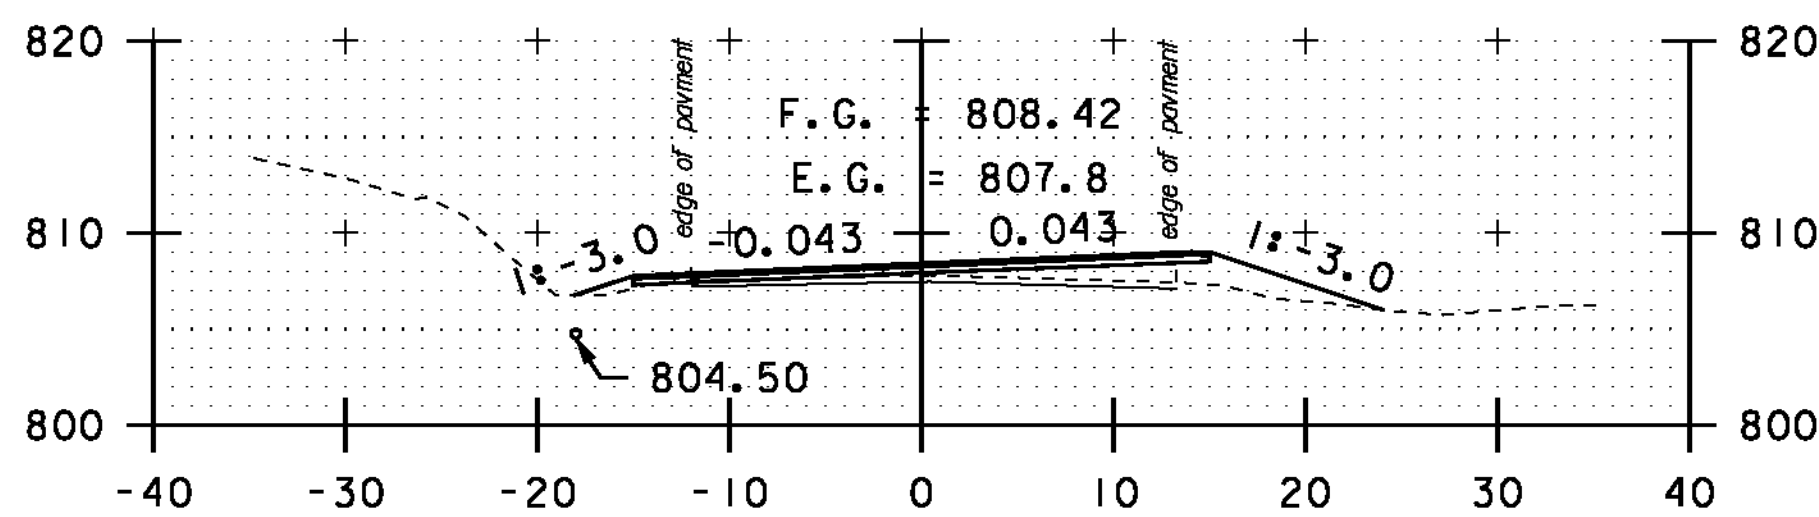

58+50

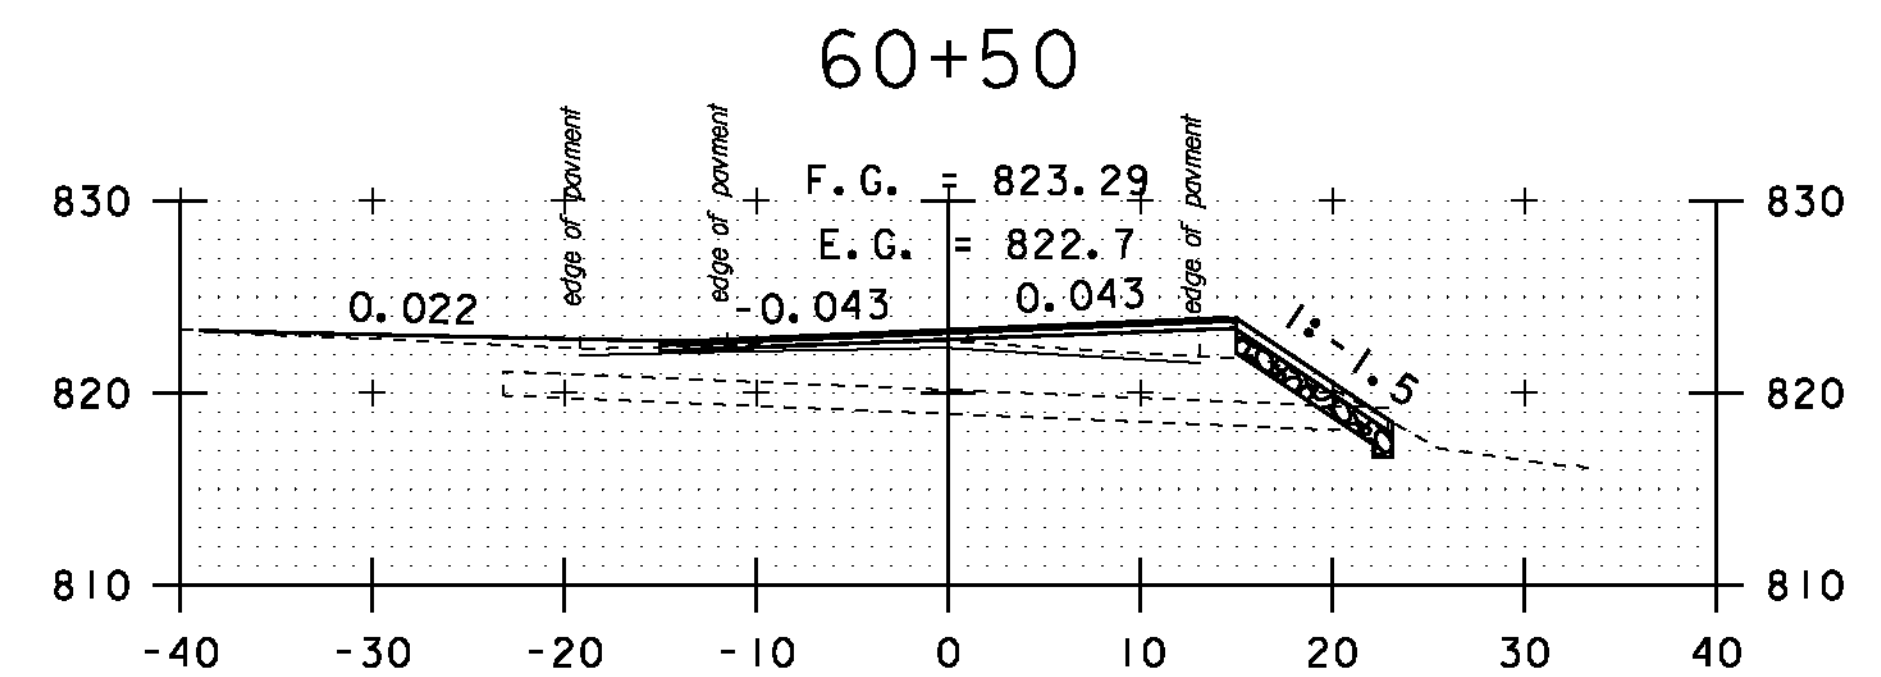

TH #65 LT
60+35

STA. 56+50 TO STA. 61+50



CROSS SECTION SHEET 12

PROJECT NAME: MONTGOMERY-WESTFIELD
 PROJECT NUMBER: STP 2906(I)
 FILE NAME: p10CI90.dgn
 PROJECT LEADER: CDL
 DESIGNED BY: SJL
 PLOT FILE: p10CI90_I26.I
 PLOT DATE: 9/5/12
 DRAWN BY: SJL
 CHECKED BY: CDL
 SHEET 126 OF 178