




63+00

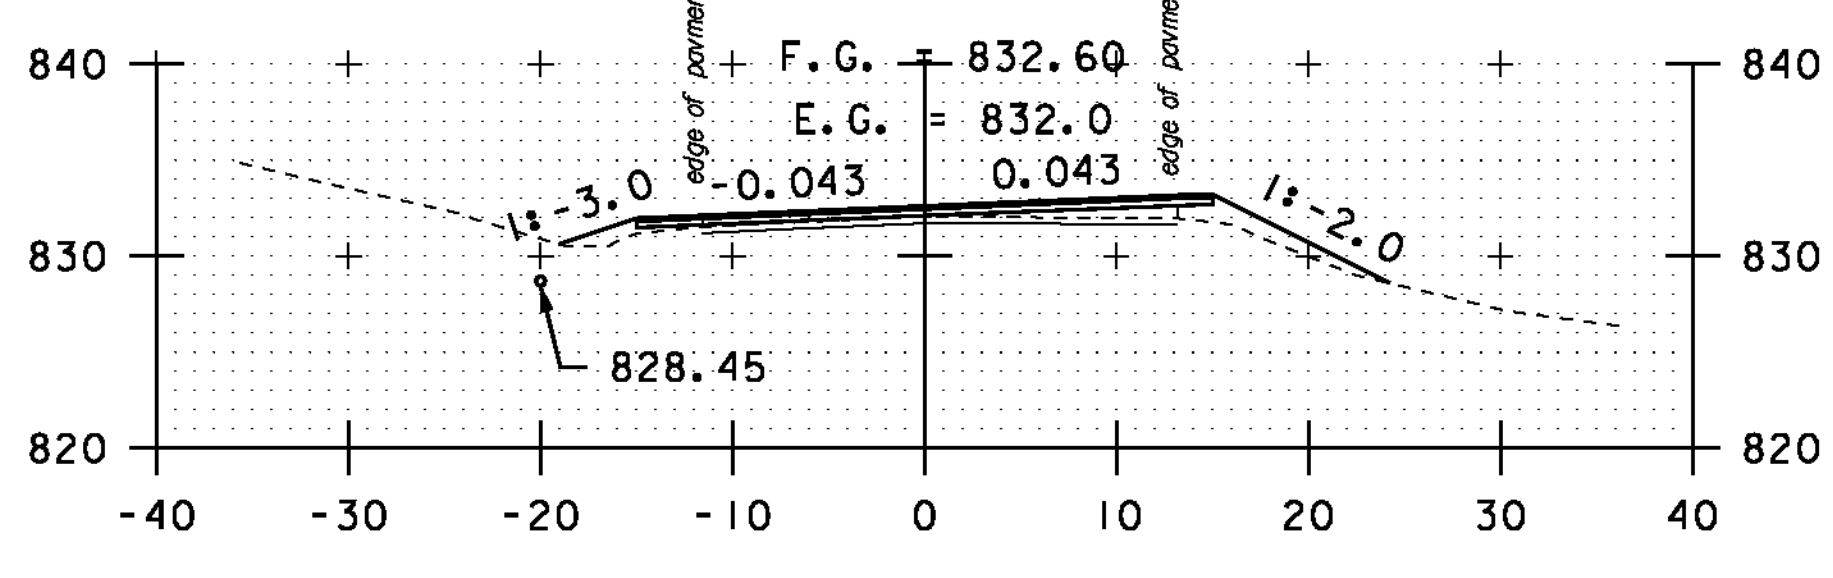


62+50

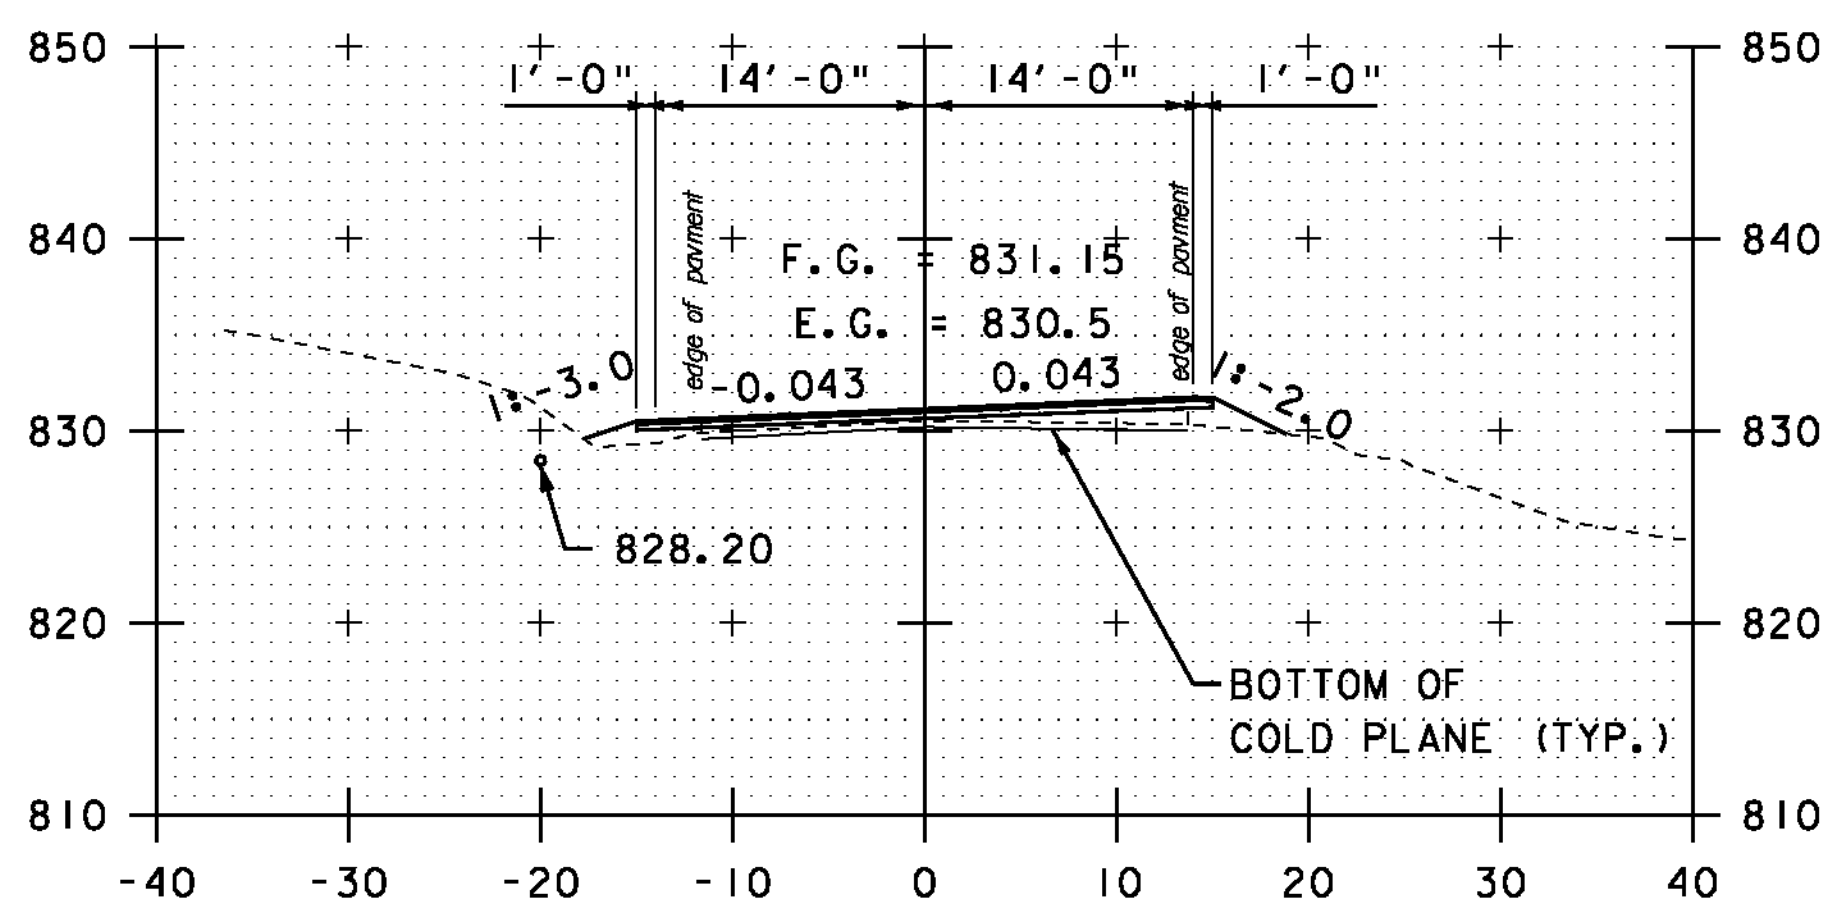


62+00

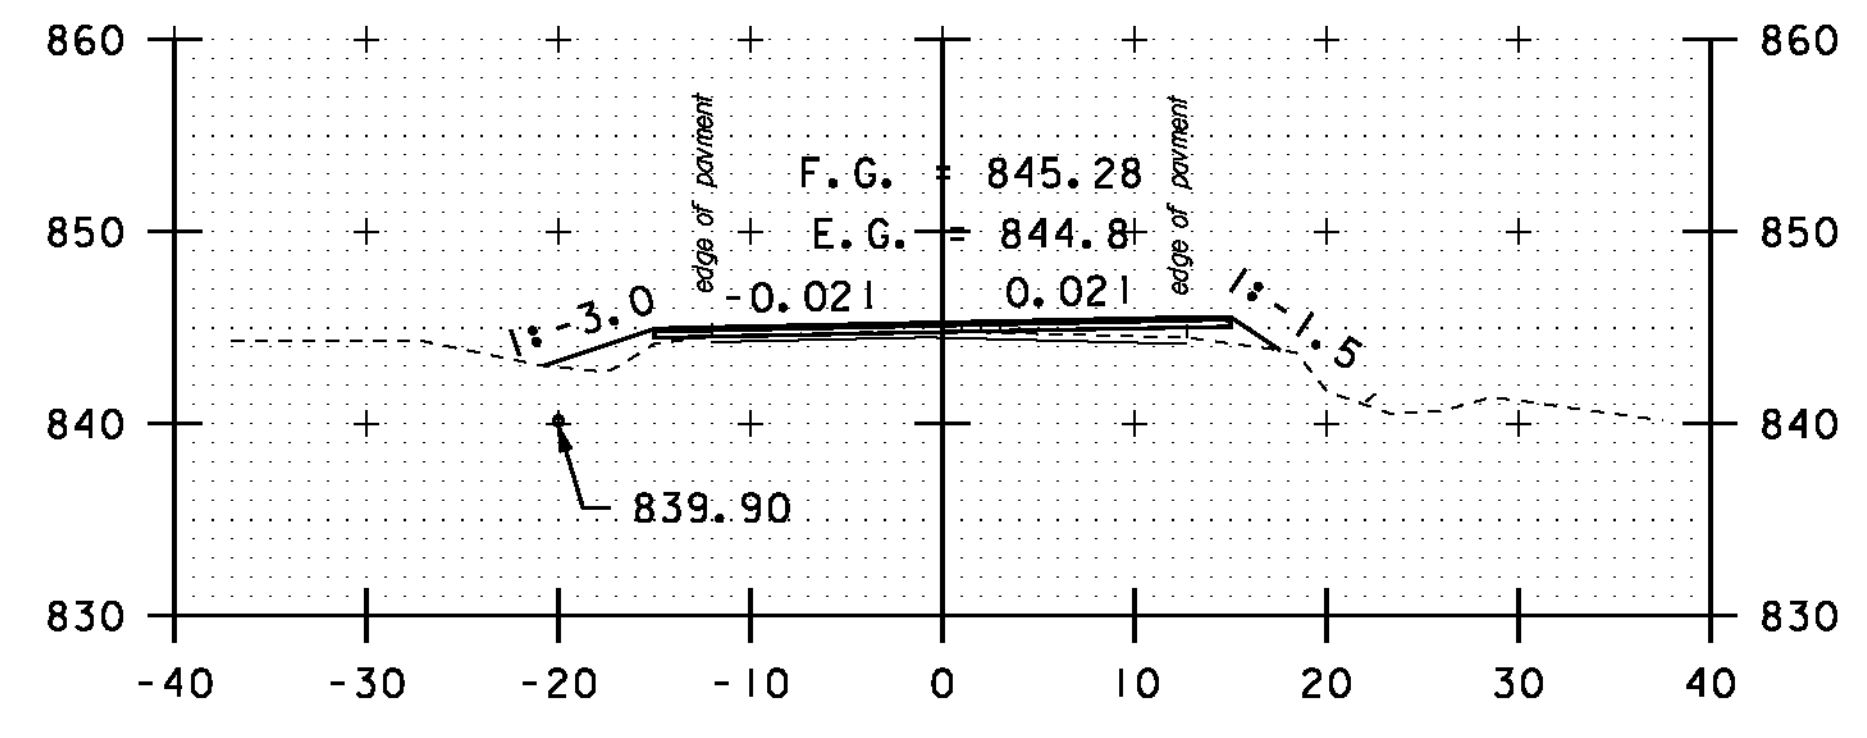


65+00

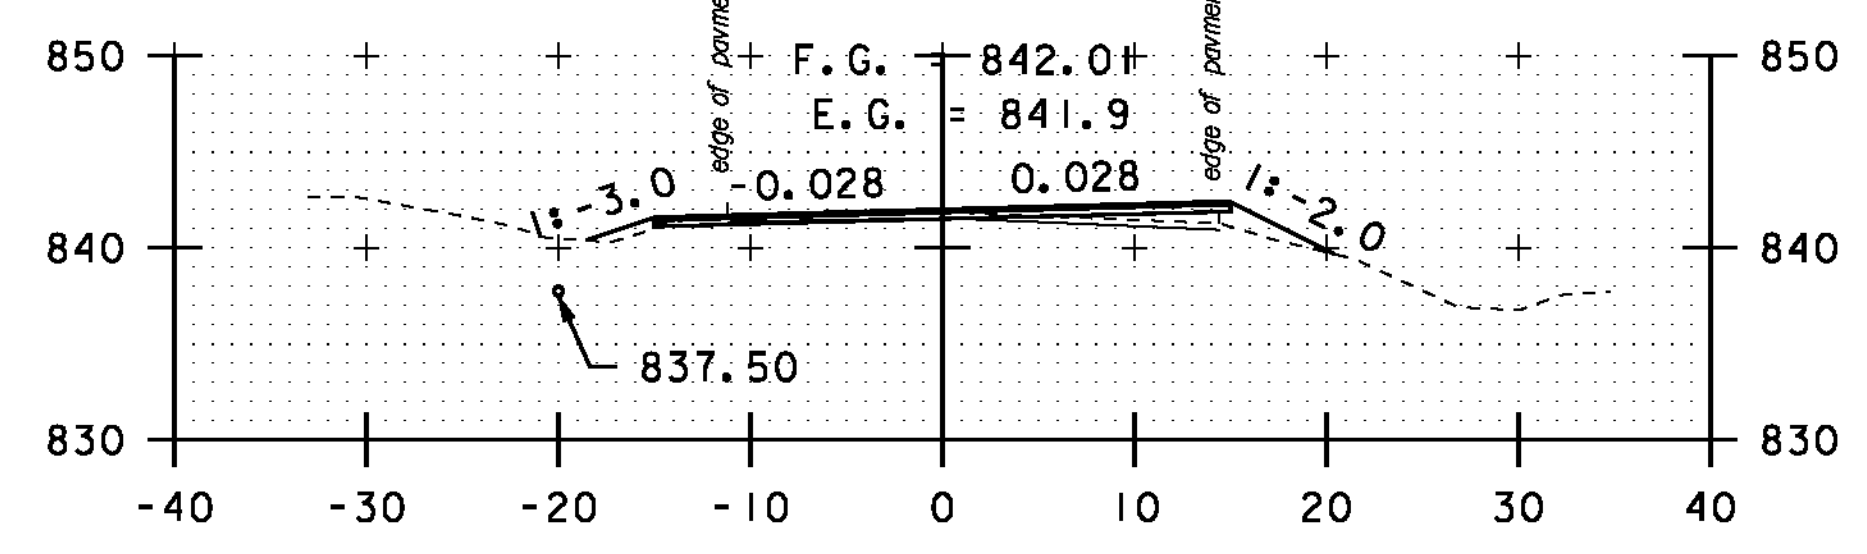


64+50

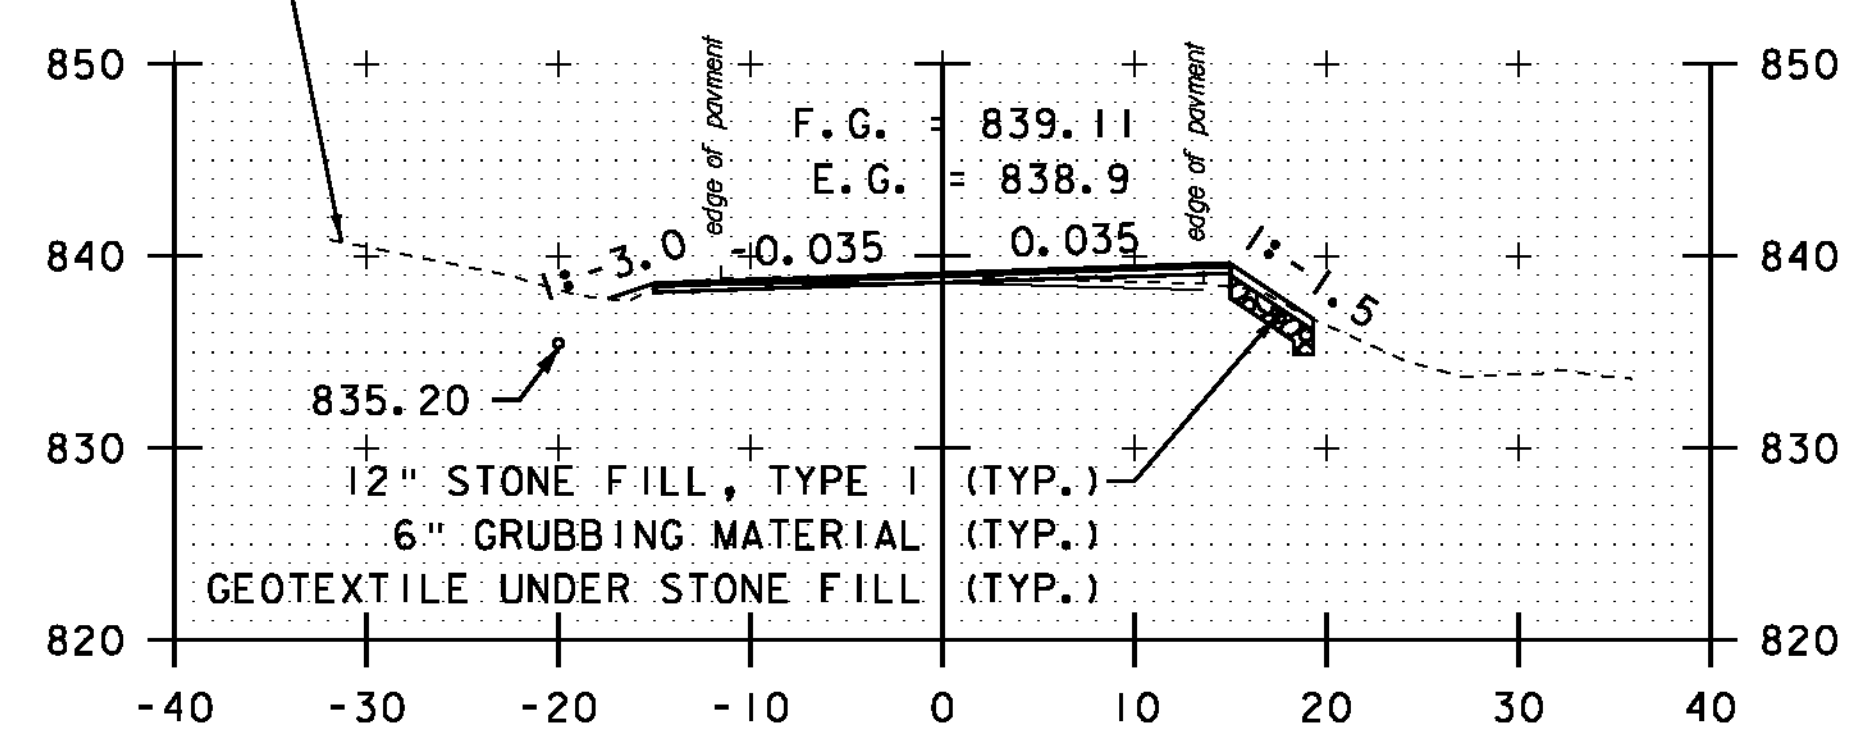


64+00

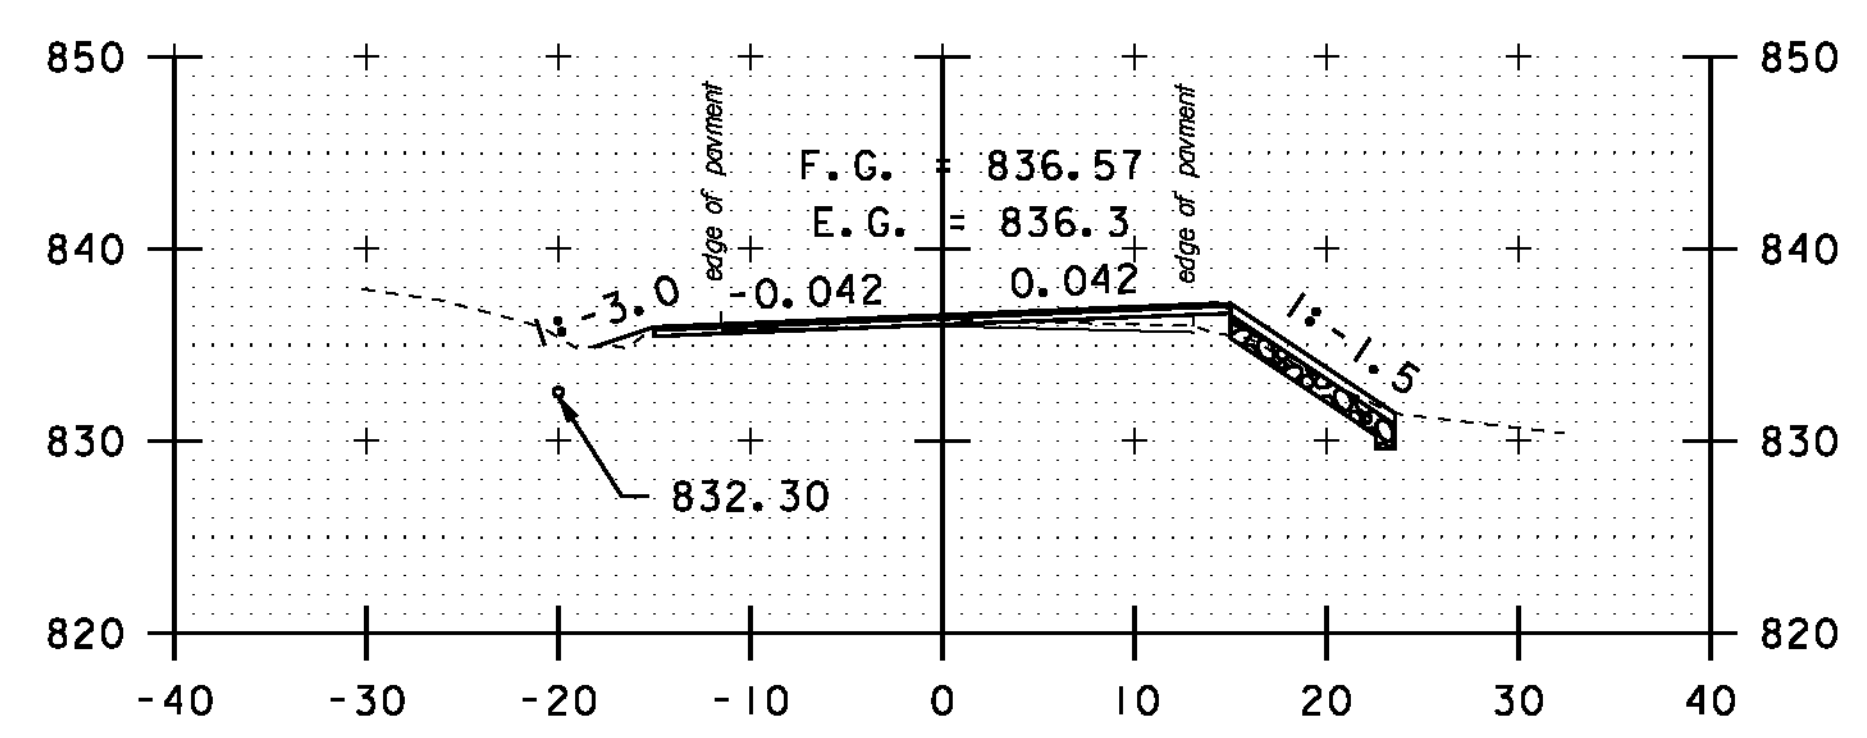


63+50

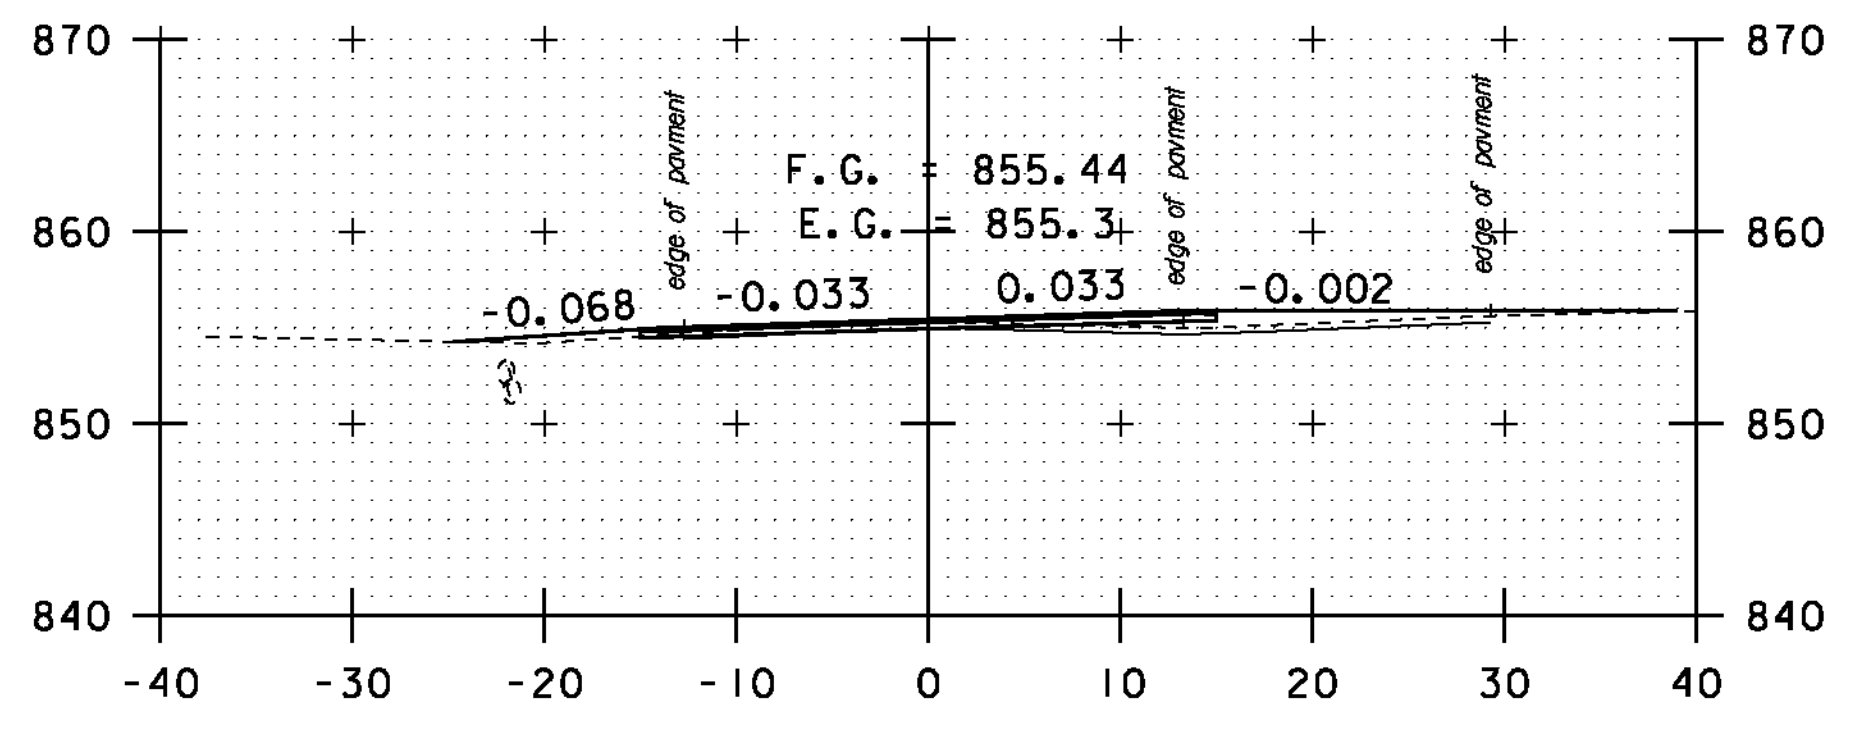


DRIVE LT/ TH #17 RT
66+51

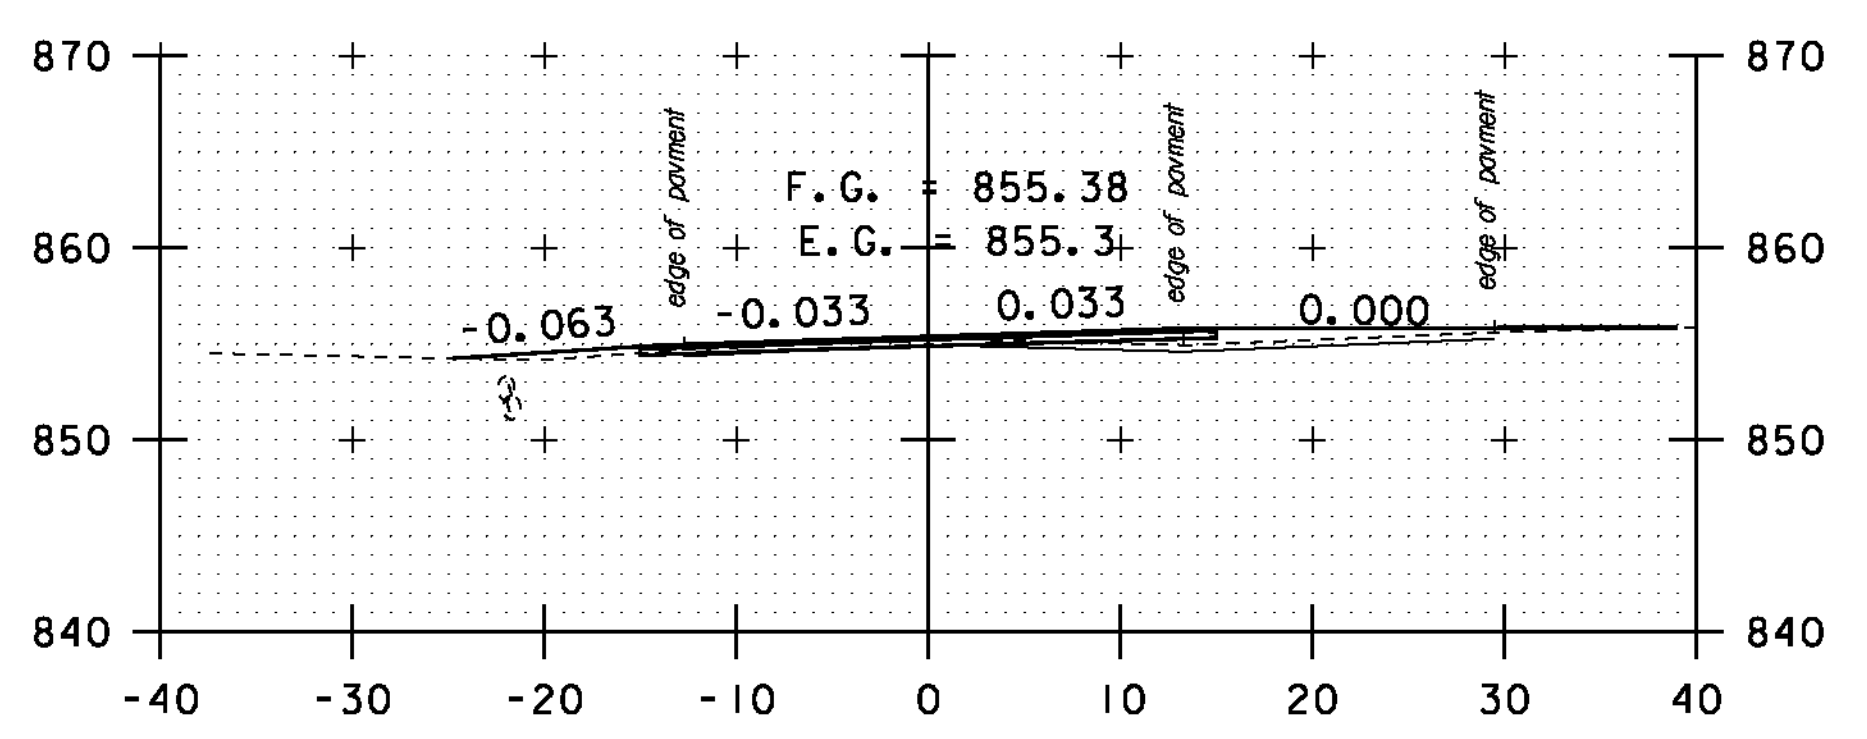

DRIVE LT/ TH #17 RT
66+50

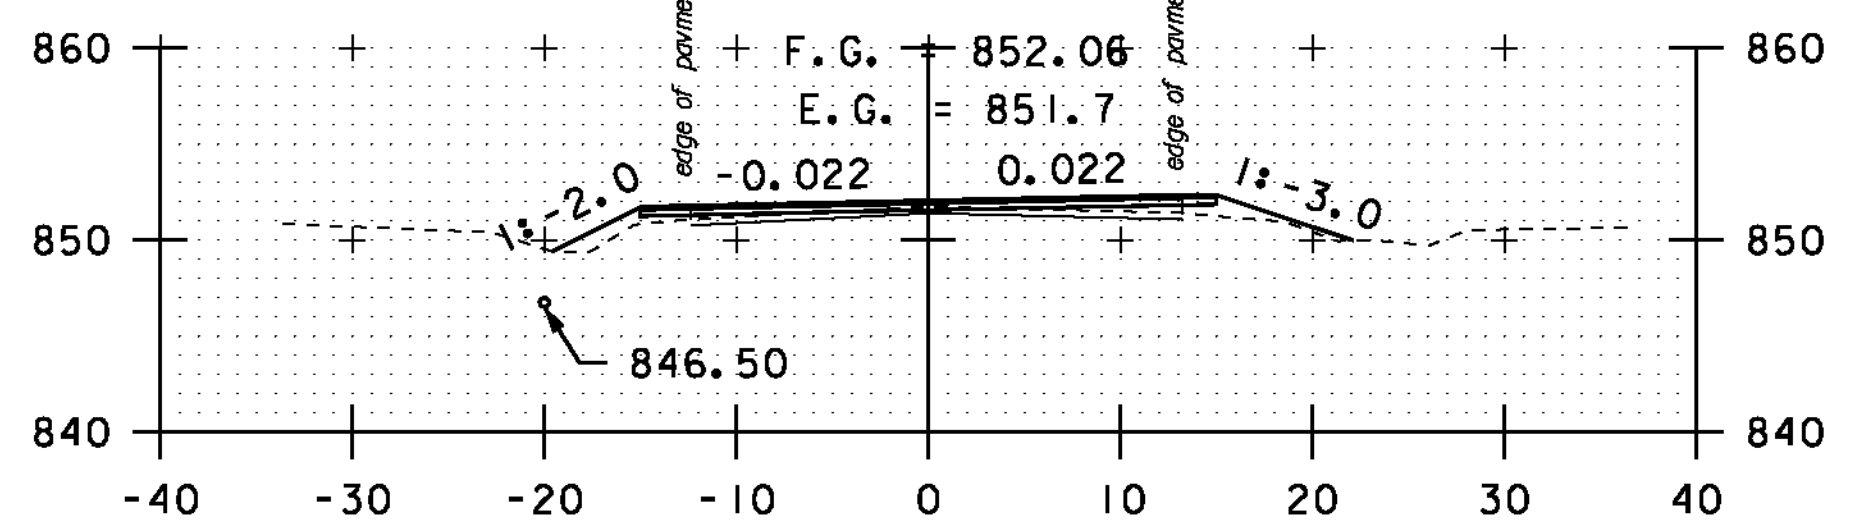


66+00

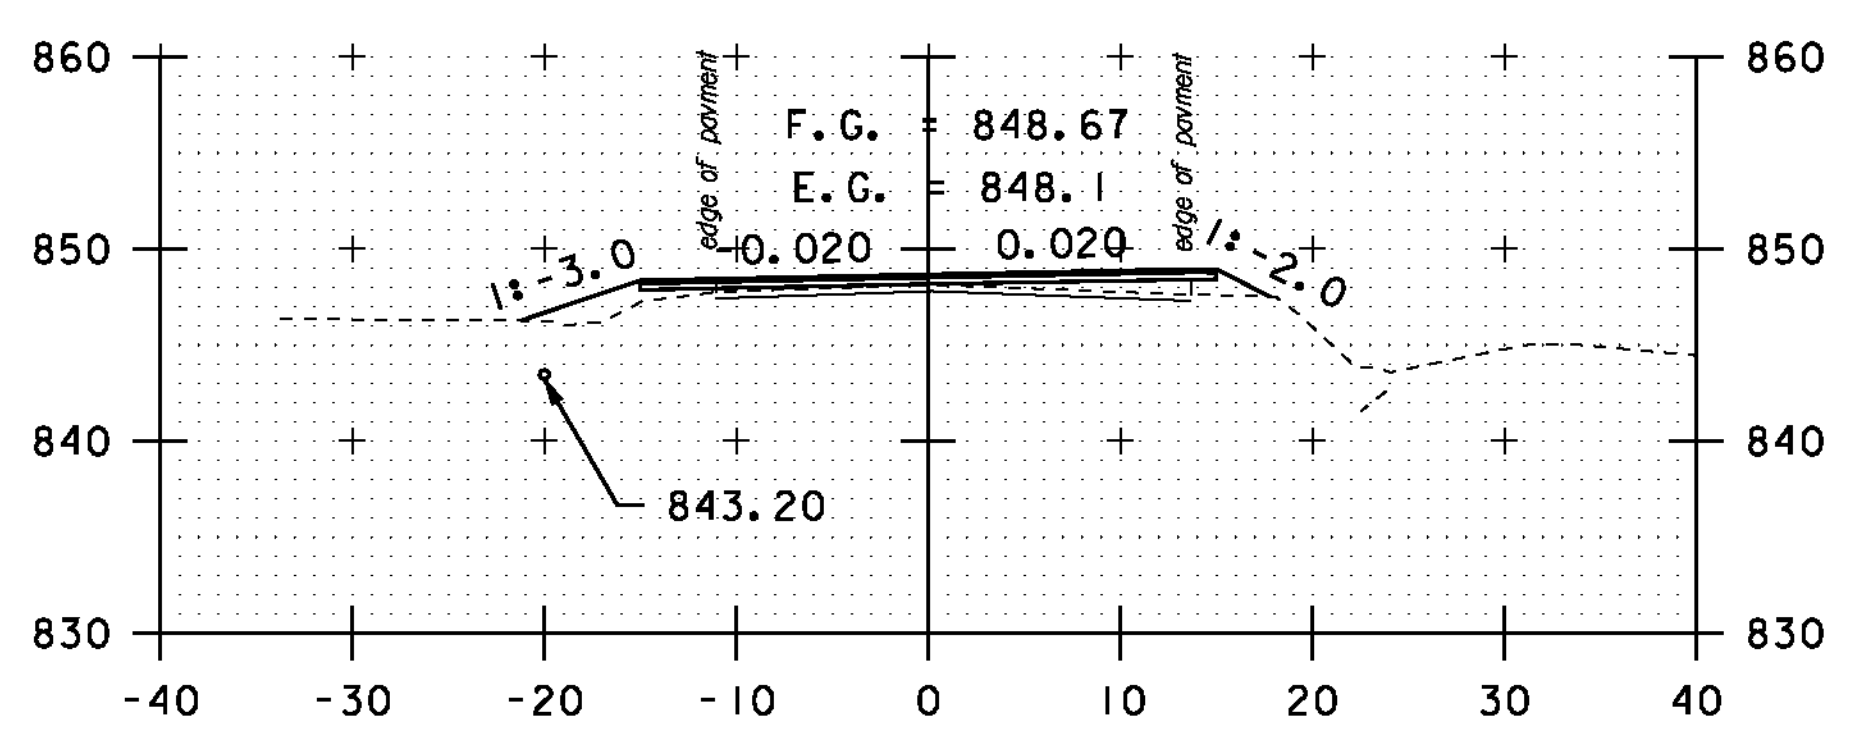

65+50

STA. 62+00 TO STA. 66+51

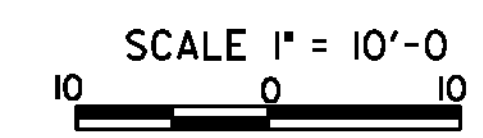

CROSS SECTION SHEET 13

PROJECT NAME: MONTGOMERY-WESTFIELD	PLOT DATE: 9/5/12
PROJECT NUMBER: STP 2906(I)	DRAWN BY: SJL
FILE NAME: p10CI90.dgn	CHECKED BY: CDL
DESIGNED BY: SJL	SHEET 127 OF 178
PLOT FILE: p10CI90_I27.I	