


STA. 67+00 TO STA. 72+50

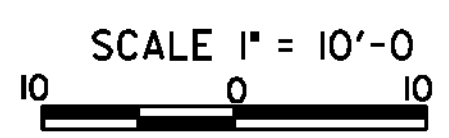

<b>CROSS SECTION SHEET 14</b>	PROJECT NAME: MONTGOMERY-WESTFIELD	PLOT DATE: 9/5/12
	PROJECT NUMBER: STP 2906(I)	DRAWN BY: SJL
	FILE NAME: p10ci90.dgn	CHECKED BY: CDL
	DESIGNED BY: SJL	SHEET 128 OF 178
	PLOT FILE: p10ci90.i28.i	