




NOTE:  
 FROM STA. 73+92 - STA. 75+00 THE SUPERELEVATION SHALL BE  
 TRANSITIONED TO MATCH EXISTING CROSS SLOPES. CROSS SLOPES  
 SHALL BE MAINTAINED THROUGH THE LEVEL/OVERLAY SECTION.

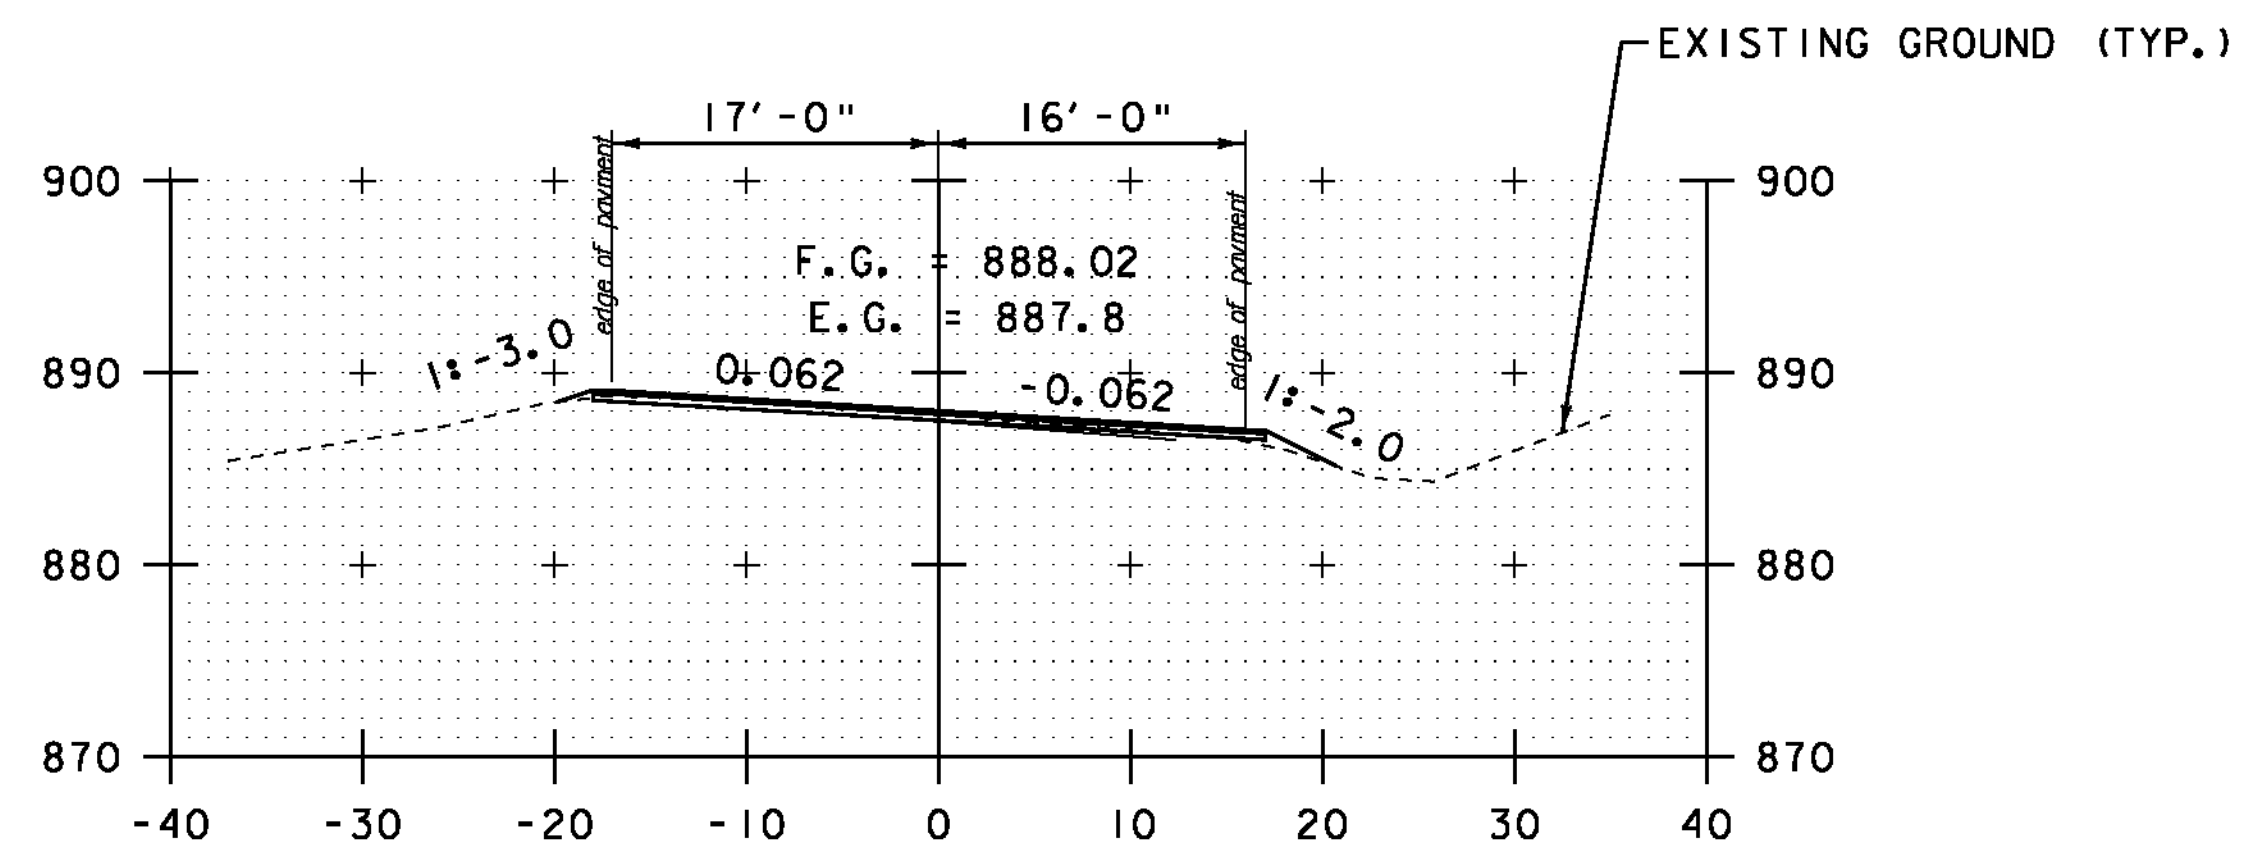

74+00

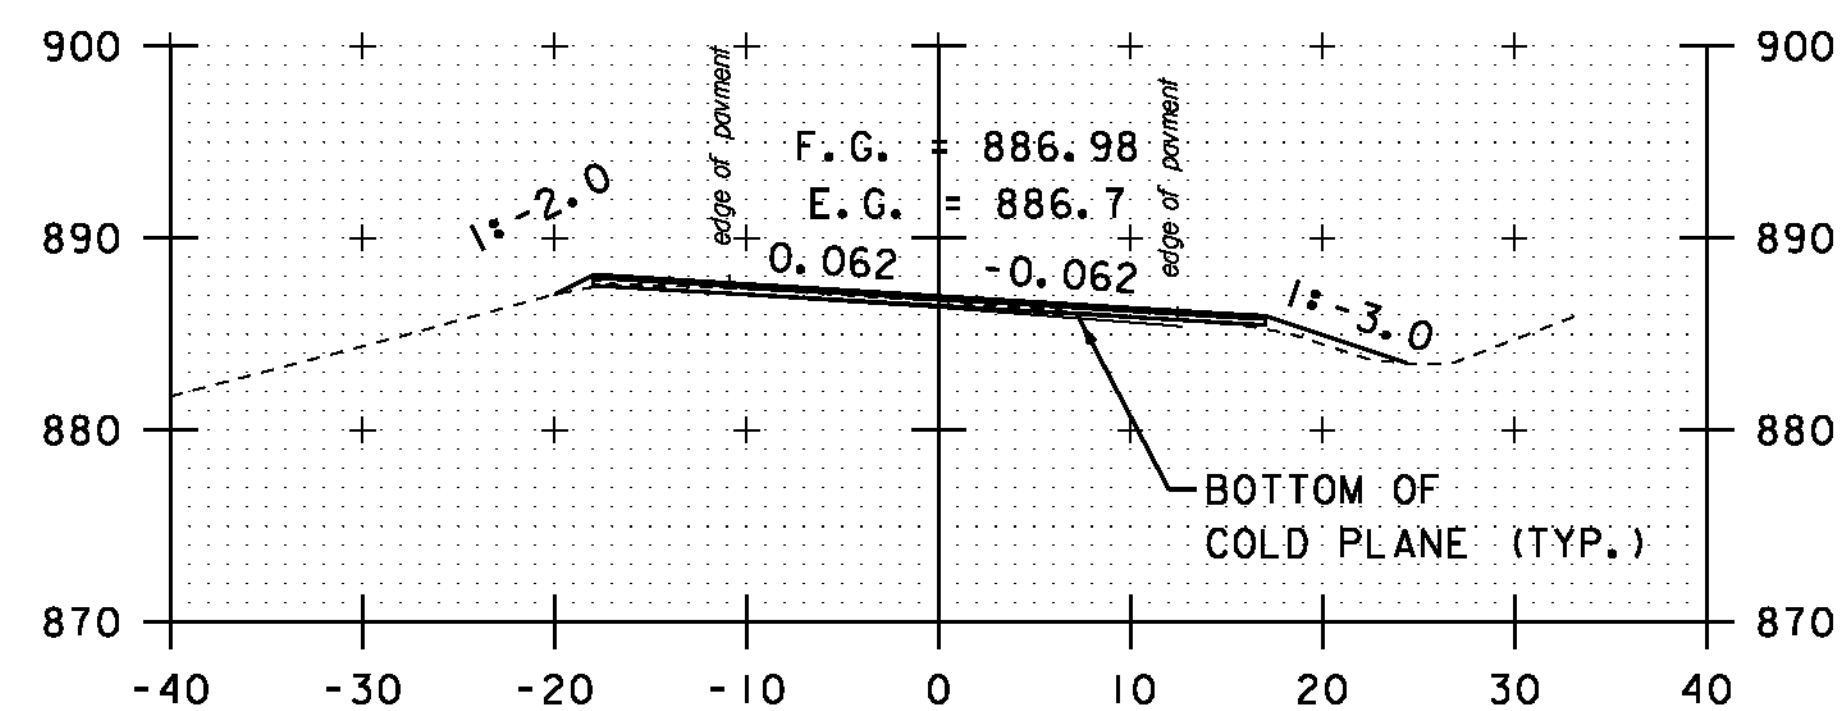

73+50

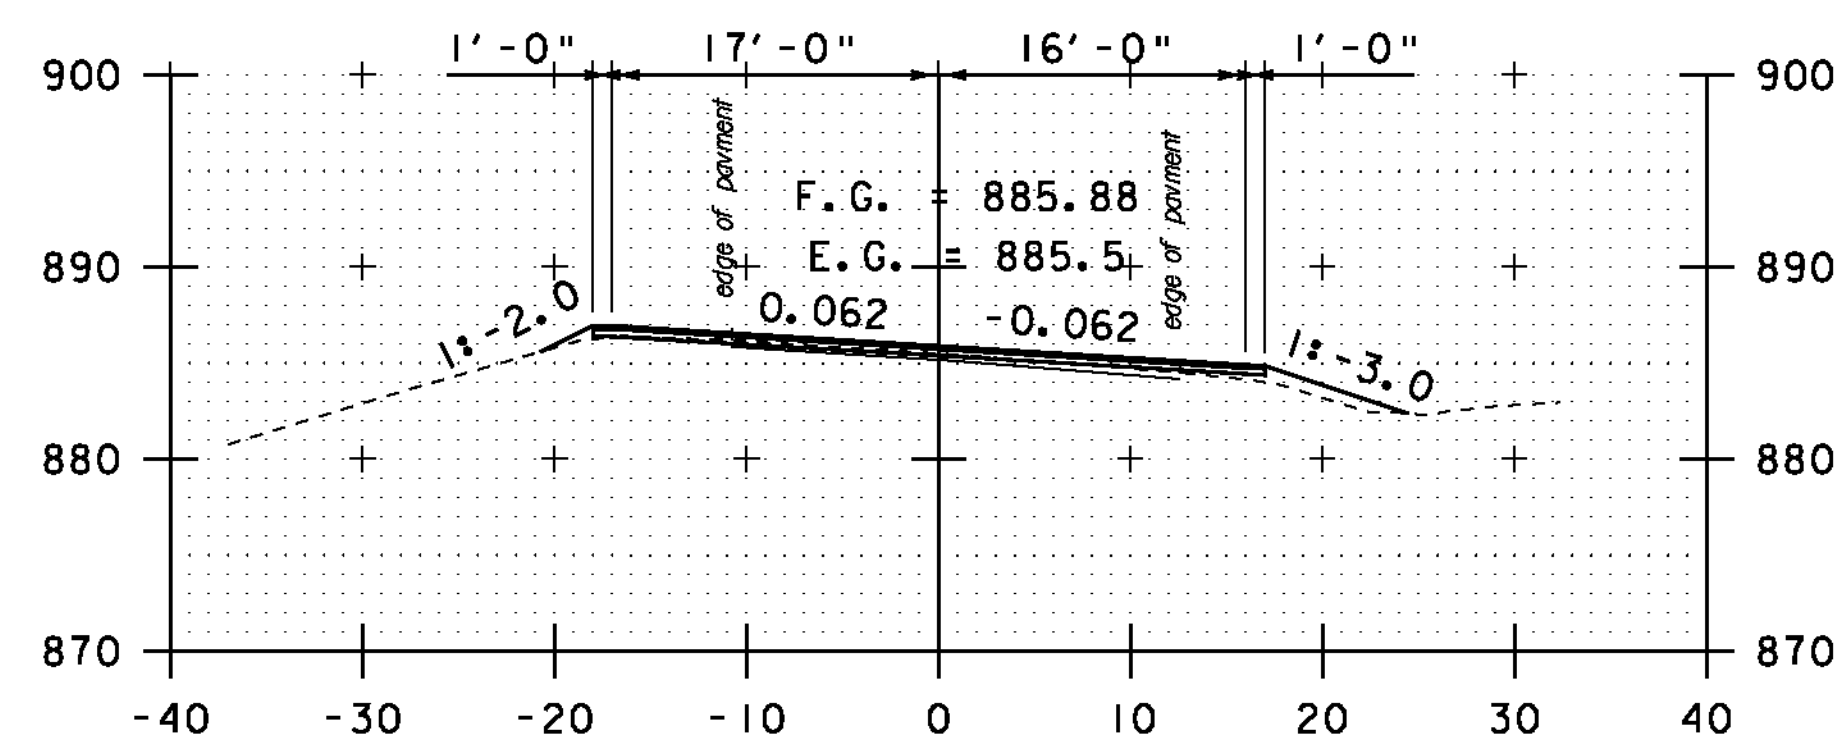

73+00

STA. 73+00 TO STA. 74+00

SCALE 1" = 10'-0"

**CROSS SECTION SHEET 15**

PROJECT NAME: MONTGOMERY-WESTFIELD

PROJECT NUMBER: STP 2906(I)

FILE NAME: p10ci90.dgn

PROJECT LEADER: CDL

DESIGNED BY: SJL

PLOT FILE: p10ci90.i29.i

PLOT DATE: 9/5/12

DRAWN BY: SJL

CHECKED BY: CDL

SHEET 129 OF 178