




101+50

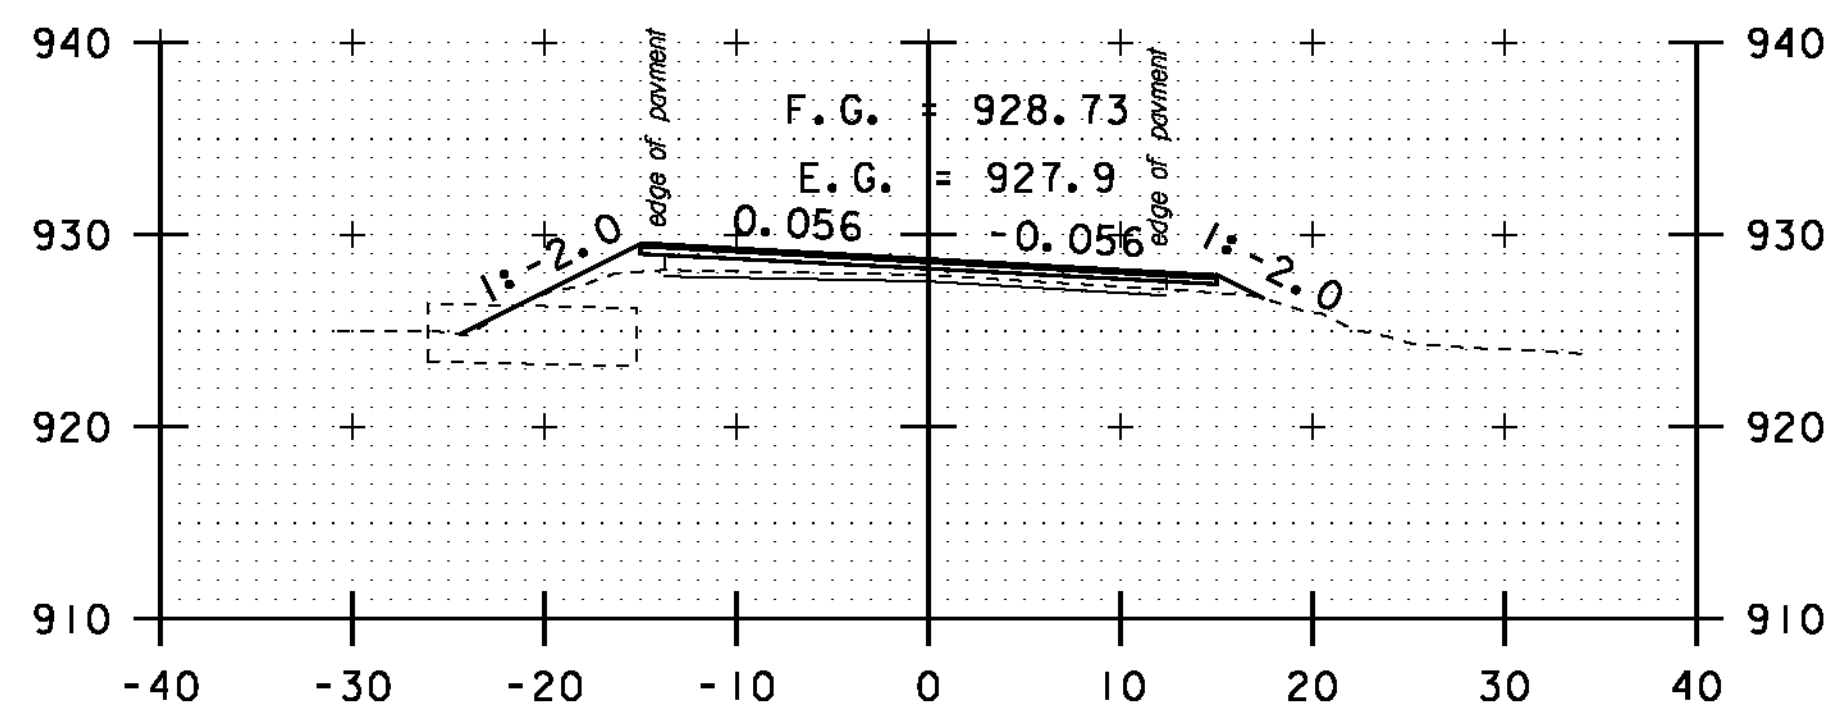


103+50

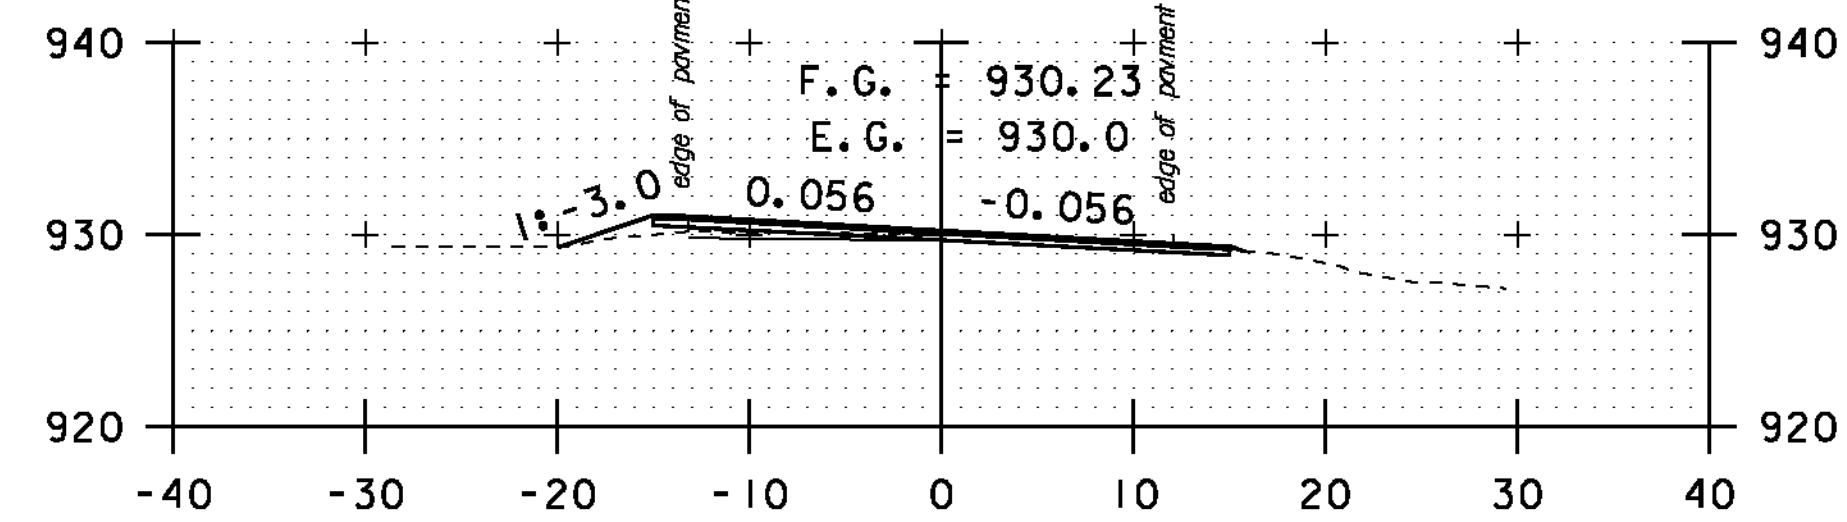


105+50

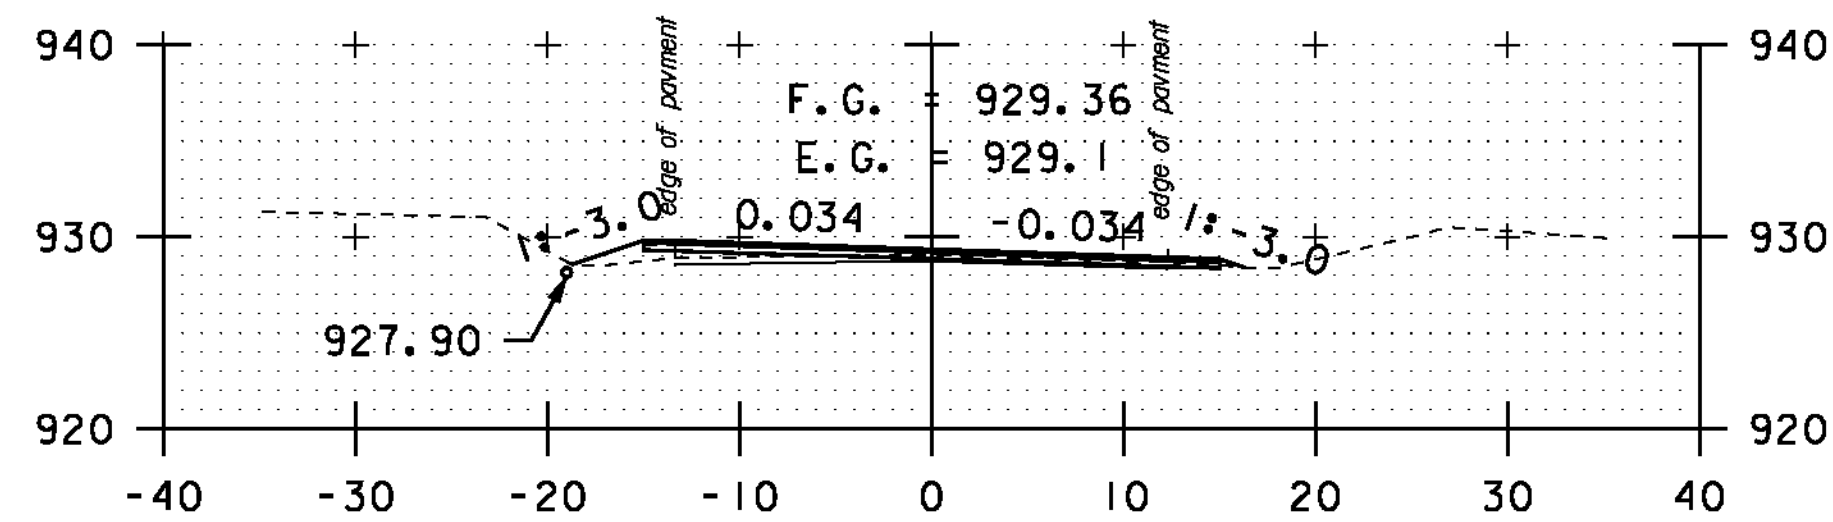


101+00

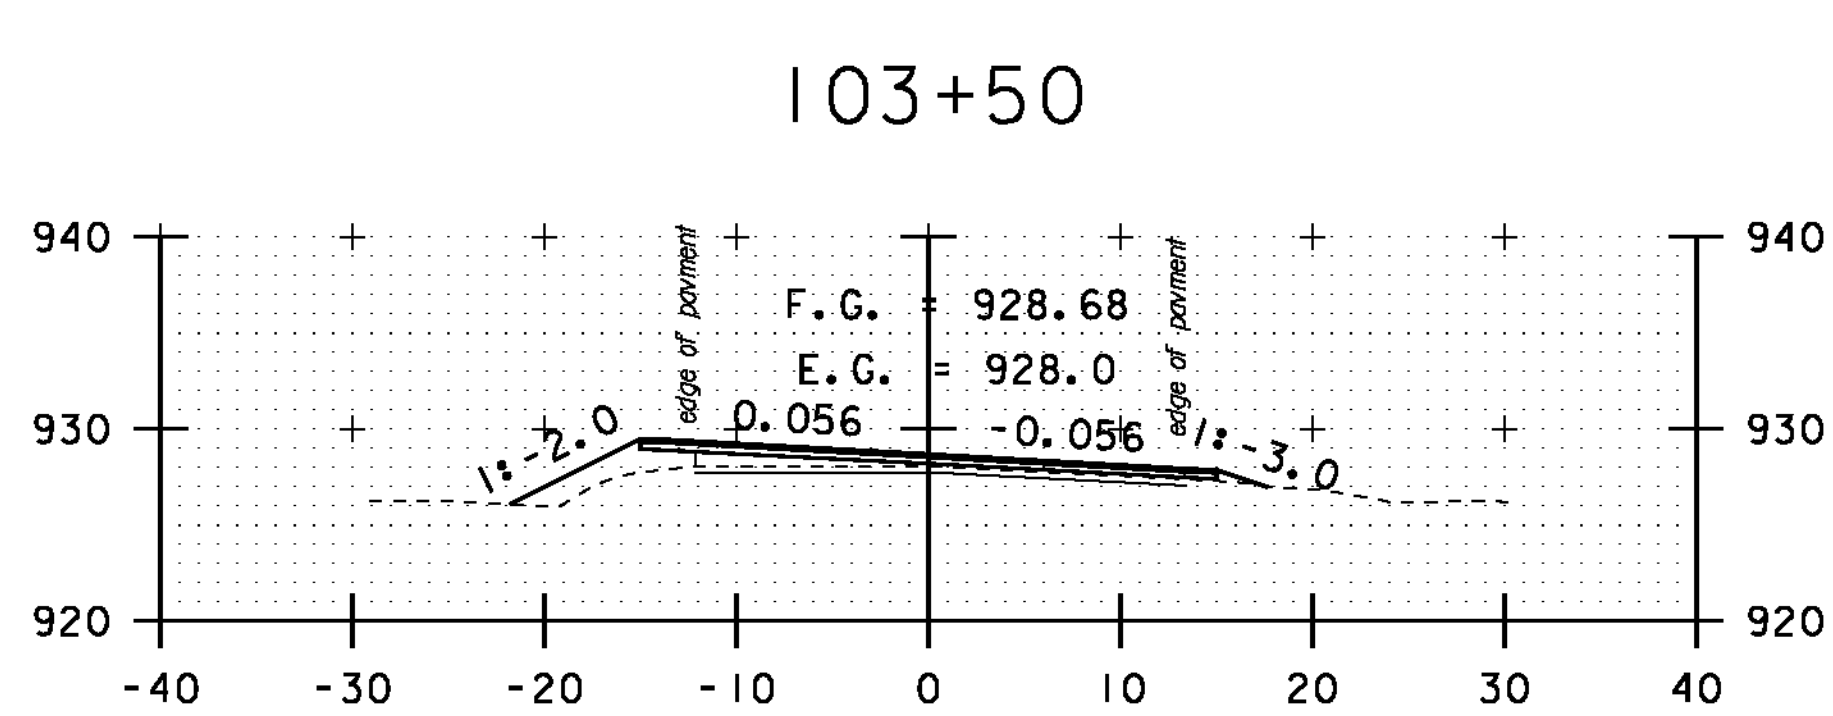


103+00

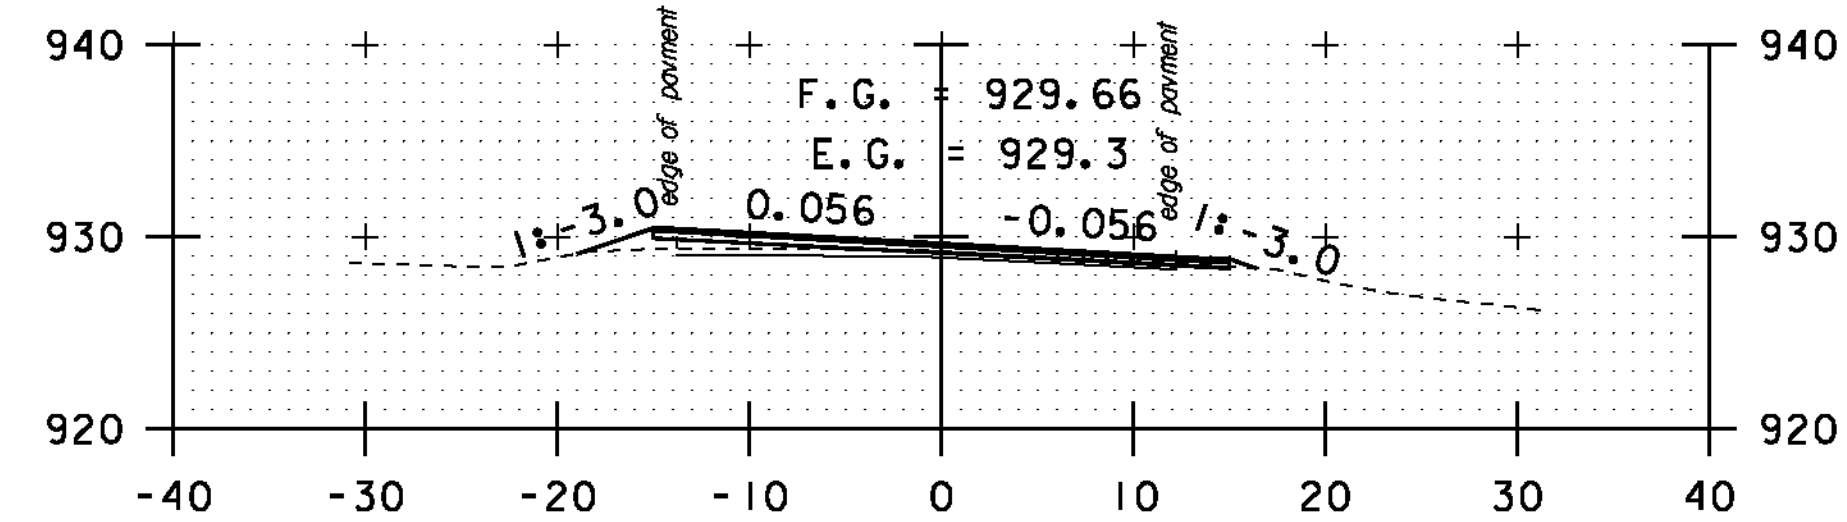


105+00

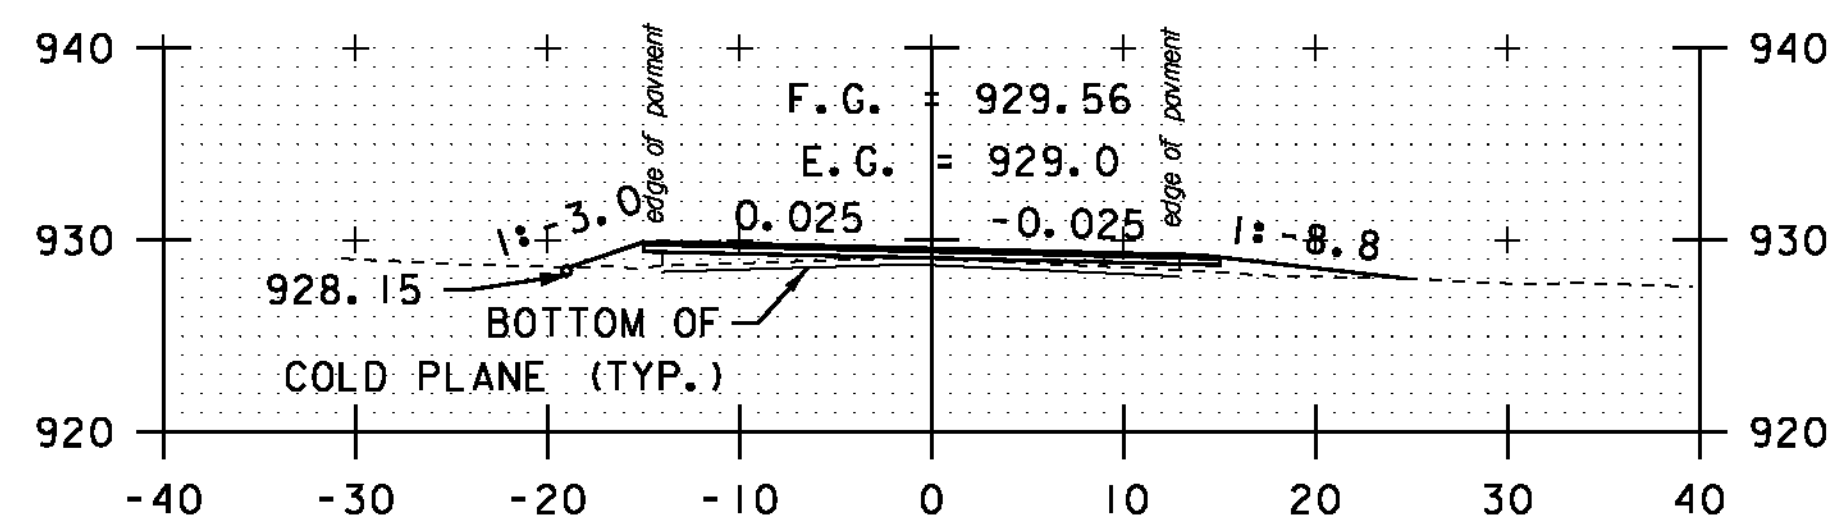


DRIVE RT
100+50

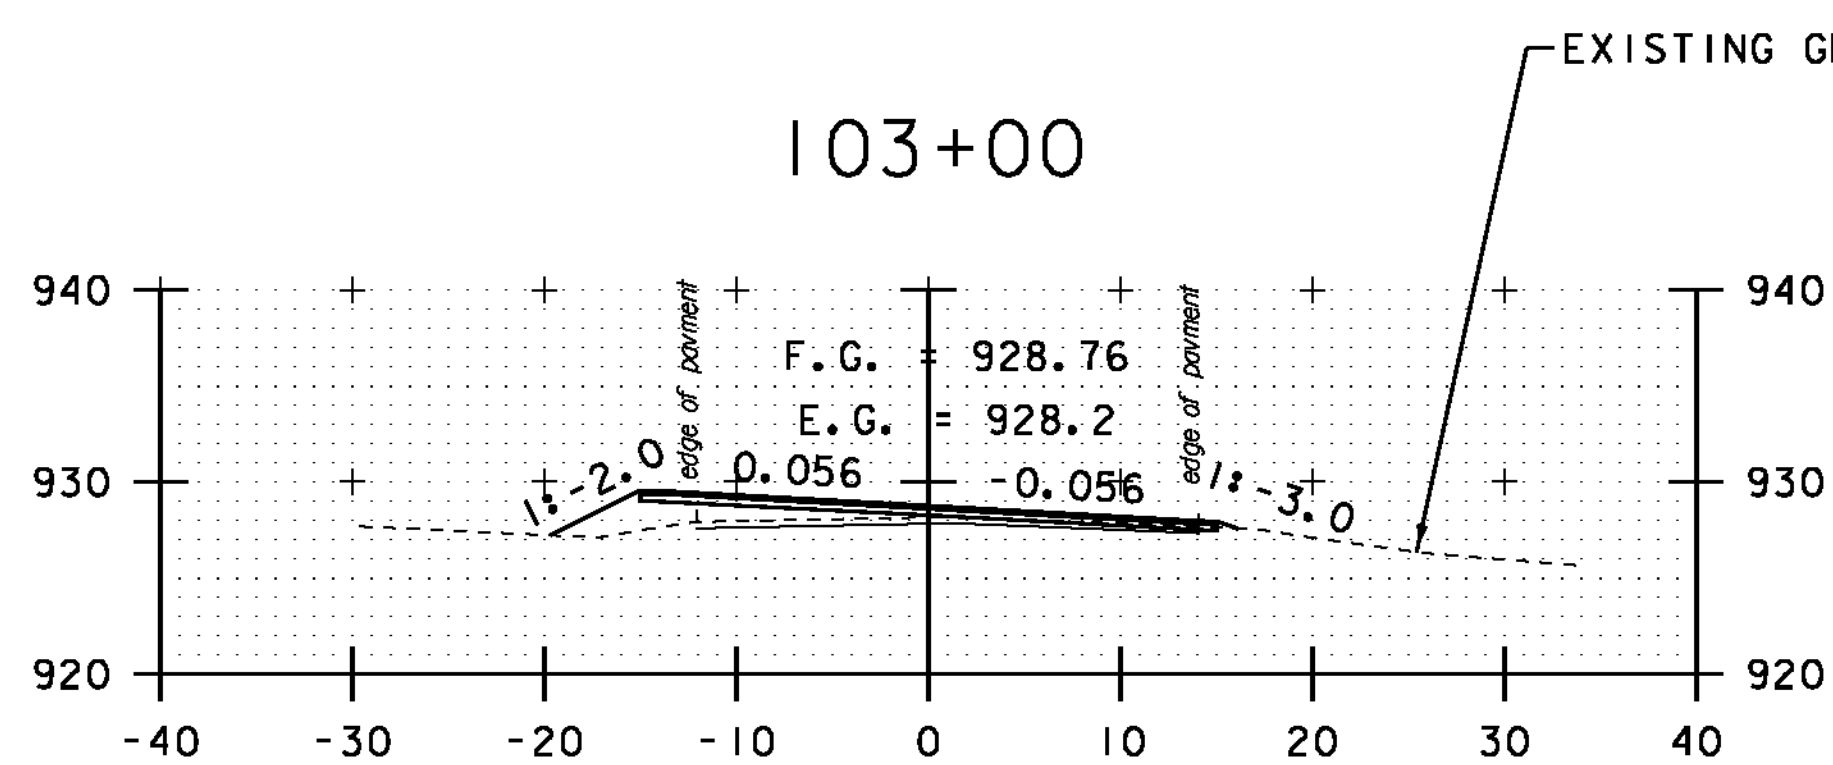


102+50

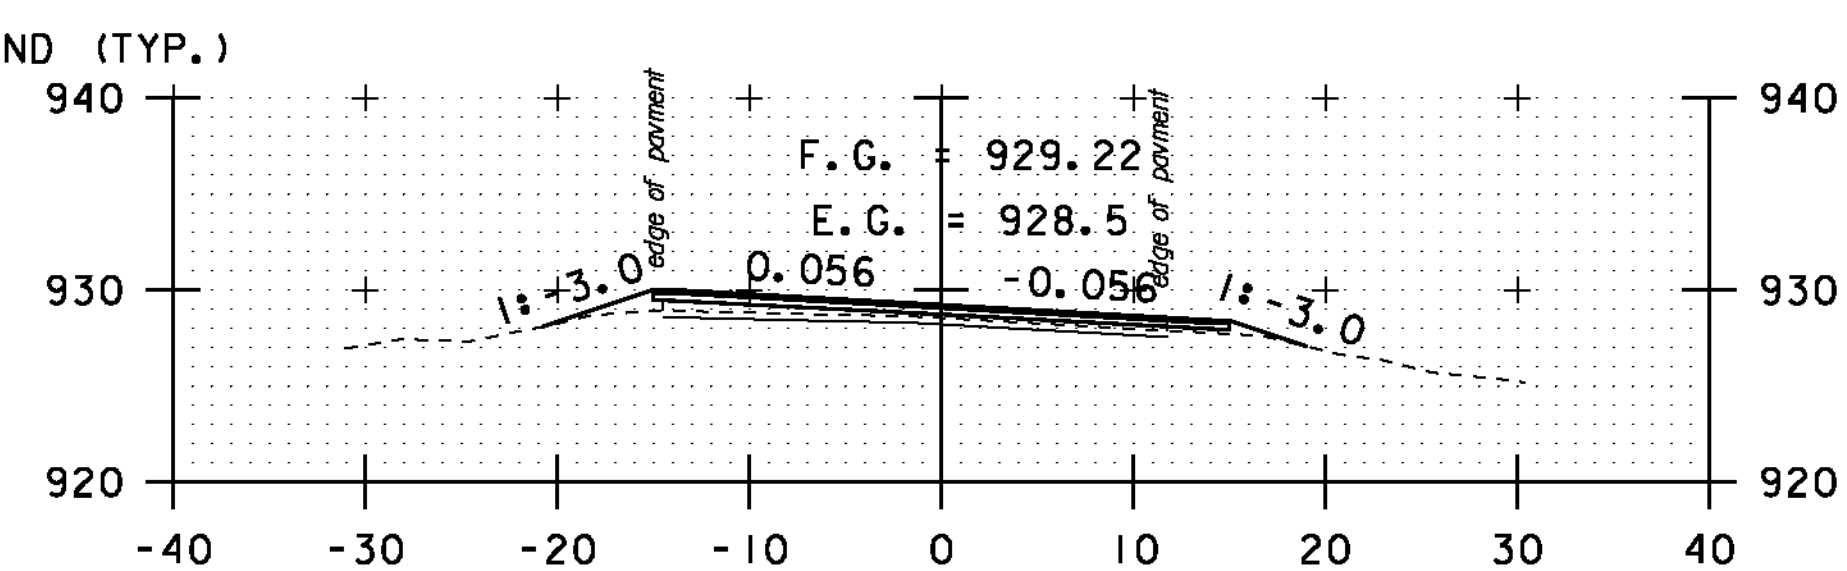


104+50

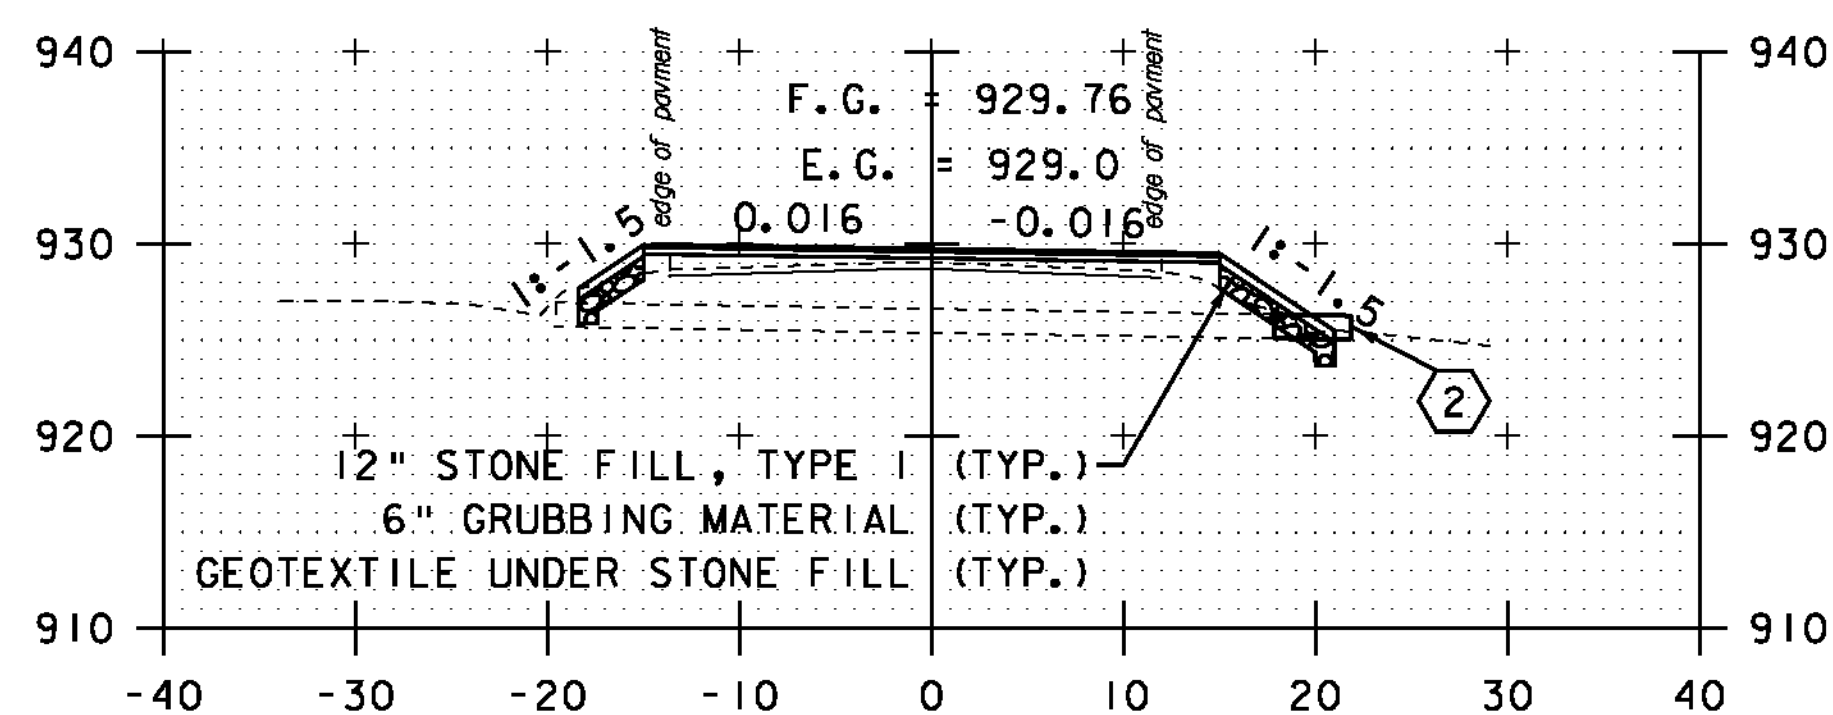

100+00

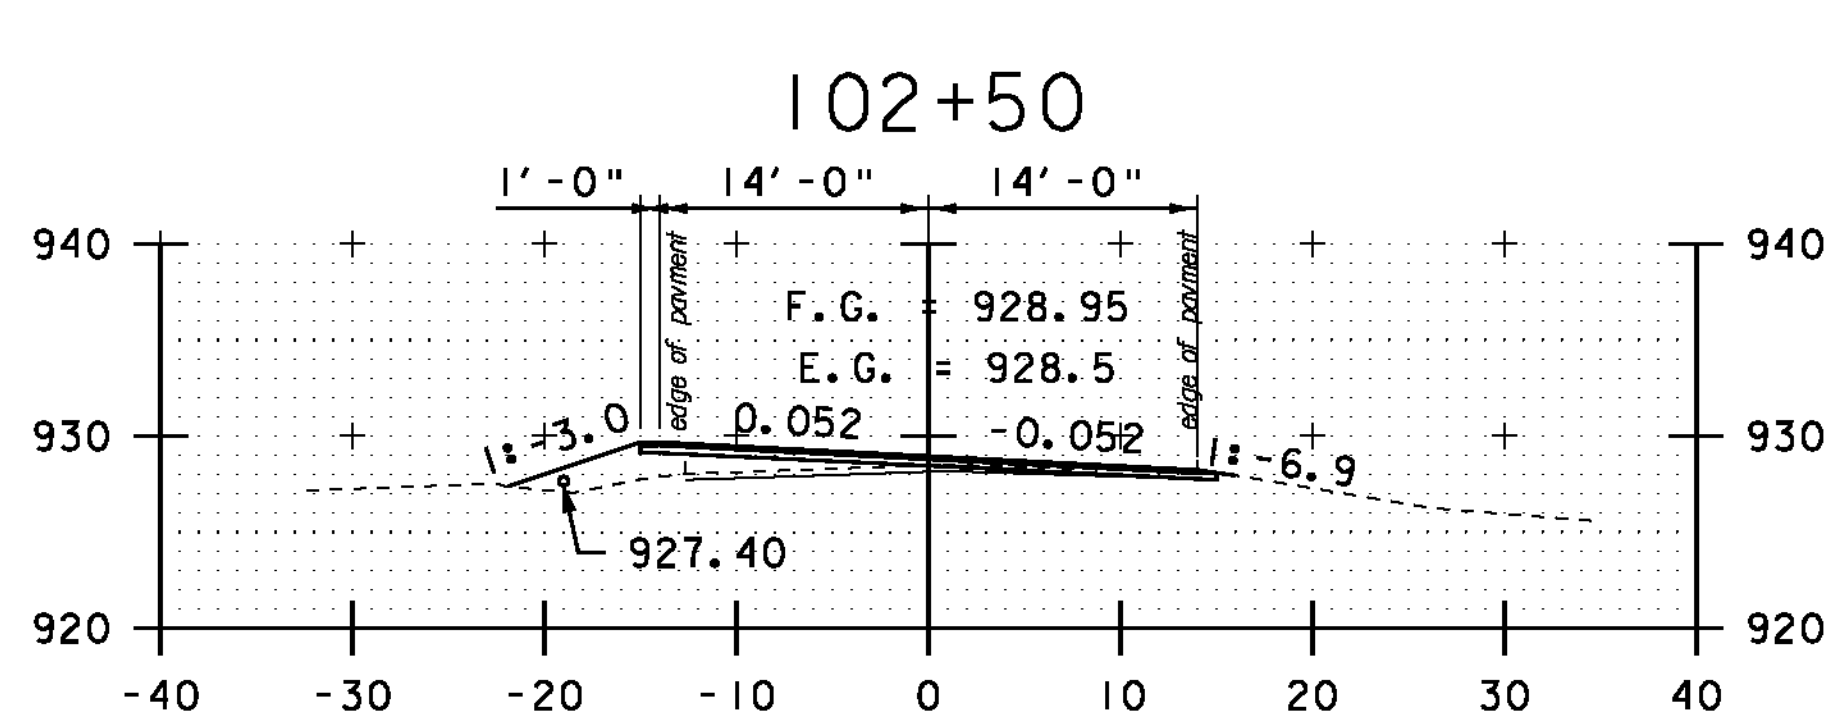

DRIVE RT
102+00

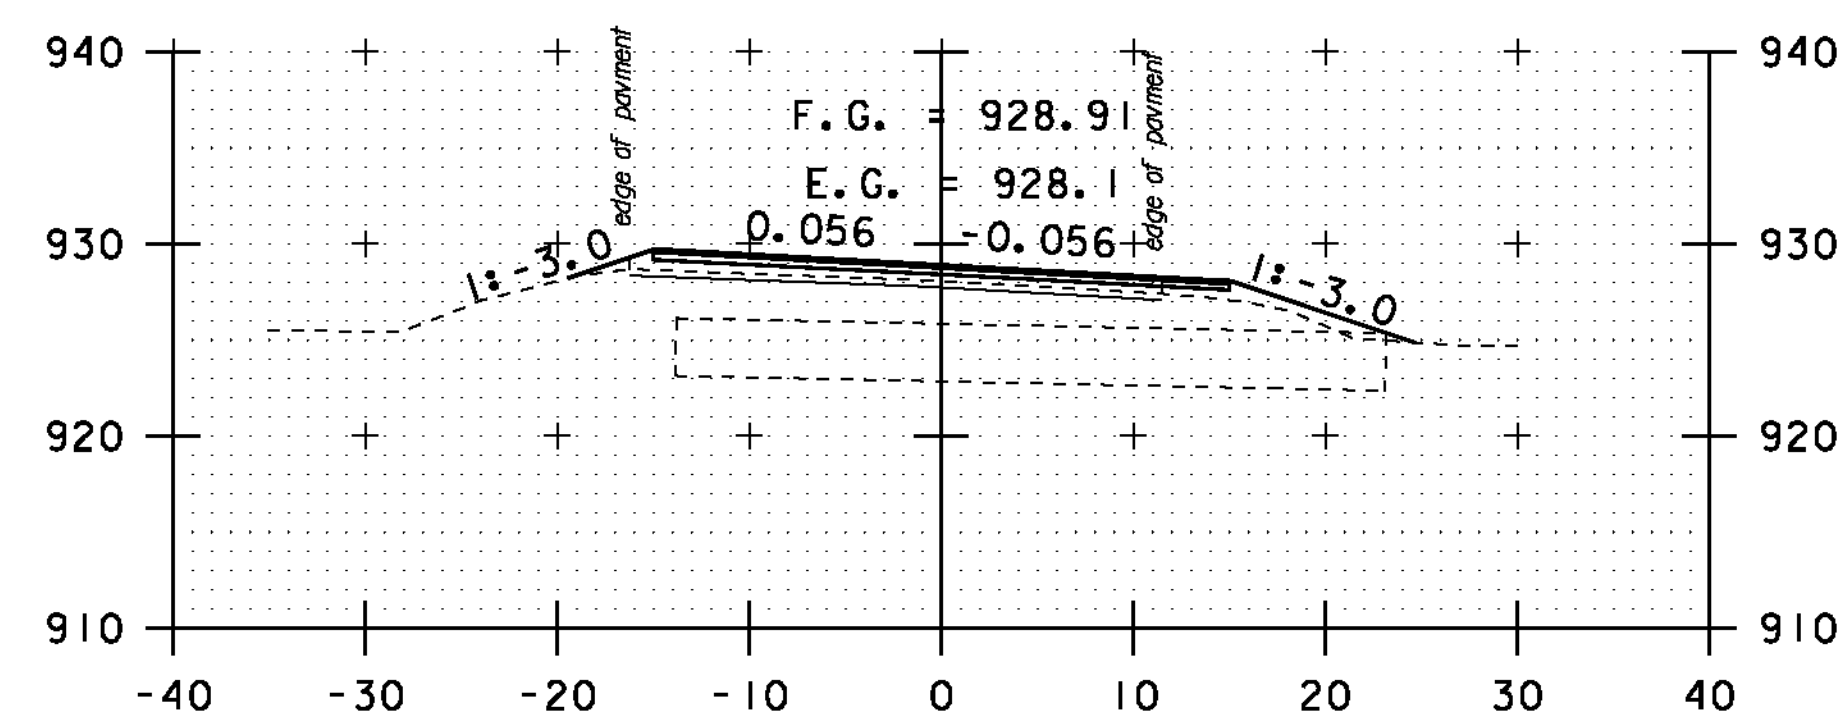

104+00

② STA. 99+98.79 RT 17.84' TO
STA. 99+98.83 RT 21.84'
EXTEND 15" CMP (4'-0")
PROPOSED INV. IN = 925.01'
EXISTING INV. IN = 925.08'

STA. 100+00 TO STA. 105+50

SCALE 1" = 10'-0"
0 10

CROSS SECTION SHEET 20

PROJECT NAME: MONTGOMERY-WESTFIELD
PROJECT NUMBER: STP 2906(I)
FILE NAME: p10ci90.dgn
PROJECT LEADER: CDL
DESIGNED BY: SJL
PLOT FILE: p10ci90_134.l
PLOT DATE: 9/5/12
DRAWN BY: SJL
CHECKED BY: CDL
SHEET 134 OF 178