


DRIVE RT
 110+00

STA. 106+00 TO STA. 111+50

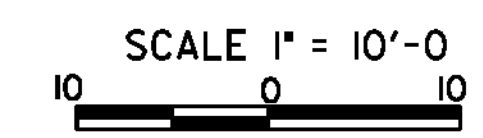

CROSS SECTION SHEET 21

PROJECT NAME: MONTGOMERY-WESTFIELD	PLOT DATE: 9/5/12
PROJECT NUMBER: STP 2906(1)	DRAWN BY: SJL
FILE NAME: p10CI90.dgn	CHECKED BY: CDL
PROJECT LEADER: CDL	SHEET 135 OF 178
DESIGNED BY: SJL	
PLOT FILE: p10CI90_135.I	