




118+50

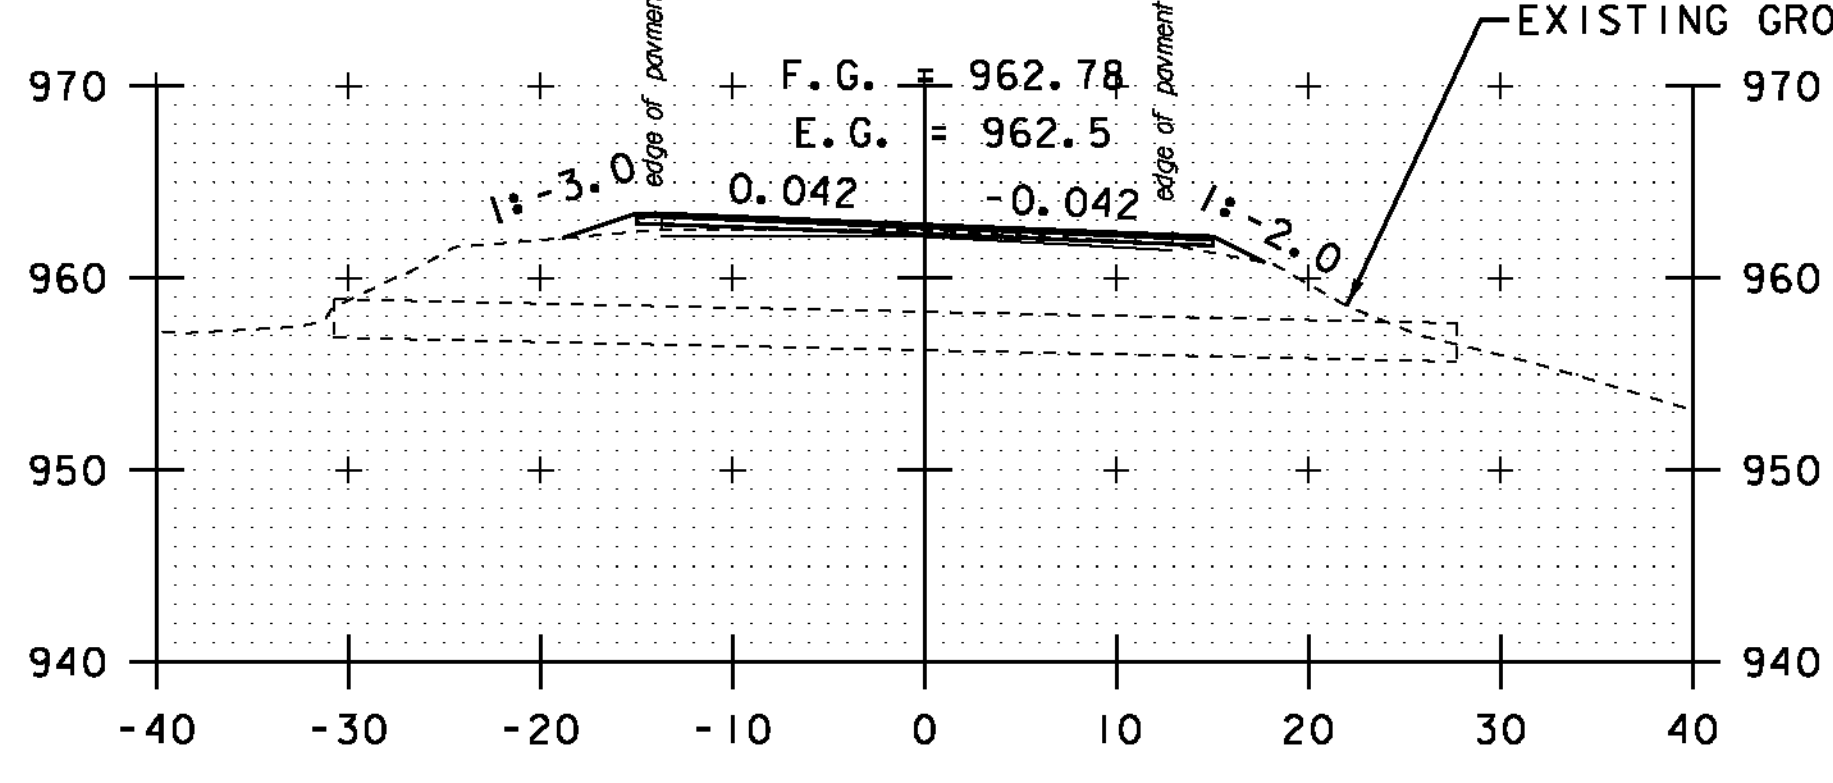


118+00

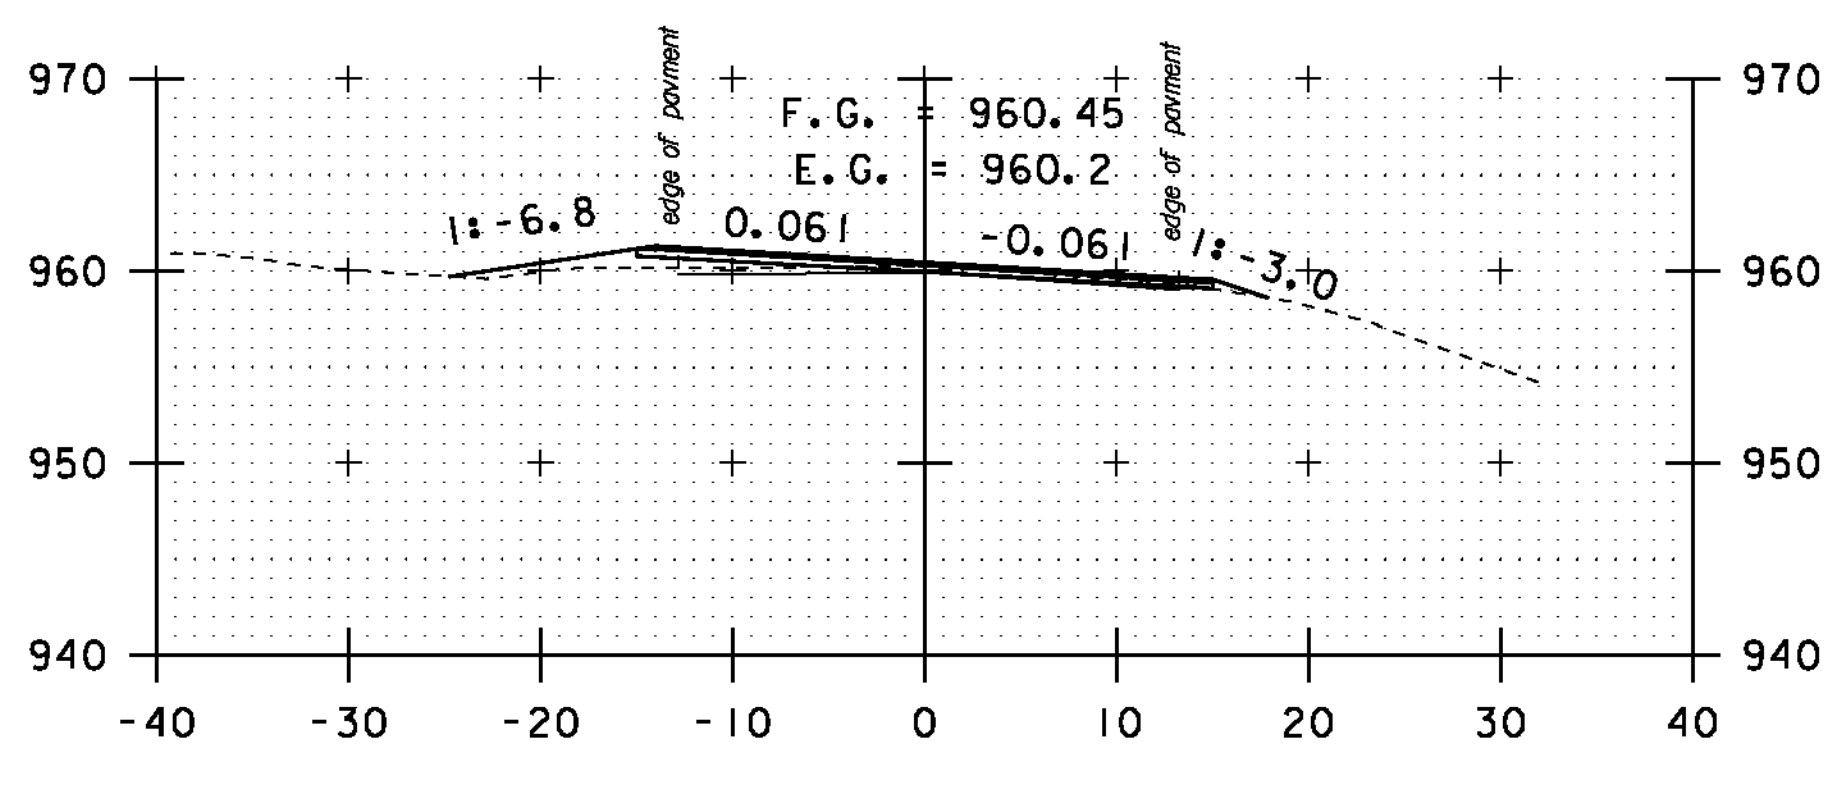


DRIVE LT  
117+50

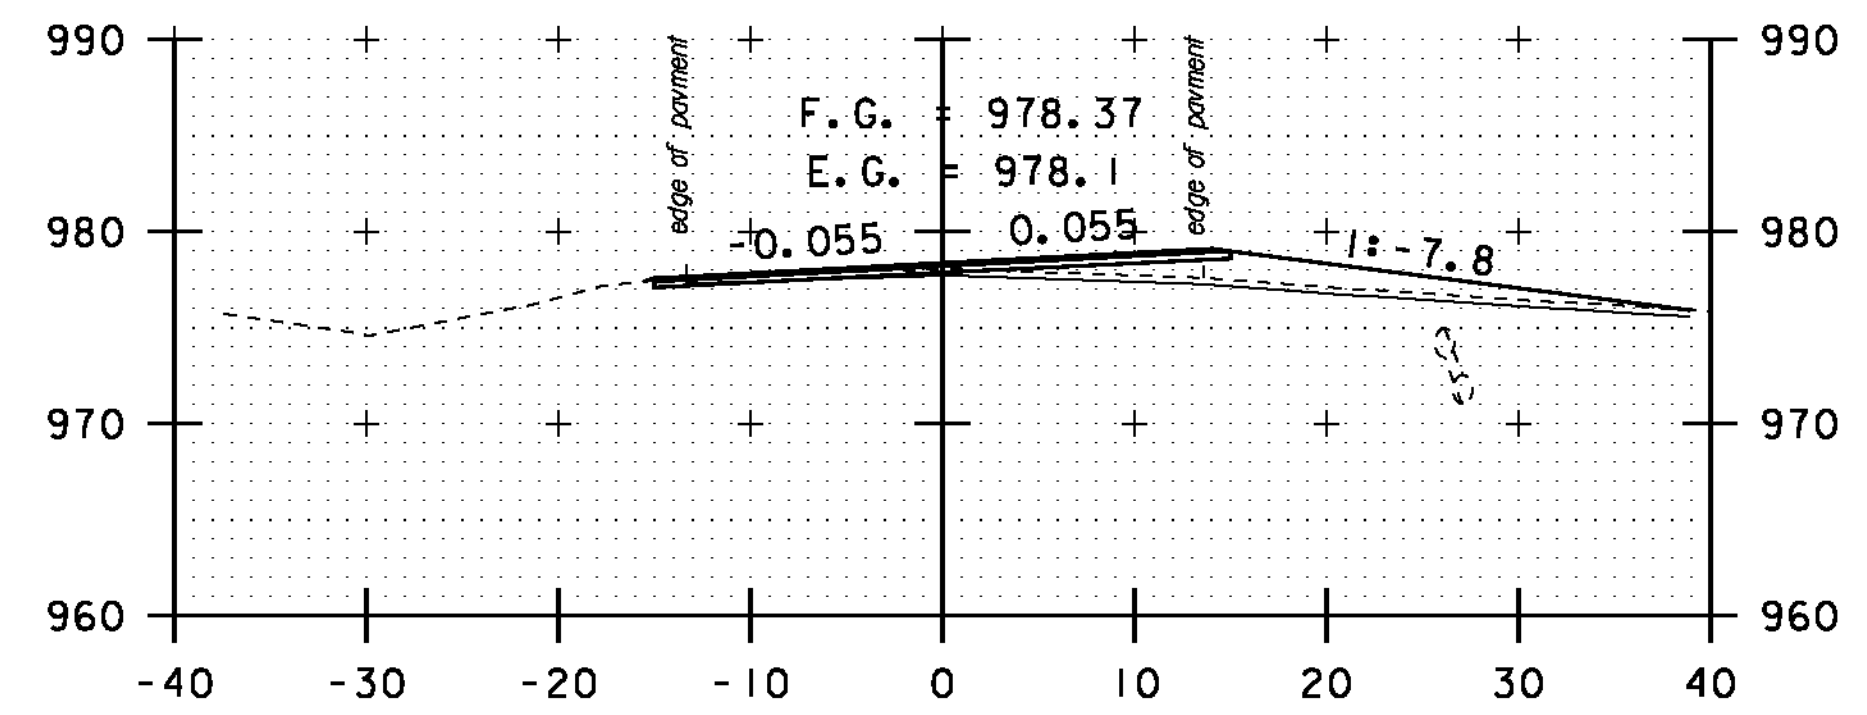


TH #19 RT  
120+50

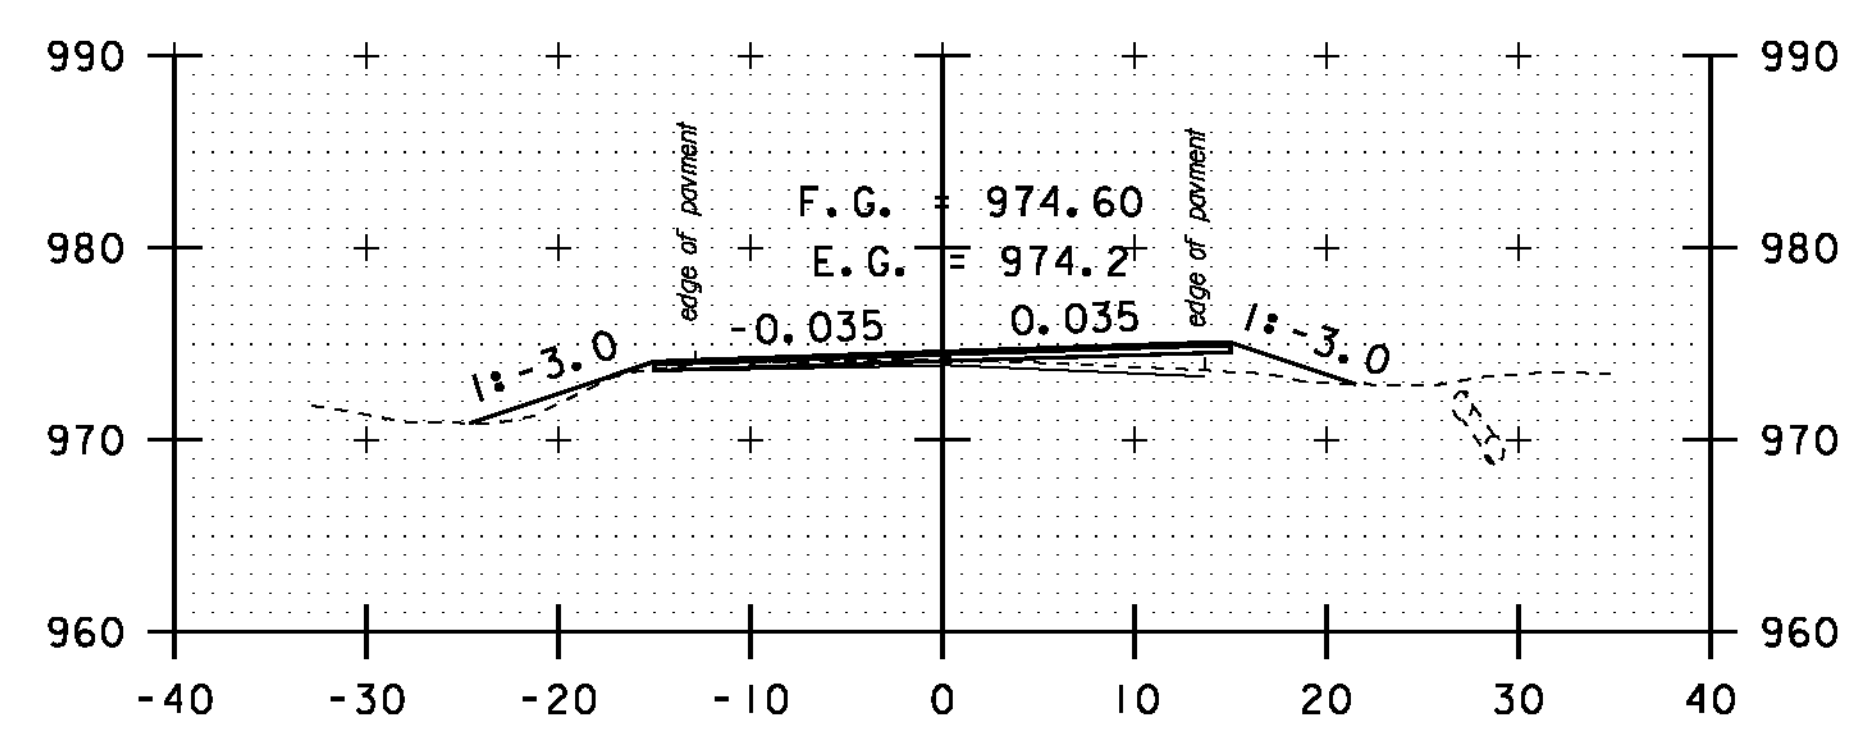


120+00

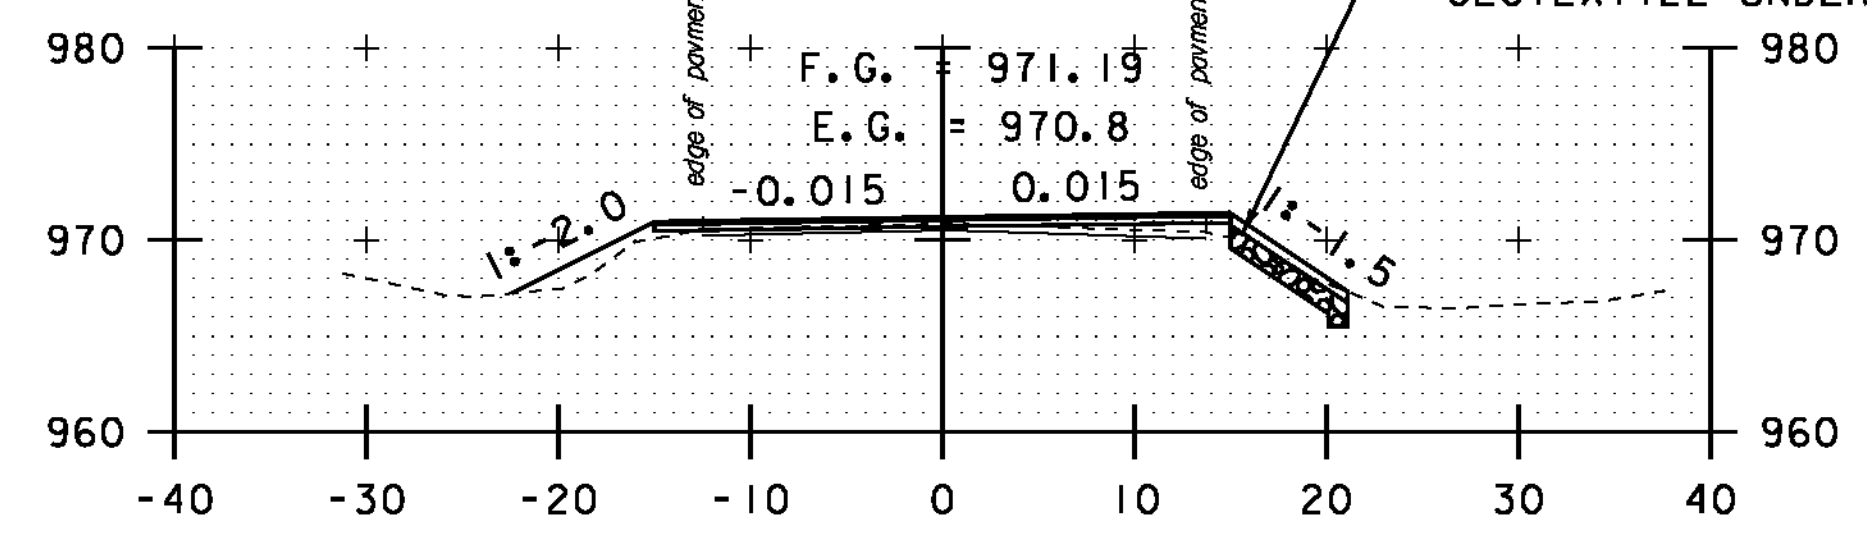


119+50

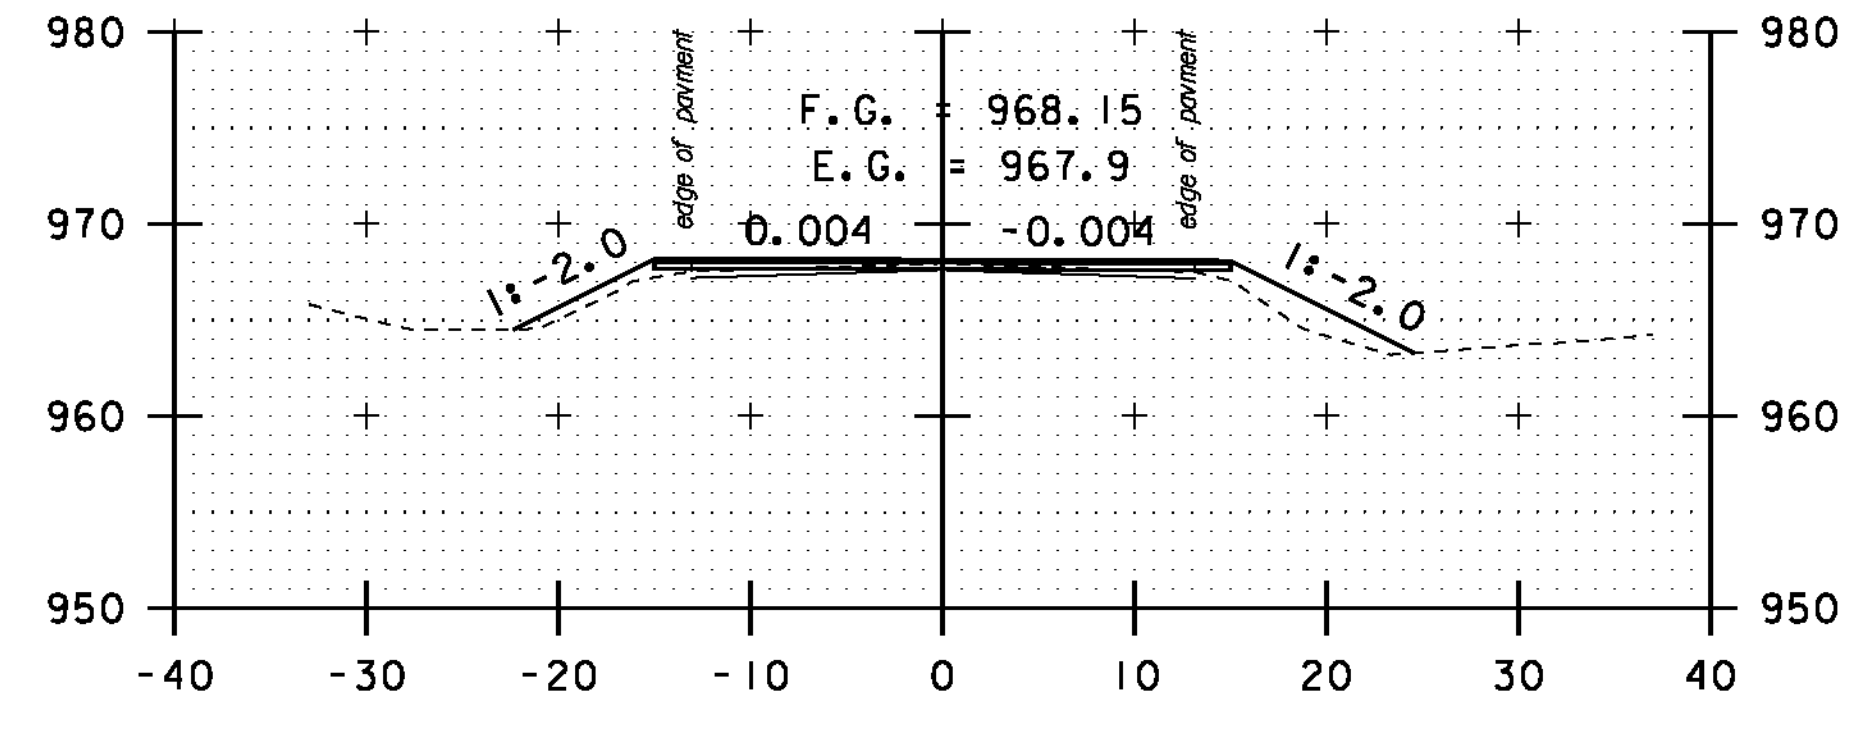


119+00

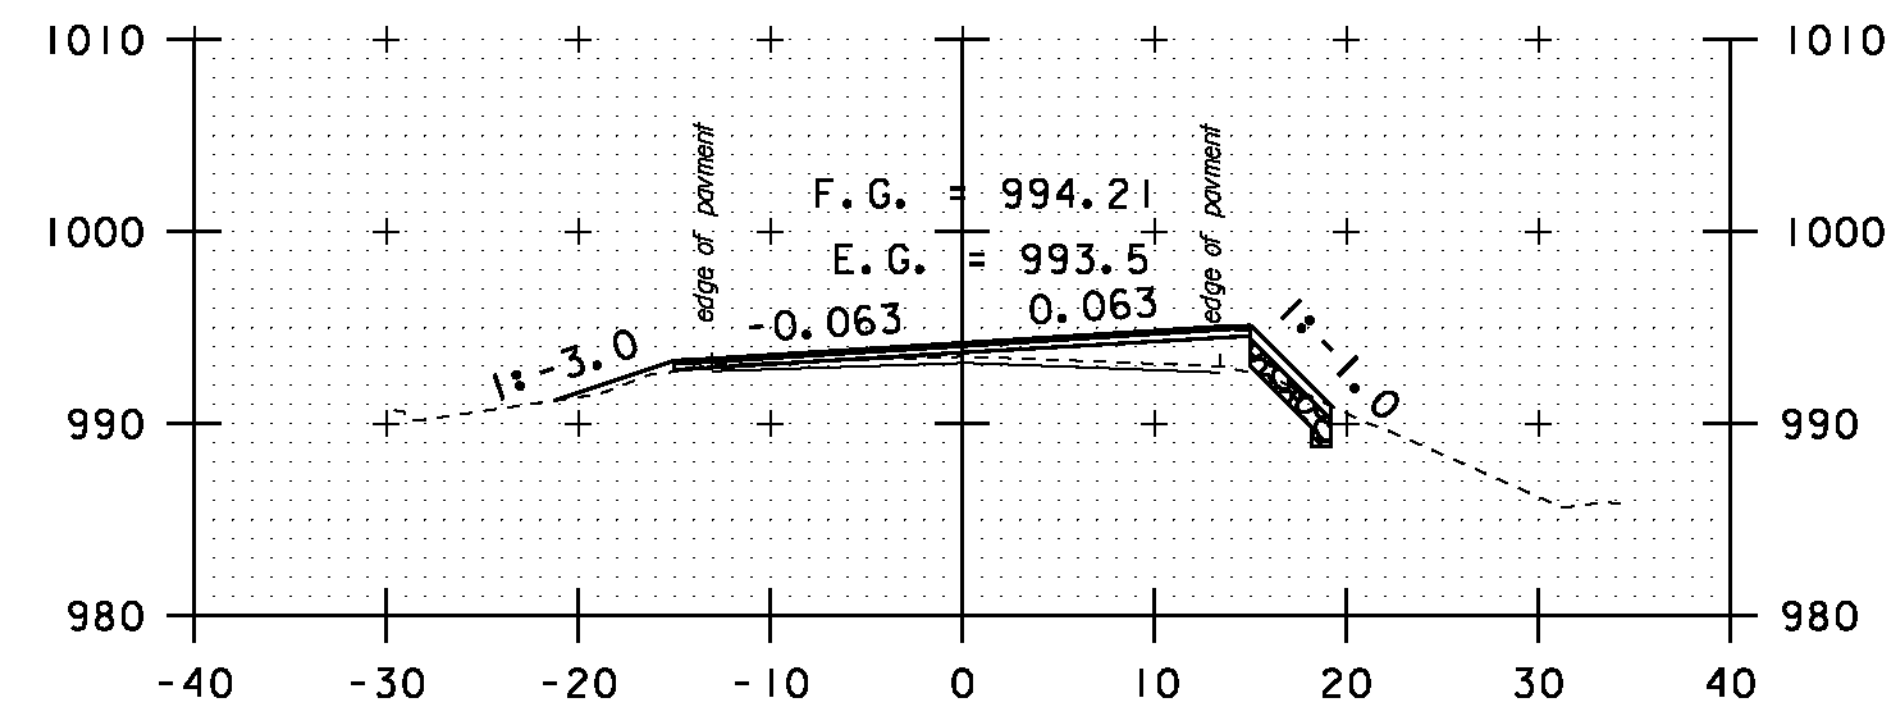


122+50

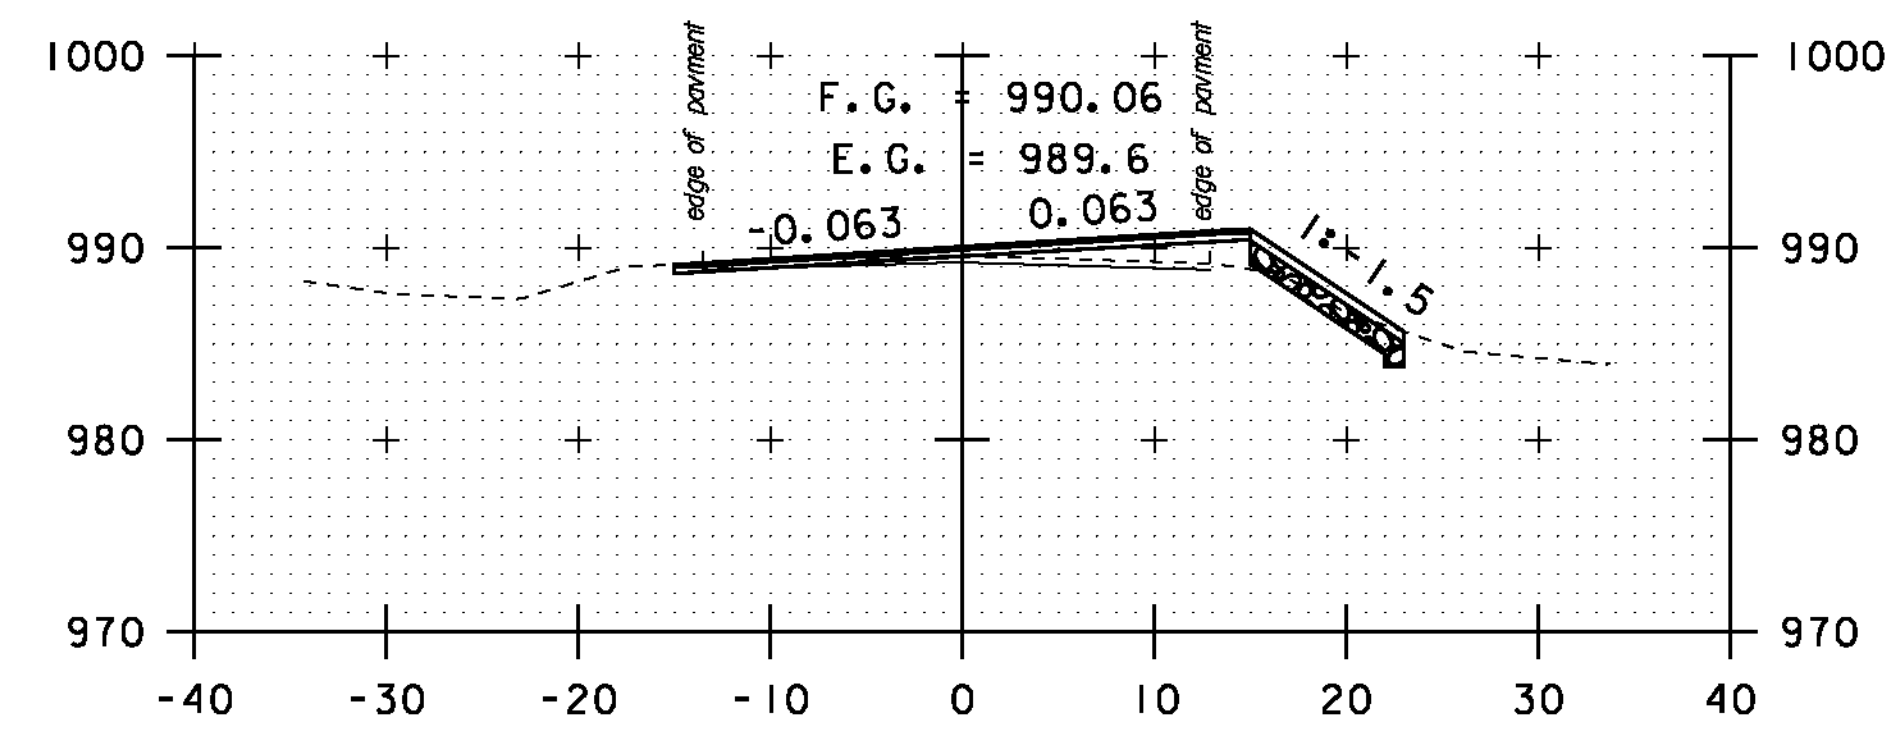

122+00

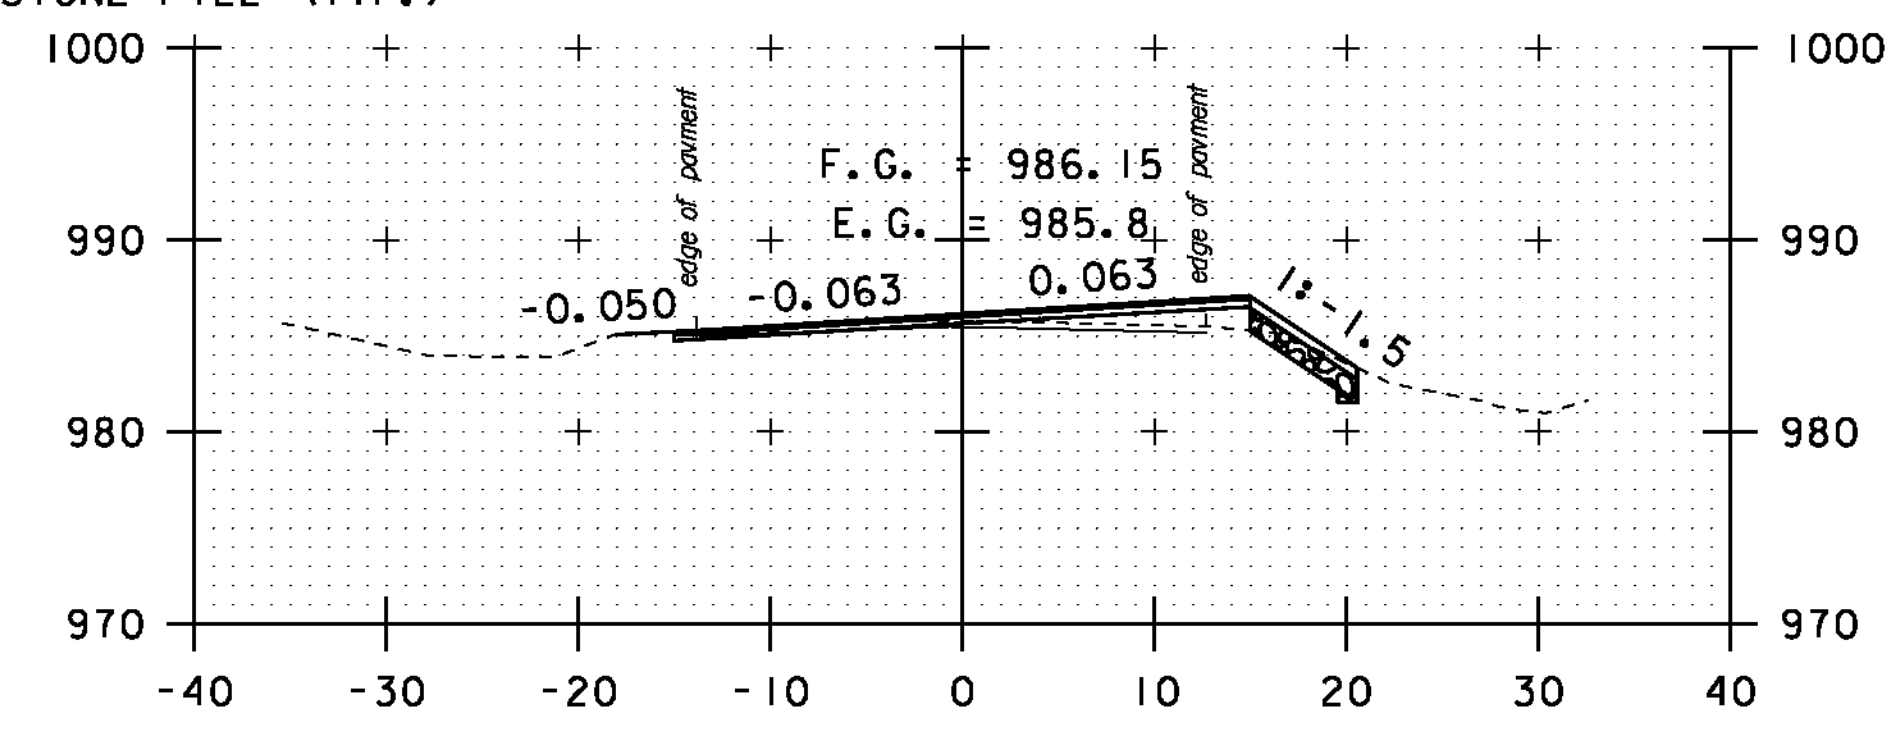


121+50

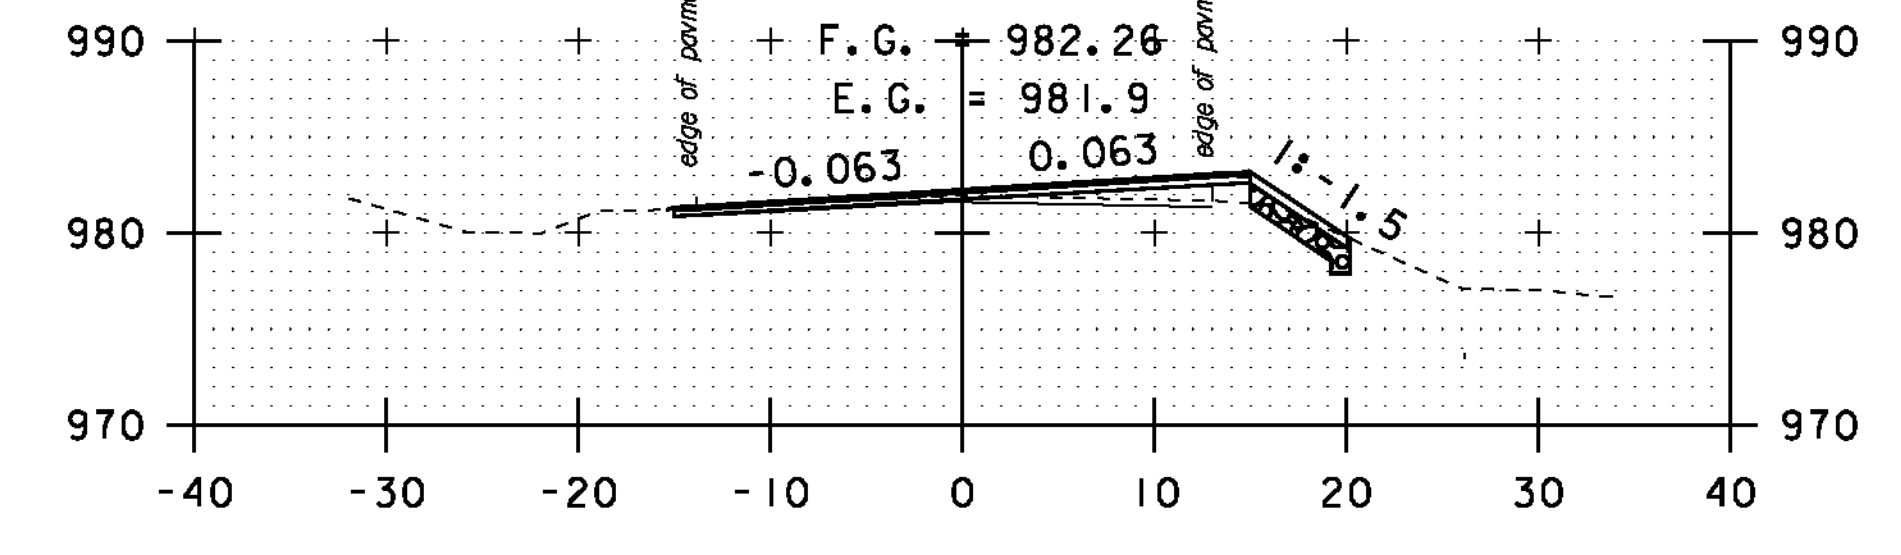

121+00

STA. 117+50 TO STA. 122+50

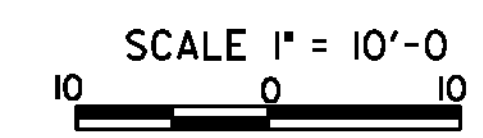

**CROSS SECTION SHEET 23**

PROJECT NAME:	MONTGOMERY-WESTFIELD
PROJECT NUMBER:	STP 2906(I)
FILE NAME:	p10ci90.dgn
PROJECT LEADER:	CDL
DESIGNED BY:	SJL
PLOT FILE:	p10ci90_137.I
PLOT DATE:	9/5/12
DRAWN BY:	SJL
CHECKED BY:	CDL
SHEET	137 OF 178