


STA. 123+00 TO STA. 127+50

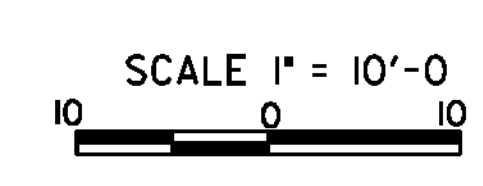

**CROSS SECTION SHEET 24**

PROJECT NAME: MONTGOMERY-WESTFIELD	PLOT DATE: 9/5/12
PROJECT NUMBER: STP 2906(I)	DRAWN BY: SJL
FILE NAME: p10ci90.dgn	CHECKED BY: CDL
PROJECT LEADER: CDL	SHEET 138 OF 178
DESIGNED BY: SJL	
PLOT FILE: p10ci90_138.l	