




146+00

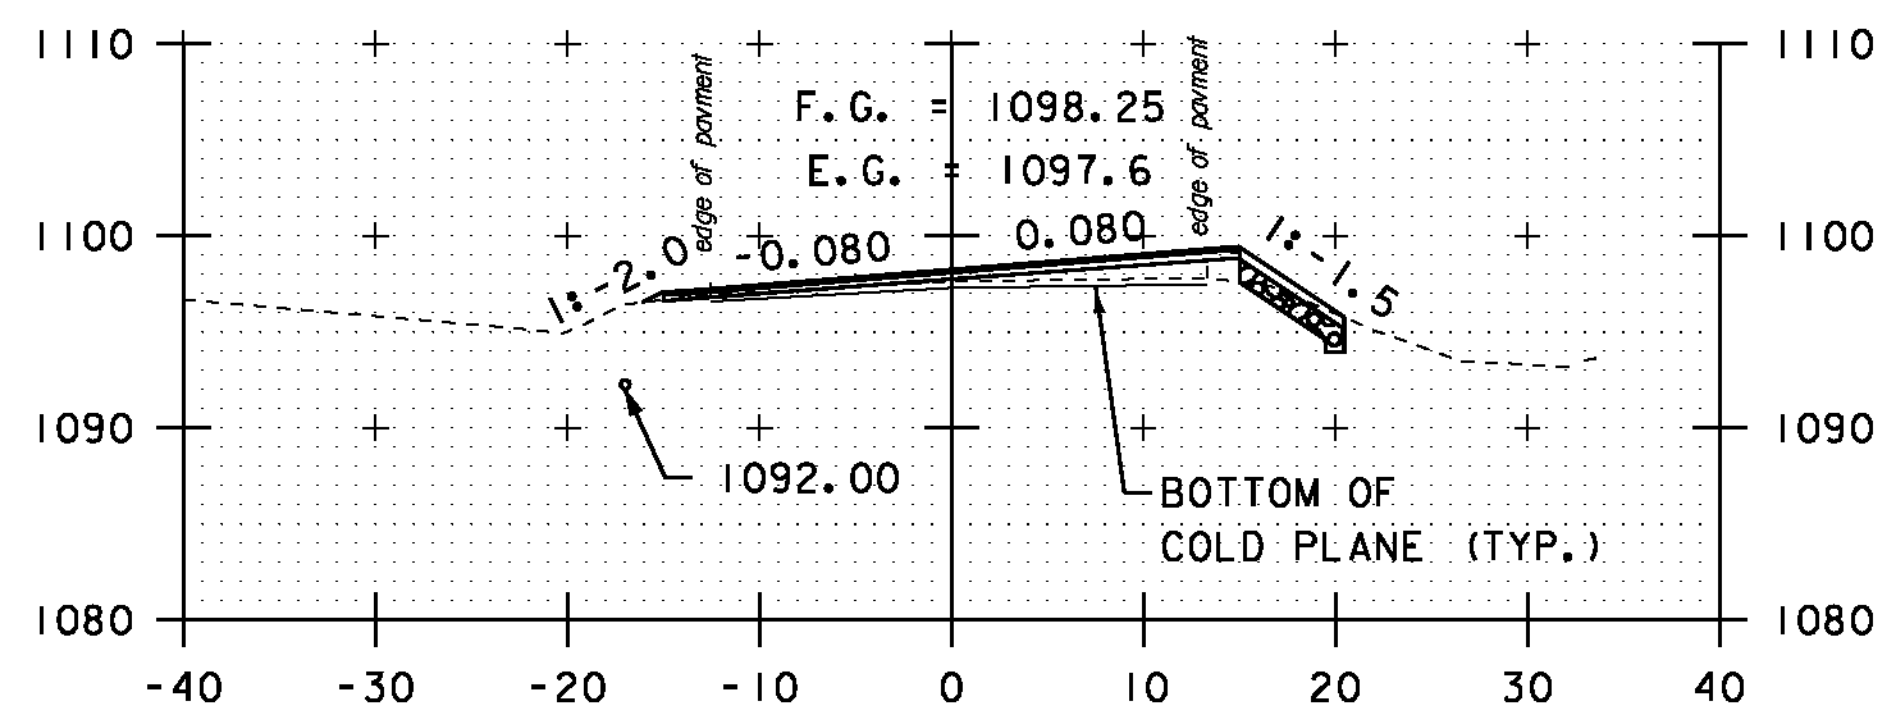


145+50

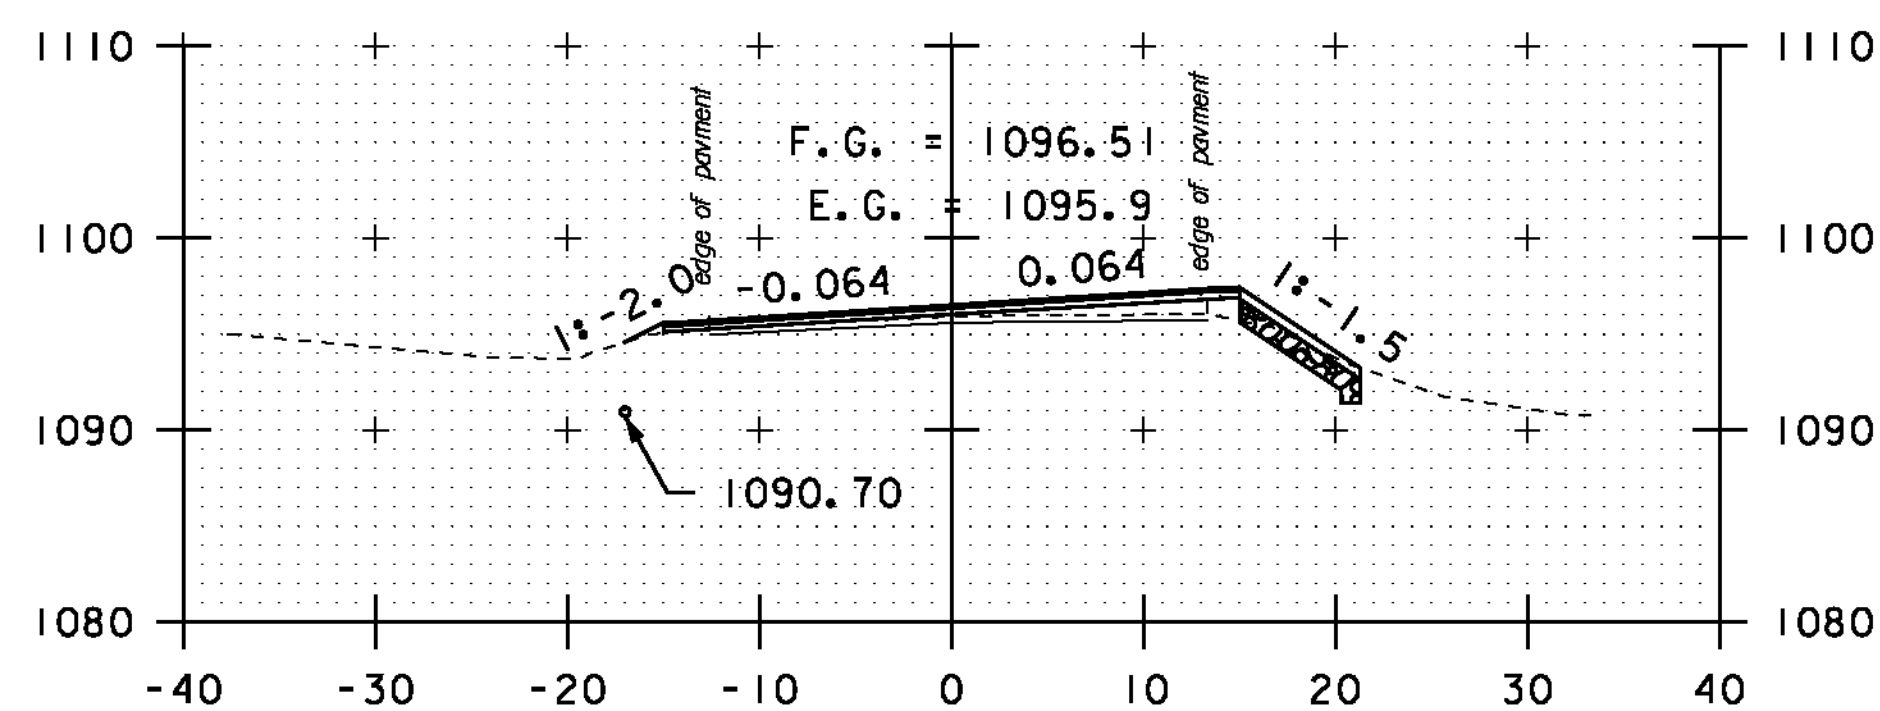


145+00

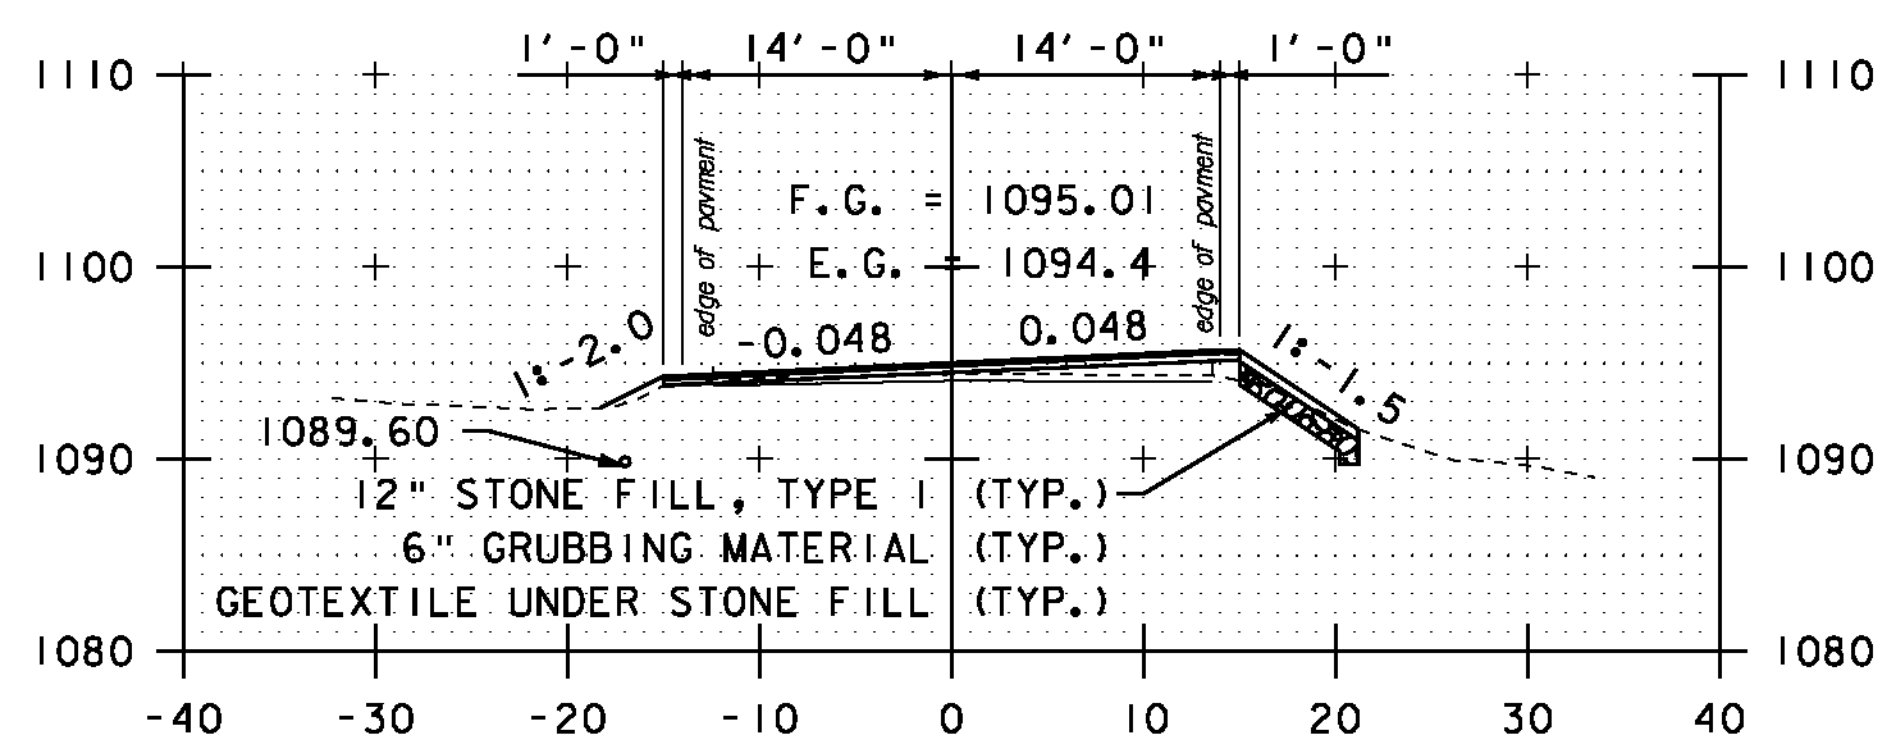


144+50

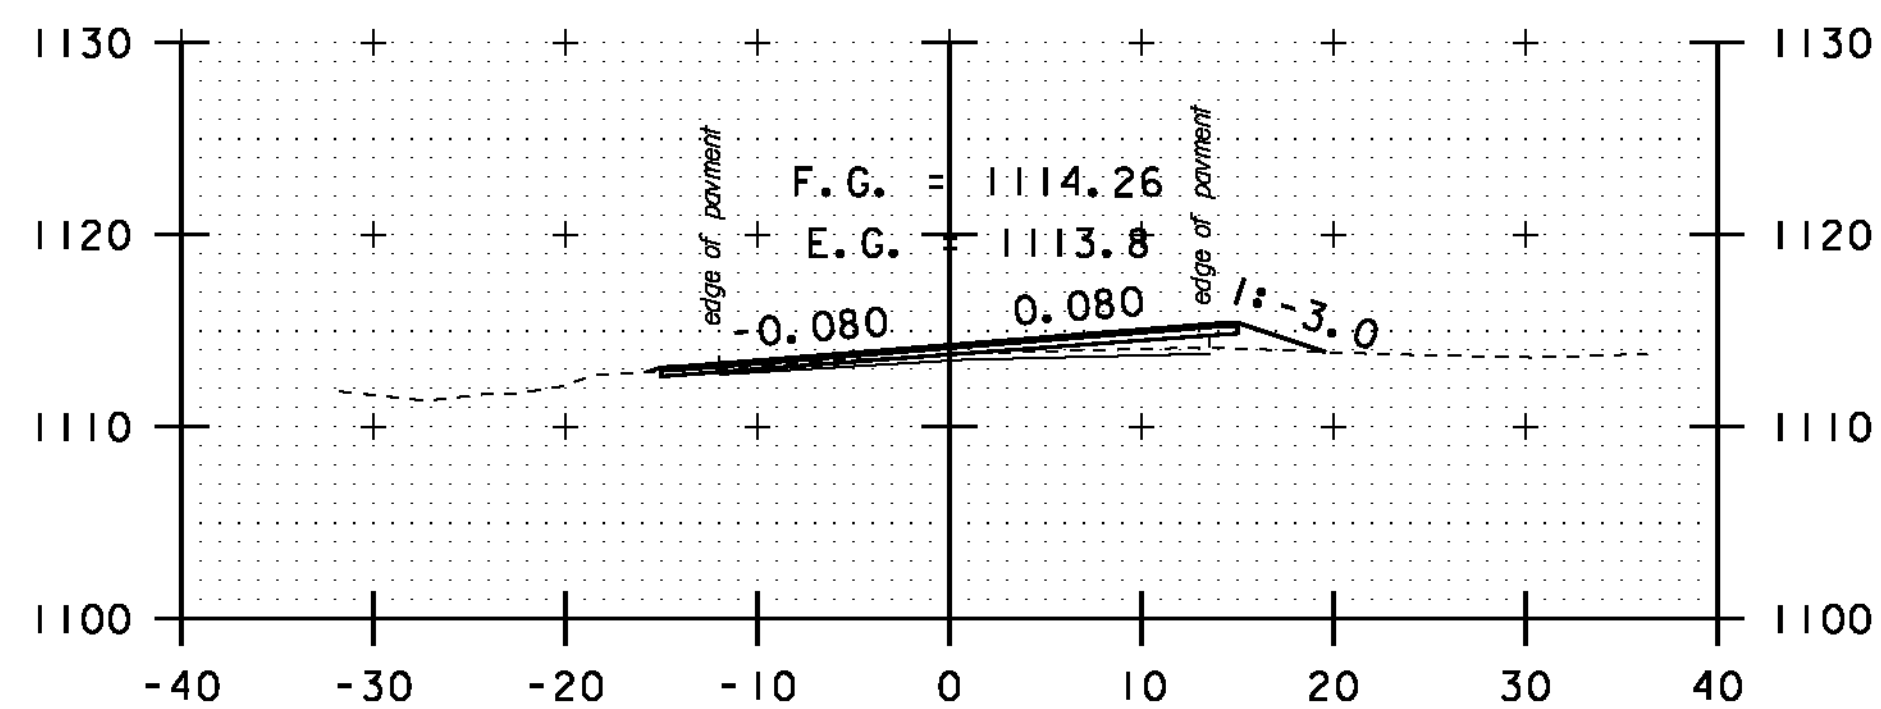


148+00

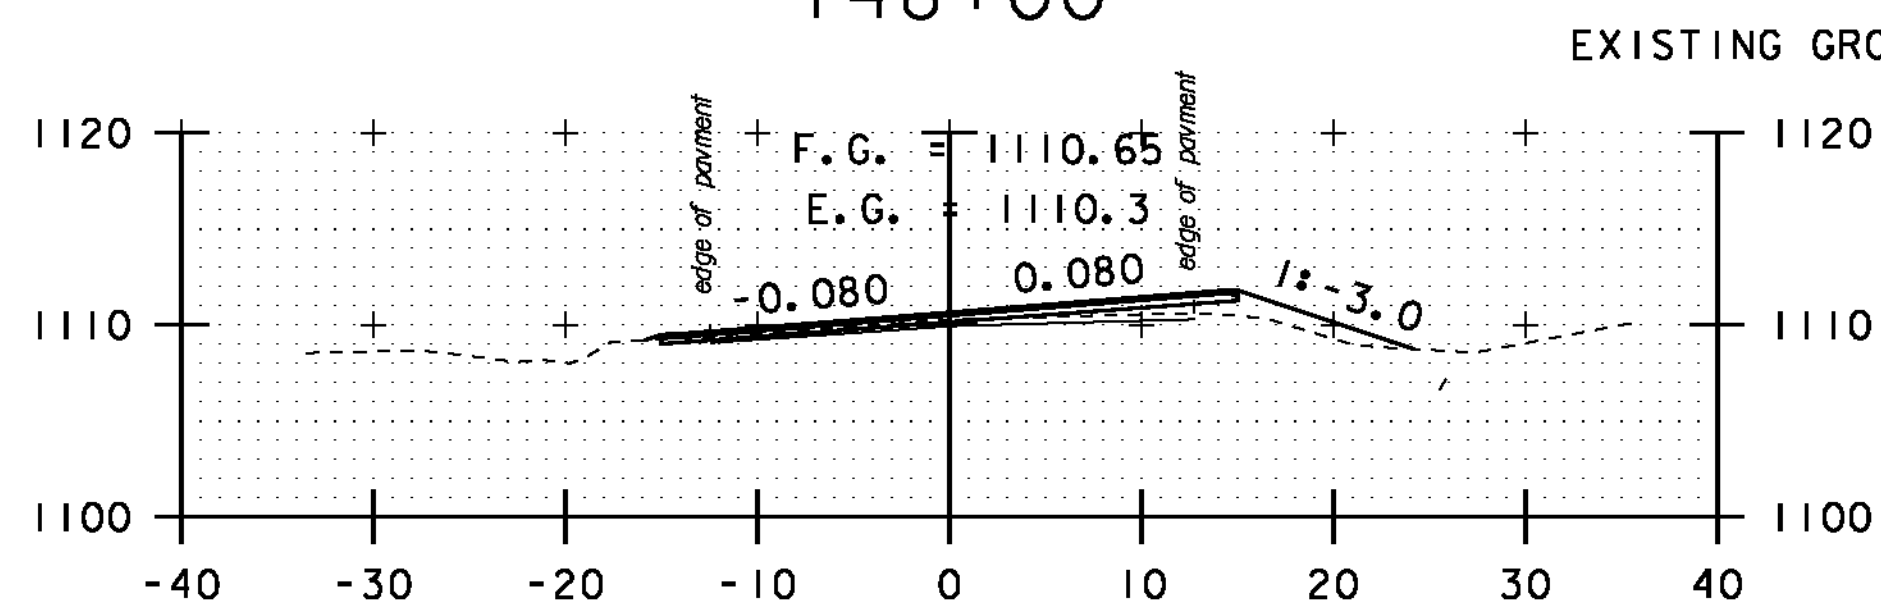


147+50

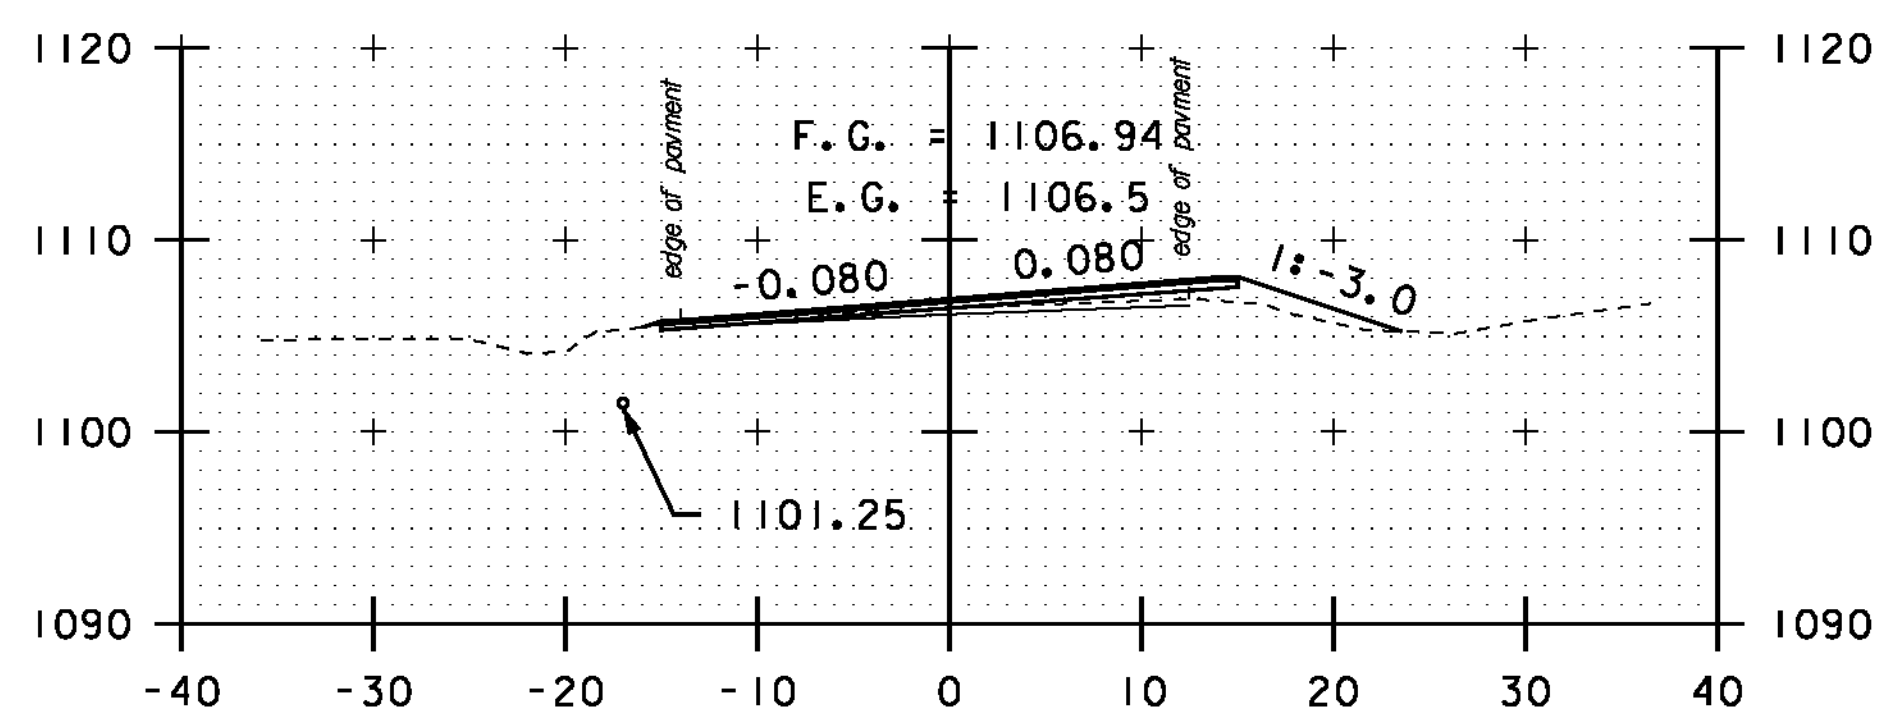


147+00

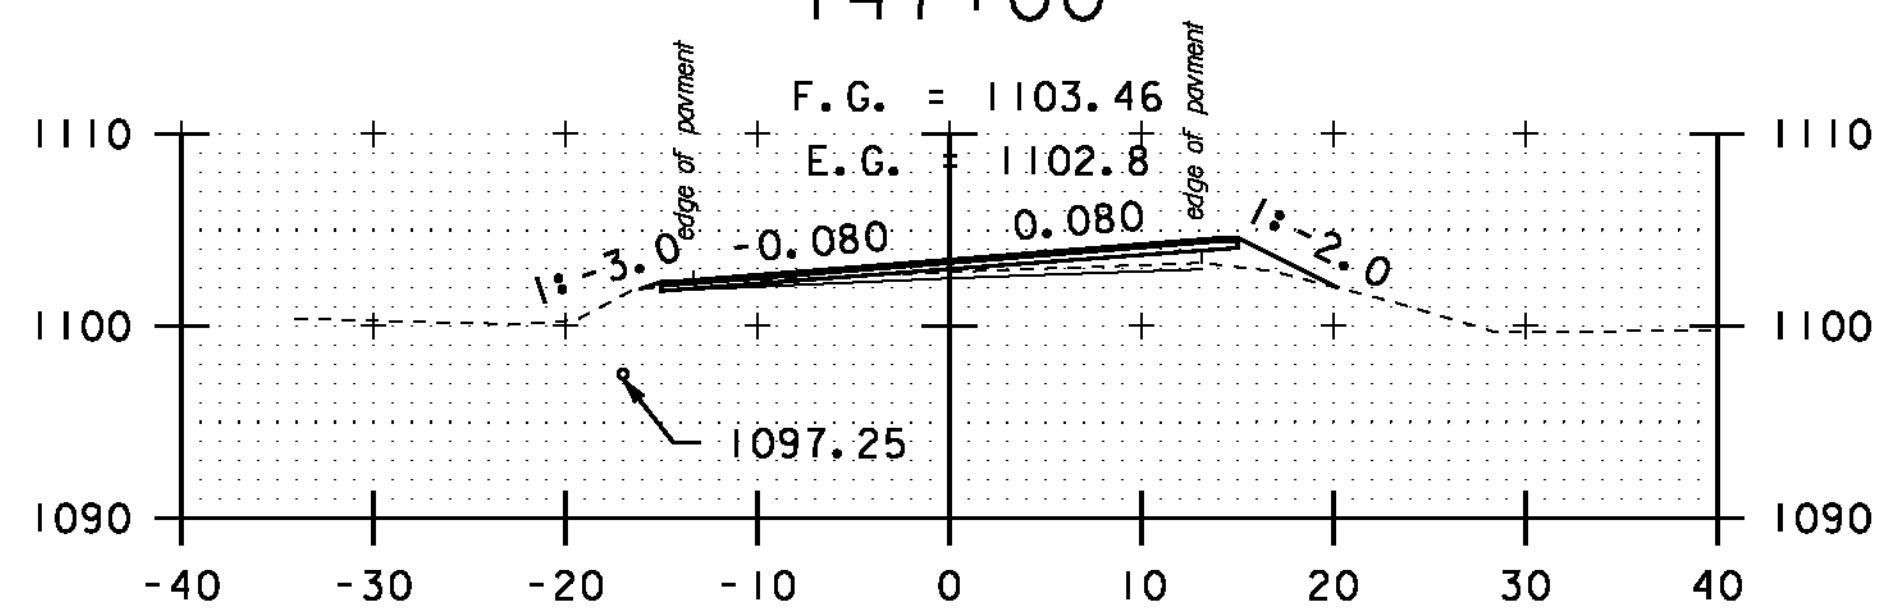


146+50

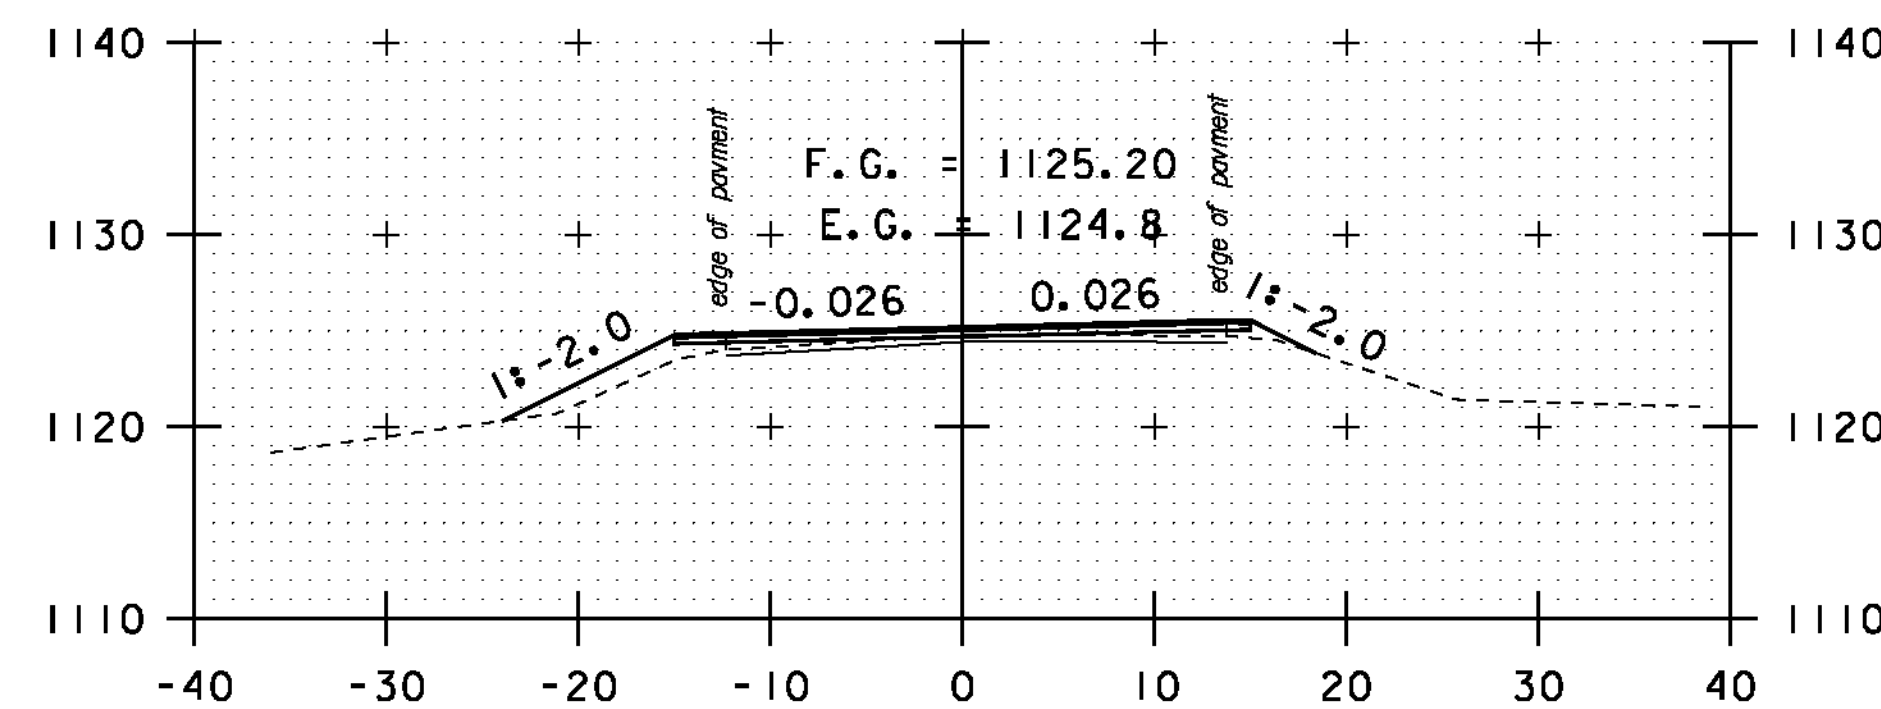


150+00

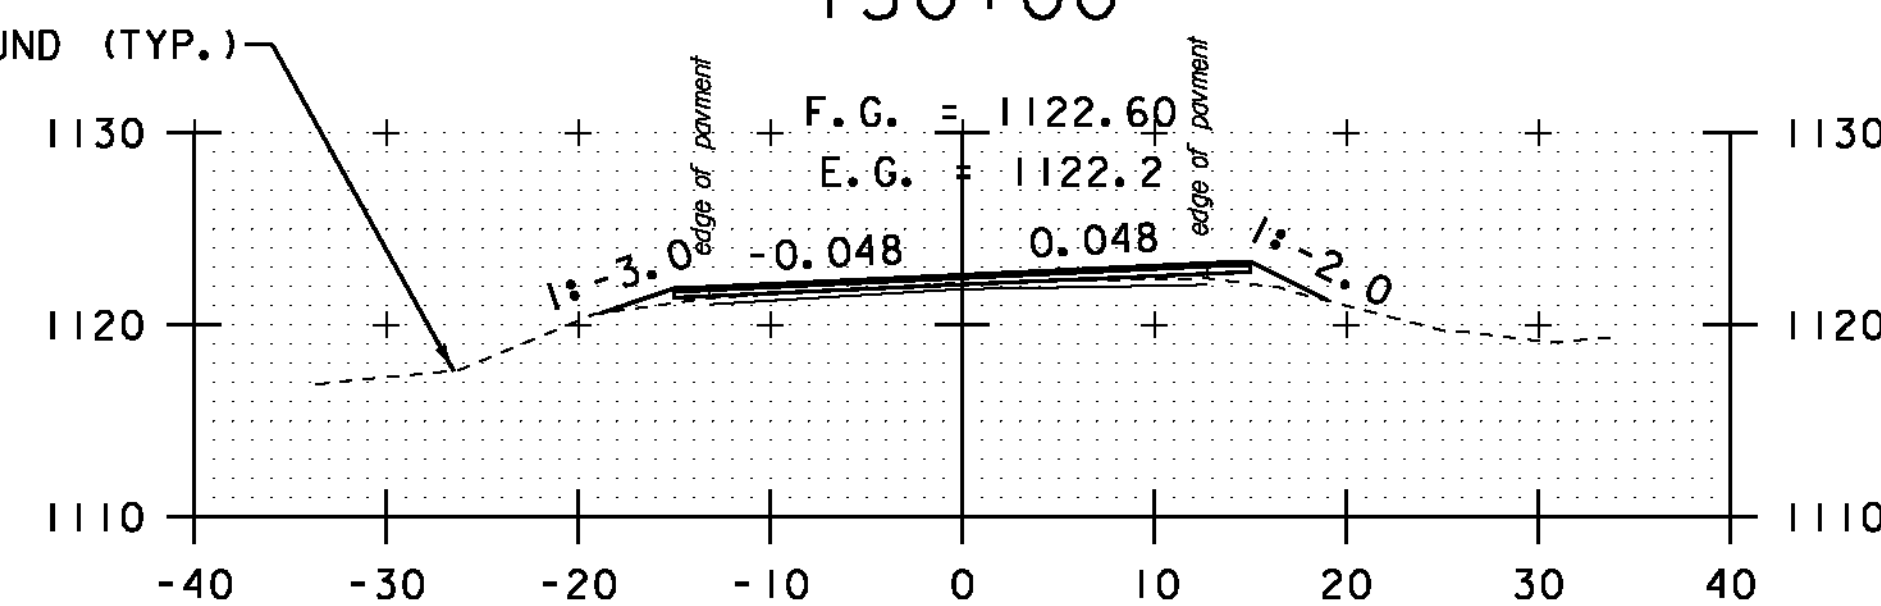

149+50

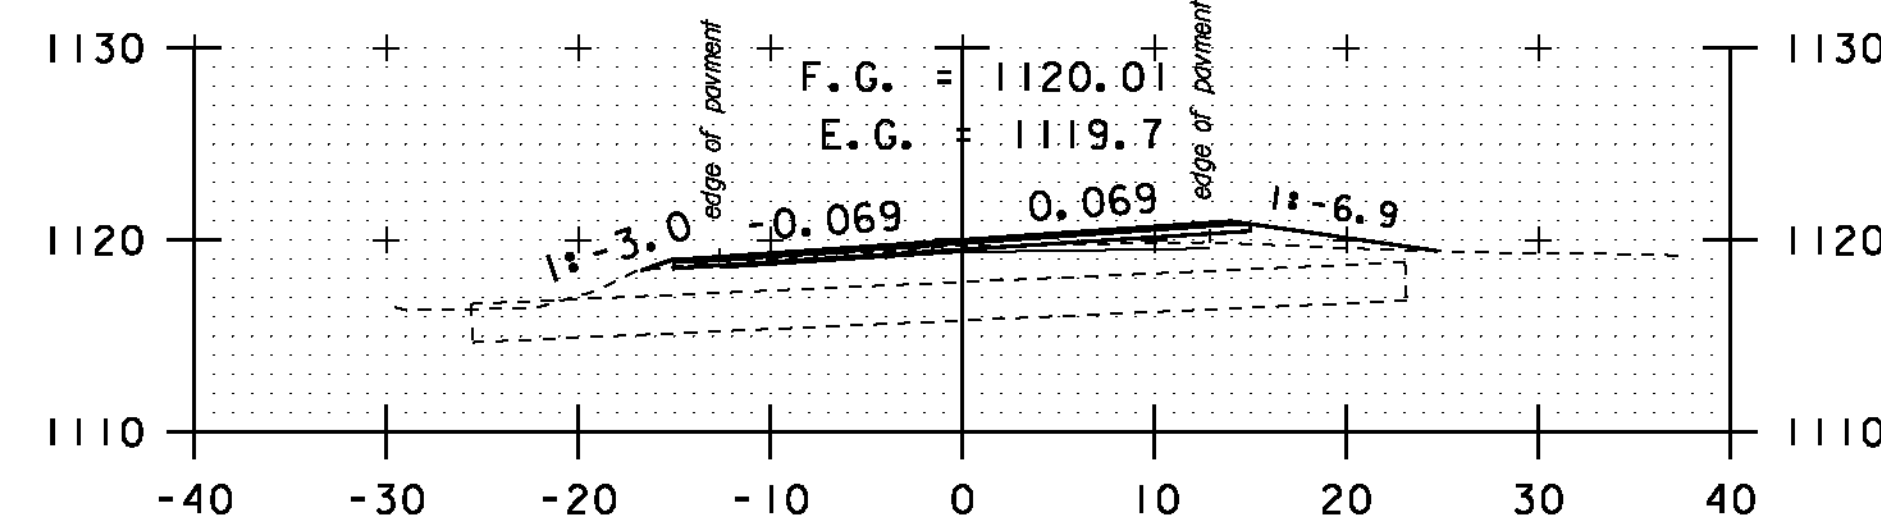

DRIVE RT
149+00

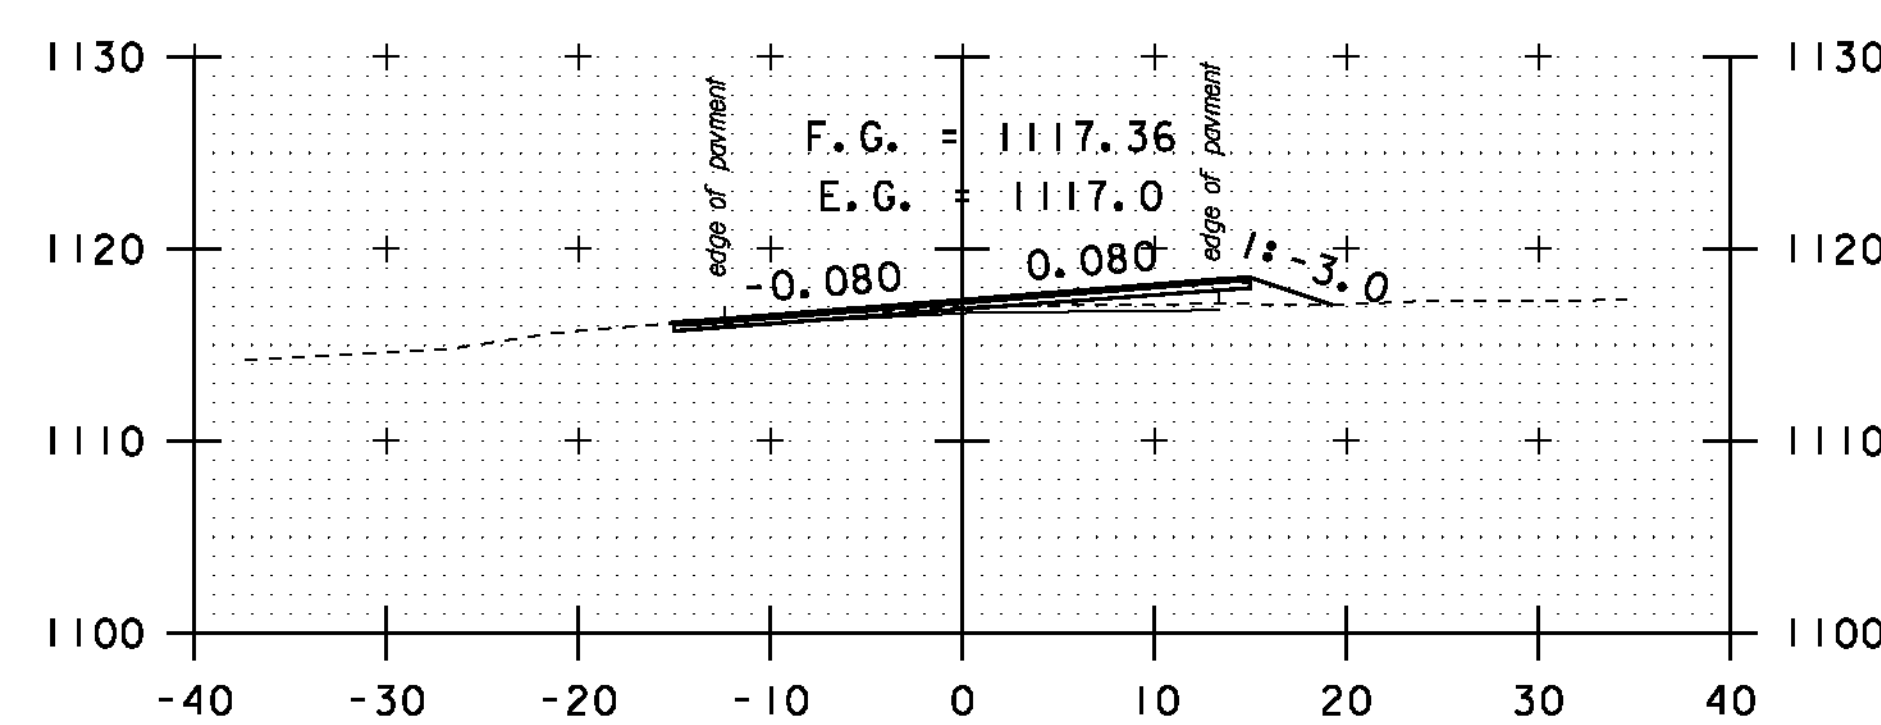

148+50

STA. 144+50 TO STA. 150+00



CROSS SECTION SHEET 28

PROJECT NAME: MONTGOMERY-WESTFIELD
 PROJECT NUMBER: STP 2906(I)
 FILE NAME: p10ci90.dgn
 PROJECT LEADER: CDL
 DESIGNED BY: SJL
 PLOT FILE: p10ci90_142.j
 PLOT DATE: 9/5/12
 DRAWN BY: SJL
 CHECKED BY: CDL
 SHEET 142 OF 178