


STA. 150+50 TO STA. 156+00

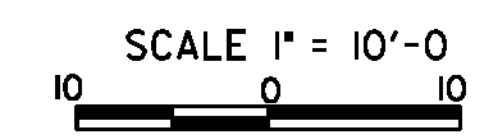

CROSS SECTION SHEET 29

PROJECT NAME: MONTGOMERY-WESTFIELD	PLOT DATE: 9/5/12
PROJECT NUMBER: STP 2906(I)	DRAWN BY: SJL
FILE NAME: p10ci90.dgn	CHECKED BY: CDL
PROJECT LEADER: CDL	SHEET 143 OF 178
DESIGNED BY: SJL	
PLOT FILE: p10ci90_143.l	