




158+00

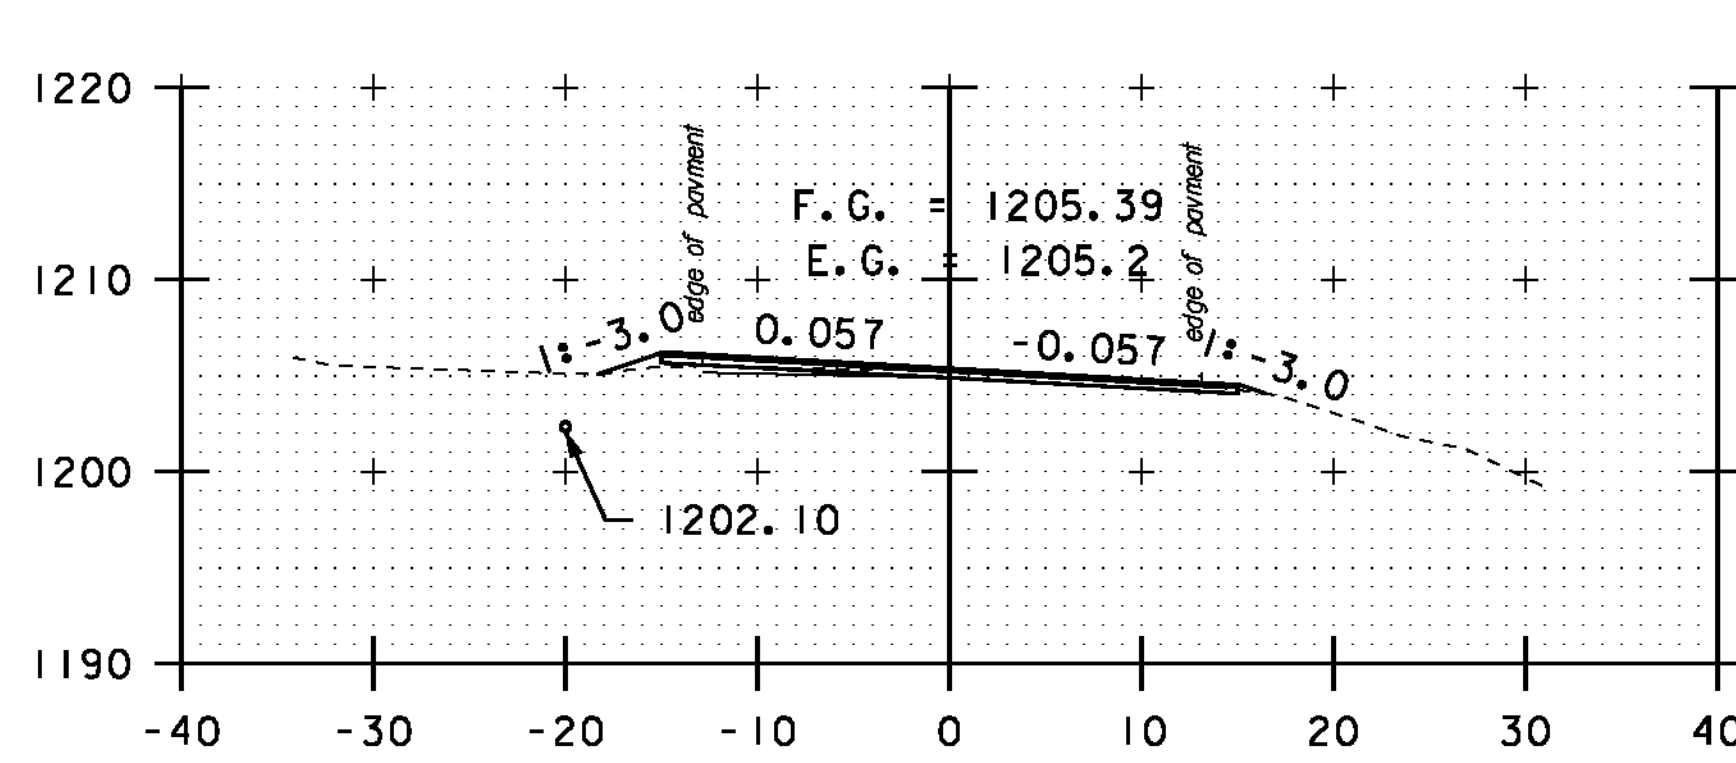


160+00

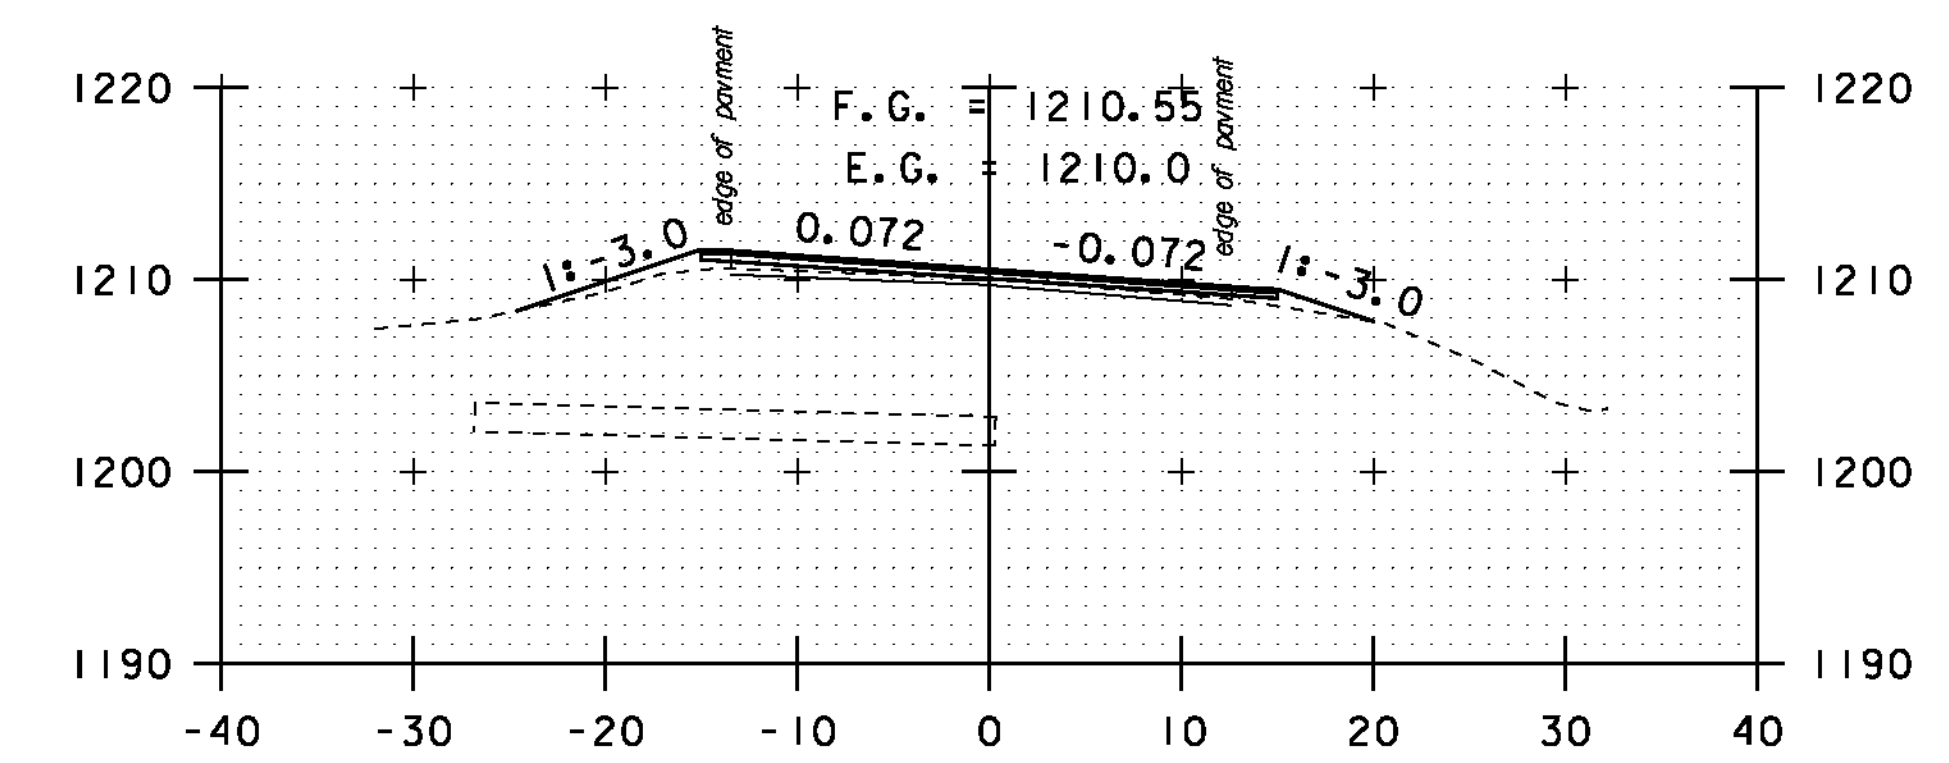


162+00

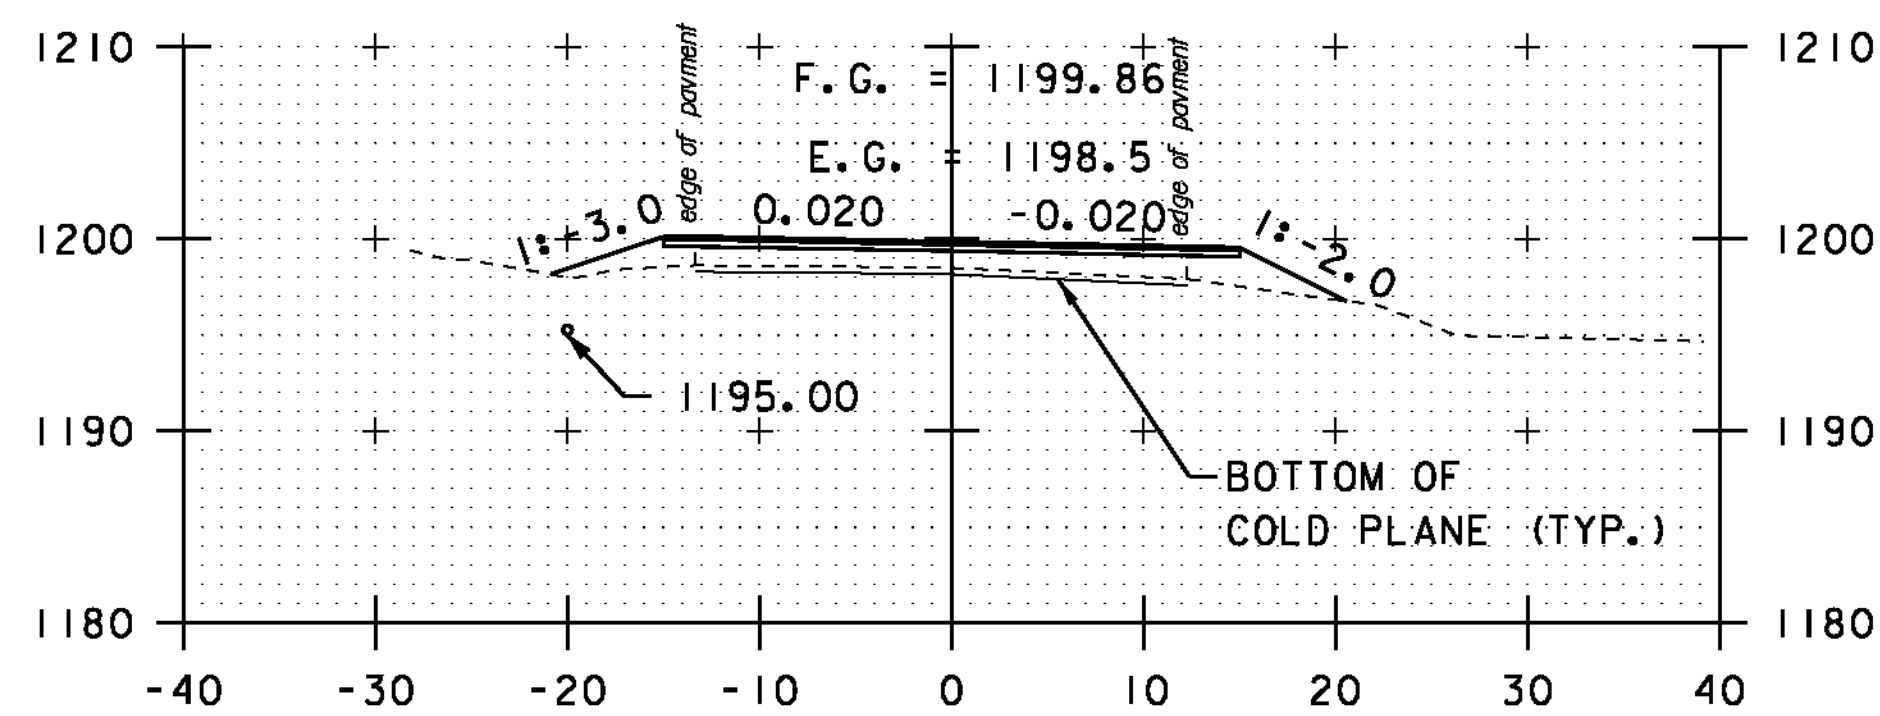


157+50

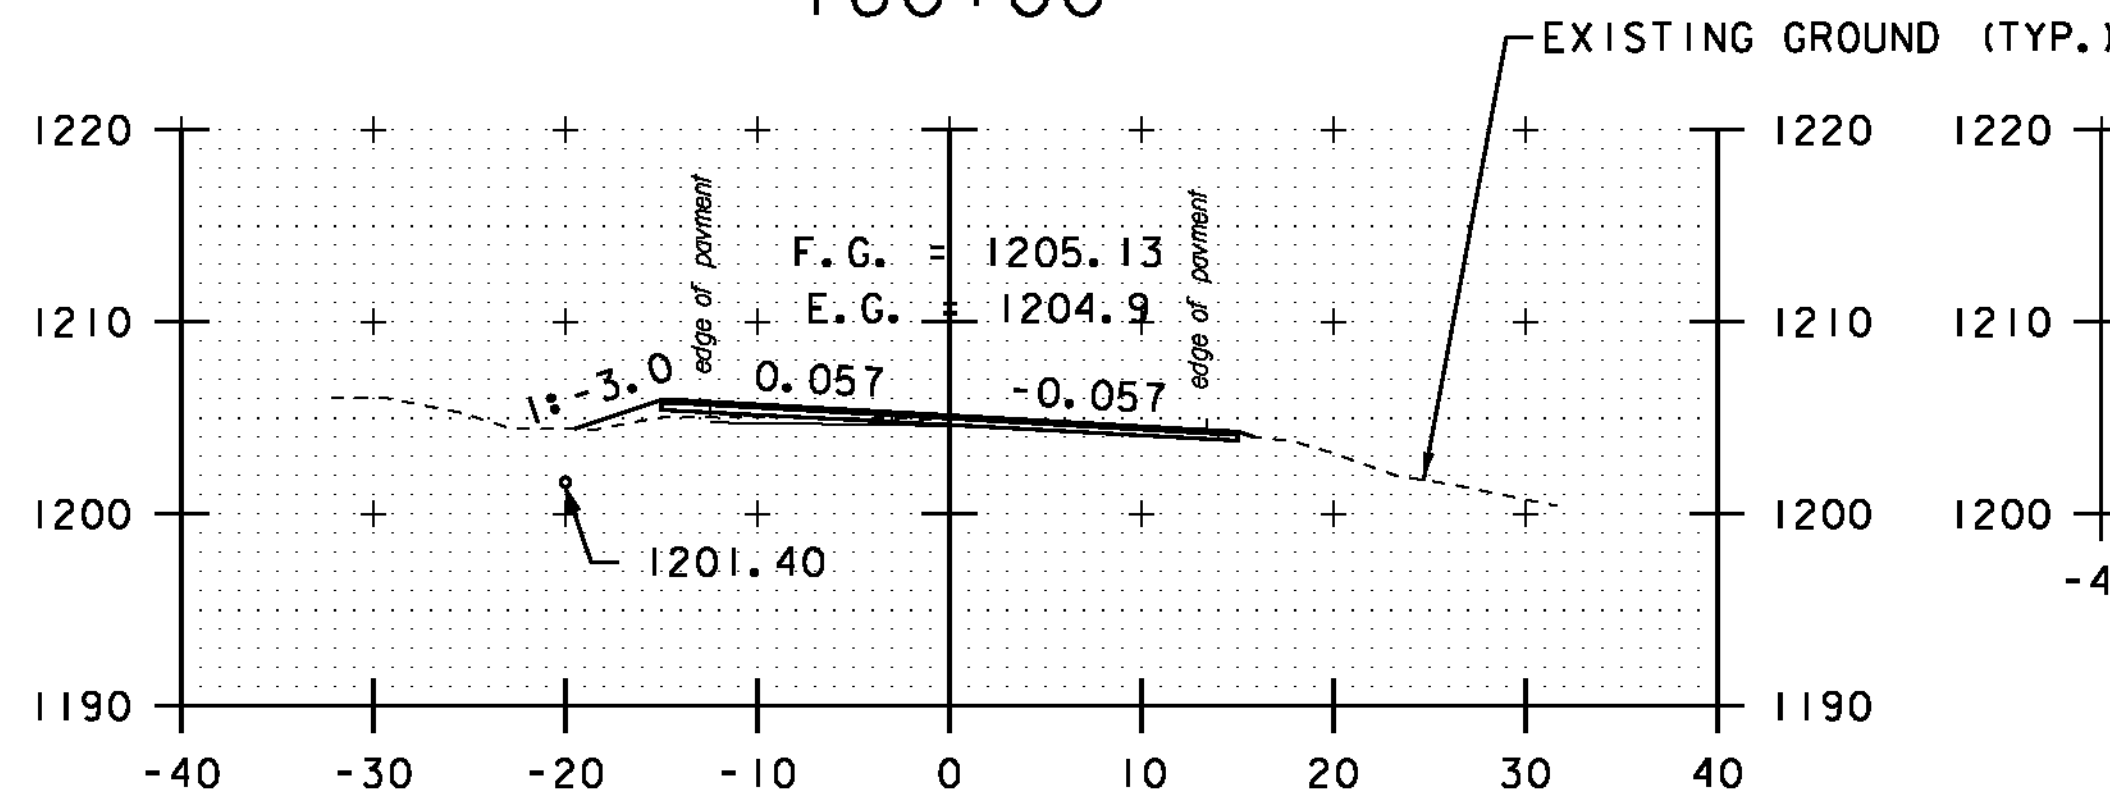


159+50

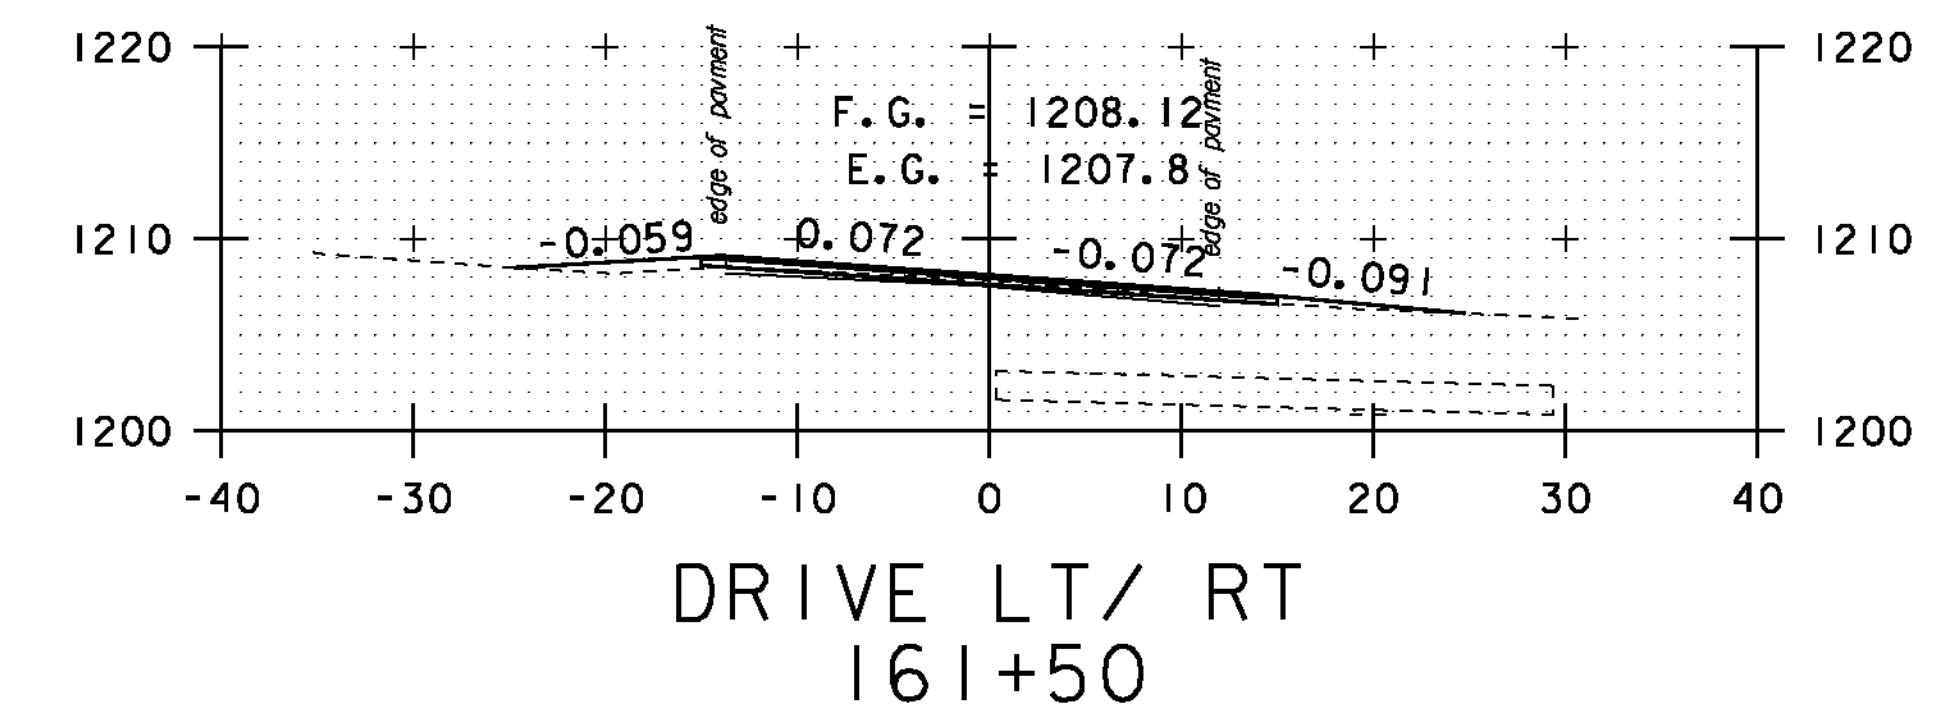


DRIVE LT/ RT
161+50

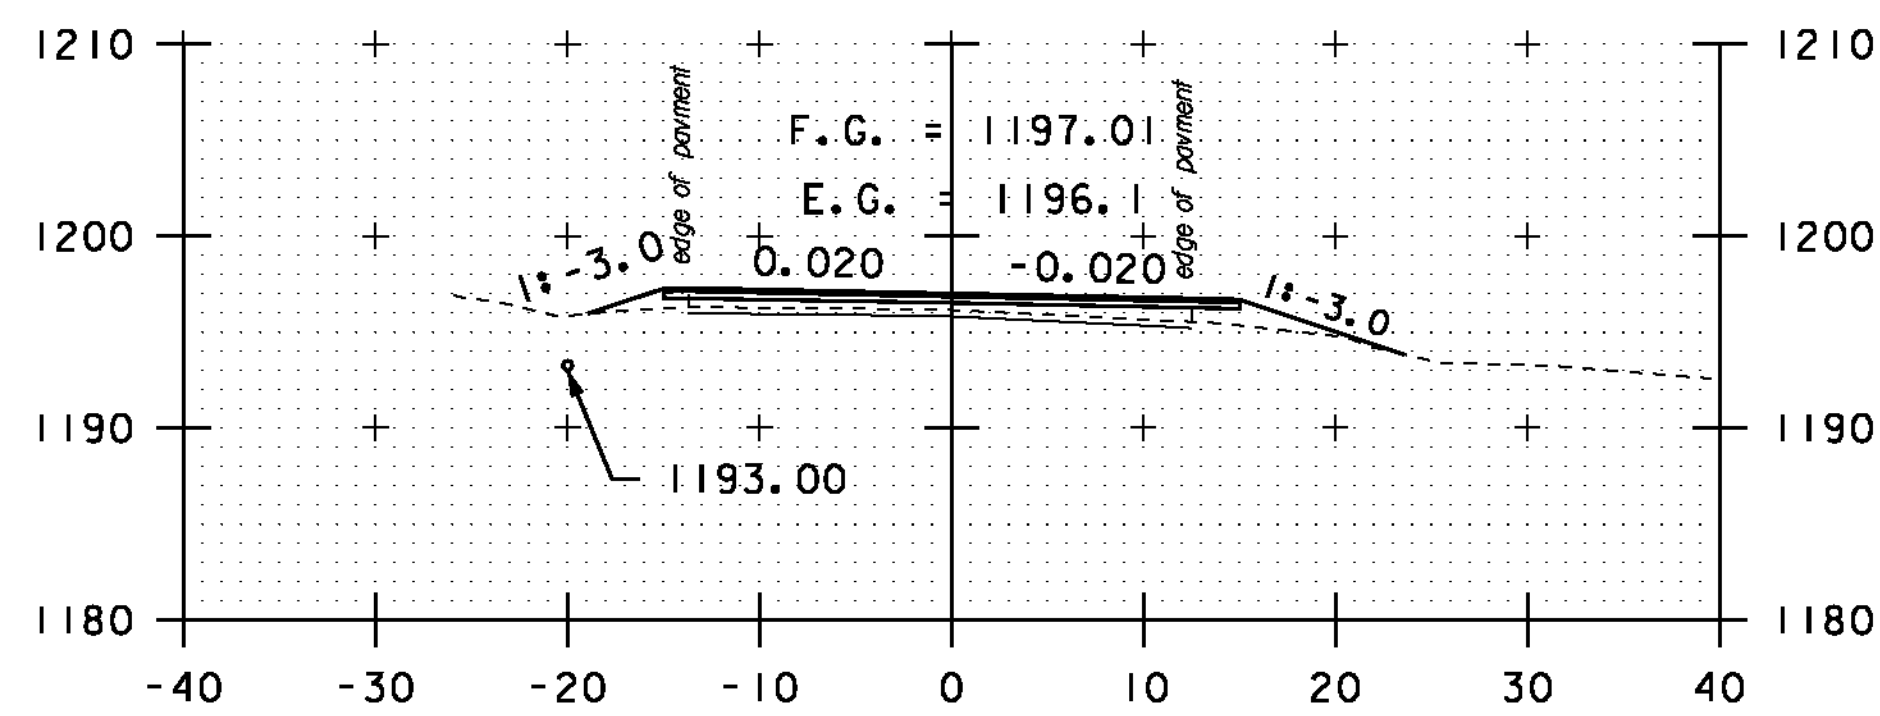


157+00

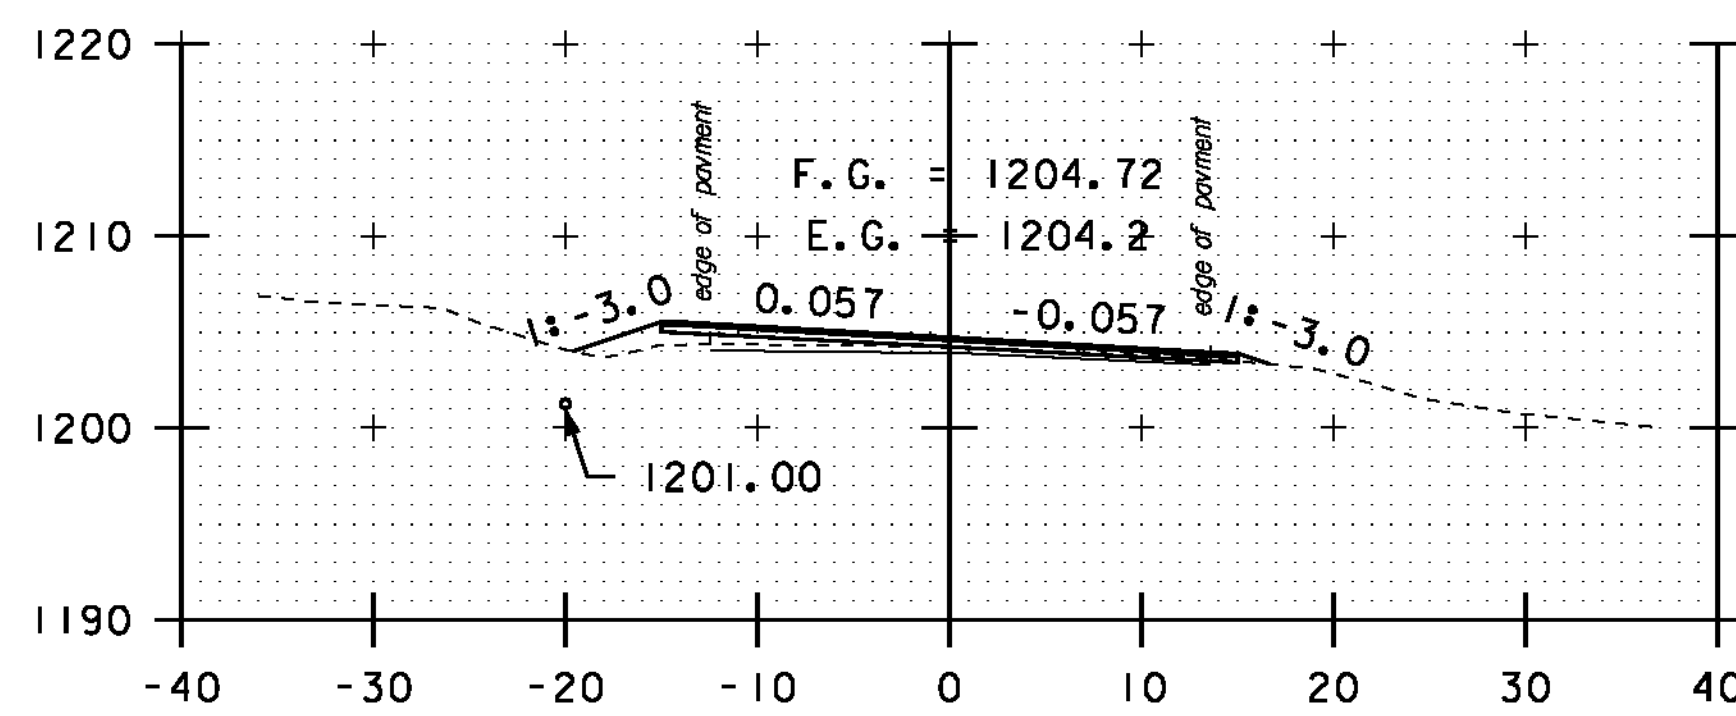


159+00

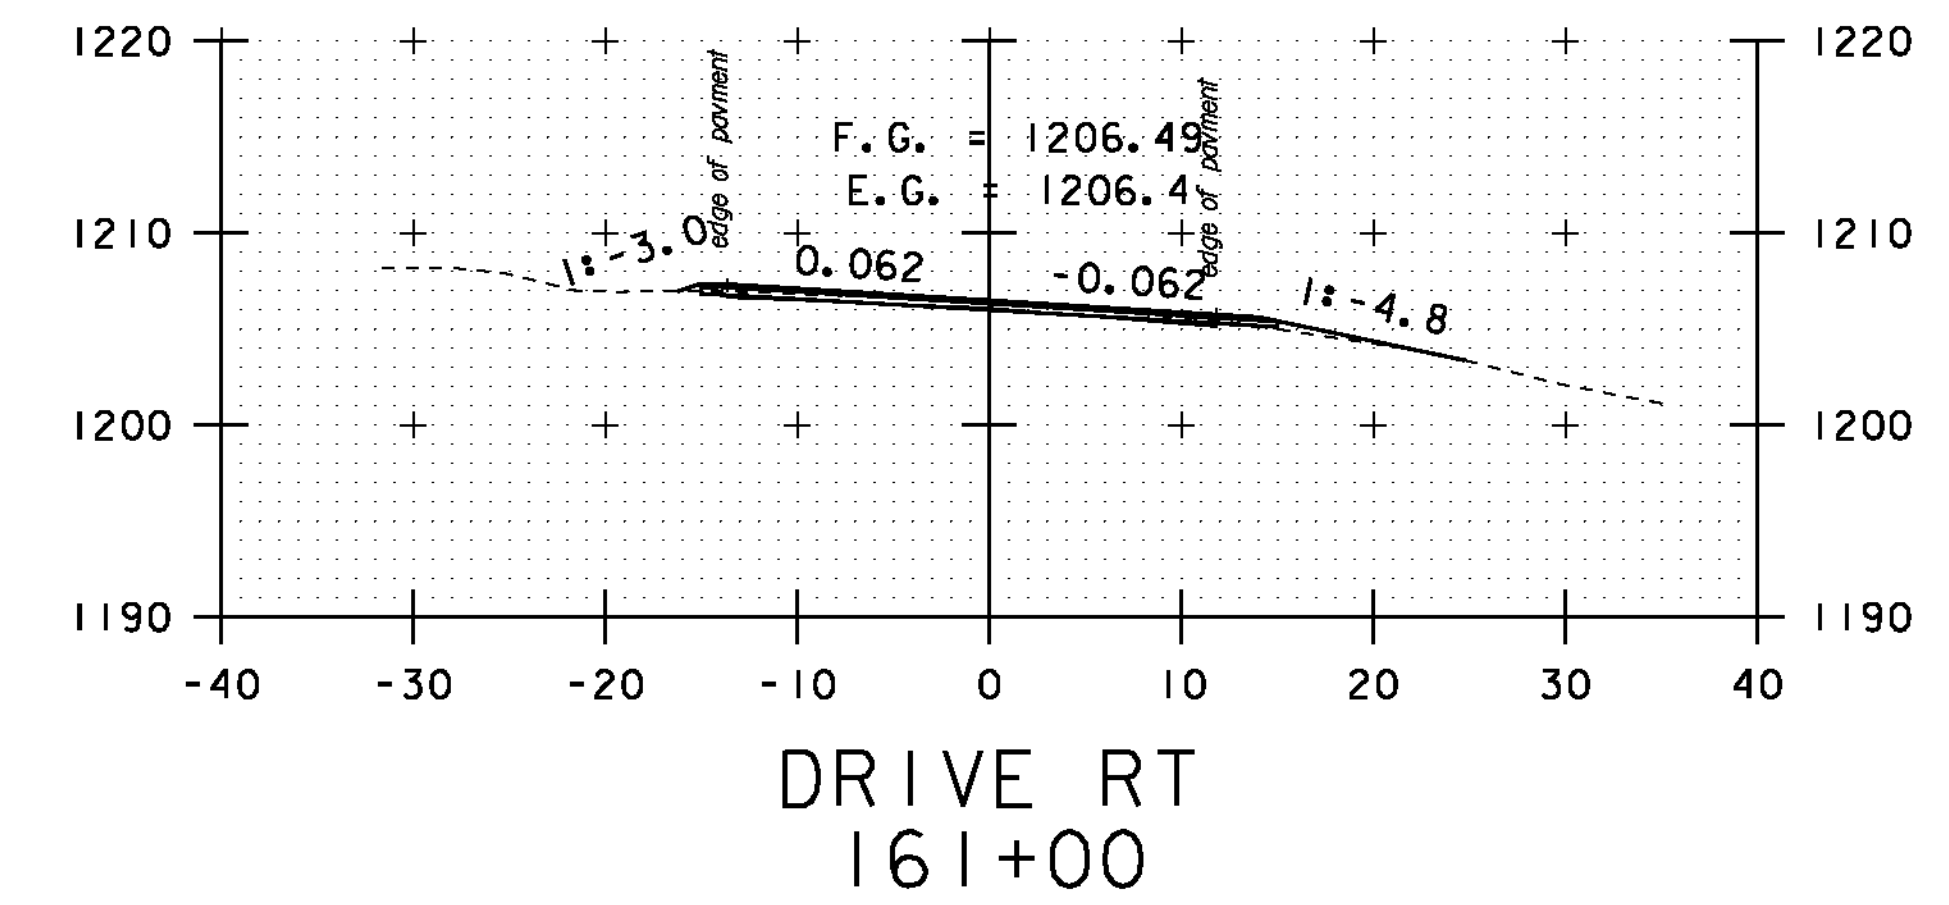


DRIVE RT
161+00

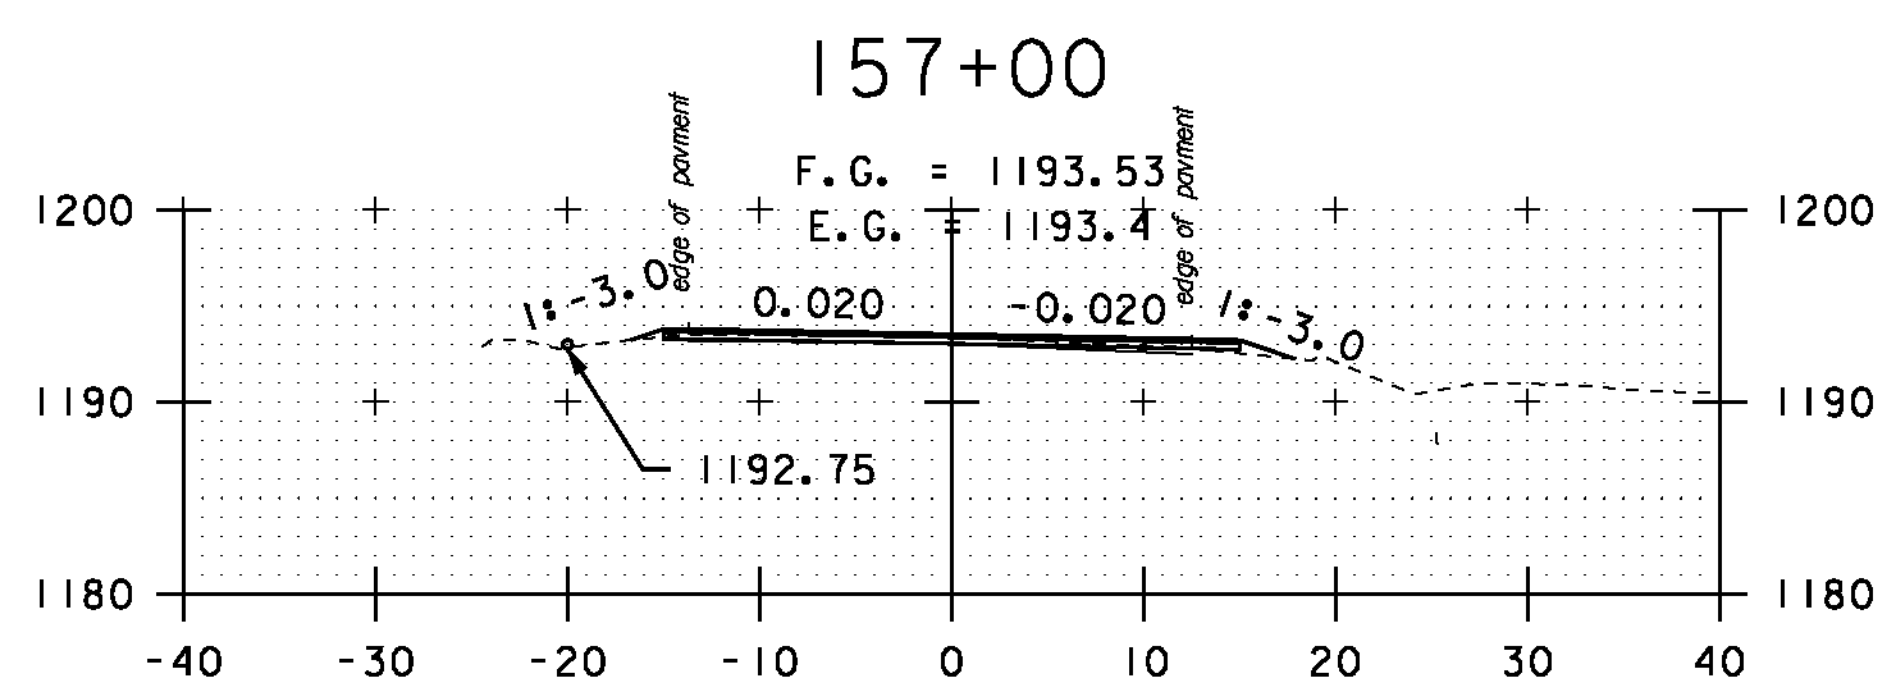

156+50

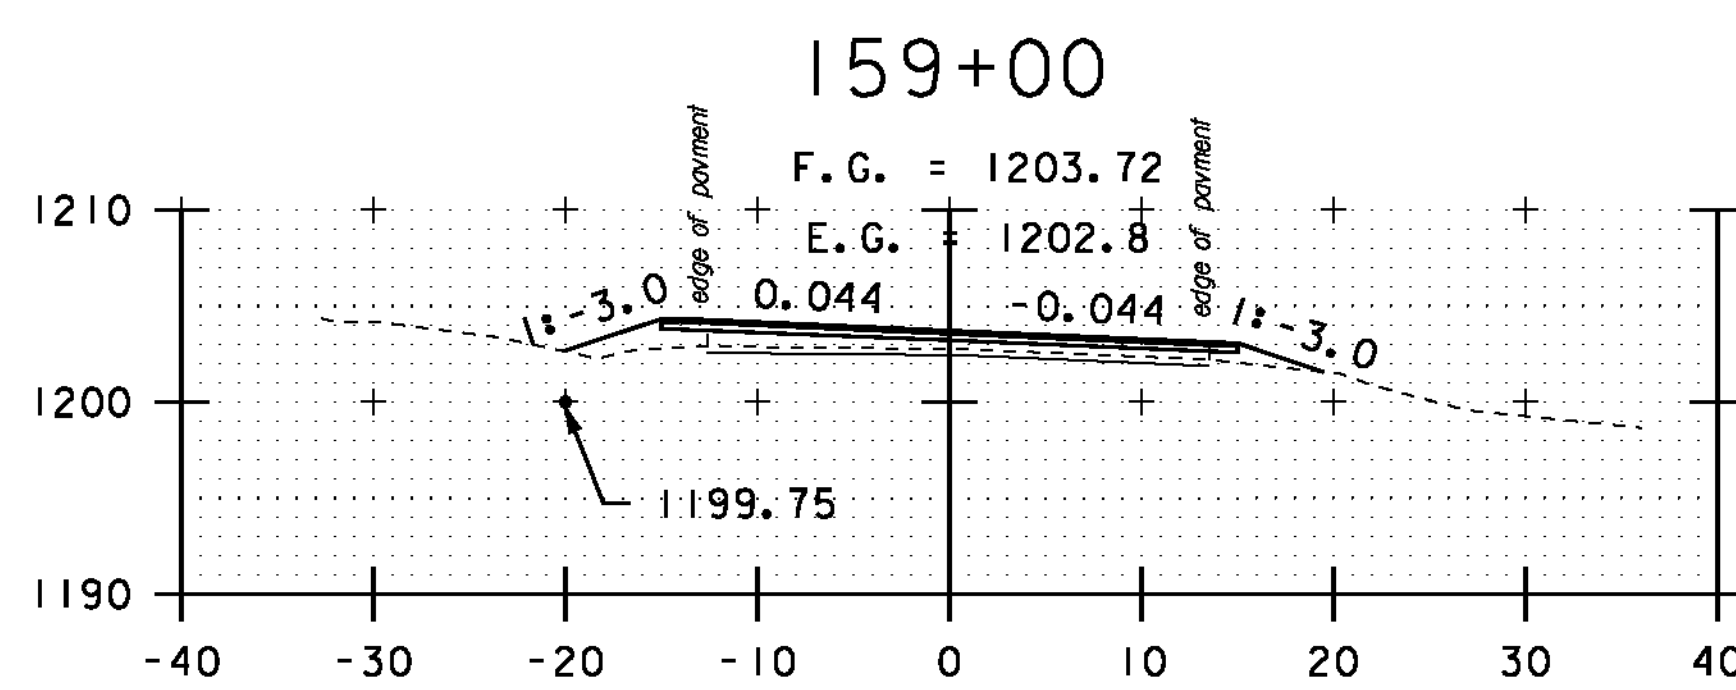


158+50

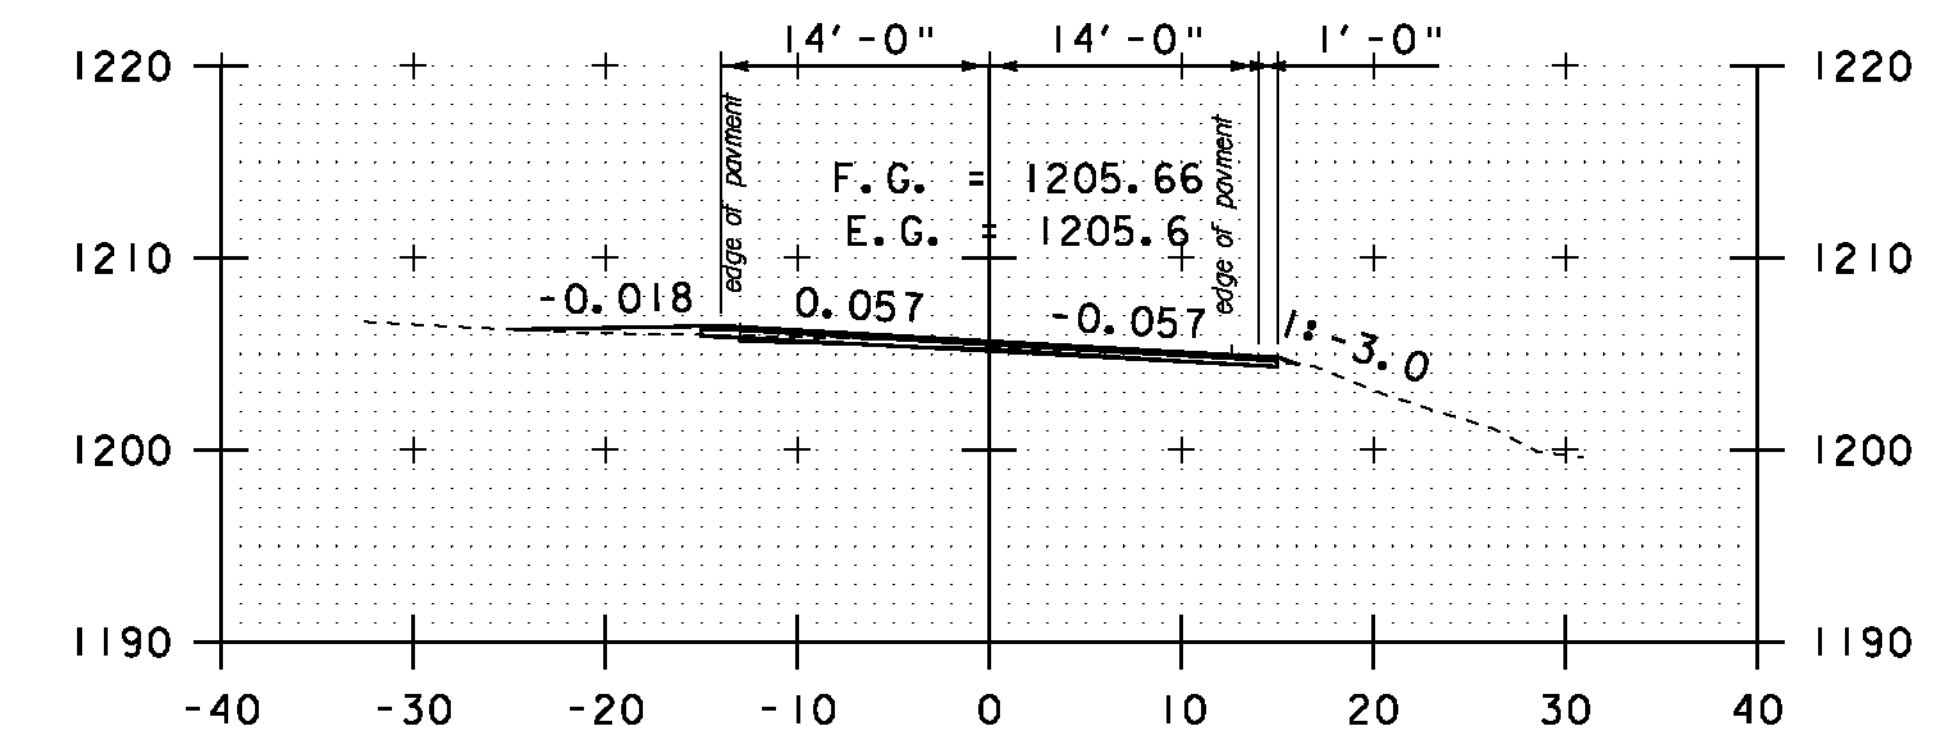

DRIVE LT
160+50

STA. 156+50 TO STA. 162+00

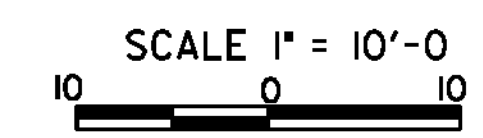

CROSS SECTION SHEET 30

PROJECT NAME: MONTGOMERY-WESTFIELD
 PROJECT NUMBER: STP 2906(I)
 FILE NAME: p10ci90.dgn
 PROJECT LEADER: CDL
 DESIGNED BY: SJL
 PLOT FILE: p10ci90_144.j

PLOT DATE: 9/5/12
 DRAWN BY: SJL
 CHECKED BY: CDL
 SHEET 144 OF 178