




168+00

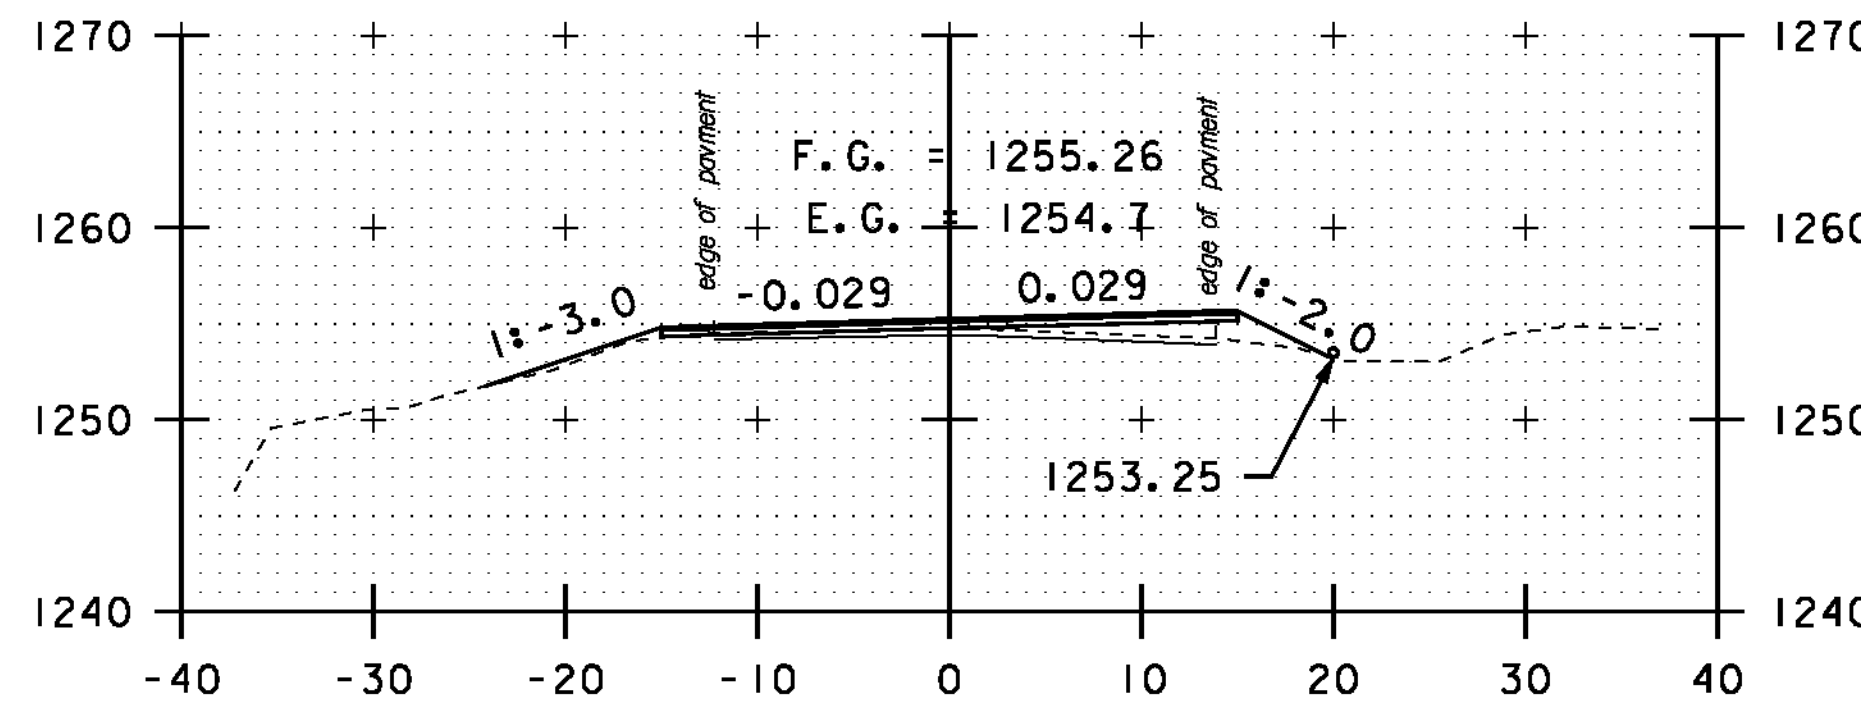



170+00

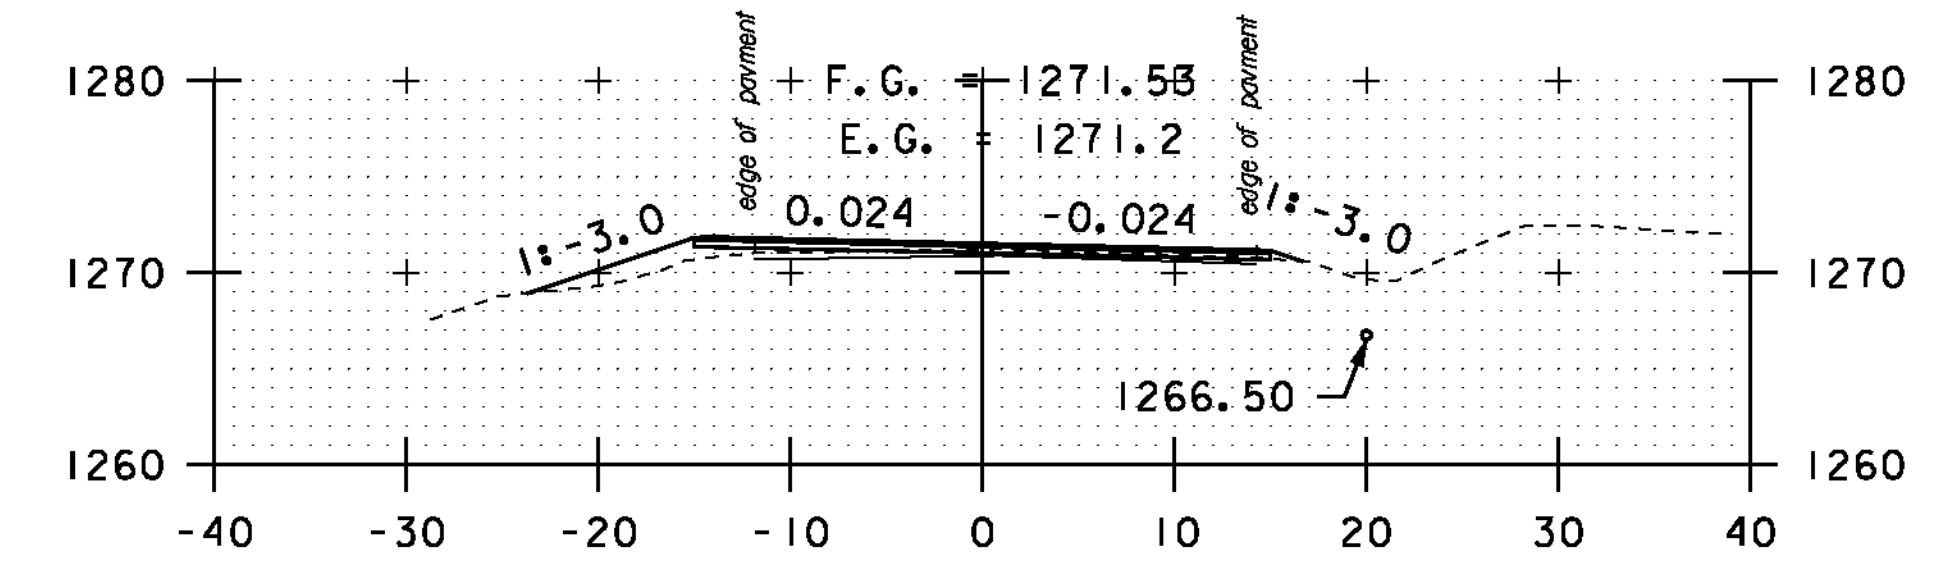


172+00

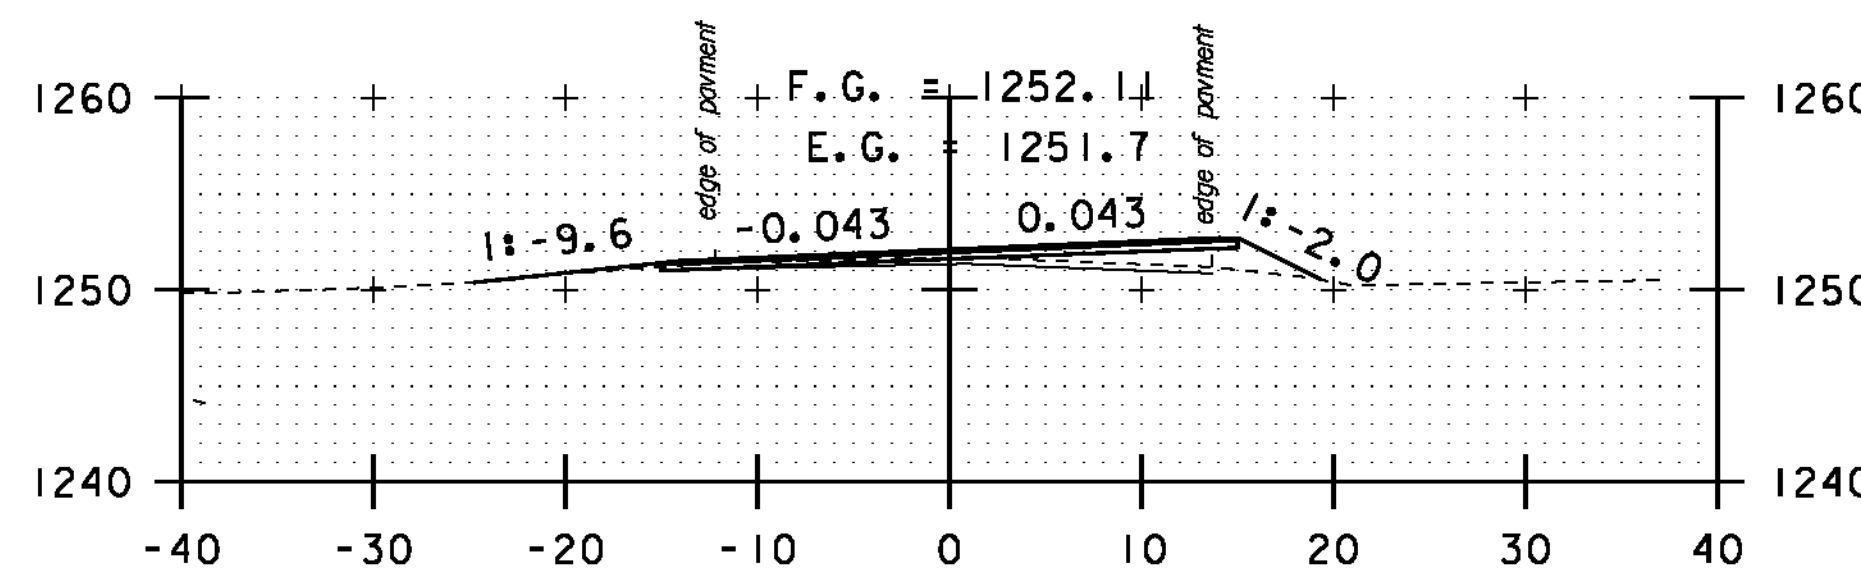


DRIVE LT
169+50

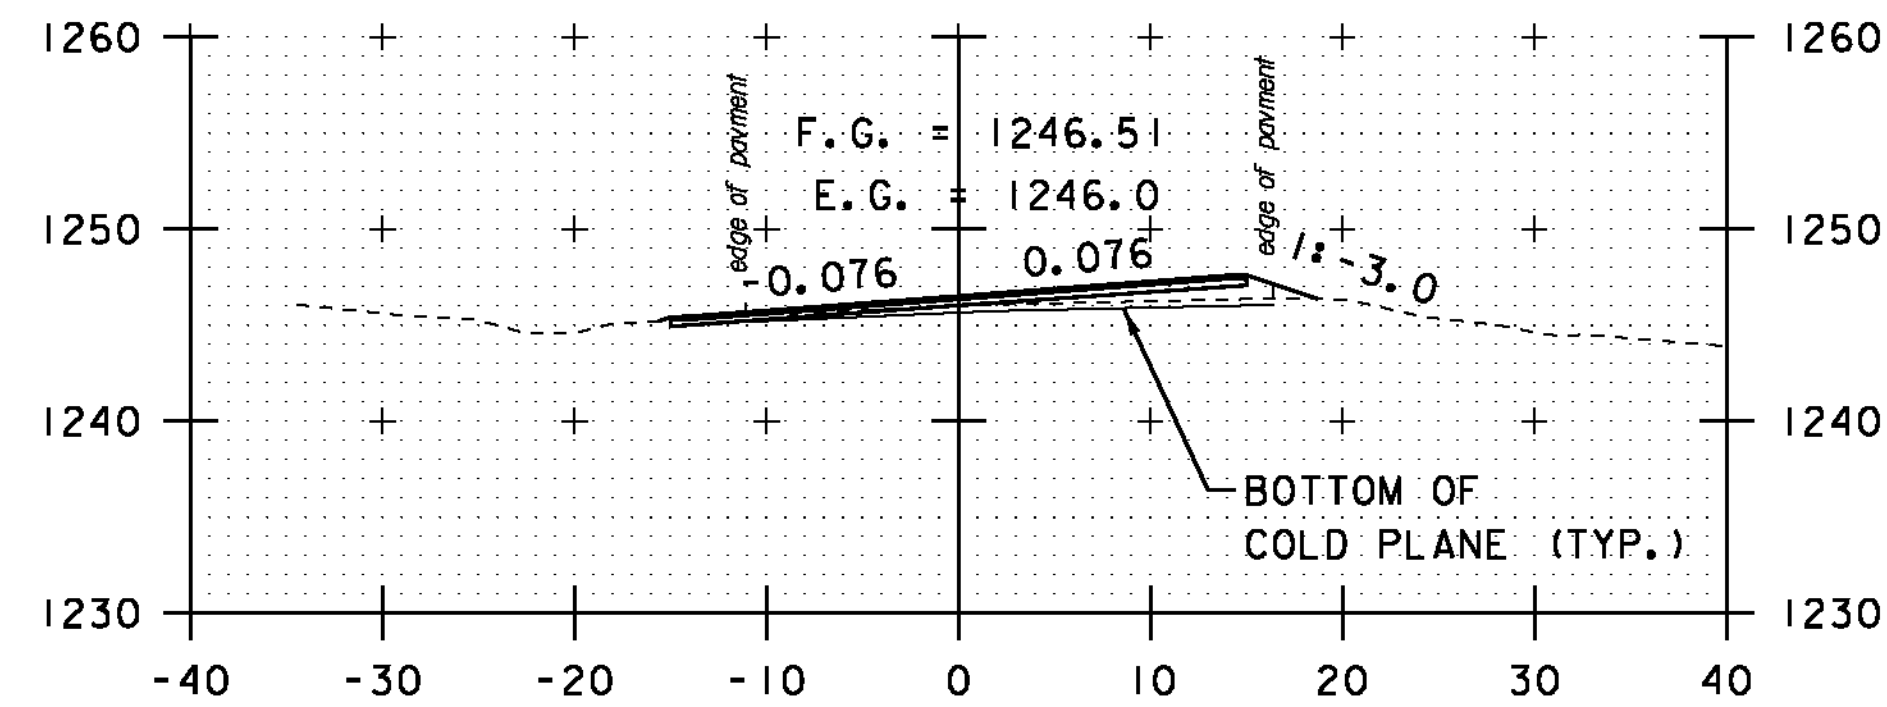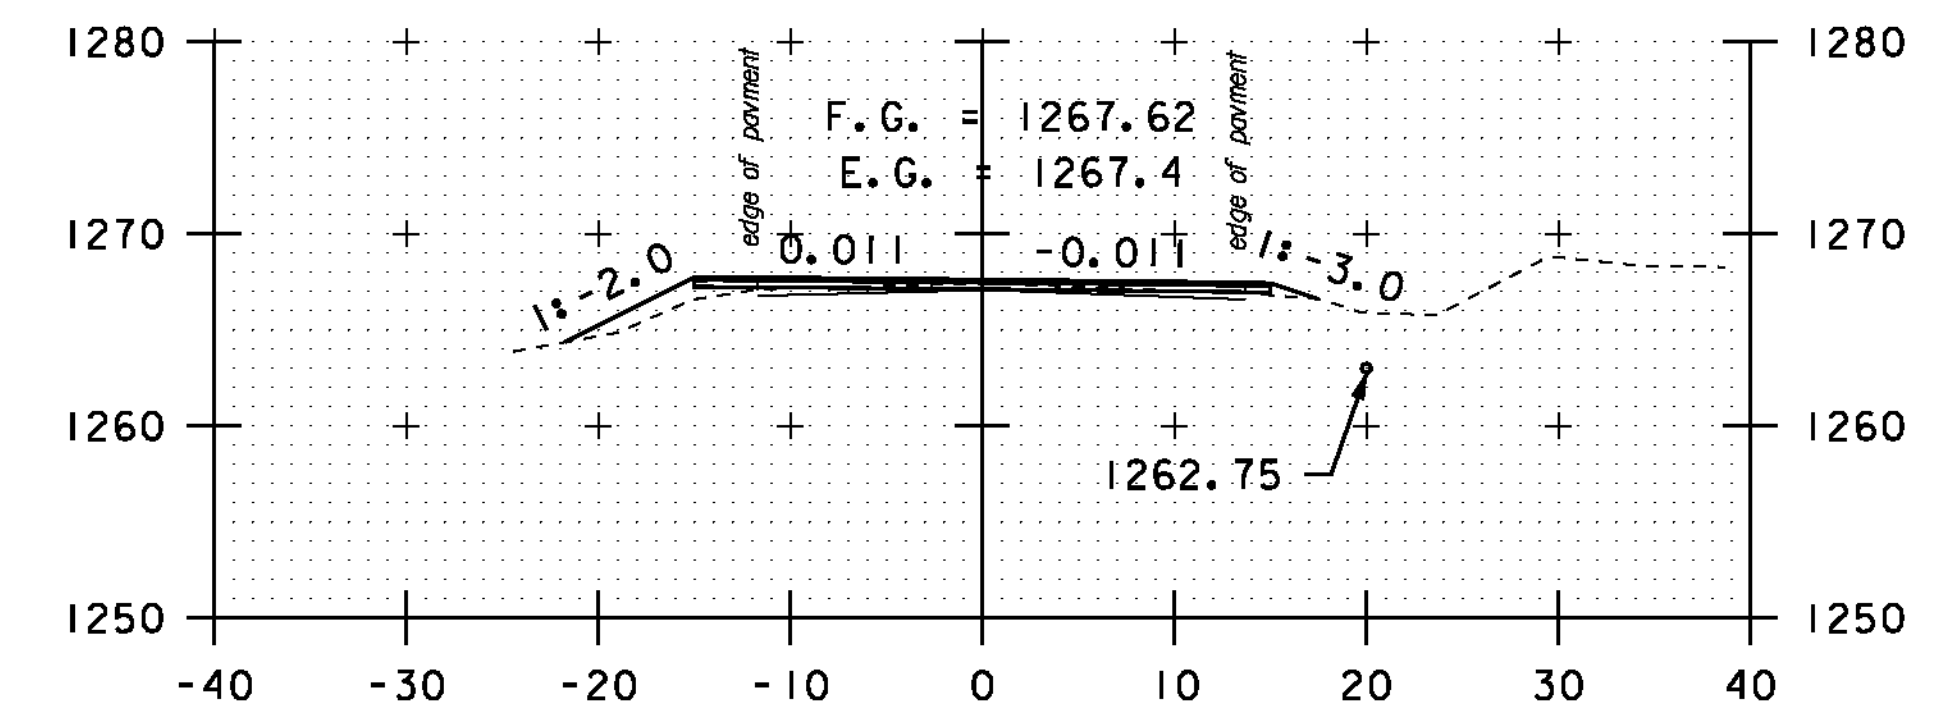


167+50

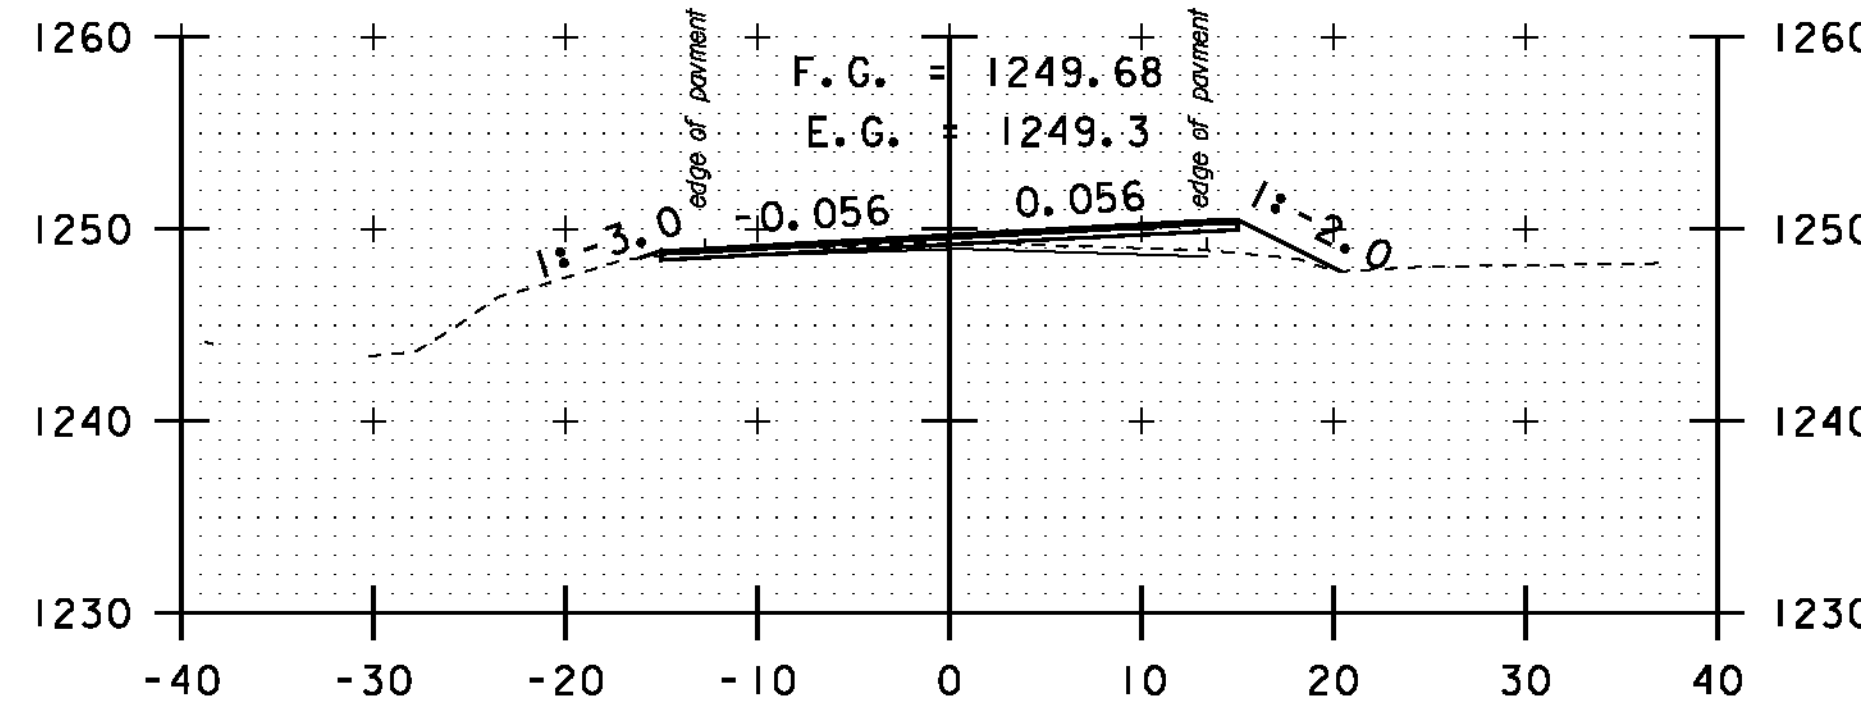


169+00

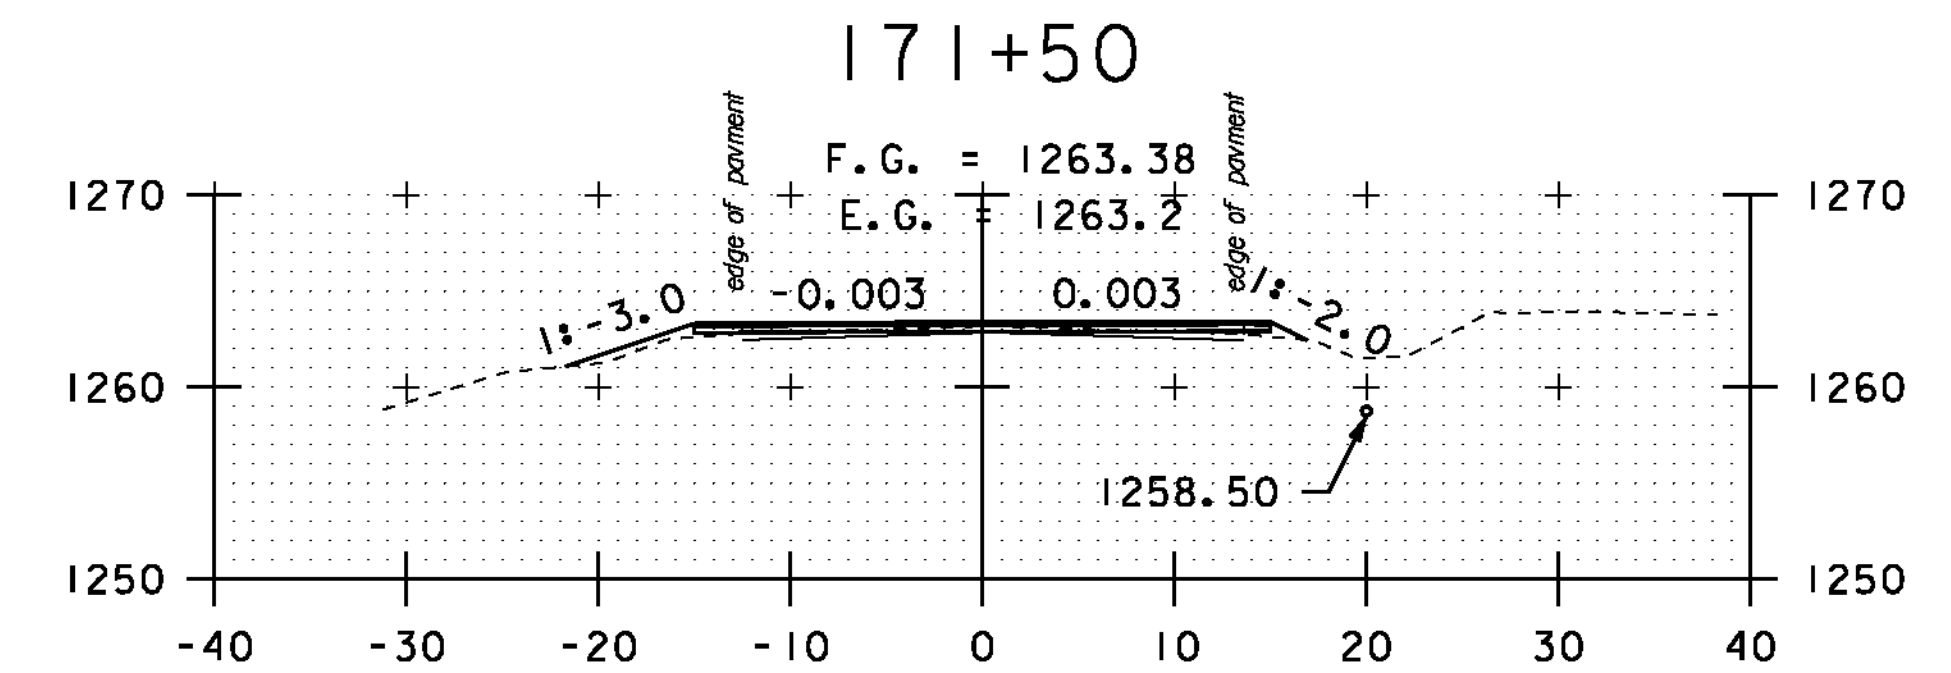


171+00

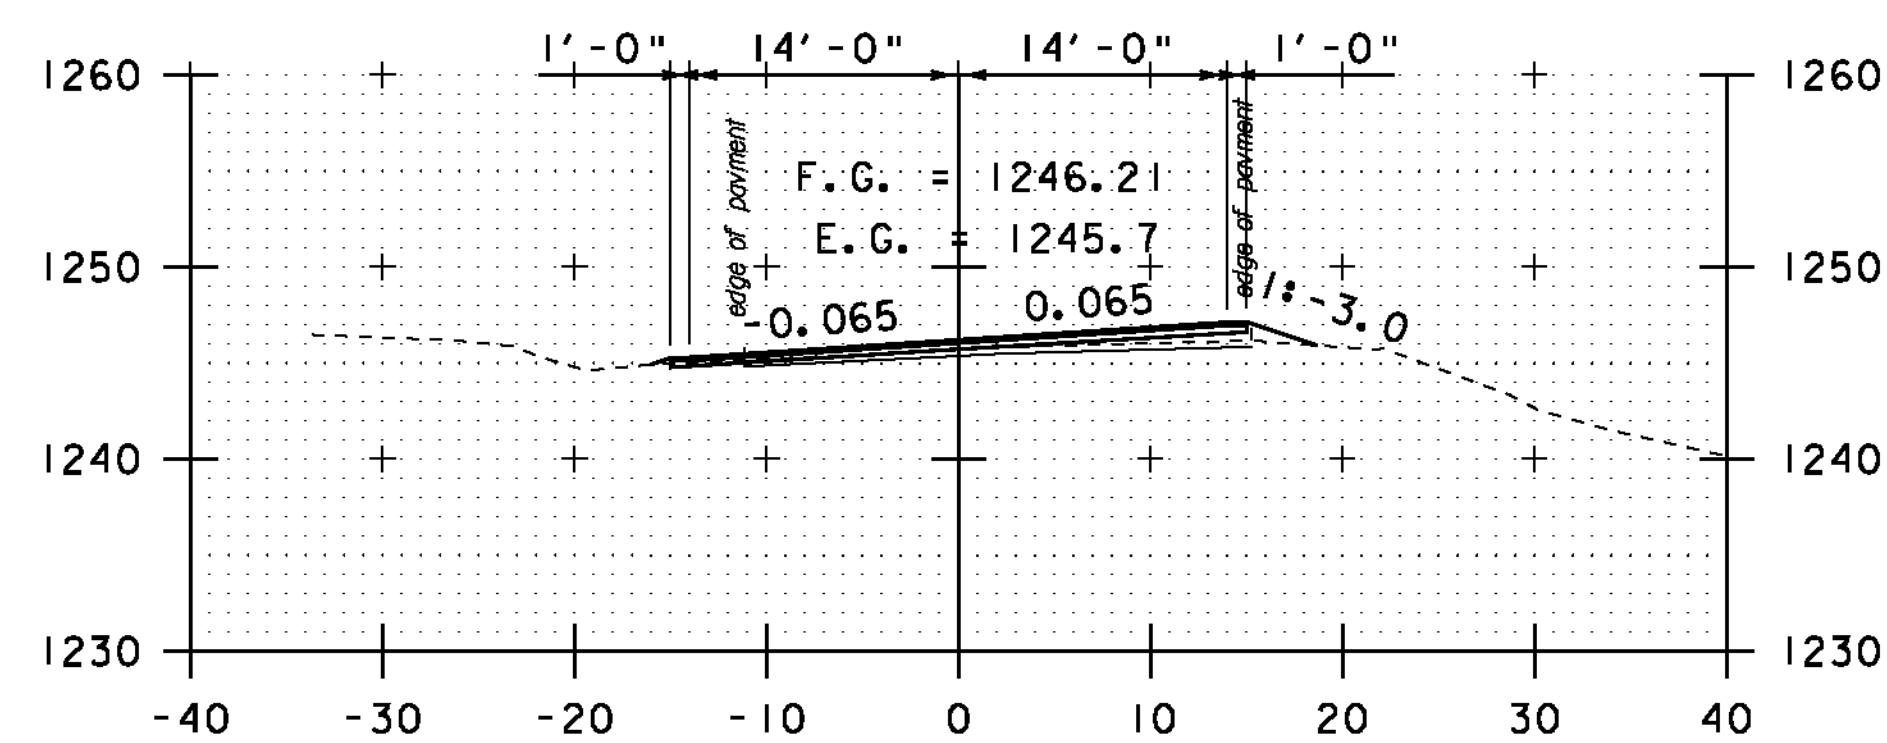

167+00

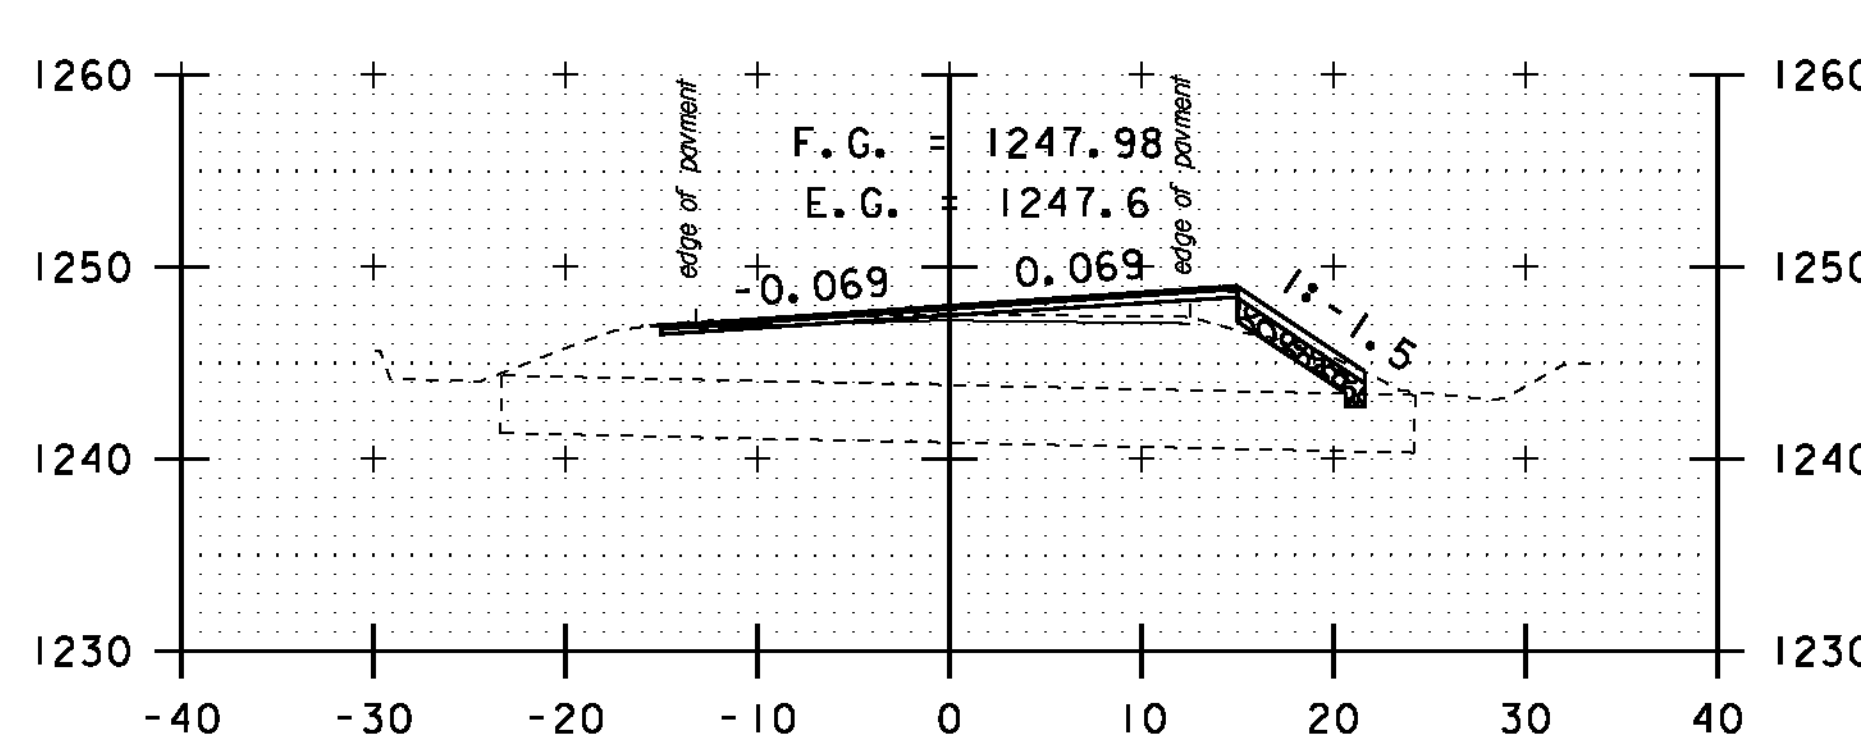


168+50

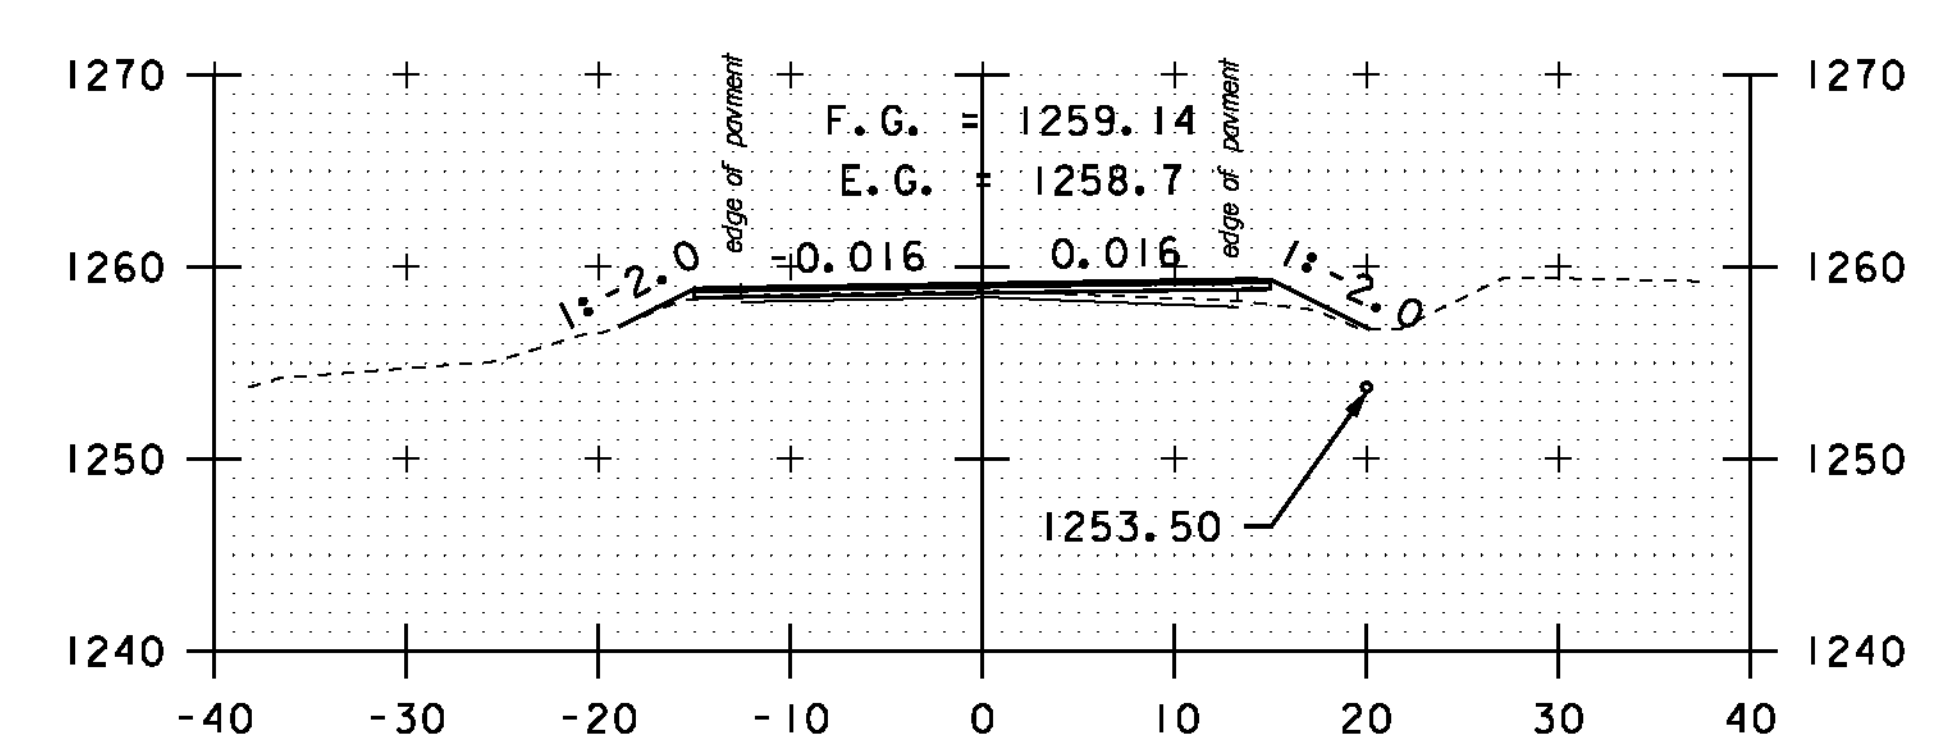

170+50

STA. 167+00 TO STA. 172+00

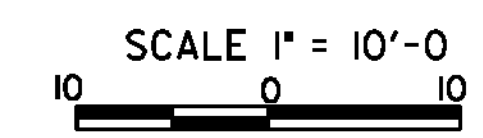

CROSS SECTION SHEET 32

PROJECT NAME: MONTGOMERY-WESTFIELD

PROJECT NUMBER: STP 2906(I)

FILE NAME: p10ci90.dgn

PROJECT LEADER: CDL

DESIGNED BY: SJL

PLOT FILE: p10ci90_146.1

PLOT DATE: 9/5/12

DRAWN BY: SJL

CHECKED BY: CDL

SHEET 146 OF 178