




180+00

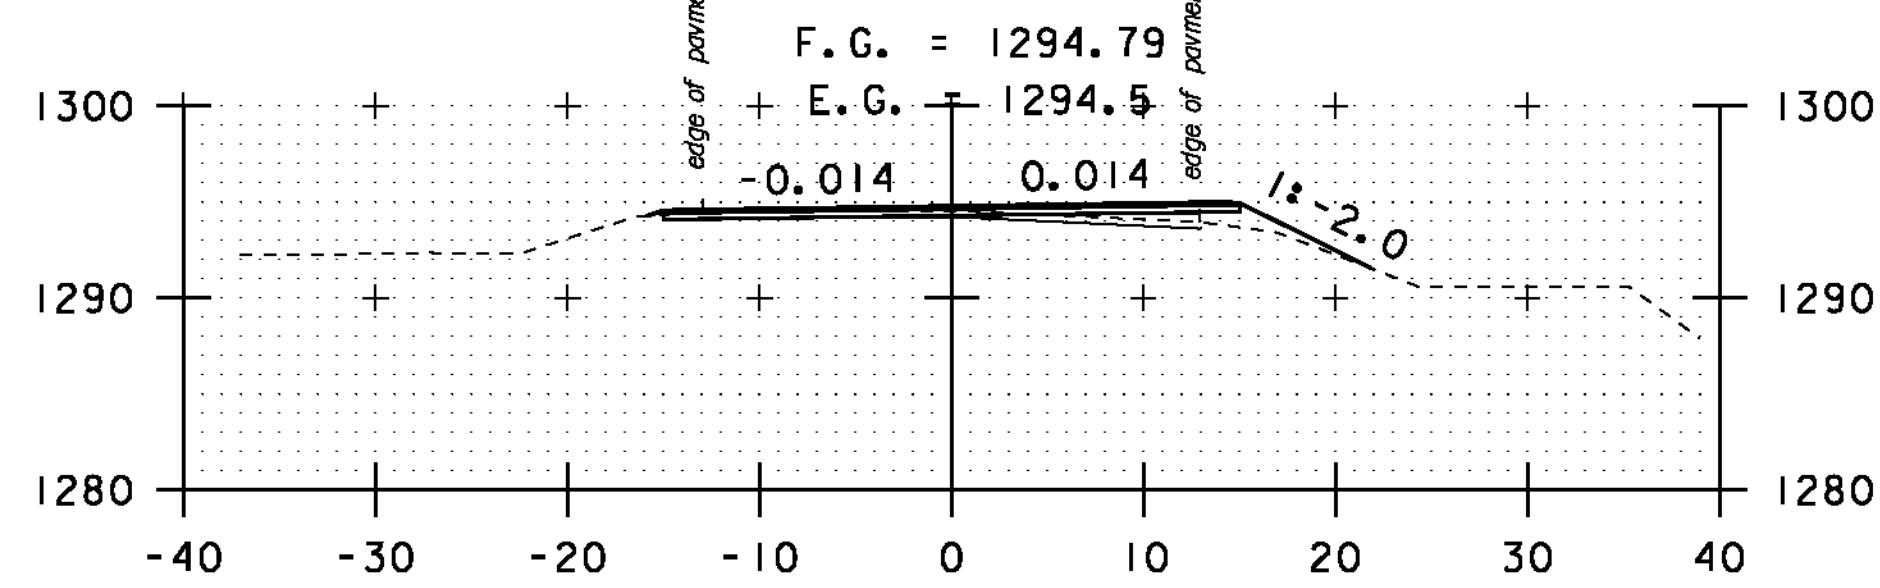


179+50

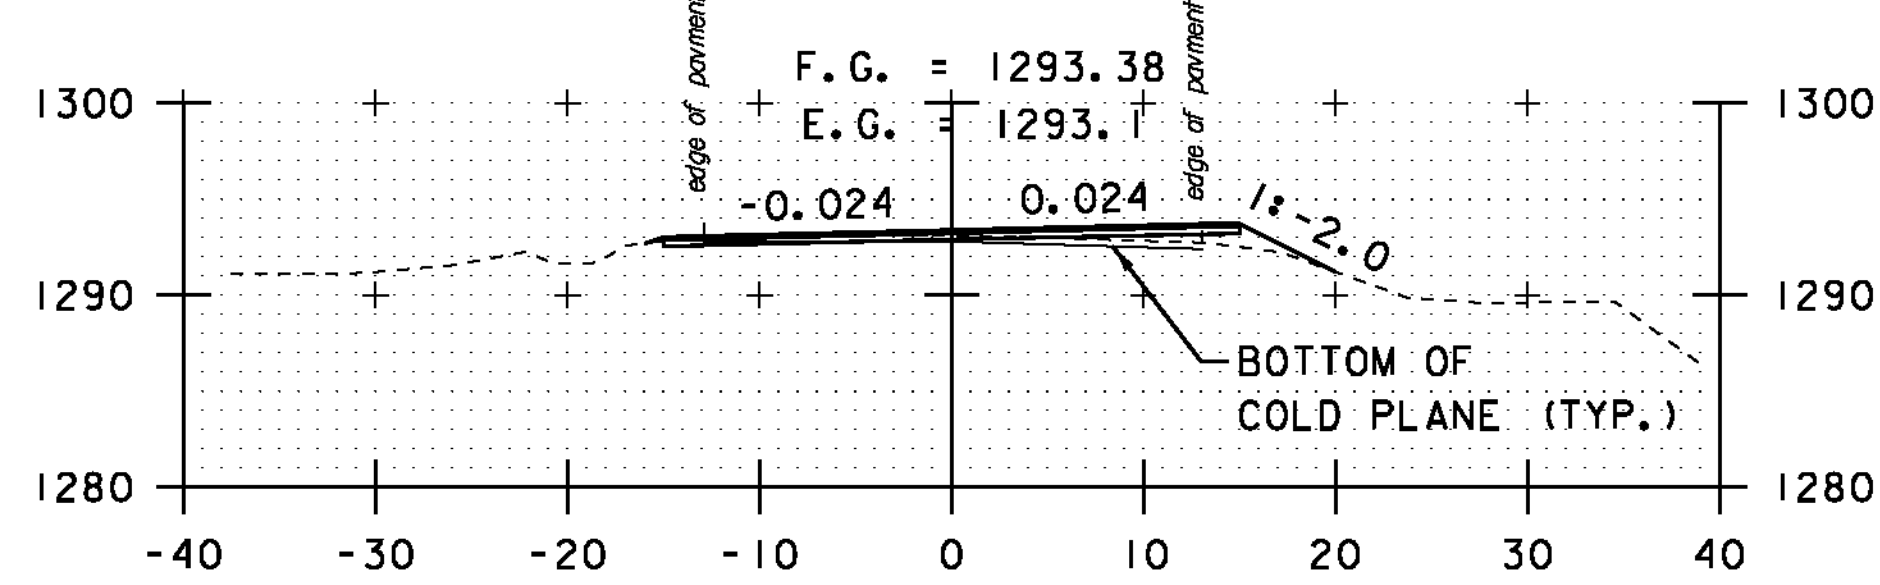


179+00

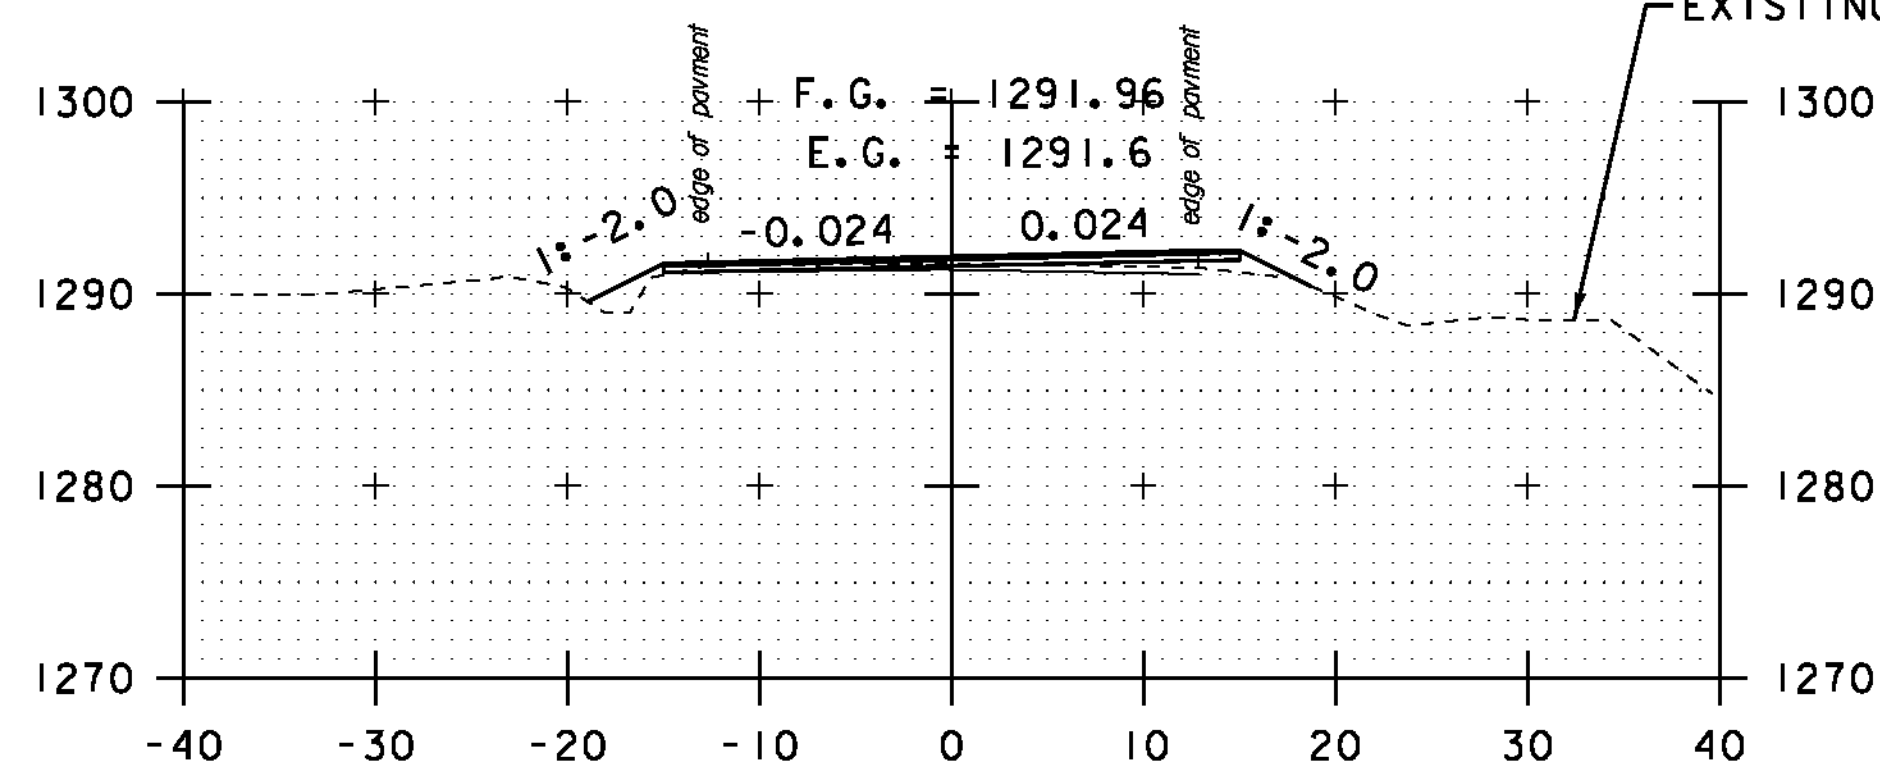


178+50

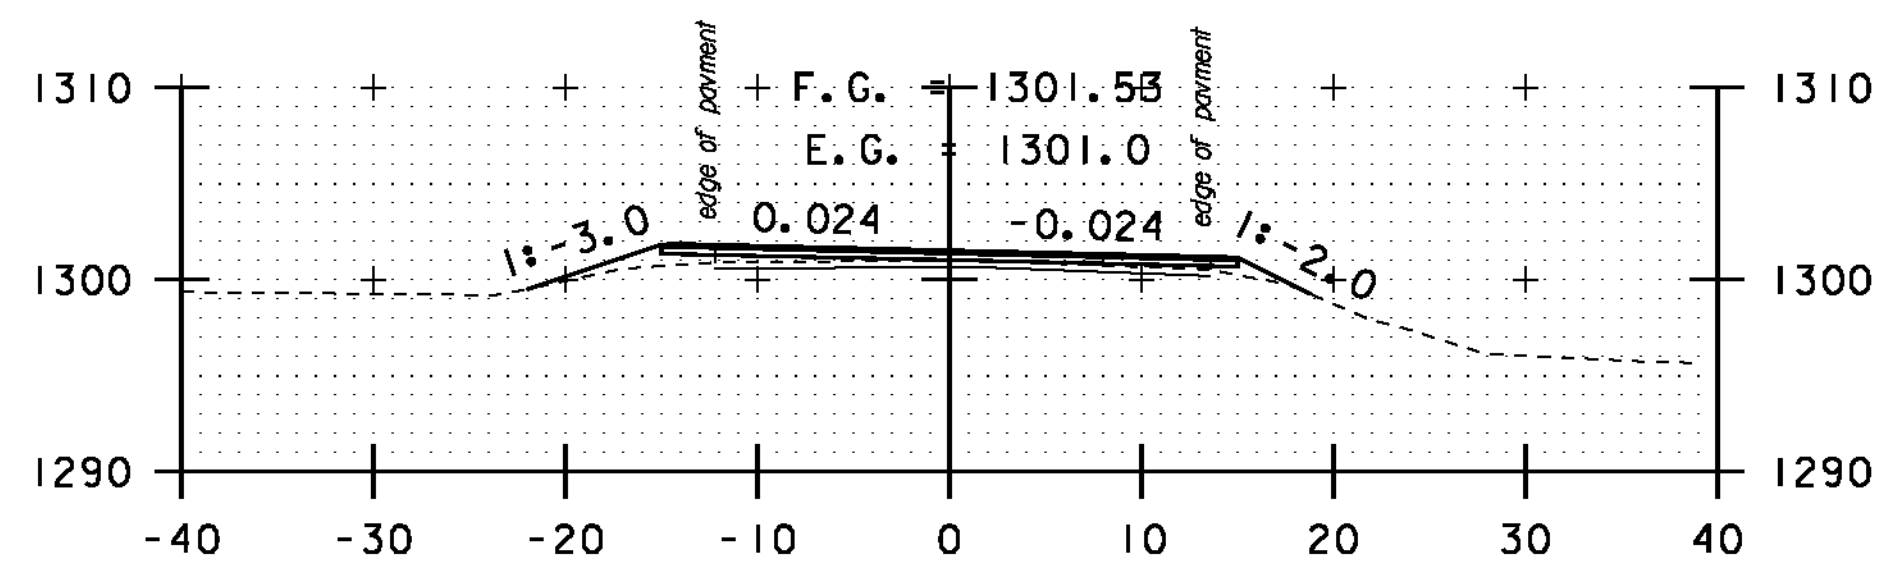


182+00

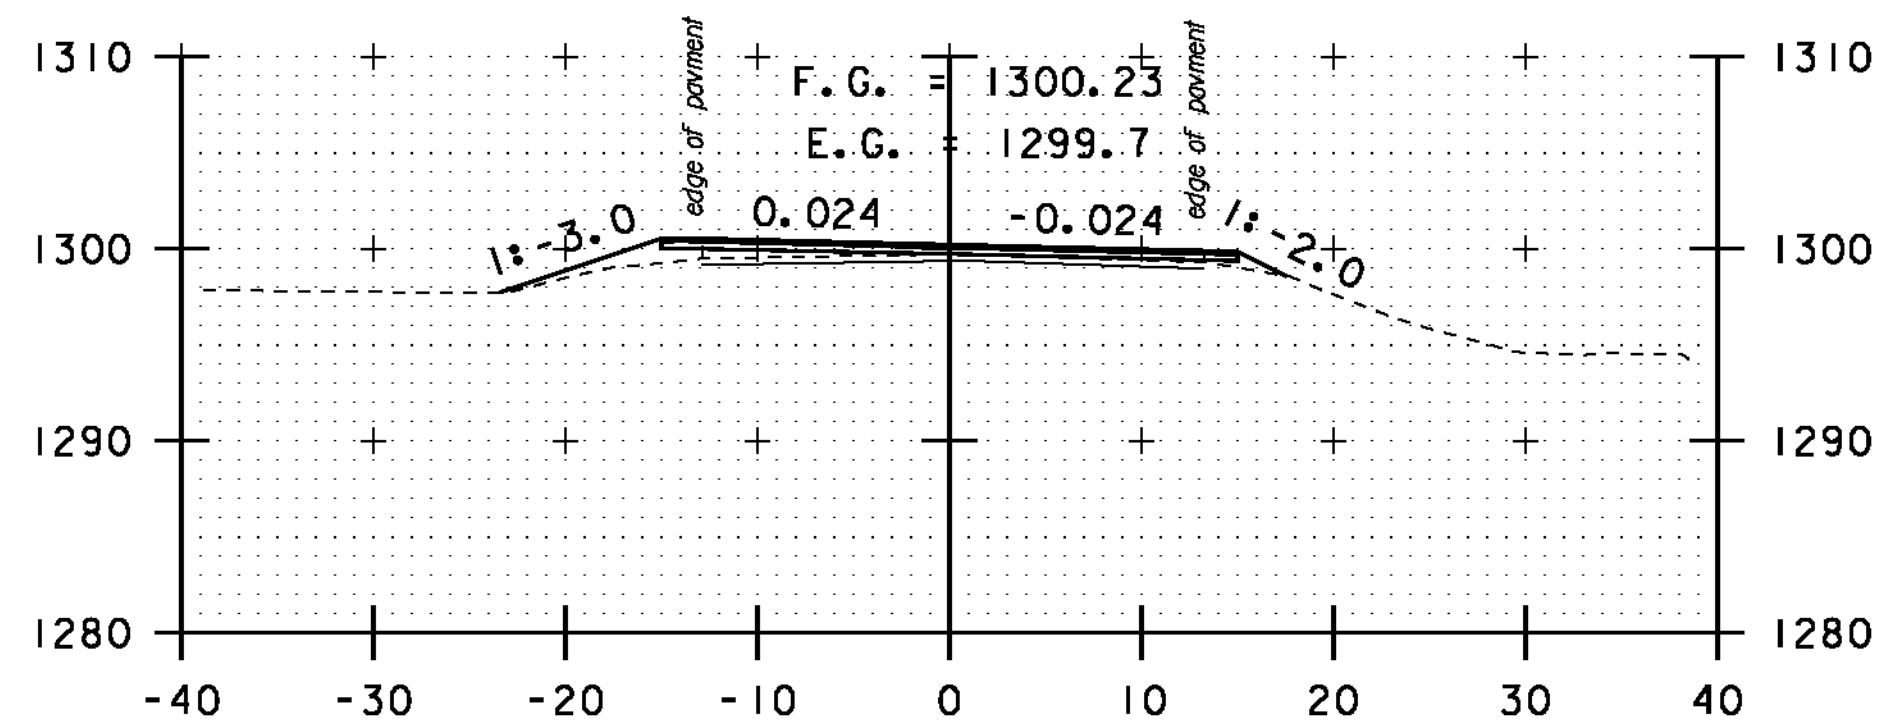


181+50

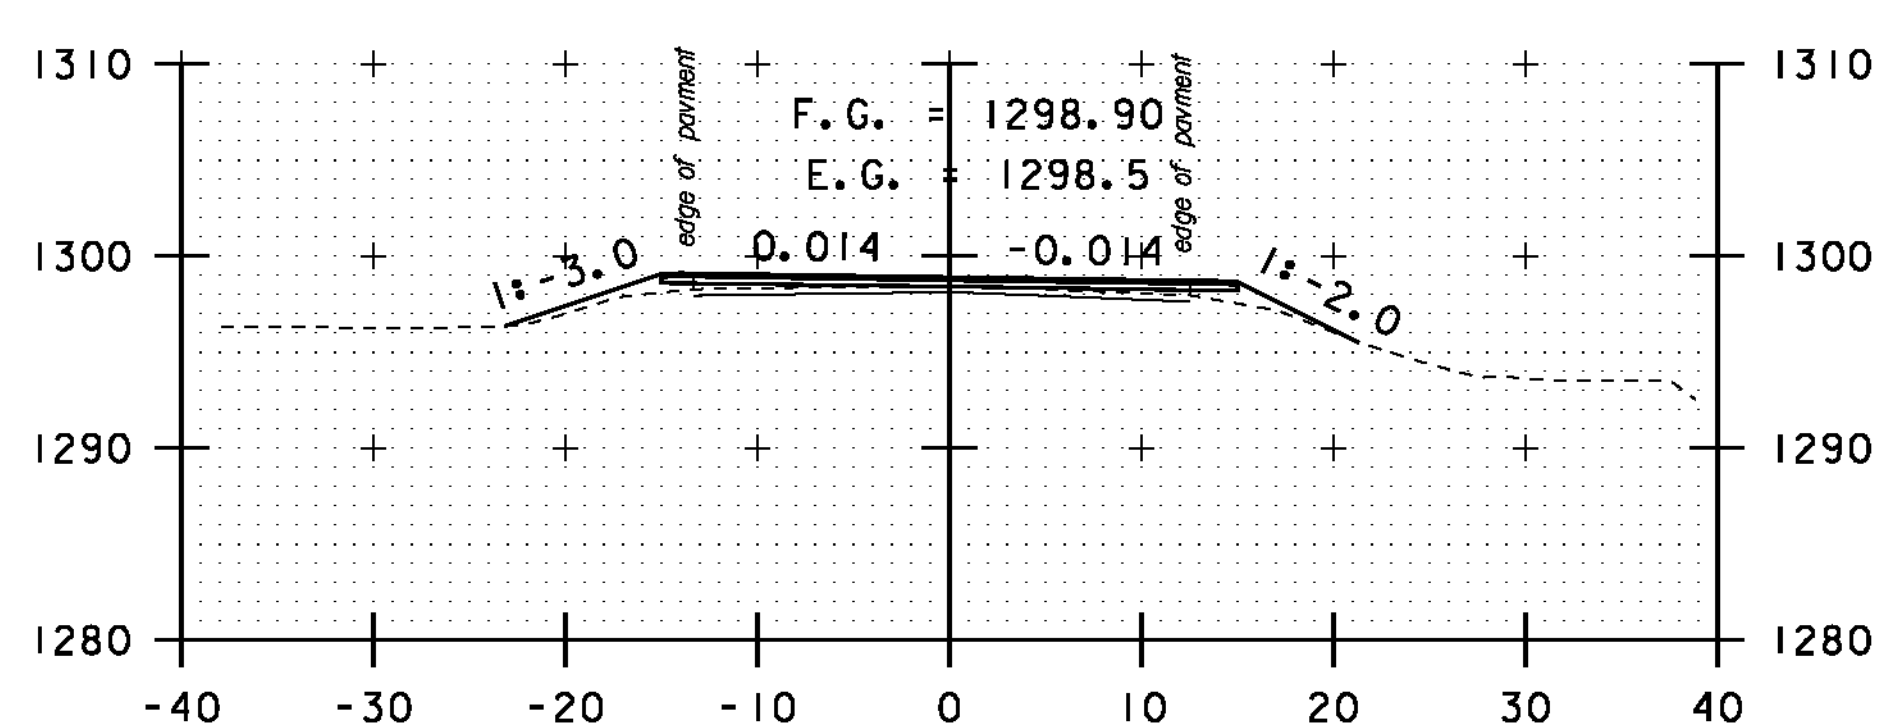


181+00

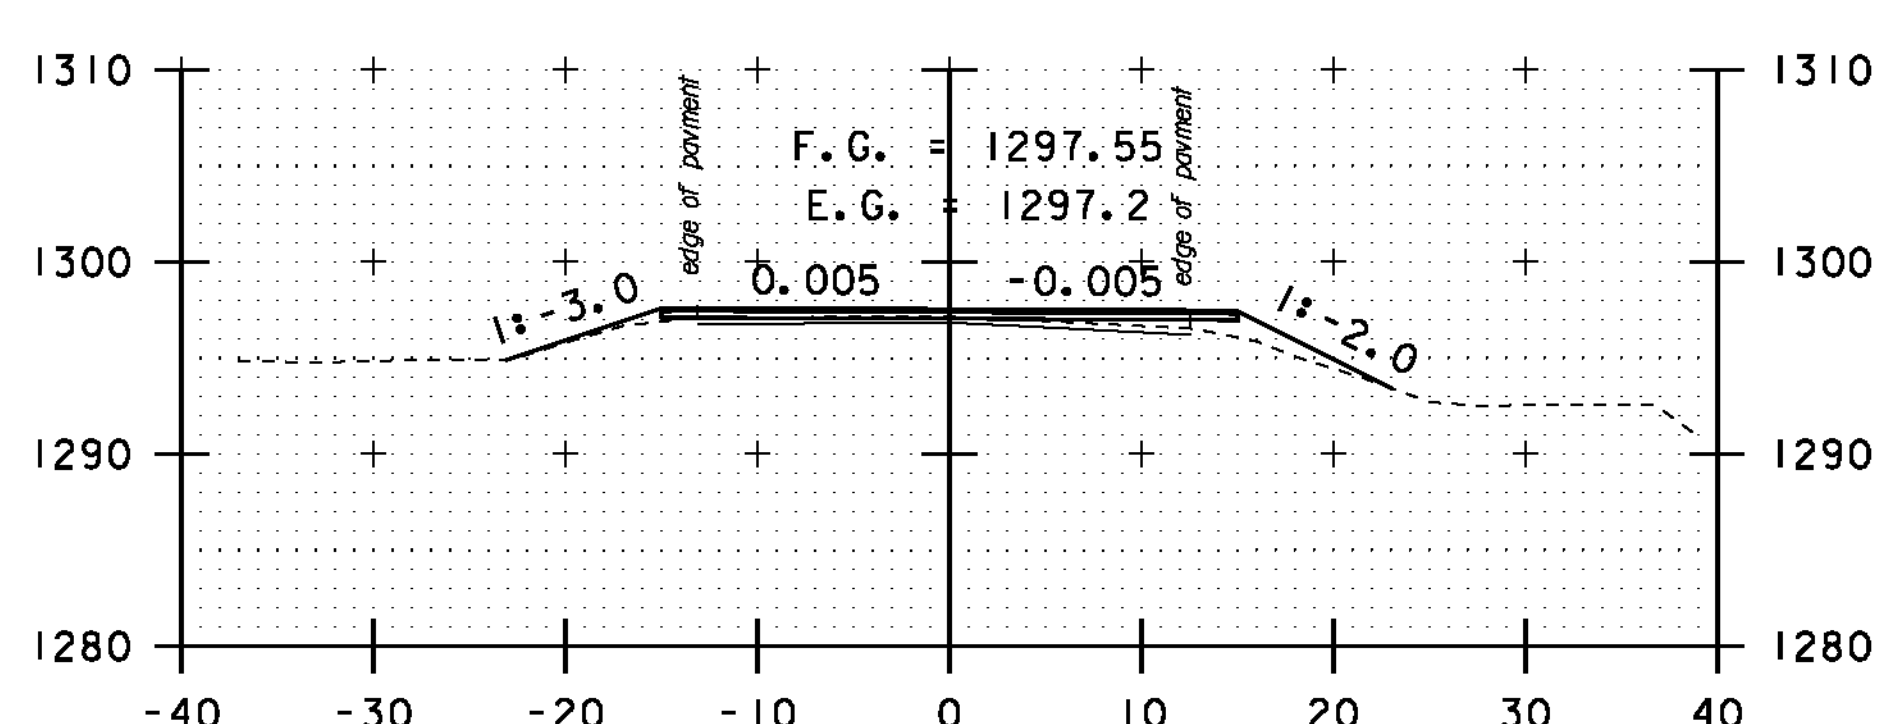


180+50

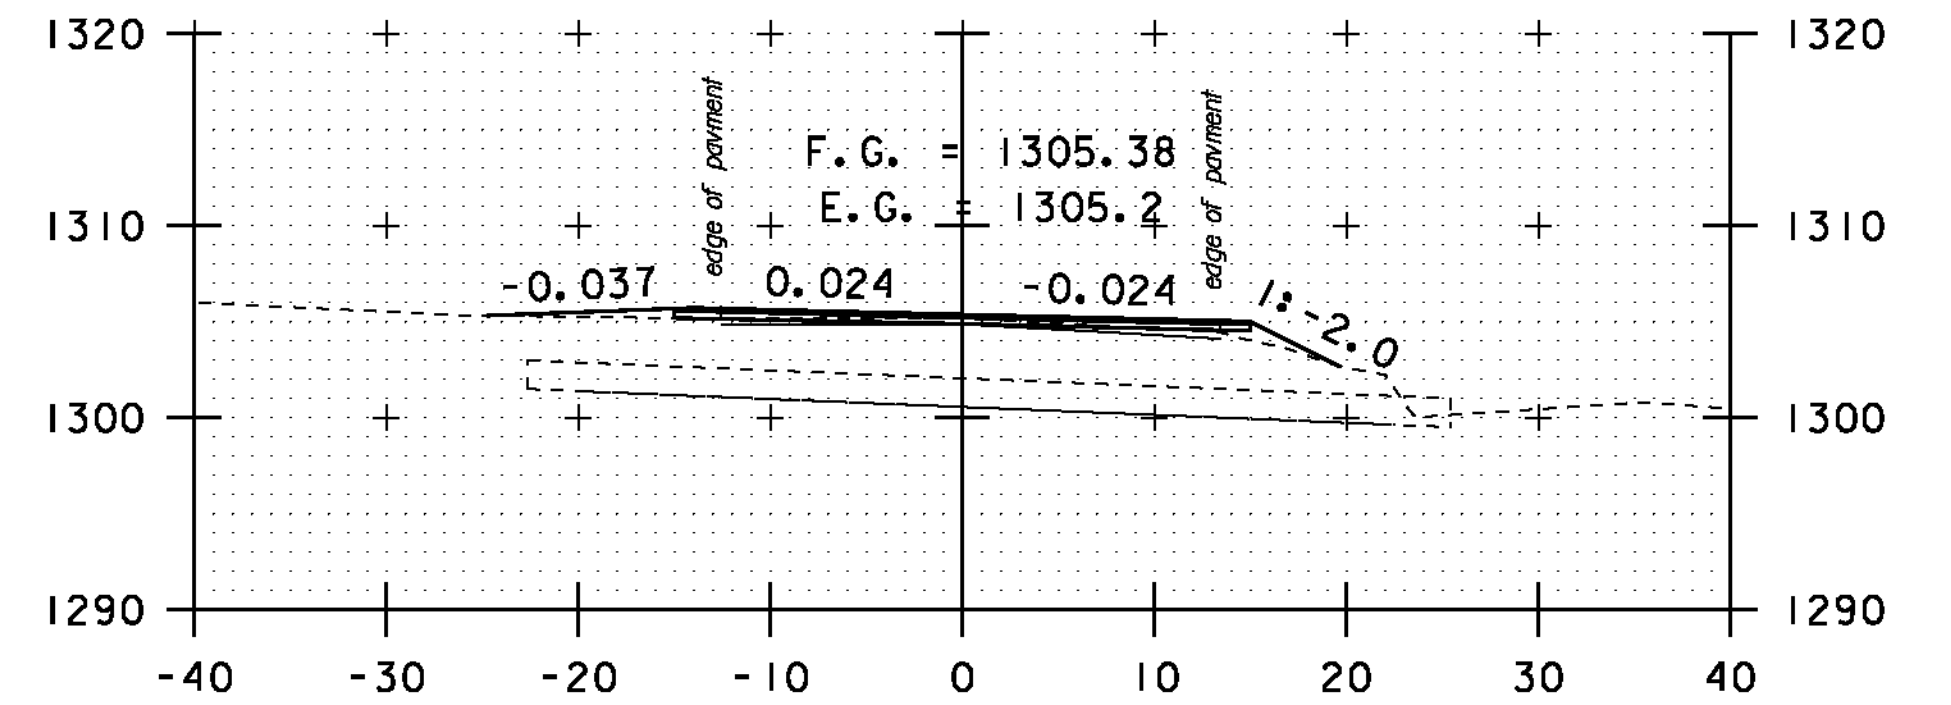


DRIVE LT  
183+50

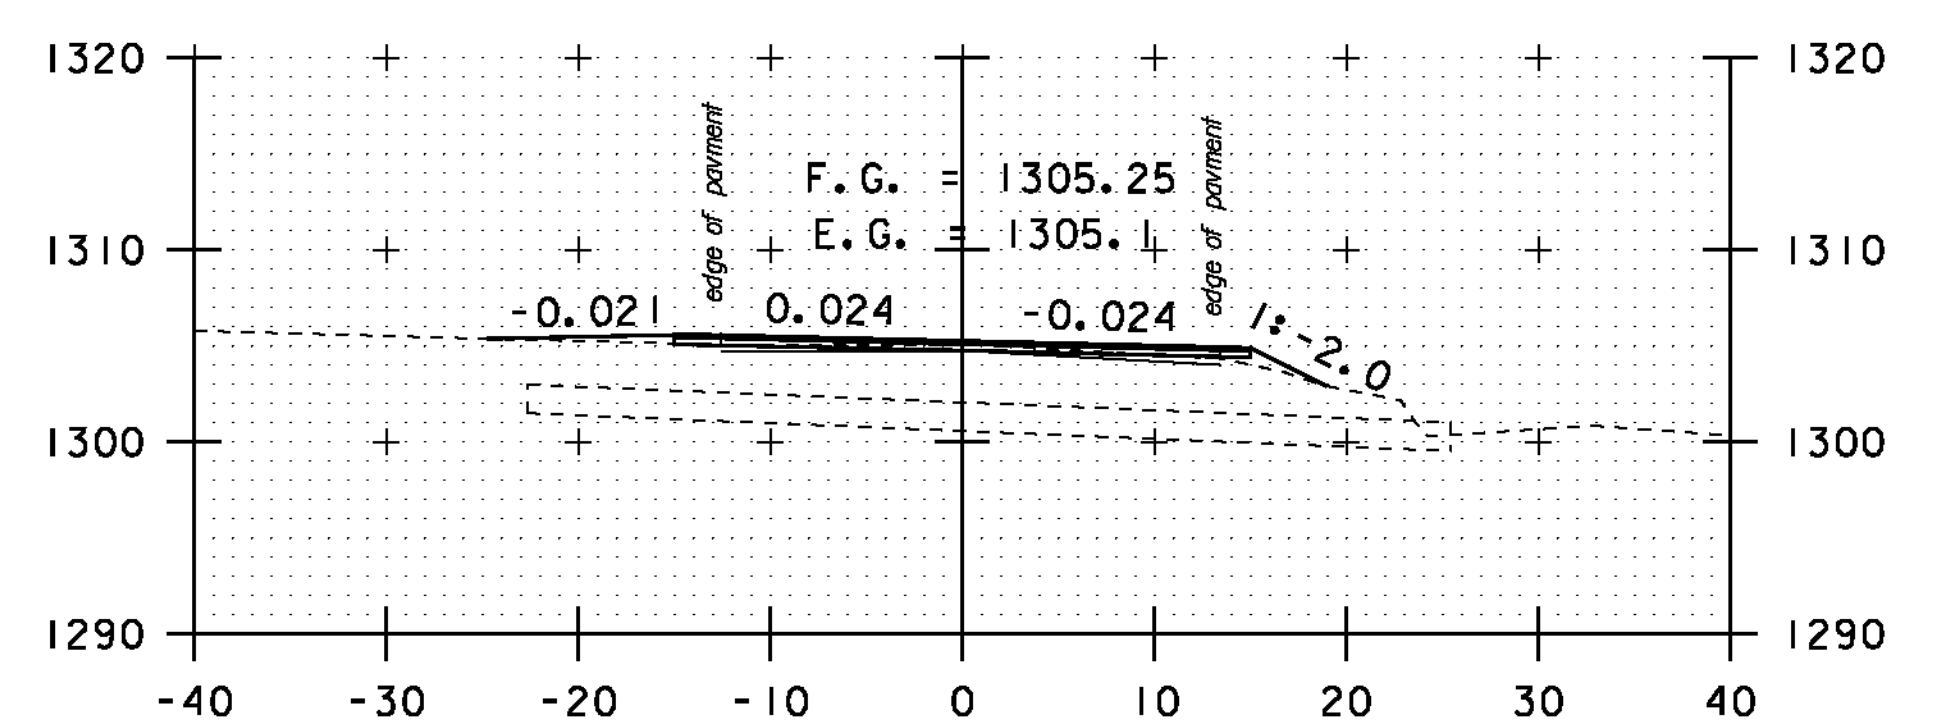

DRIVE LT  
183+45

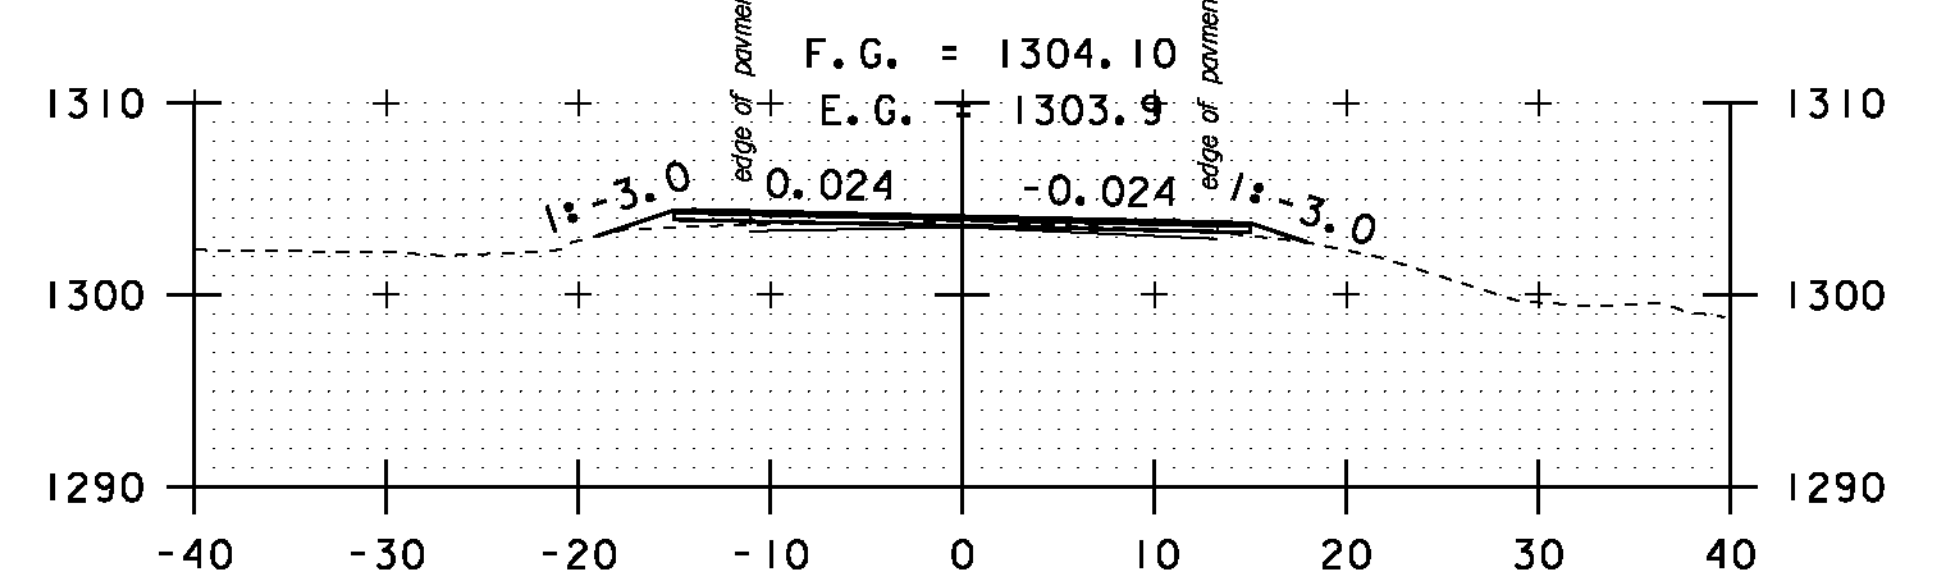


183+00

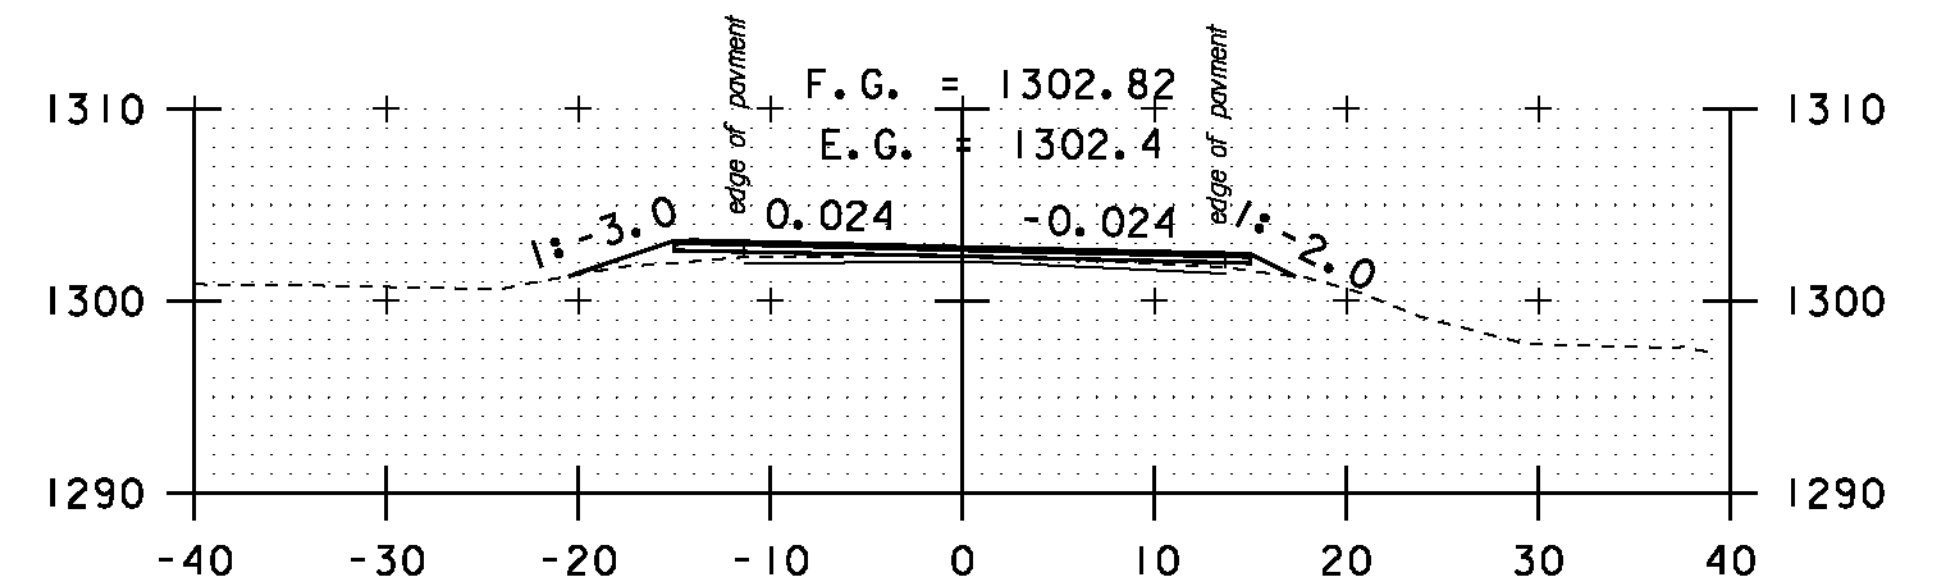

182+50

STA. 178+50 TO STA. 183+50

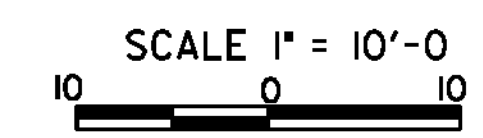

**CROSS SECTION SHEET 34**

PROJECT NAME: MONTGOMERY-WESTFIELD	PLOT DATE: 9/5/12
PROJECT NUMBER: STP 2906(I)	DRAWN BY: SJL
FILE NAME: p10ci90.dgn	CHECKED BY: CDL
PROJECT LEADER: CDL	SHEET 148 OF 178
DESIGNED BY: SJL	
PLOT FILE: p10ci90_148.l	