




185+50

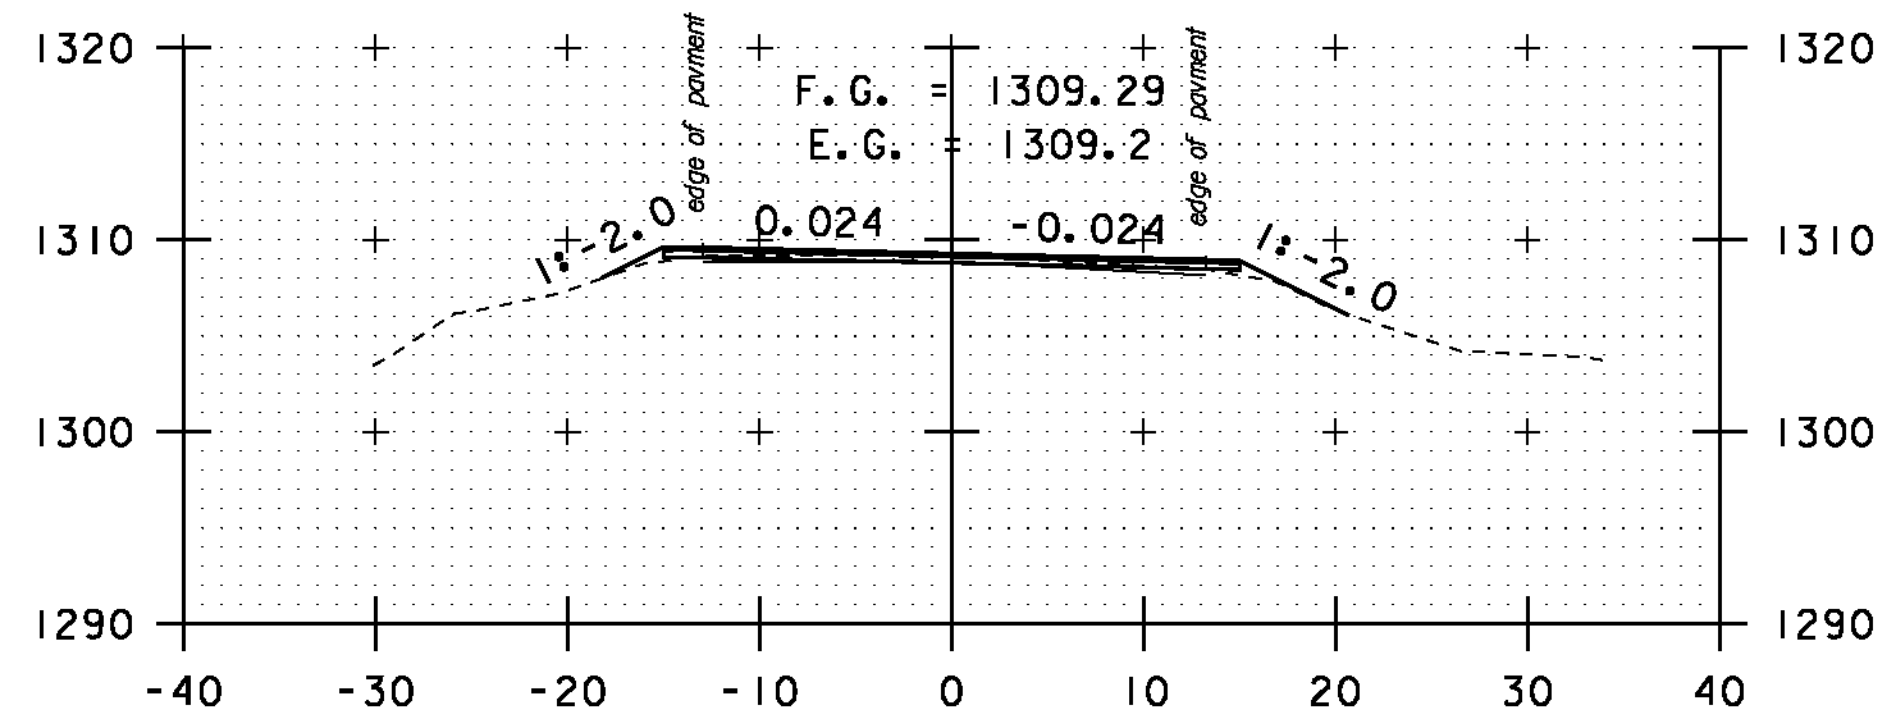


185+00

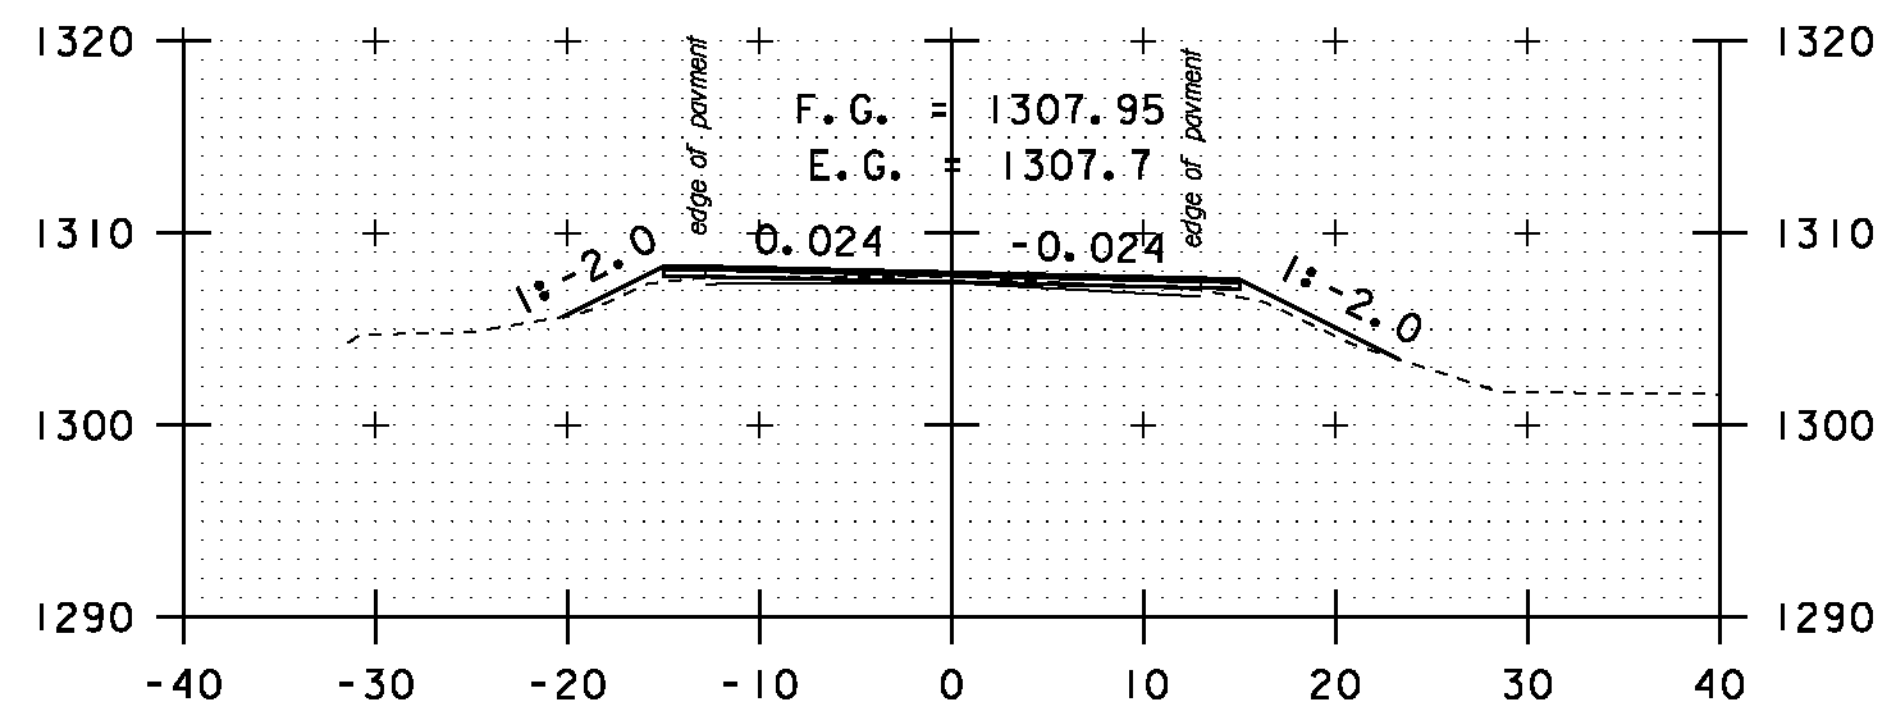


184+50

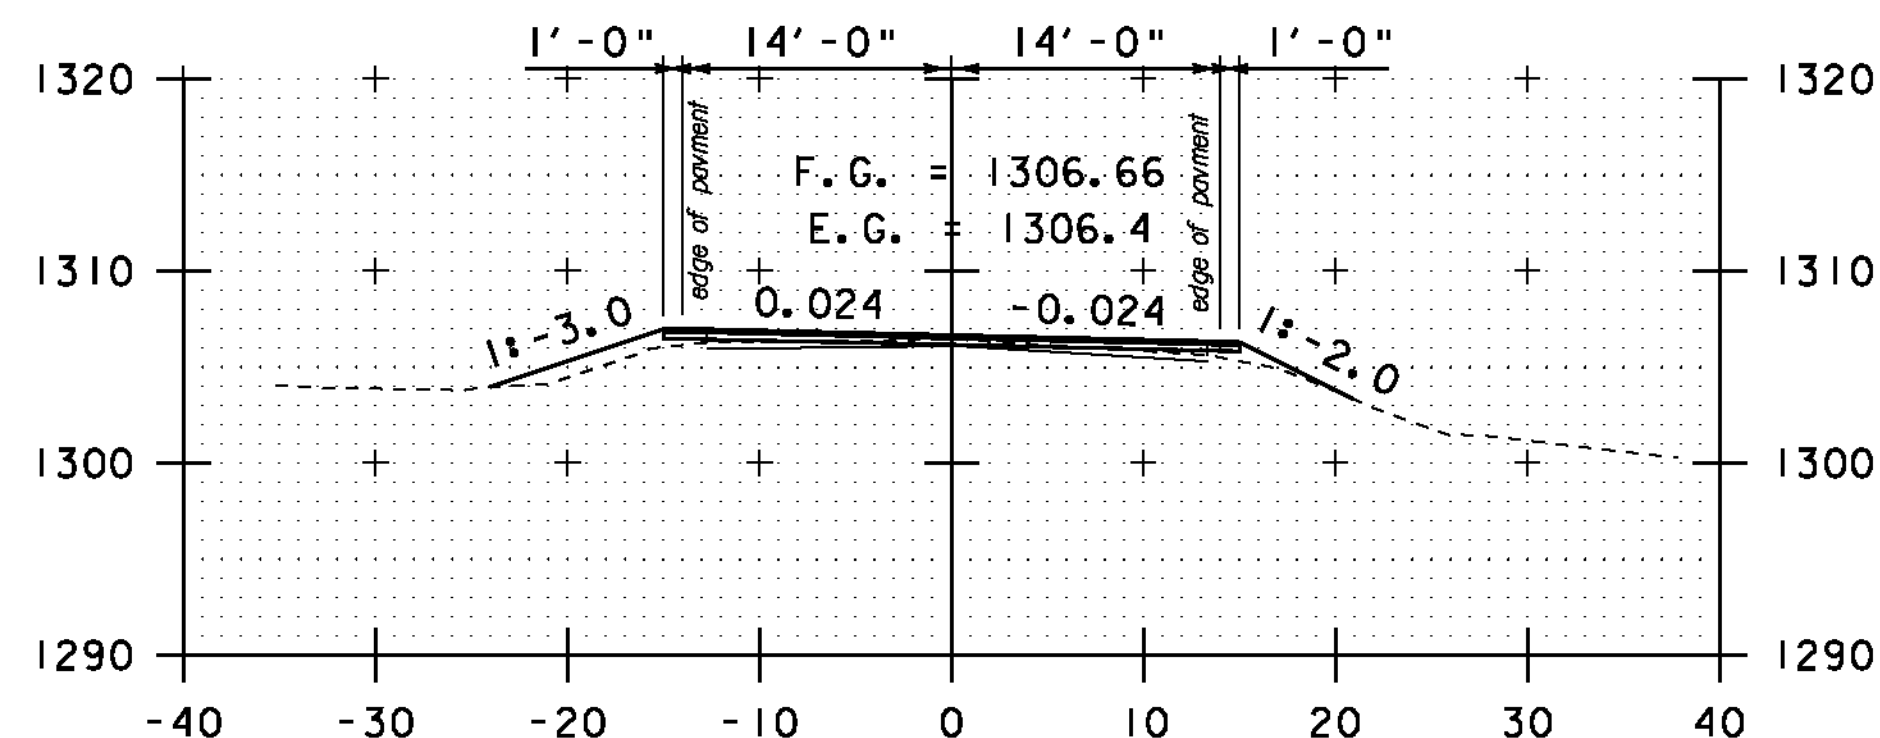


184+00

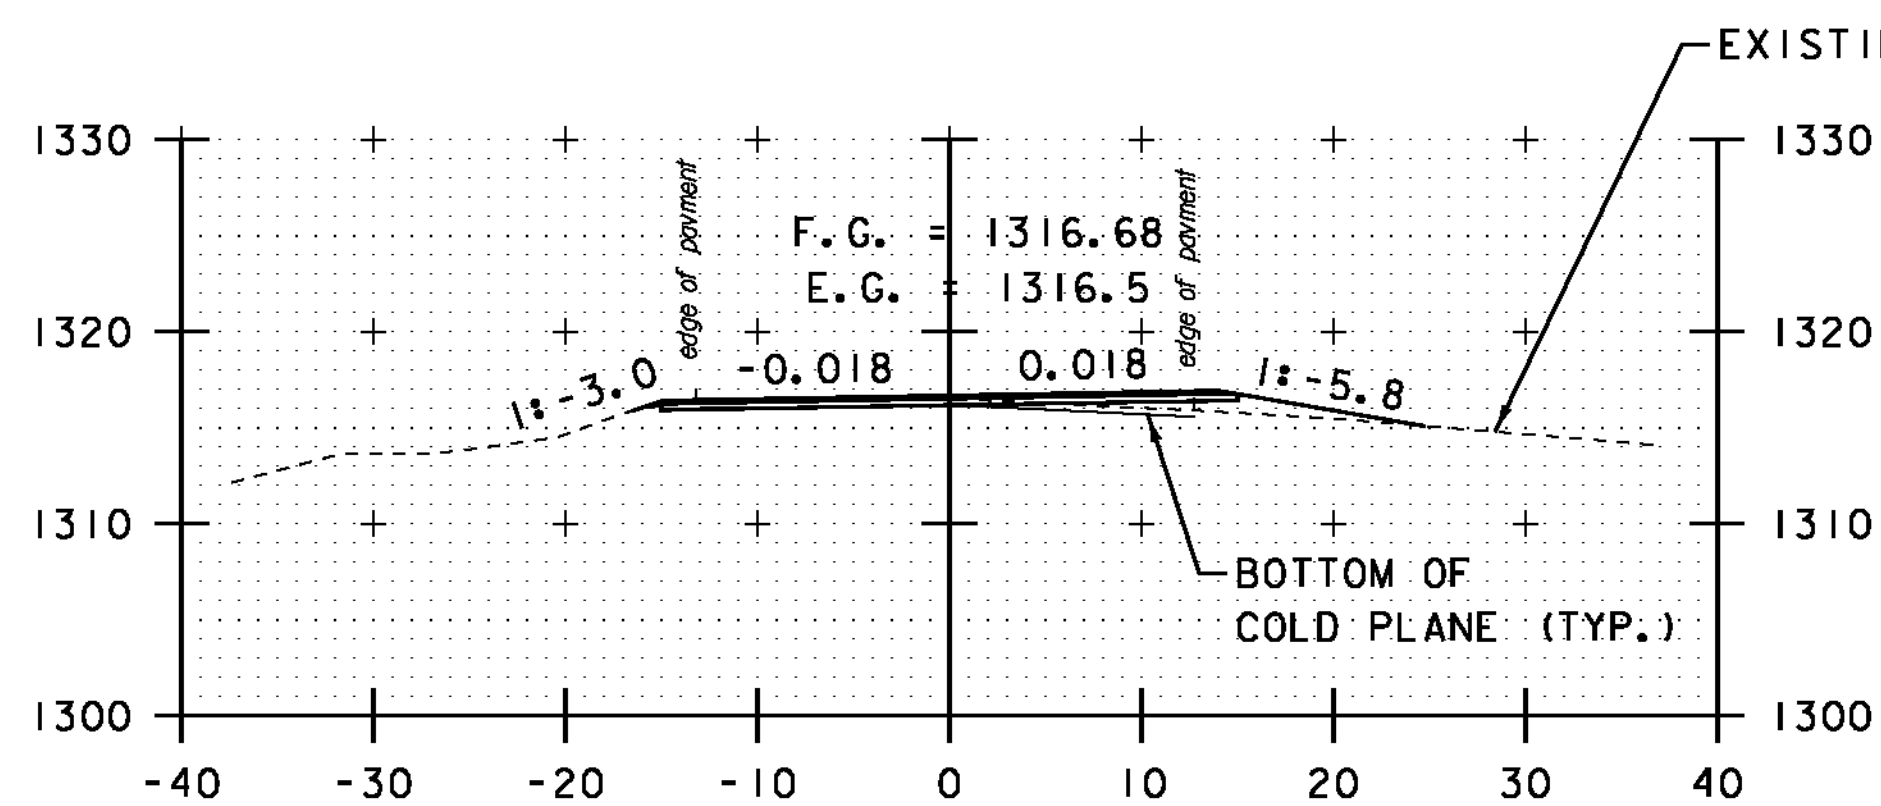


DRIVE RT  
187+50

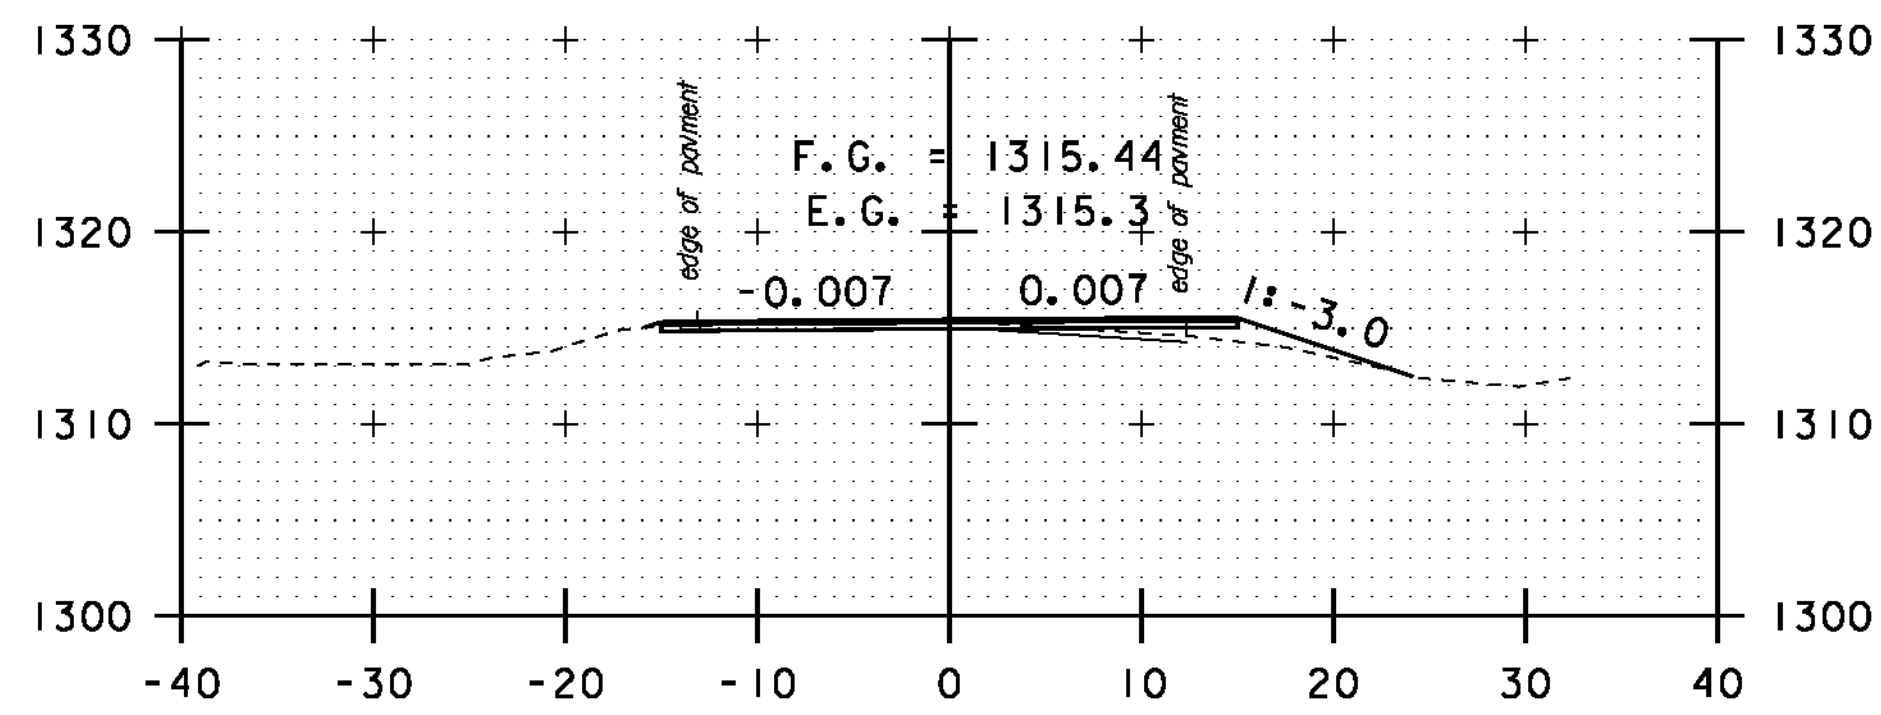


187+00

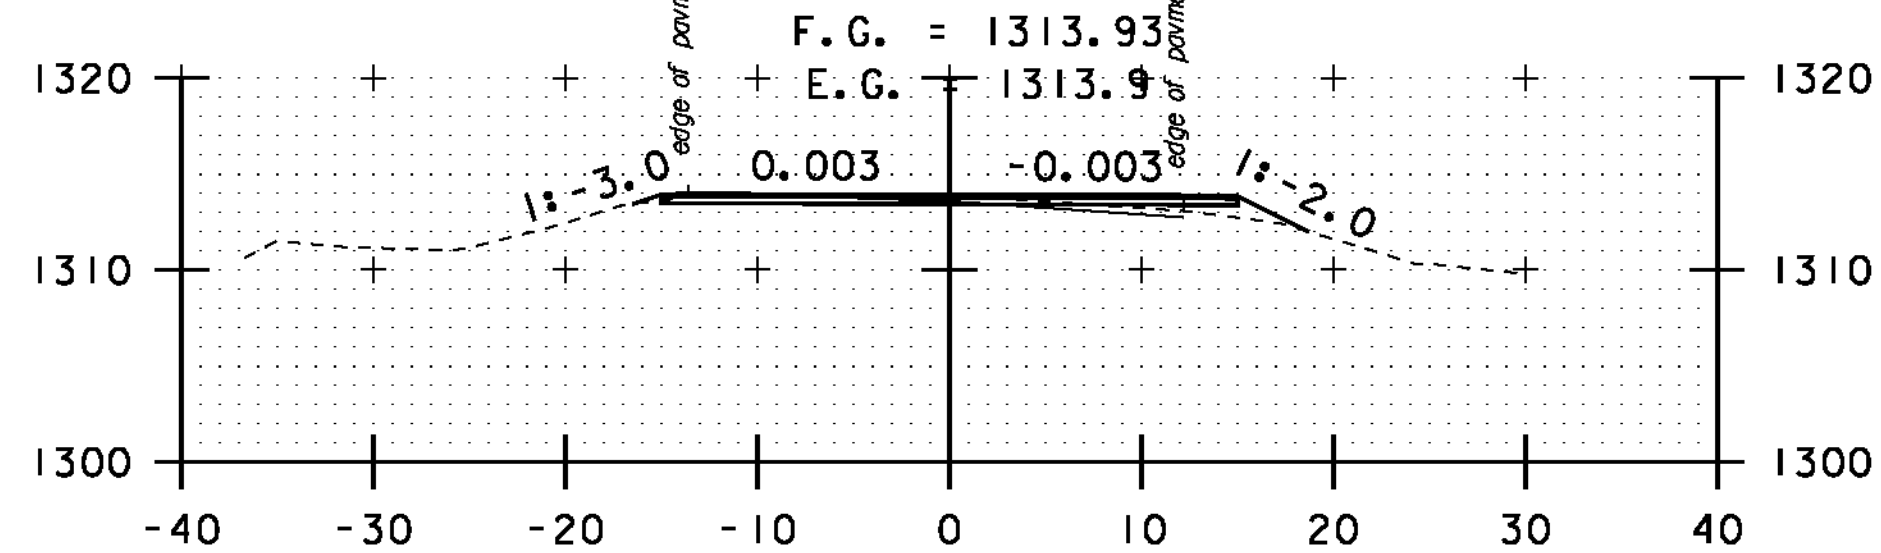


186+50

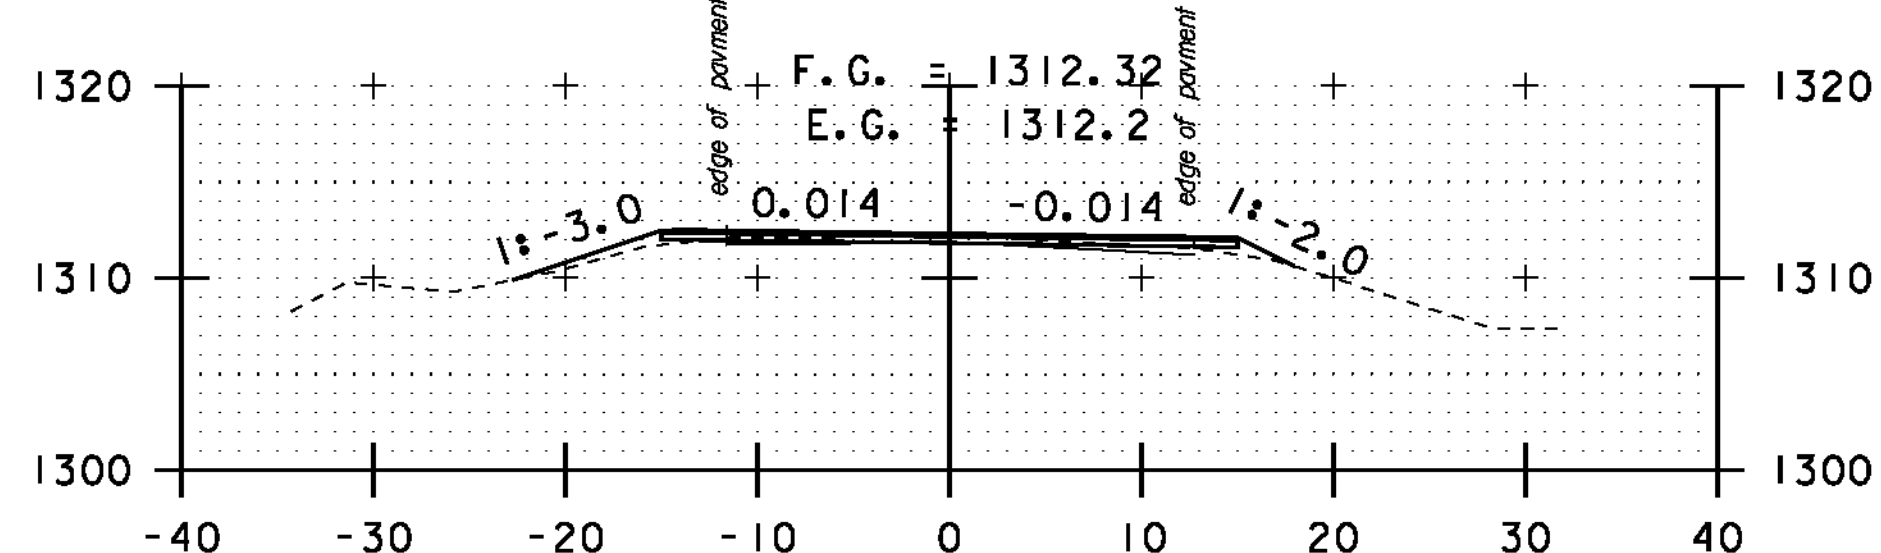


186+00

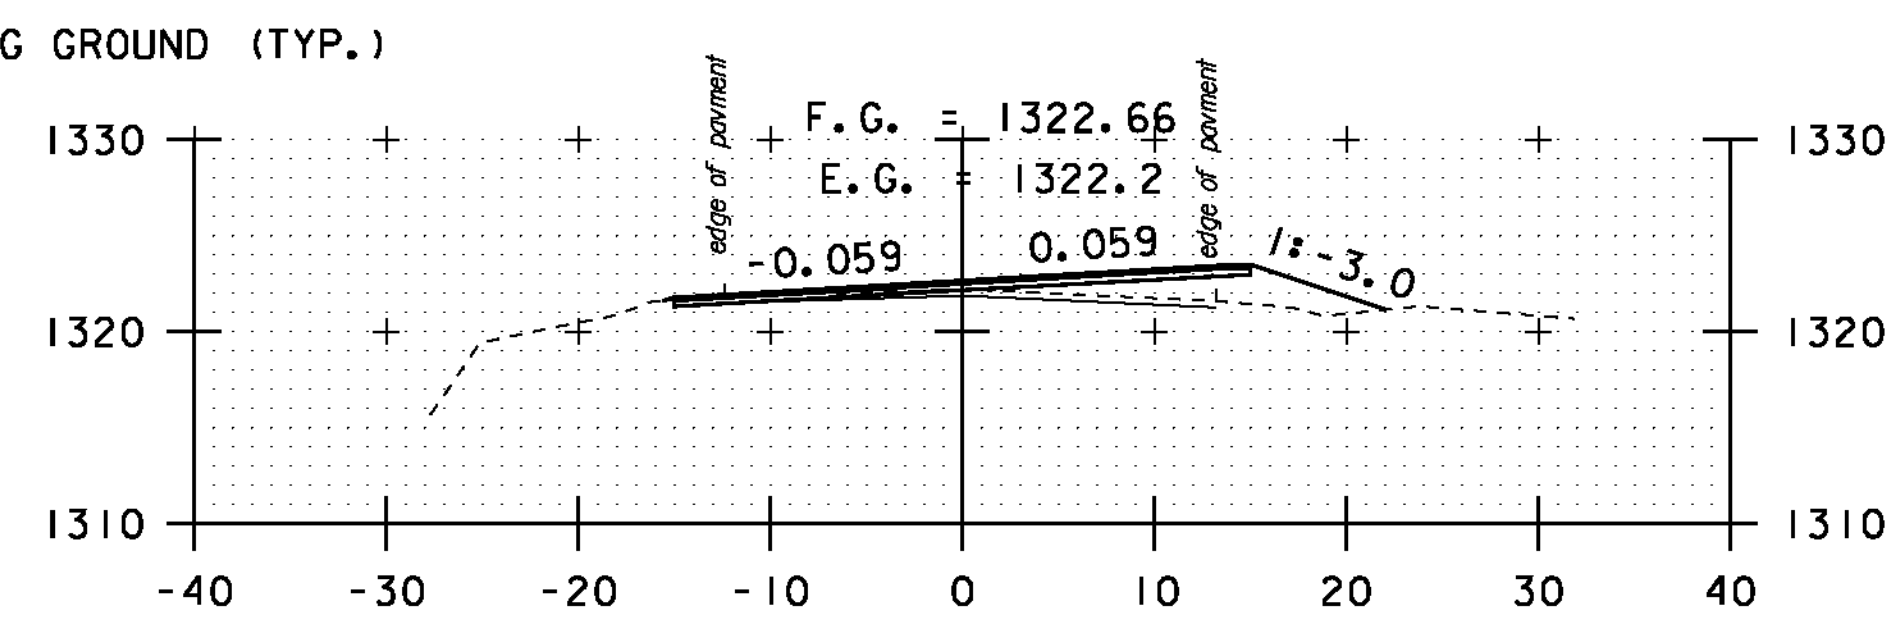


189+50

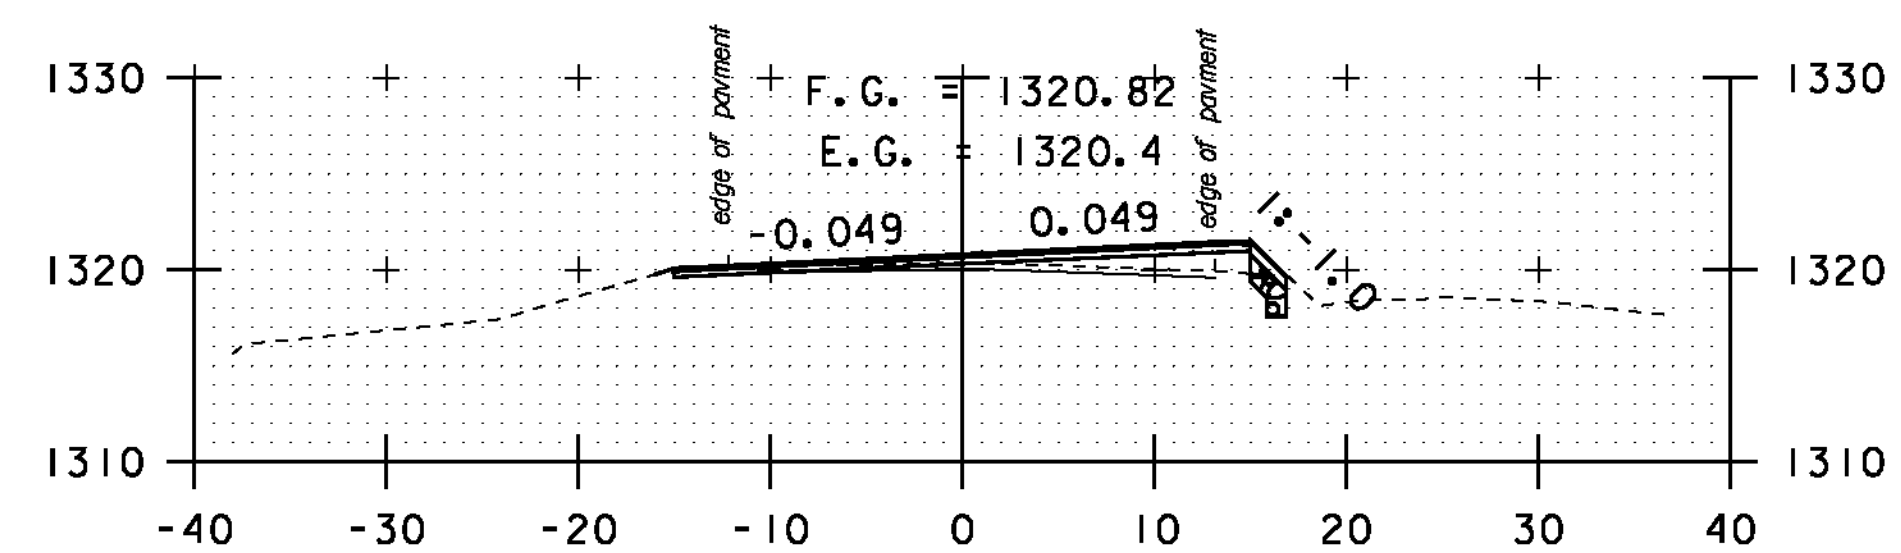

189+00

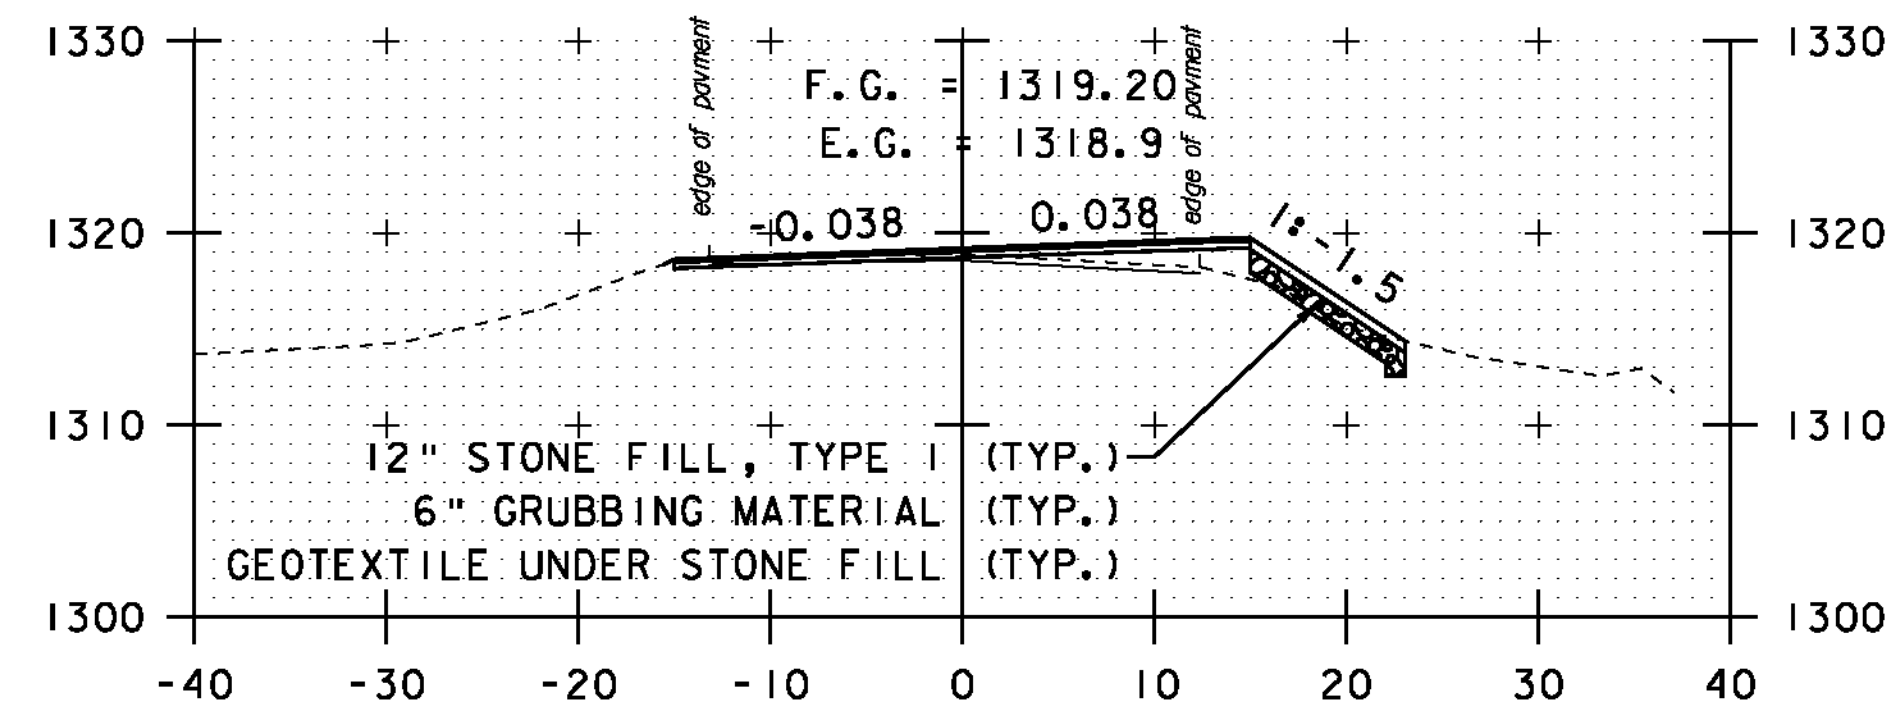


188+50

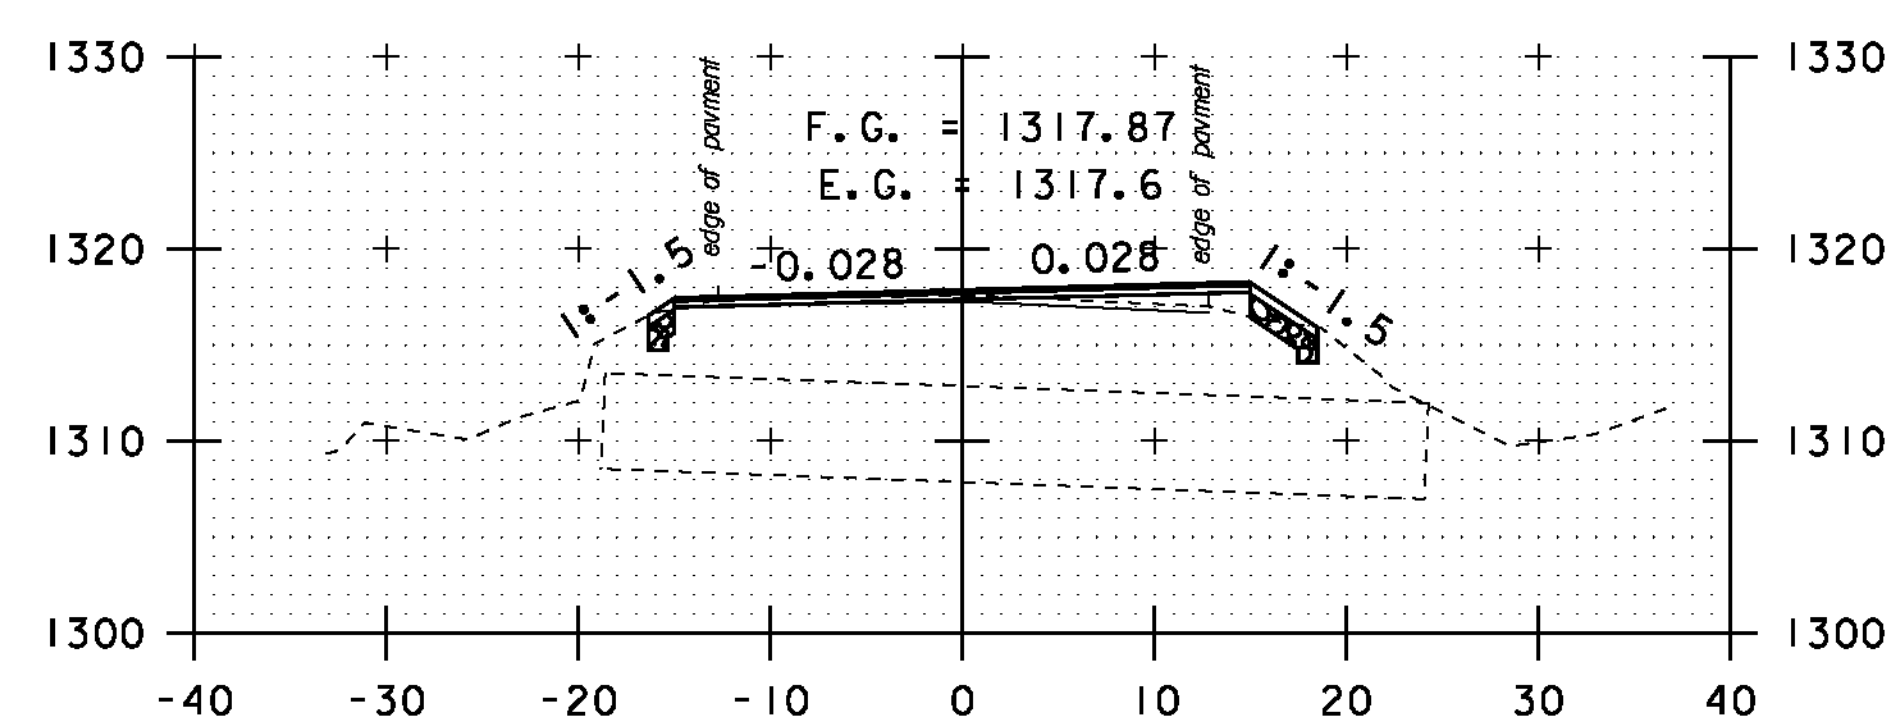

188+00

STA. 184+00 TO STA. 189+50

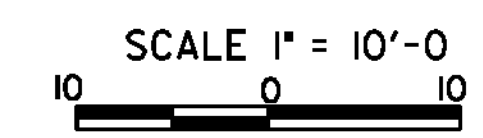

**CROSS SECTION SHEET 35**

PROJECT NAME: MONTGOMERY-WESTFIELD	PLOT DATE: 9/5/12
PROJECT NUMBER: STP 2906(1)	DRAWN BY: SJL
FILE NAME: p10ci90.dgn	CHECKED BY: CDL
PROJECT LEADER: CDL	SHEET 149 OF 178
DESIGNED BY: SJL	
PLOT FILE: p10ci90_149.l	