




191+50

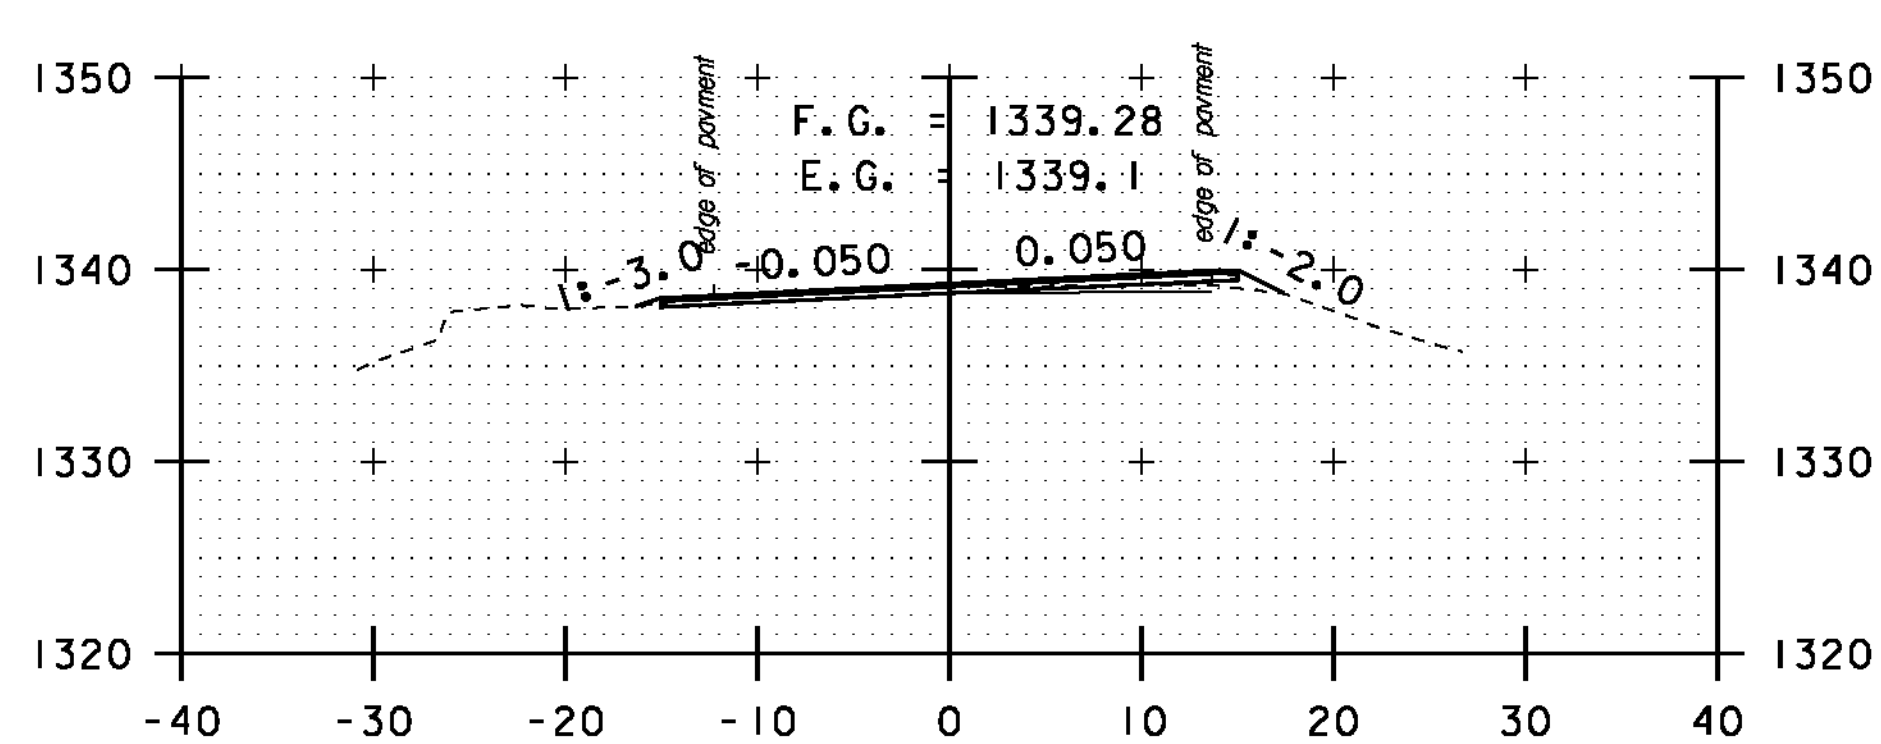


193+50

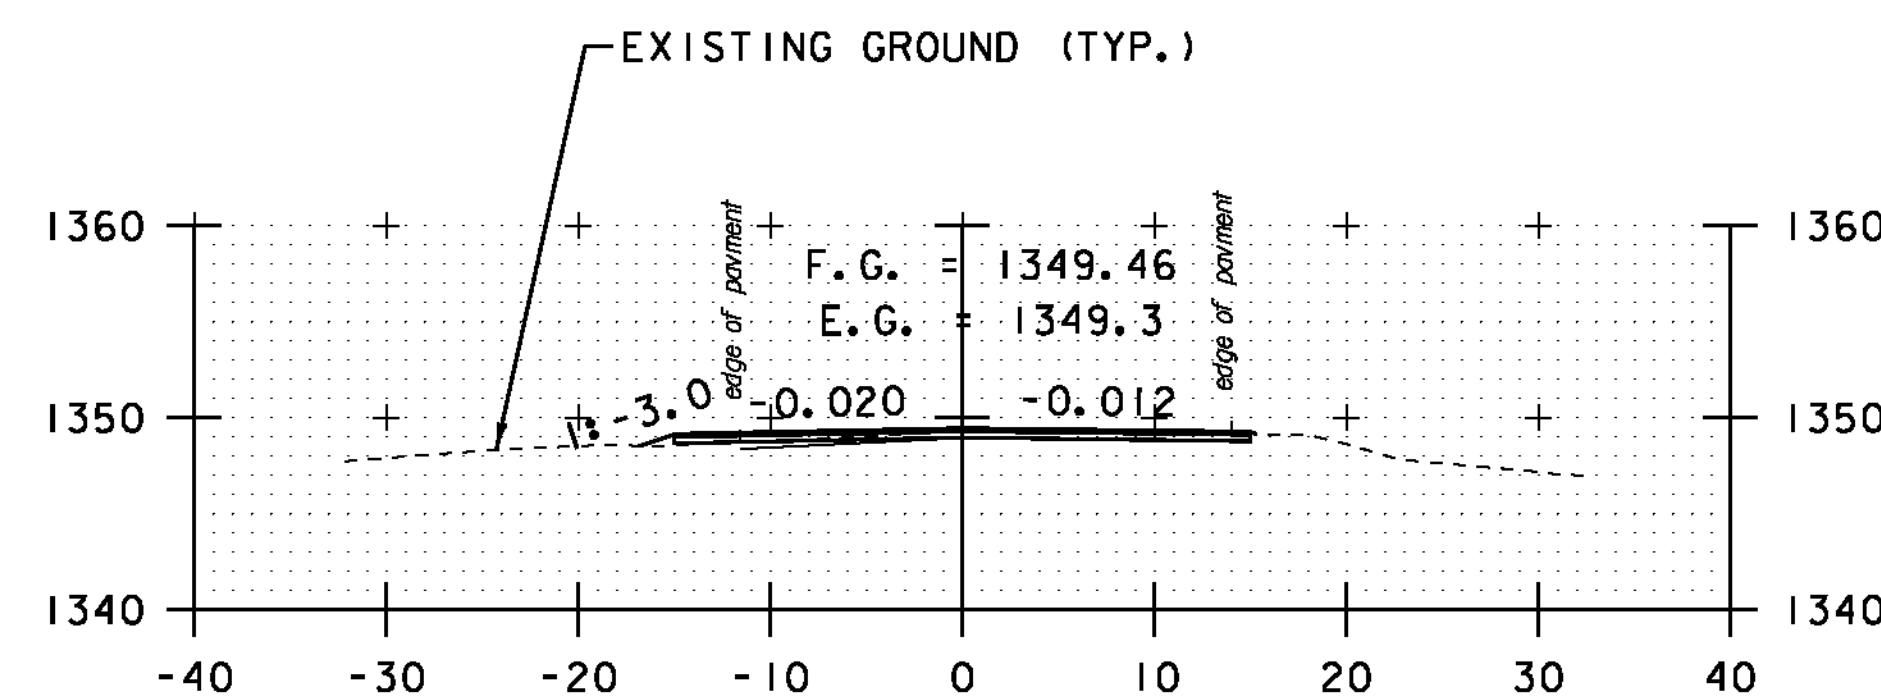


195+50

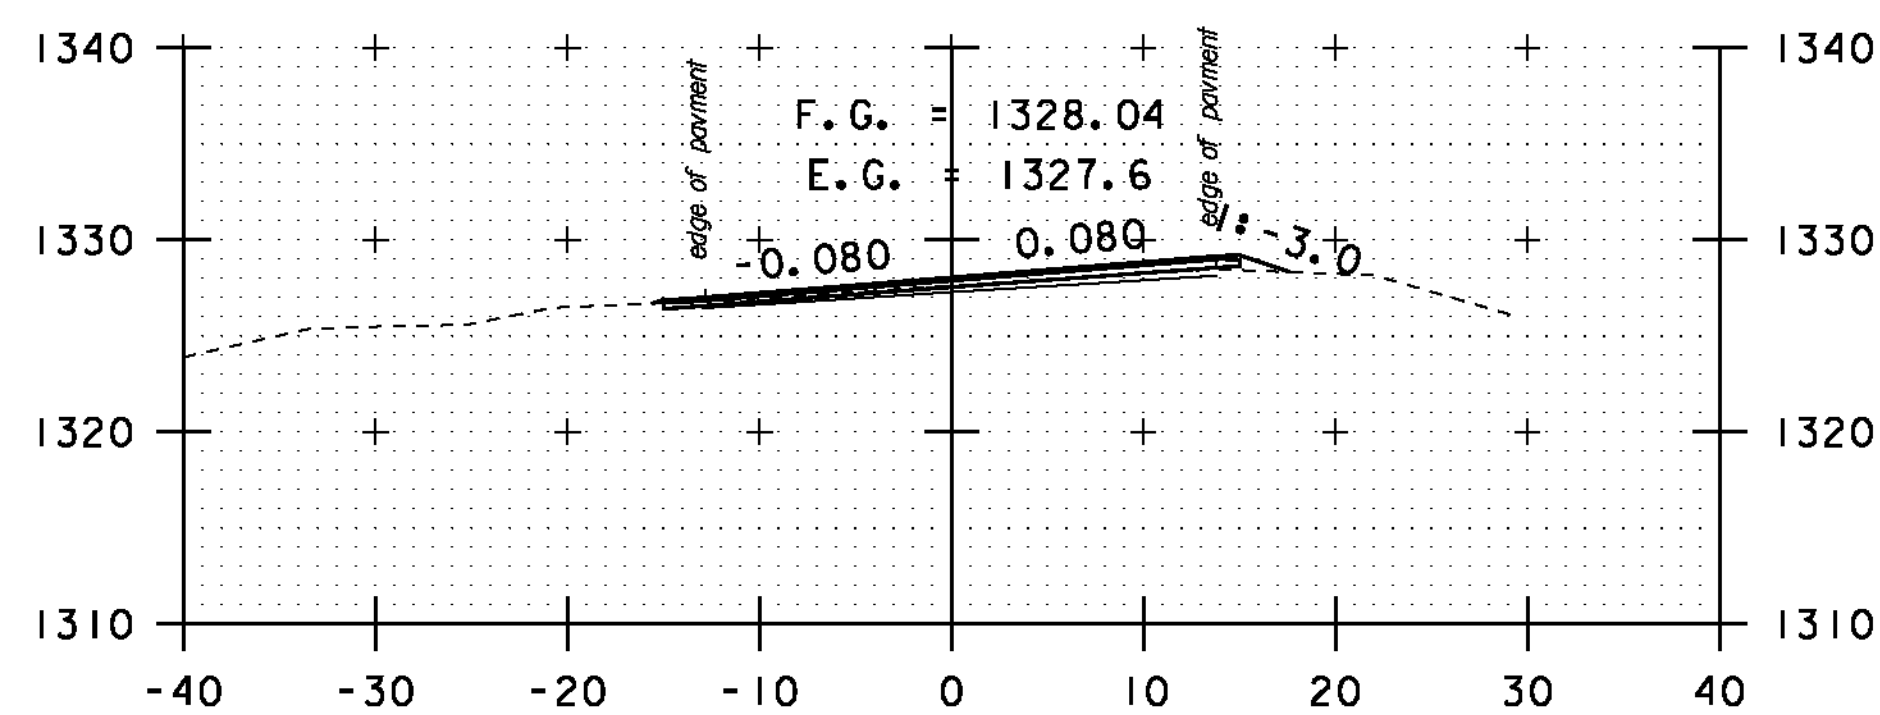


191+00

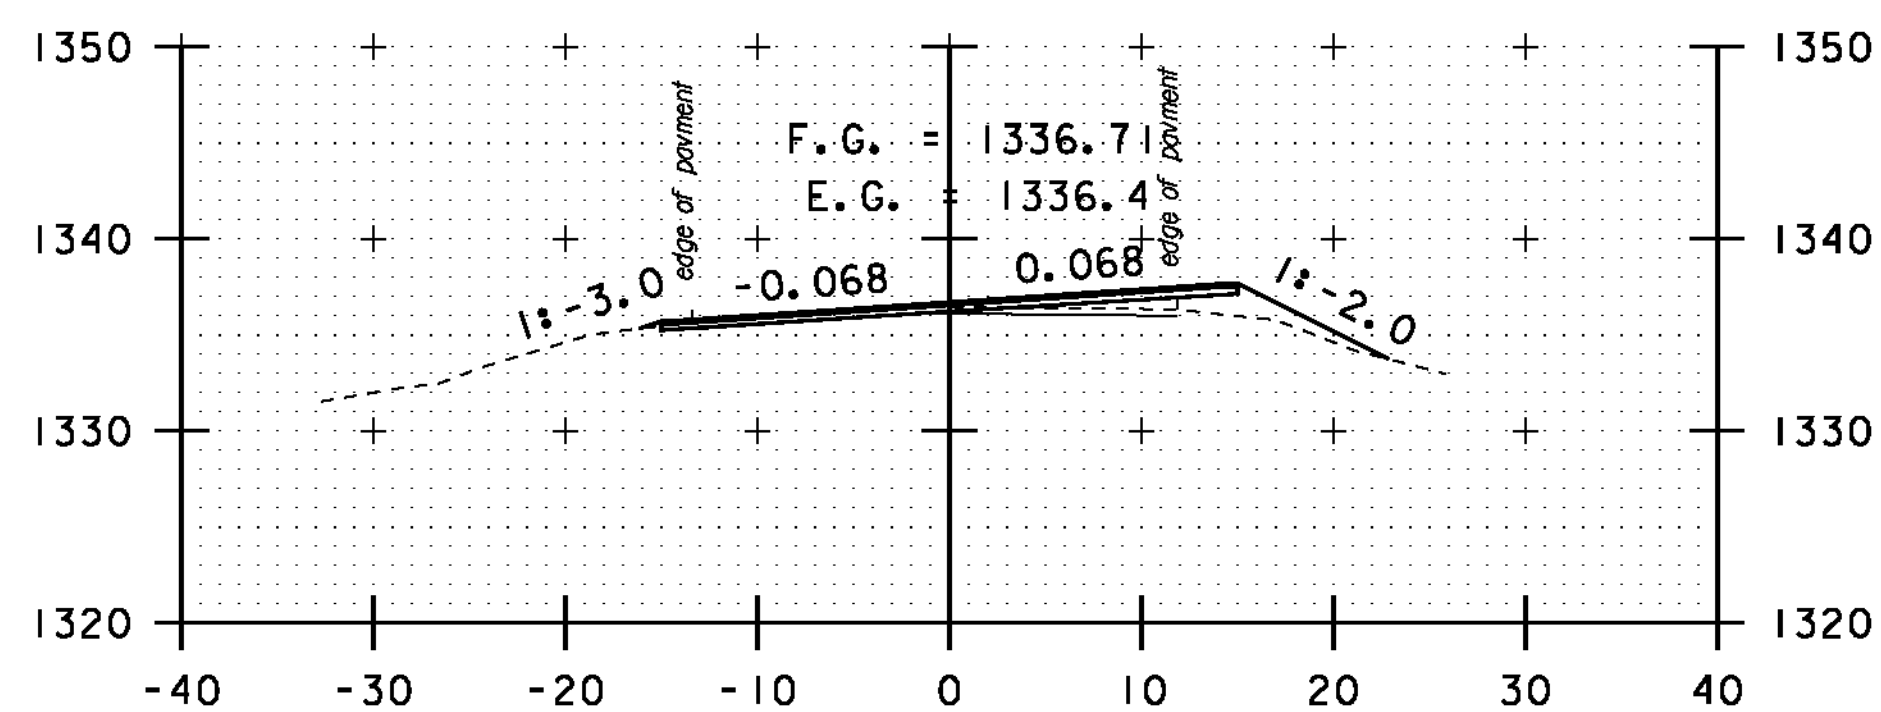


193+00

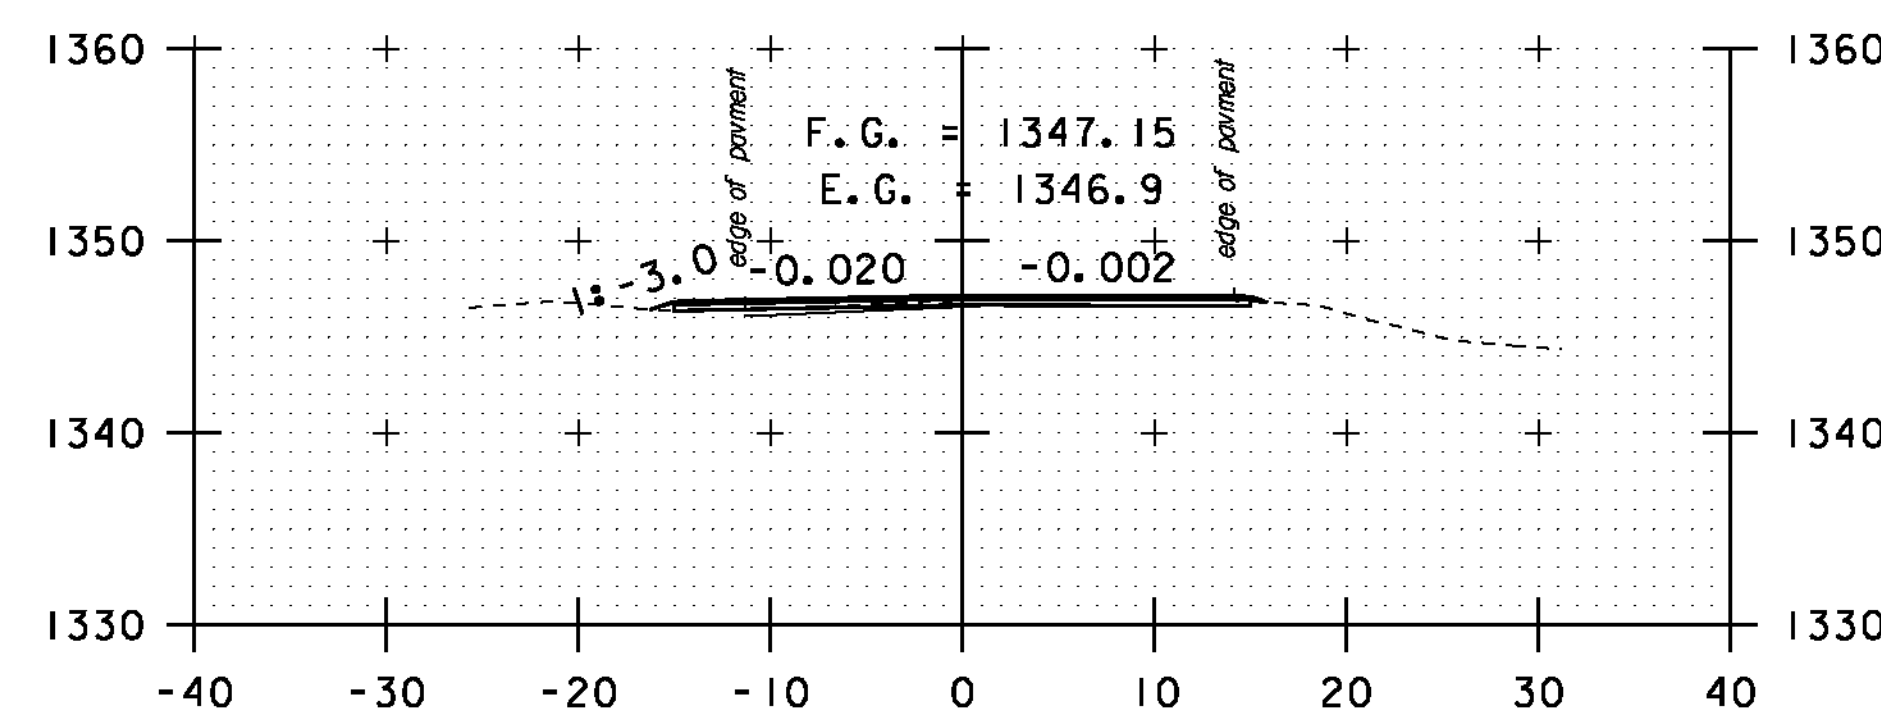


195+00

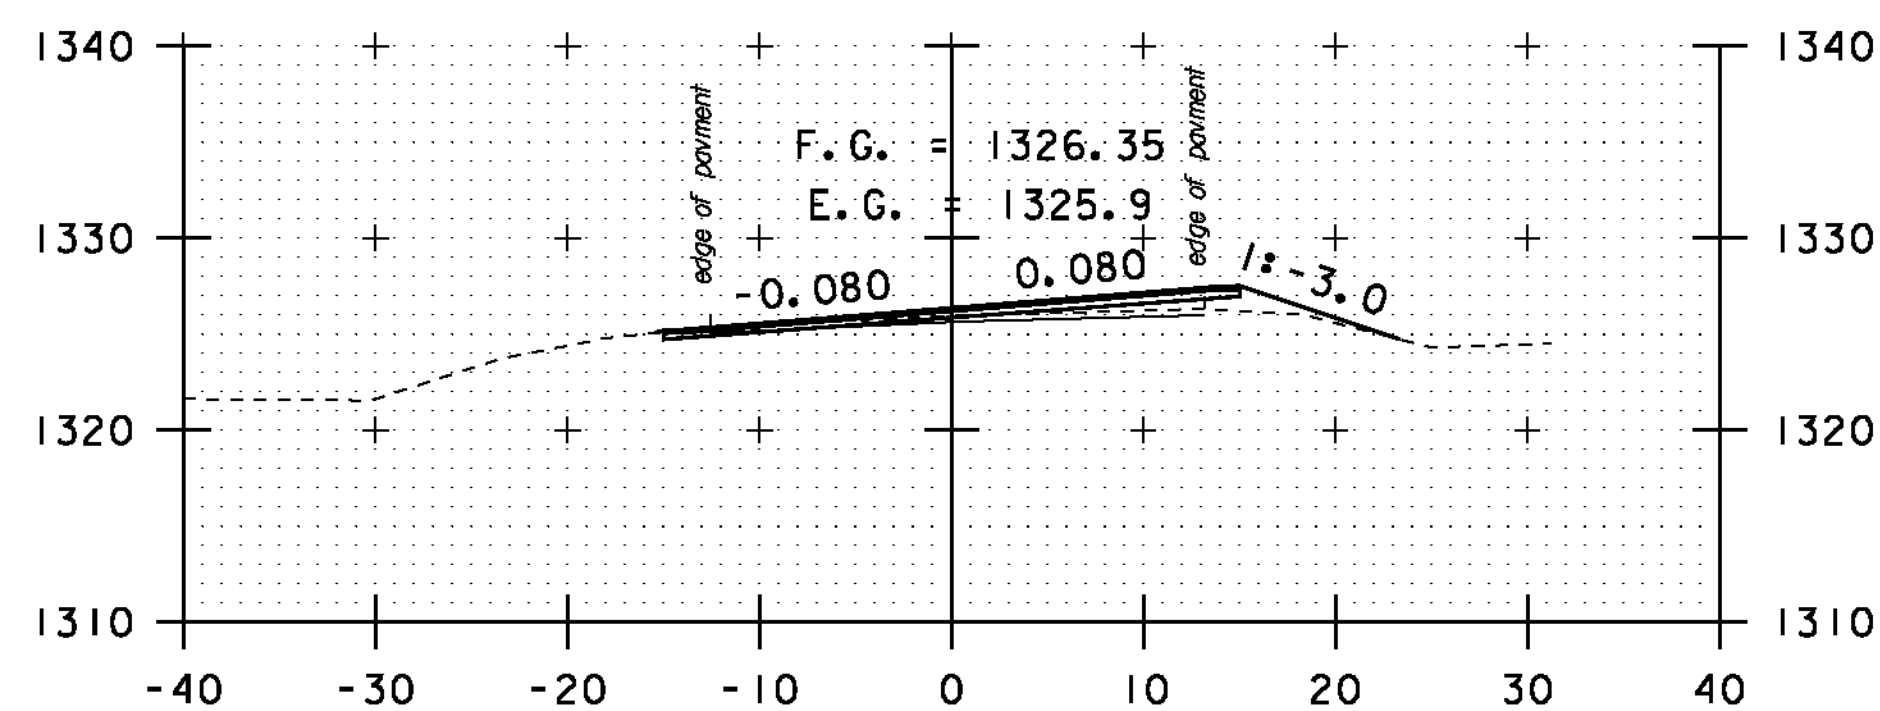


190+50

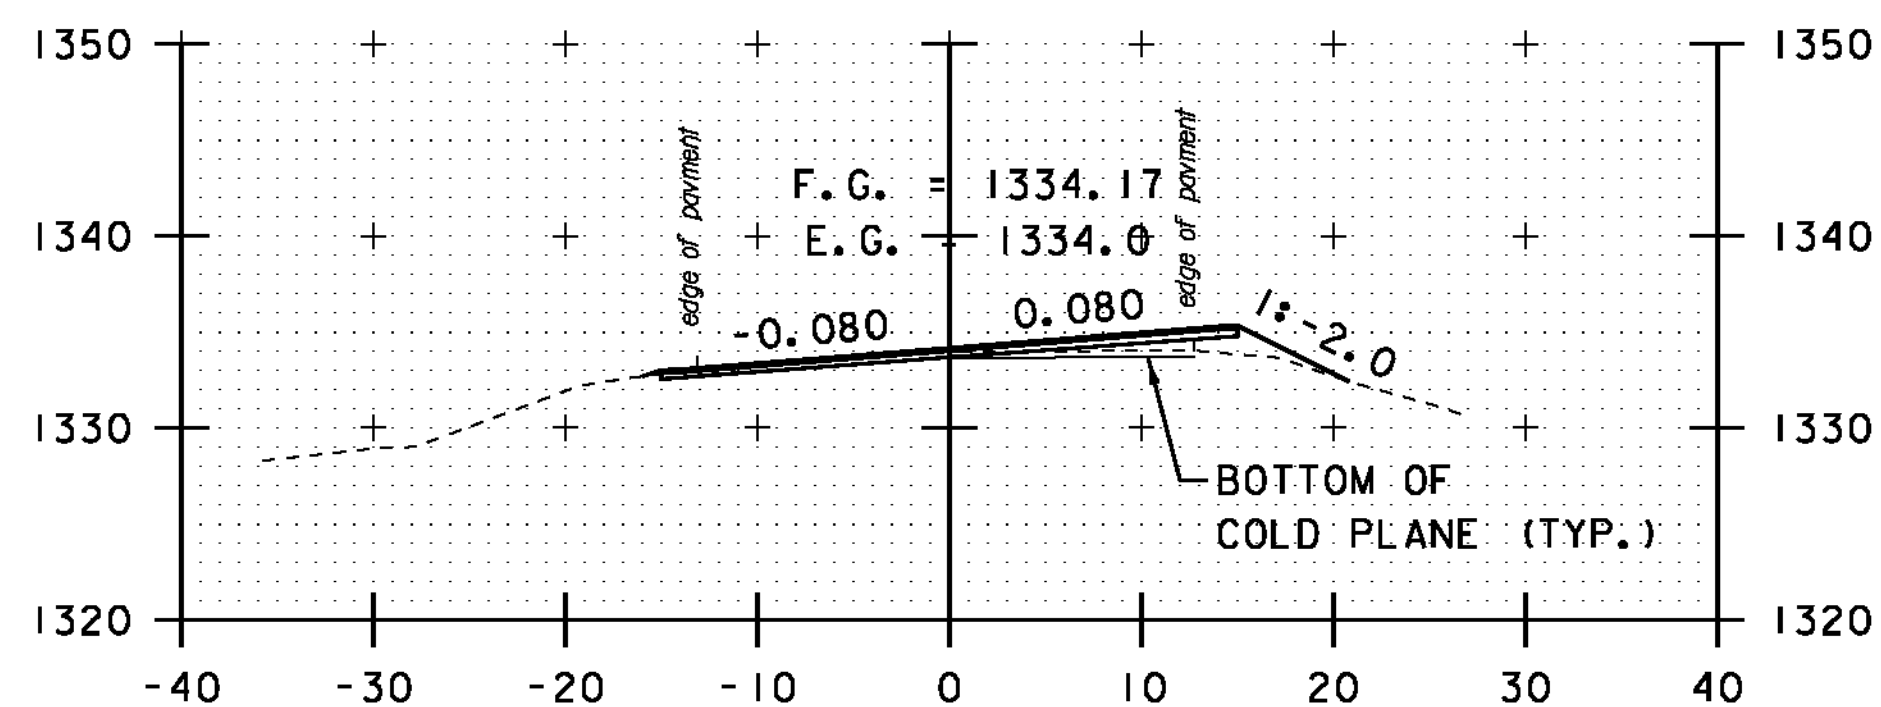


192+50

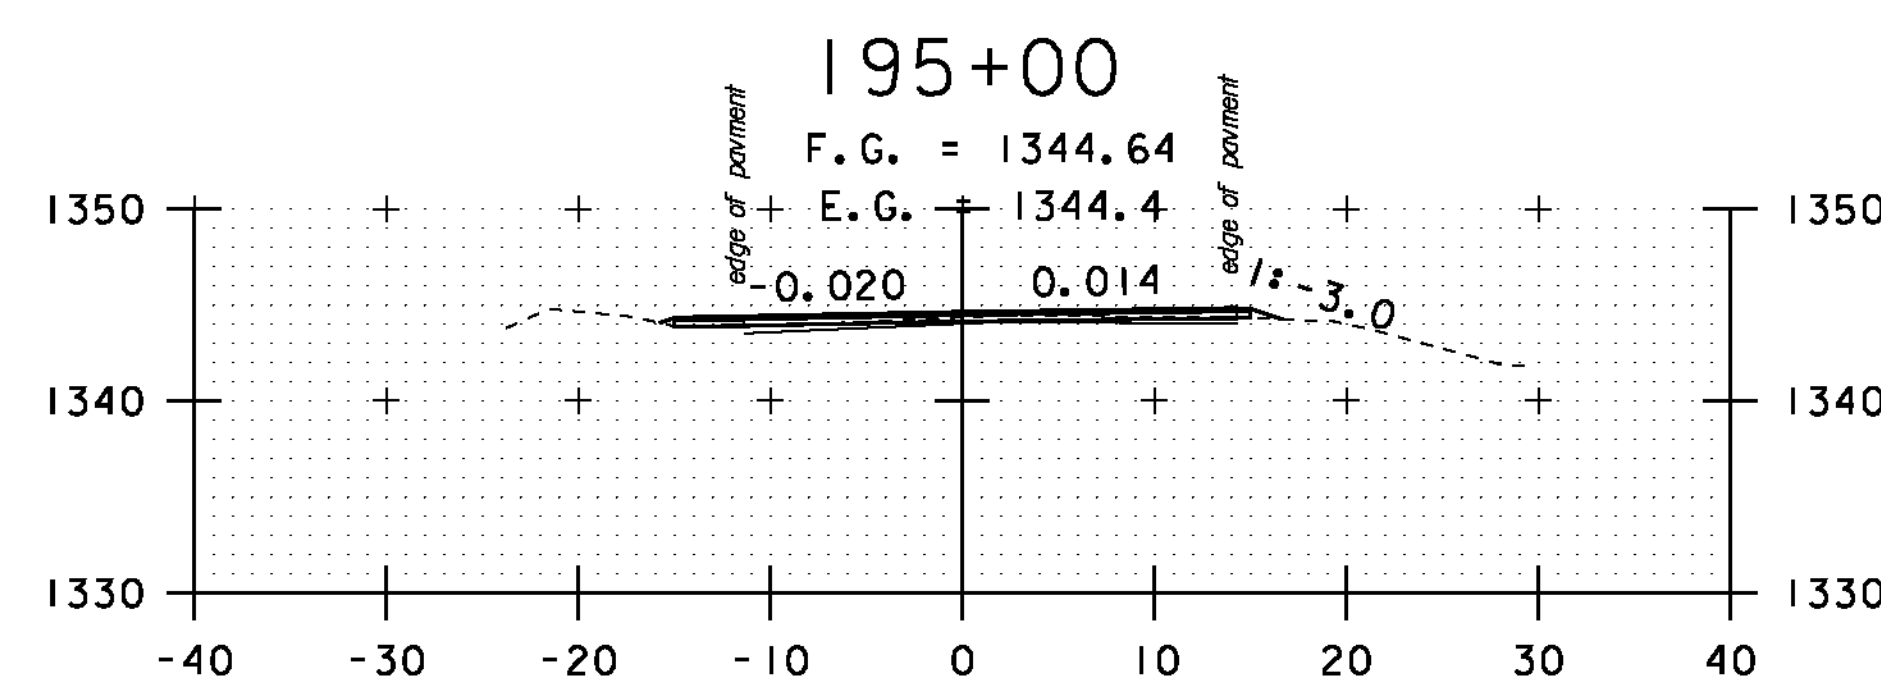


194+50

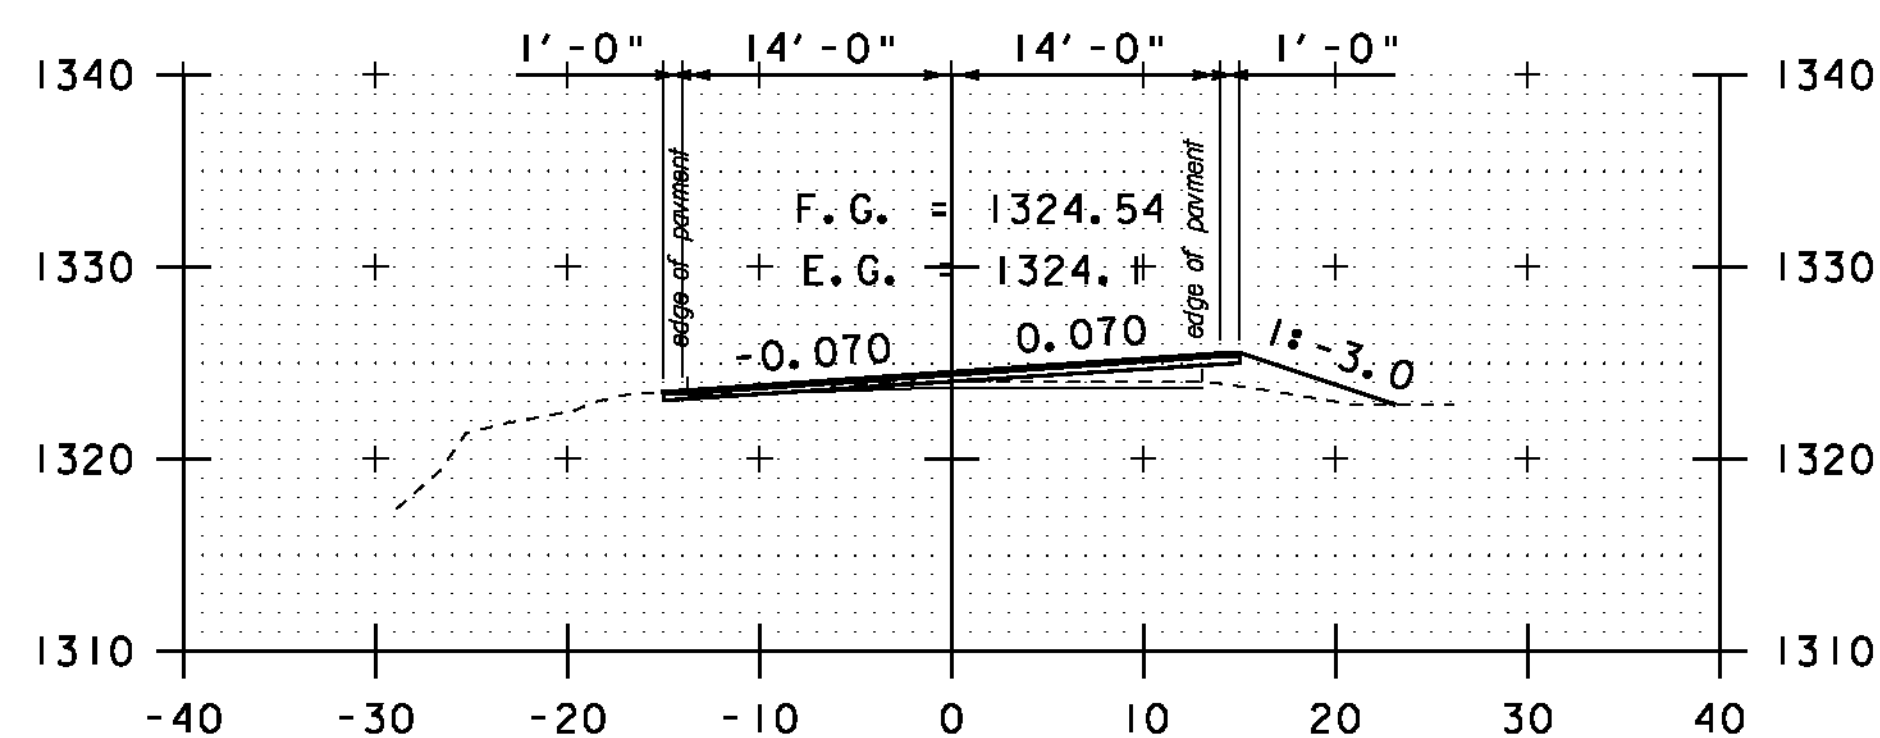

190+00

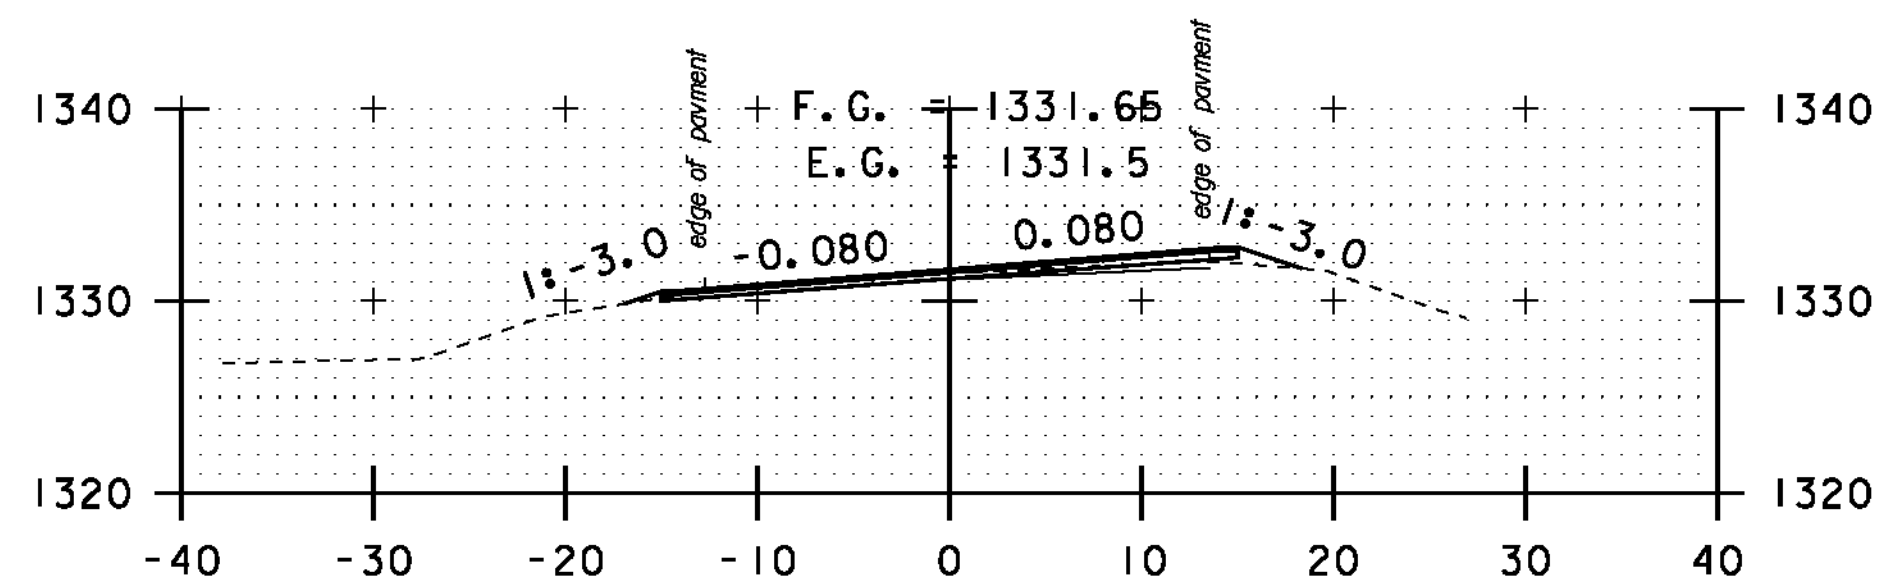

192+00

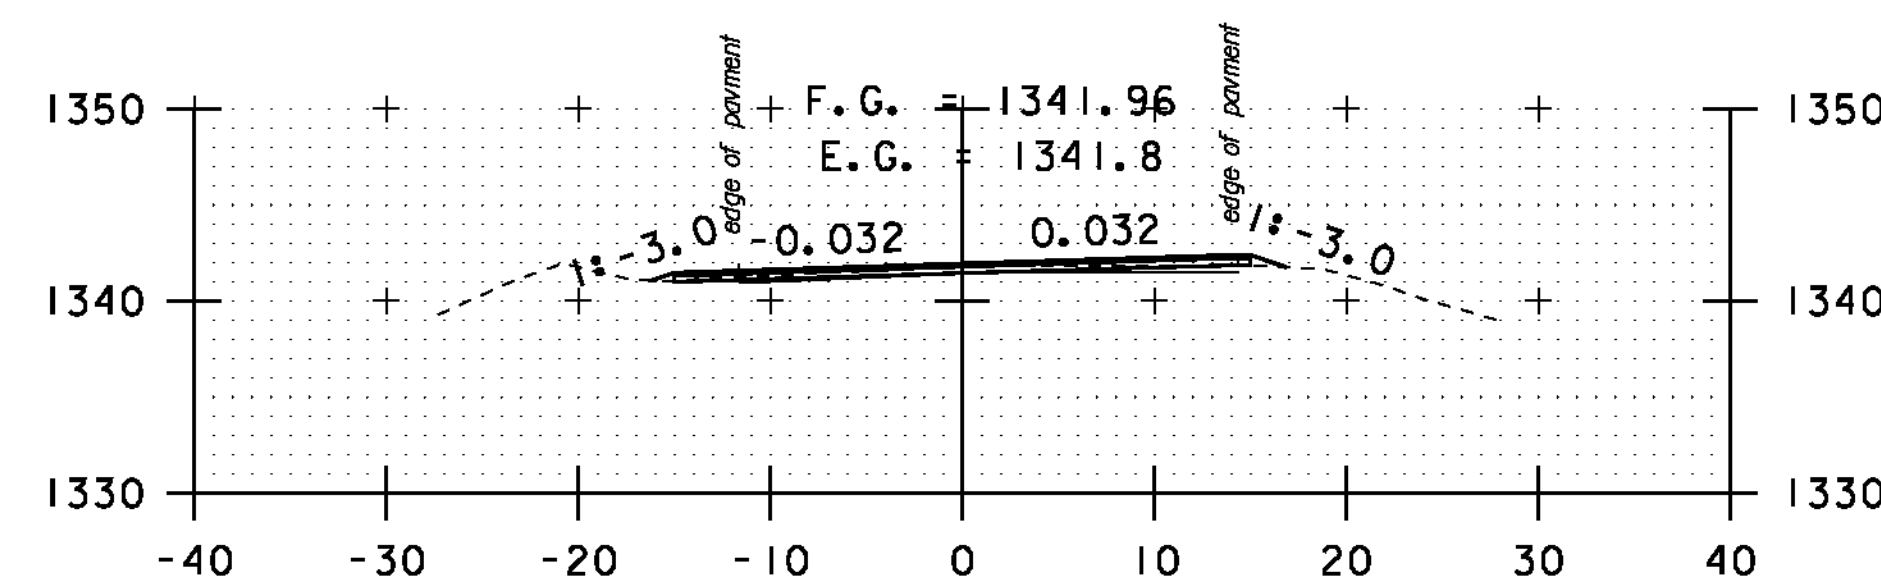

194+00

STA. 190+00 TO STA. 195+50

SCALE 1" = 10'-0"

CROSS SECTION SHEET 36

PROJECT NAME: MONTGOMERY-WESTFIELD
 PROJECT NUMBER: STP 2906(I)
 FILE NAME: p10ci90.dgn
 PROJECT LEADER: CDL
 DESIGNED BY: SJL
 PLOT FILE: p10ci90_150.l
 PLOT DATE: 9/5/12
 DRAWN BY: SJL
 CHECKED BY: CDL
 SHEET 150 OF 178