




197+50

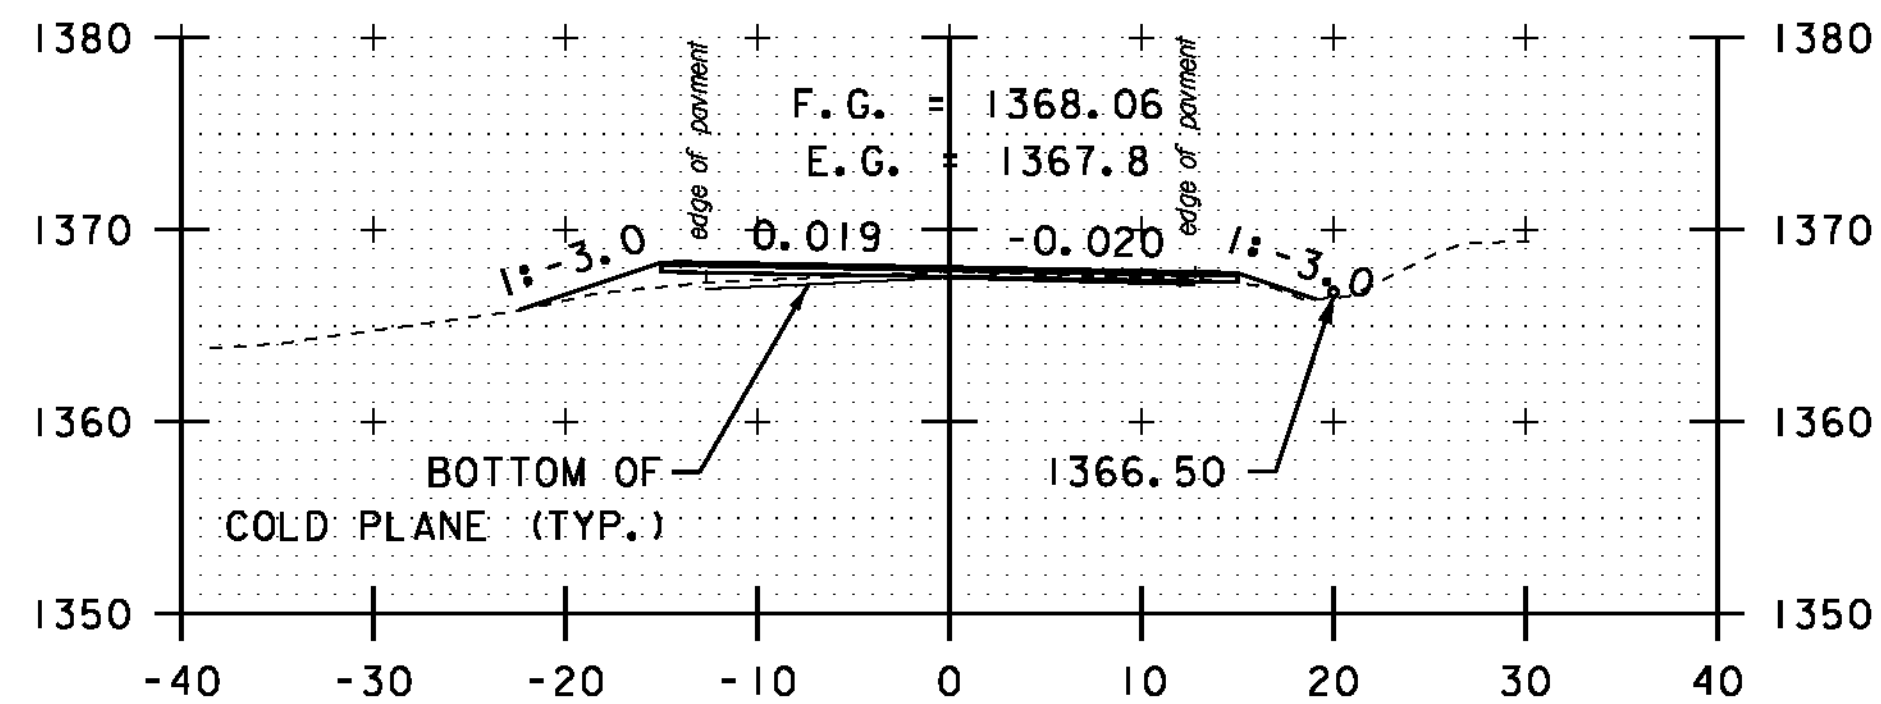


199+50

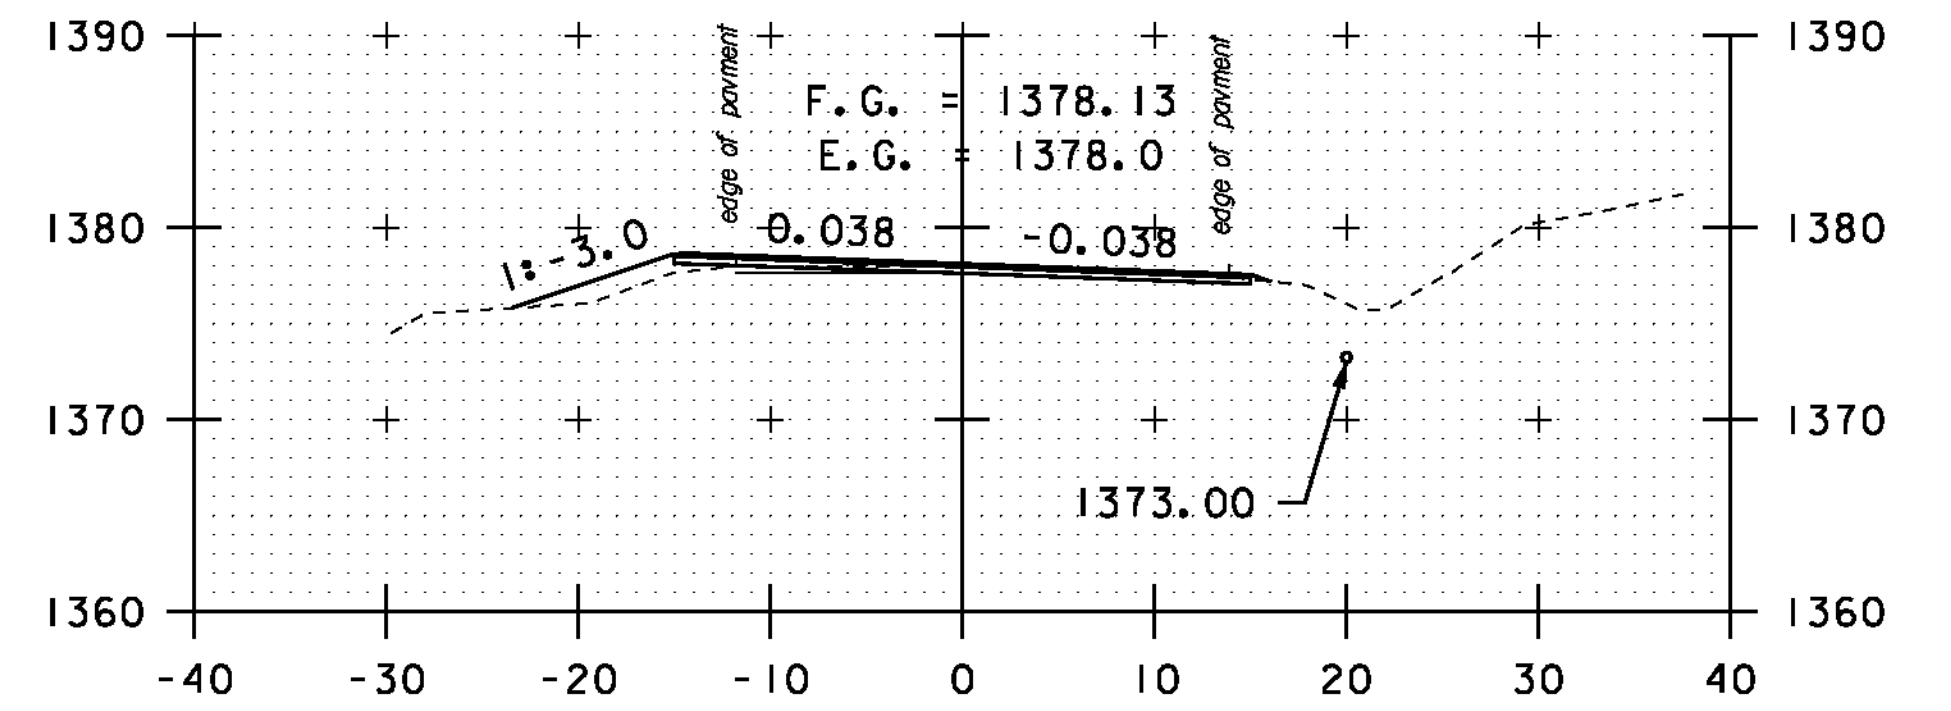


A 0+50

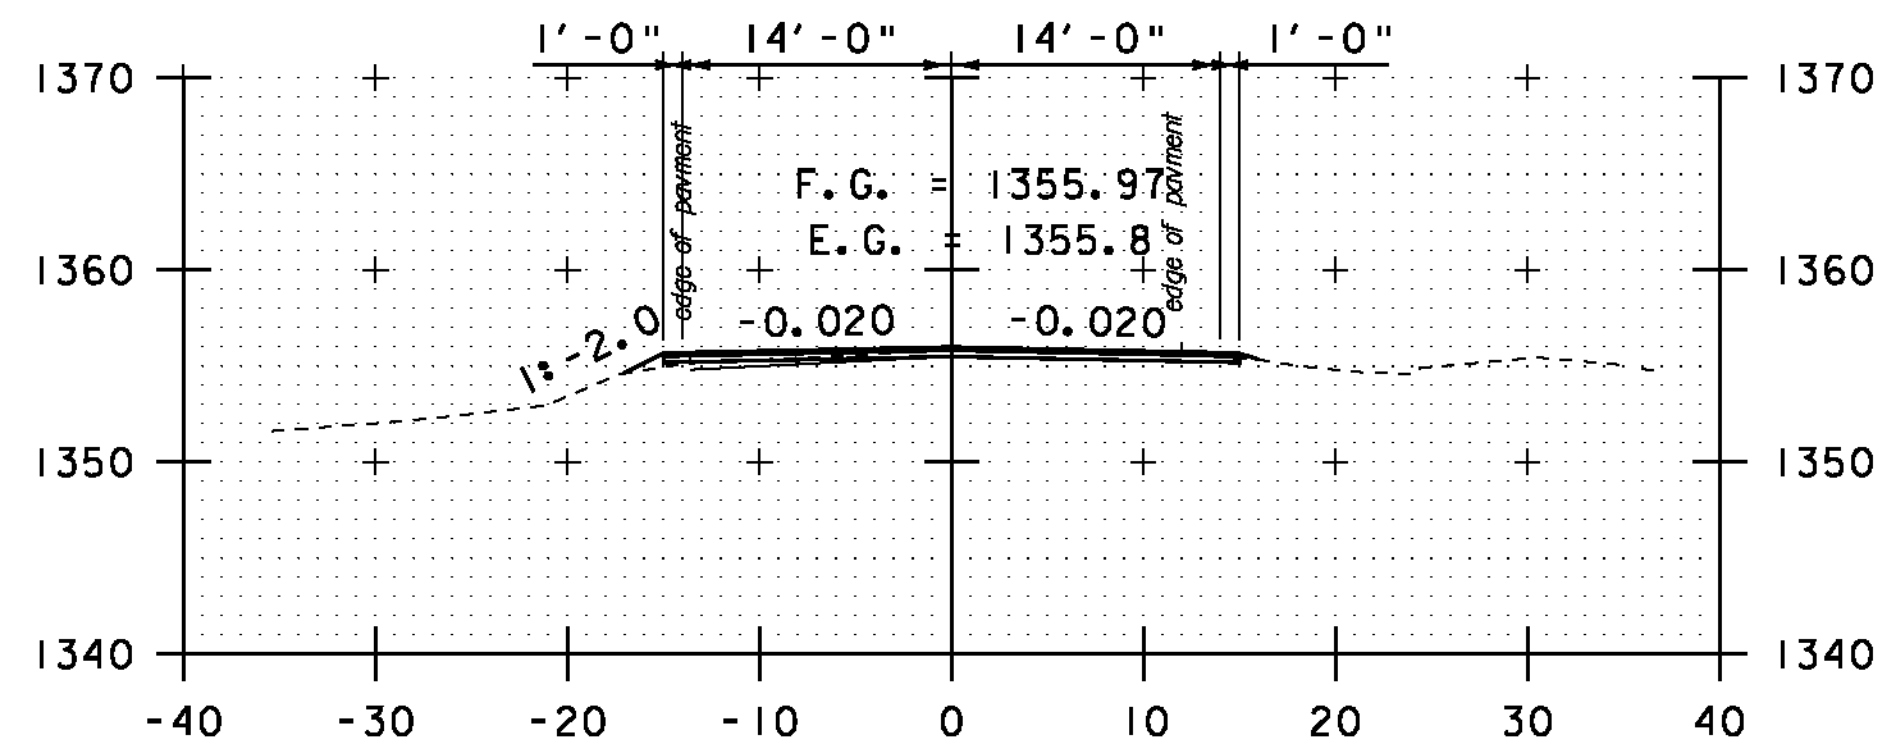


197+00

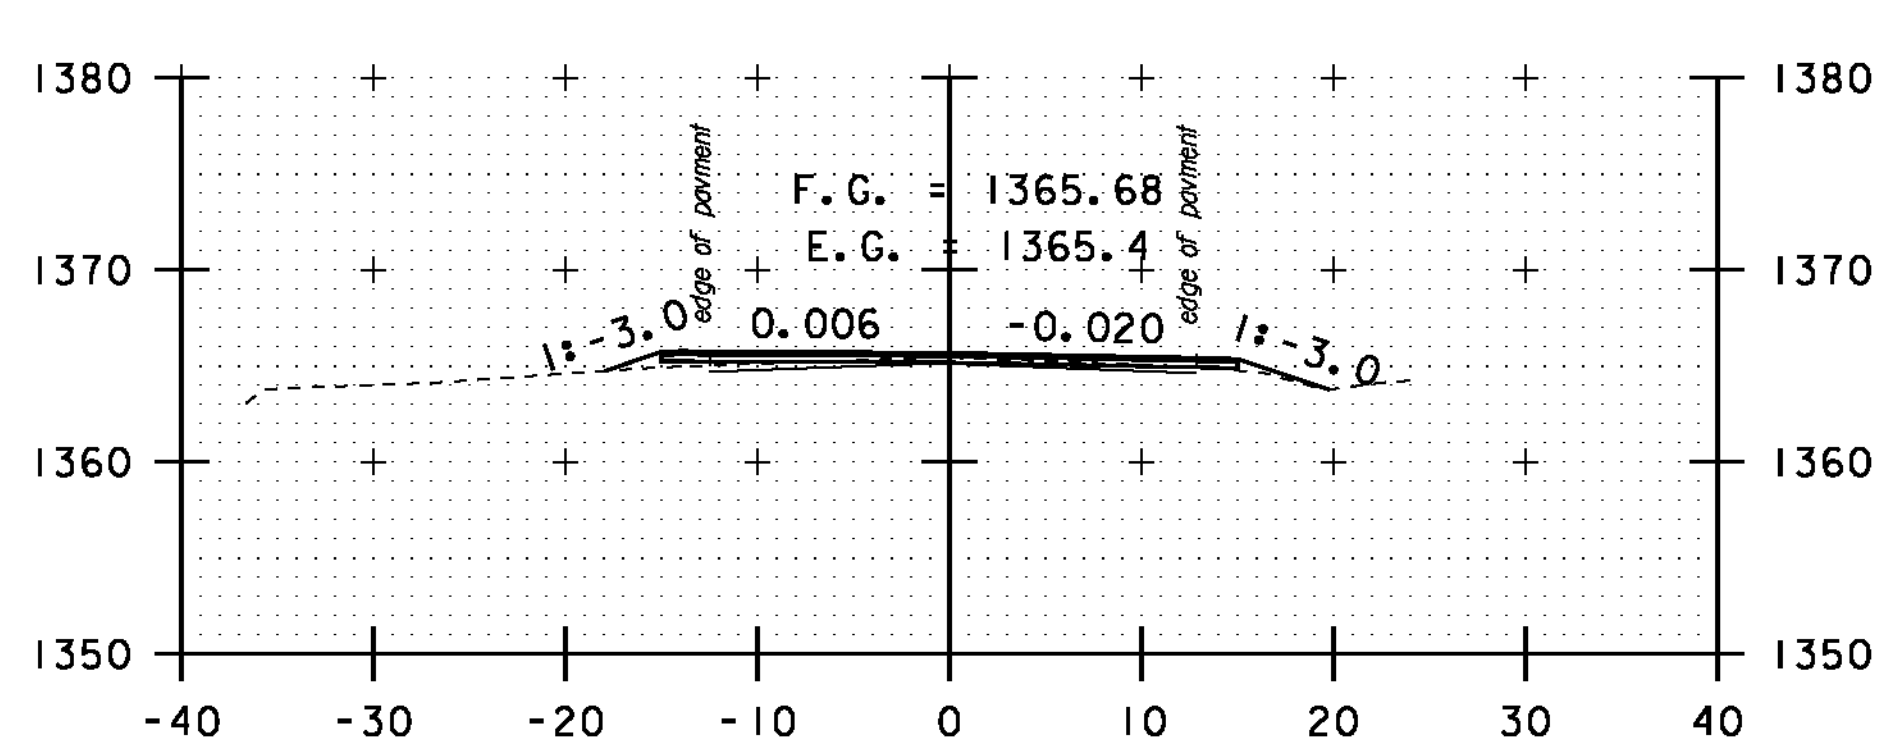


199+00

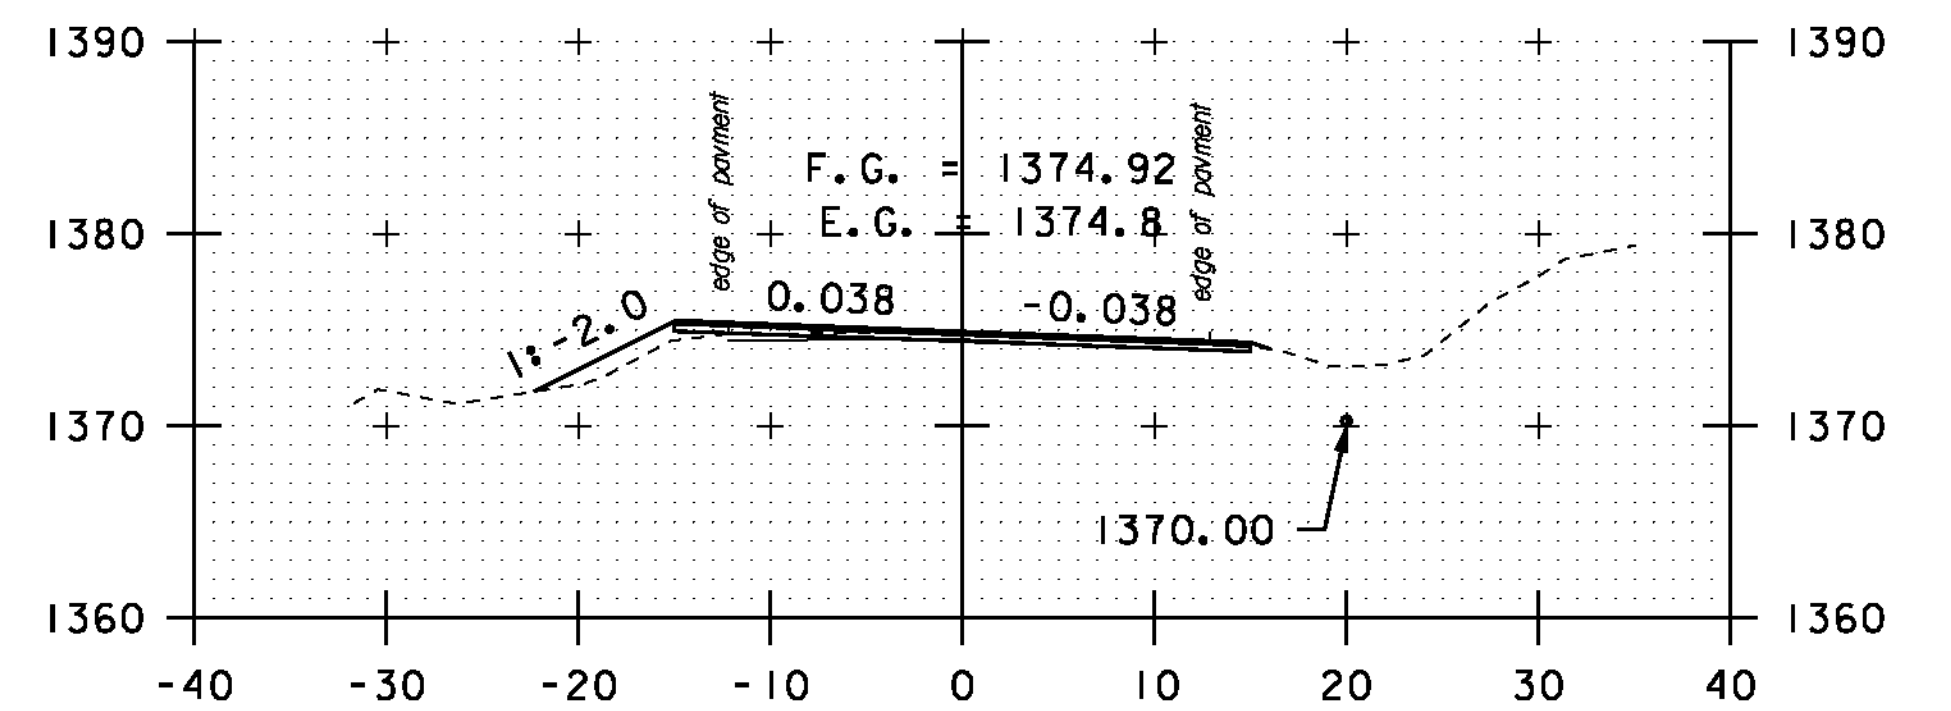


A 0+00

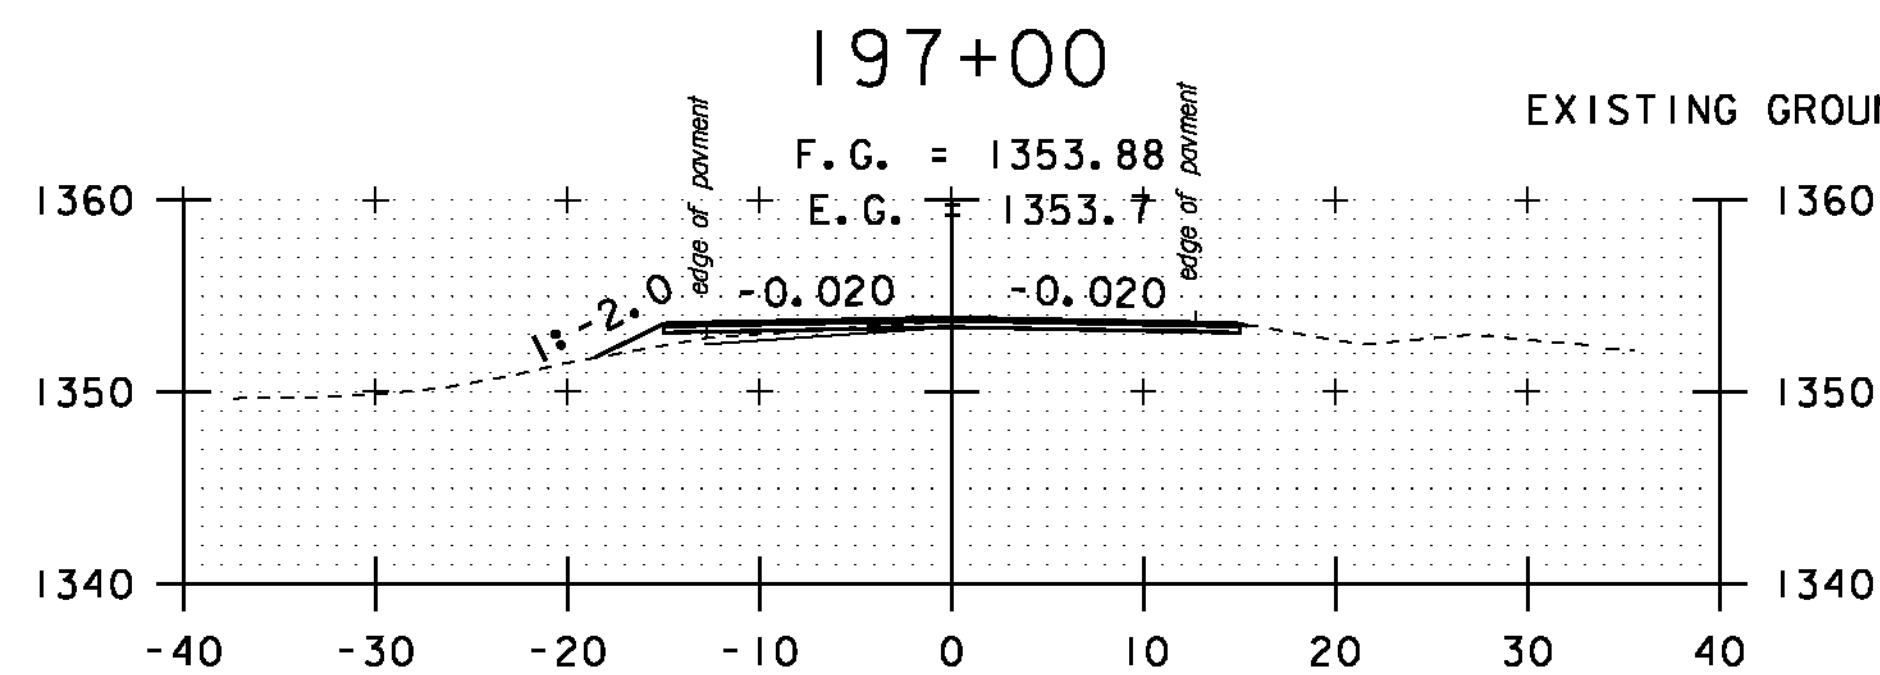


196+50

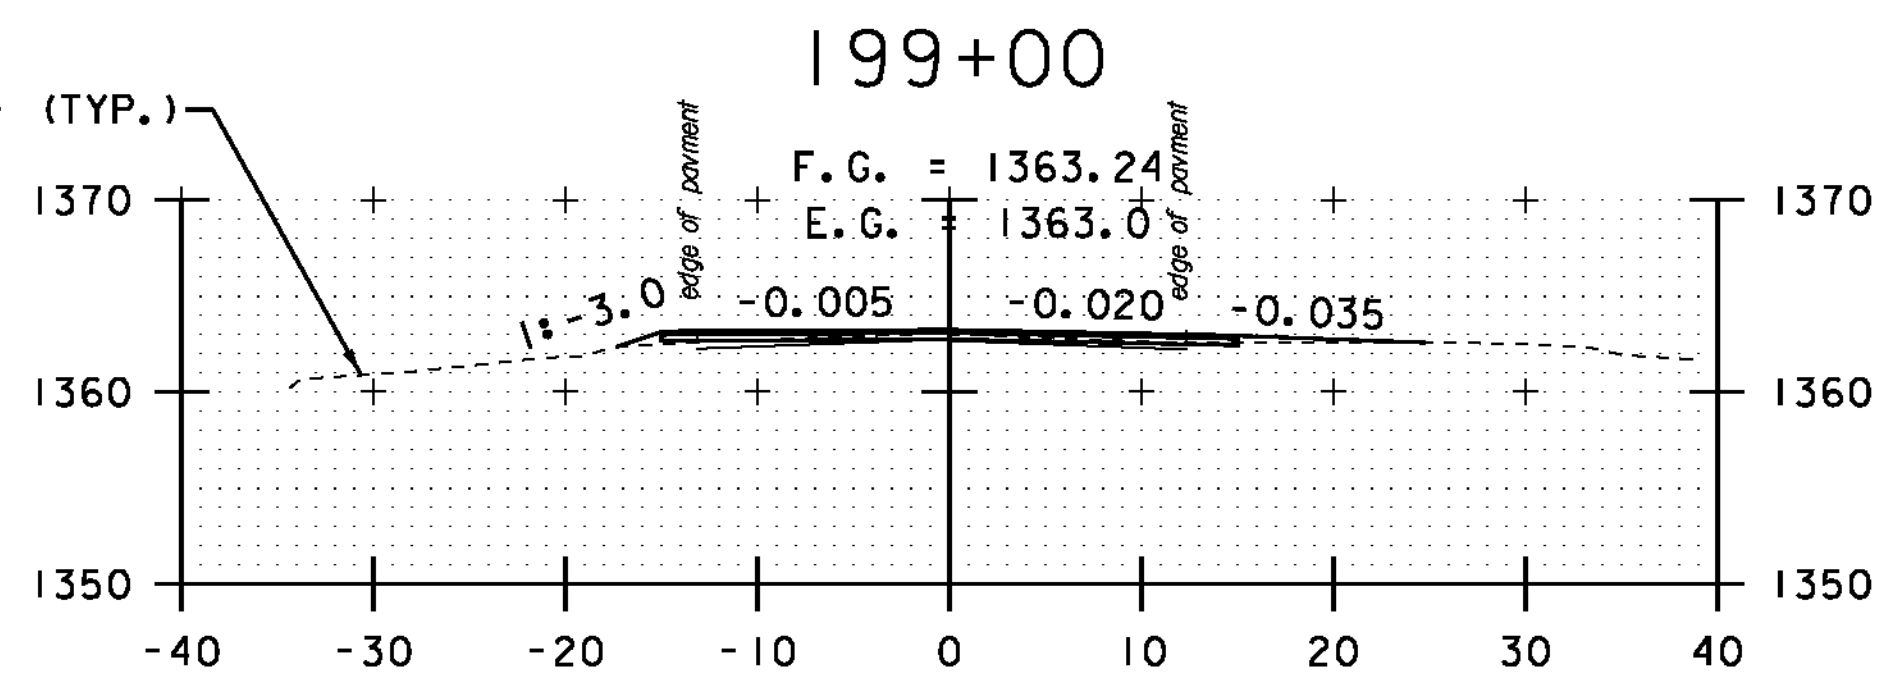


DRIVE RT
198+50

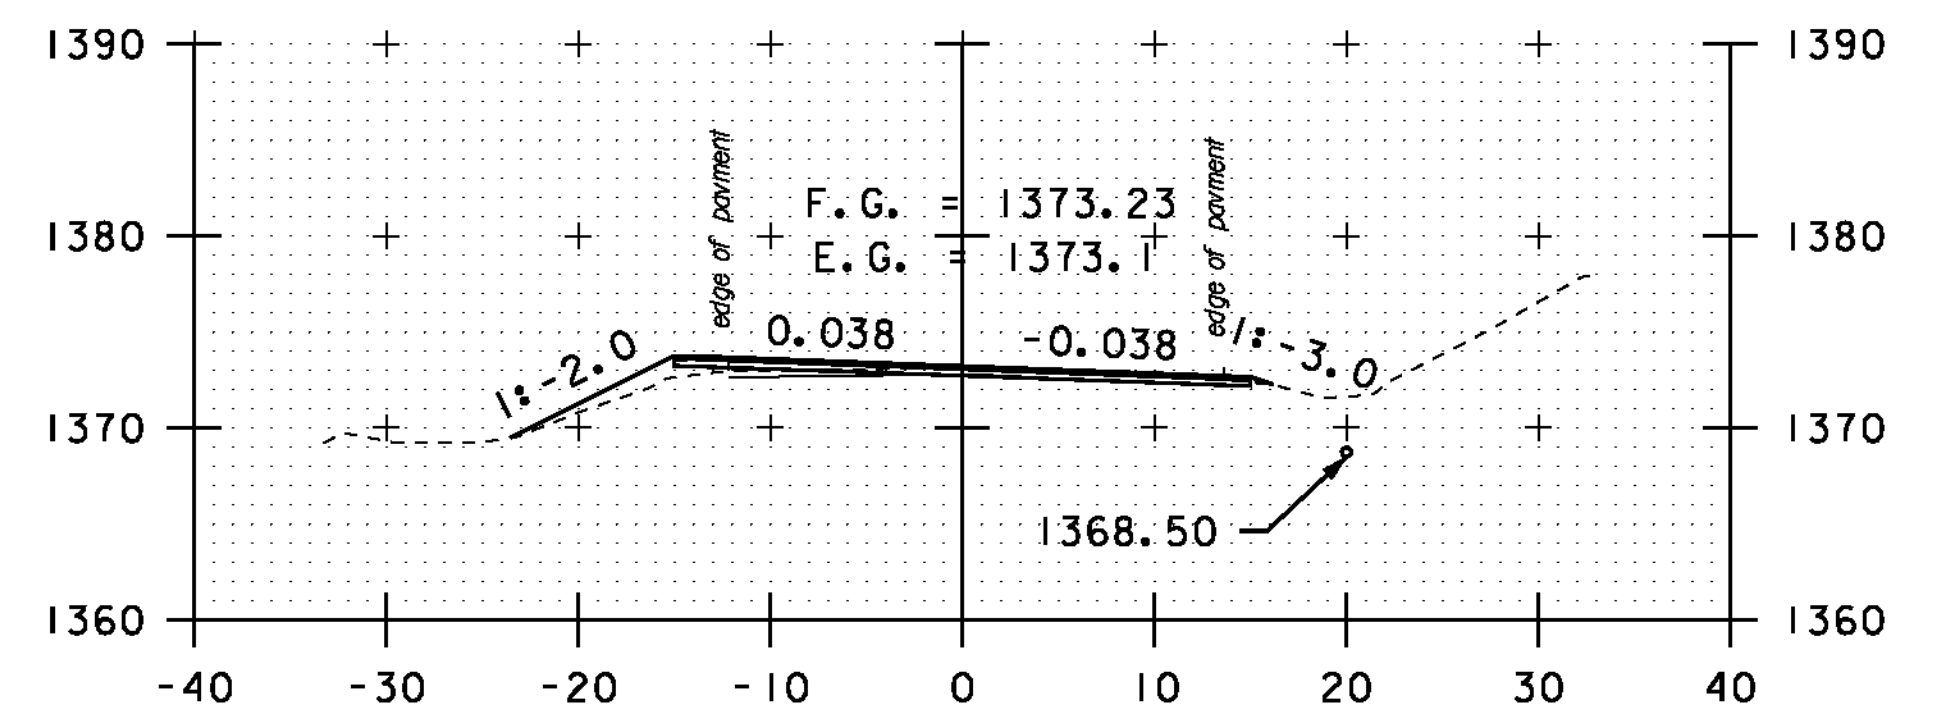


200+50

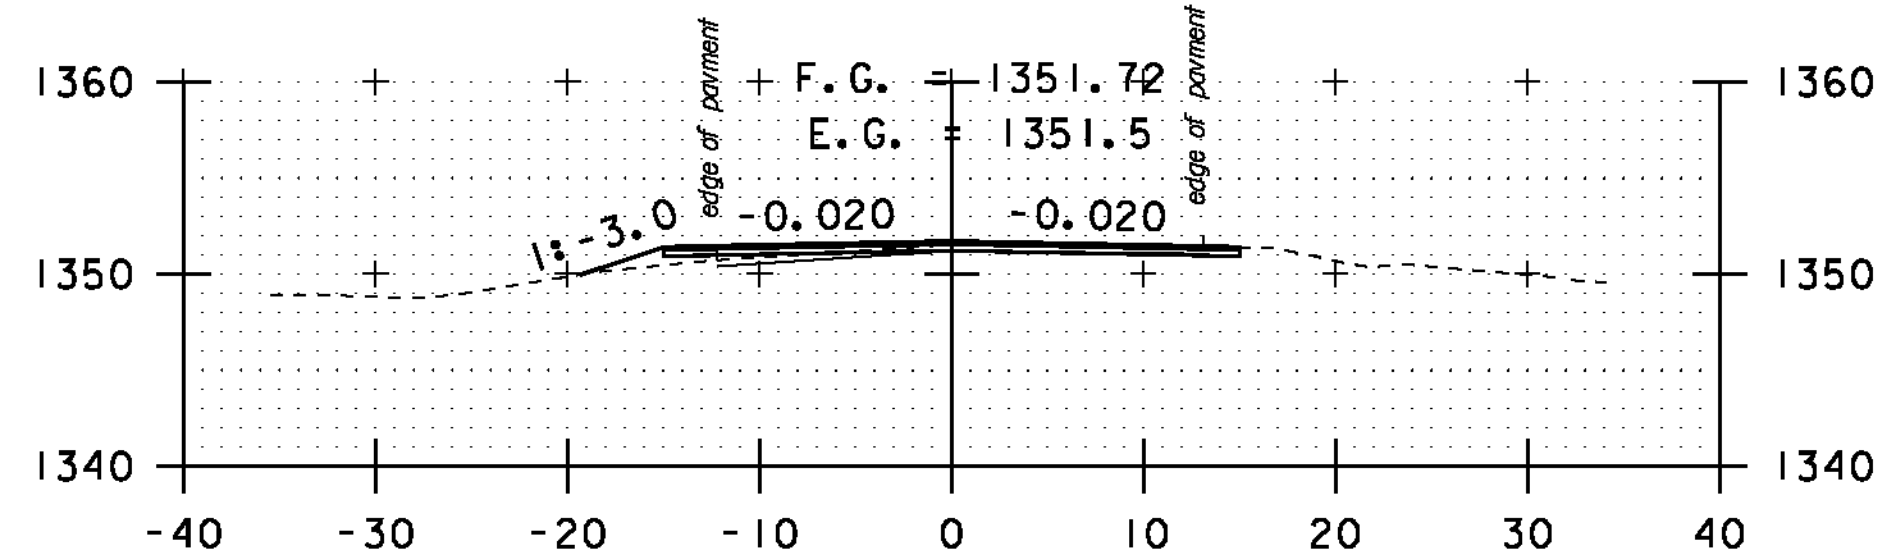

196+00

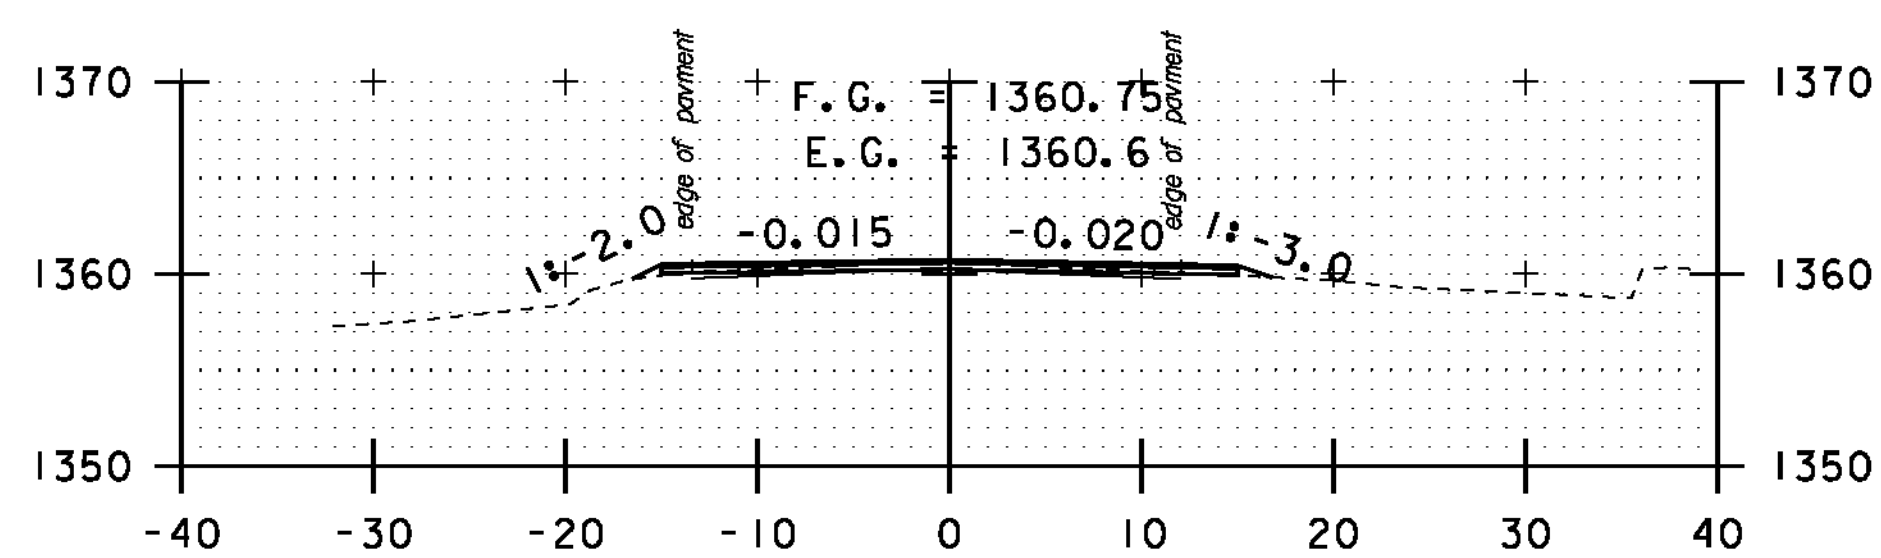

198+00

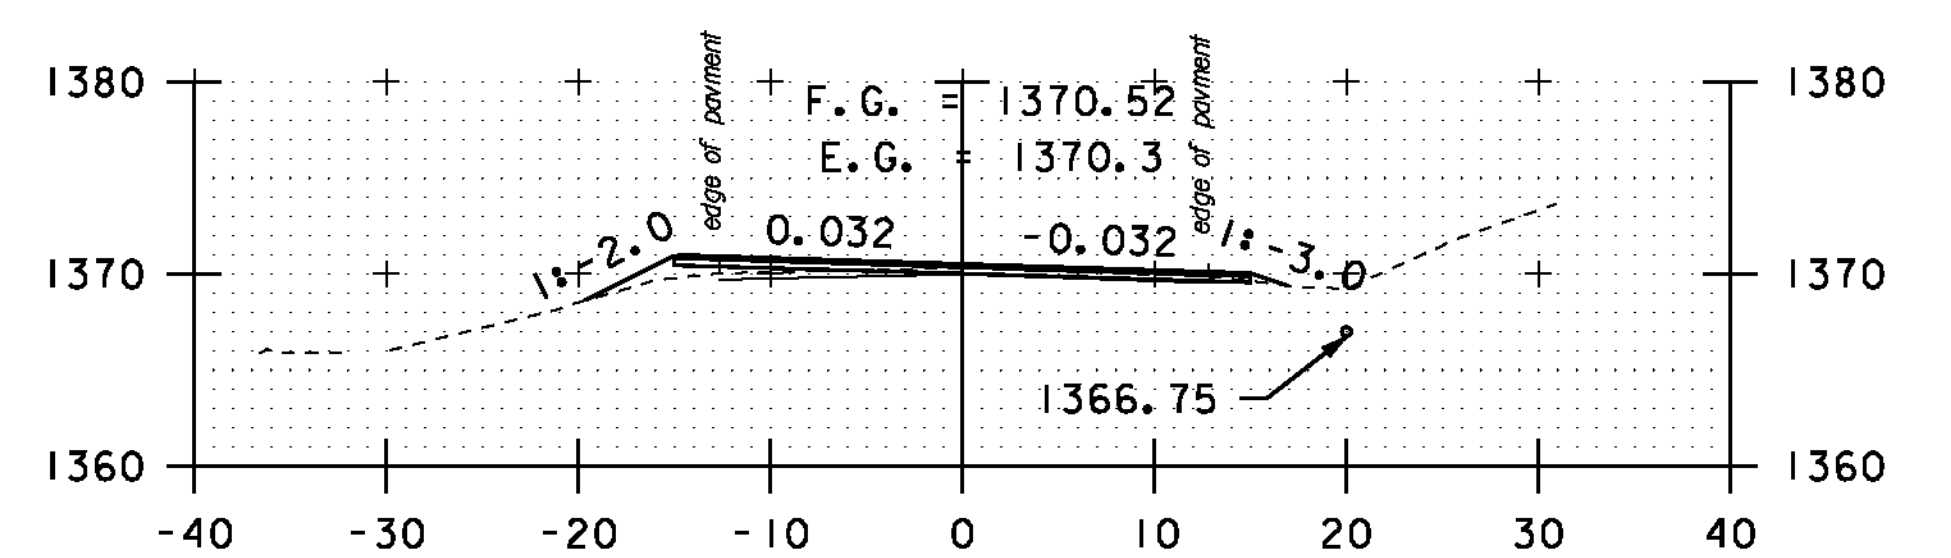

200+00

STA. 196+00 TO STA. A 0+50



CROSS SECTION SHEET 37

PROJECT NAME: MONTGOMERY-WESTFIELD
 PROJECT NUMBER: STP 2906(I)
 FILE NAME: p10ci90.dgn
 PROJECT LEADER: CDL
 DESIGNED BY: SJL
 PLOT FILE: p10ci90_151.I
 PLOT DATE: 9/5/12
 DRAWN BY: SJL
 CHECKED BY: CDL
 SHEET 151 OF 178