




A 2+50

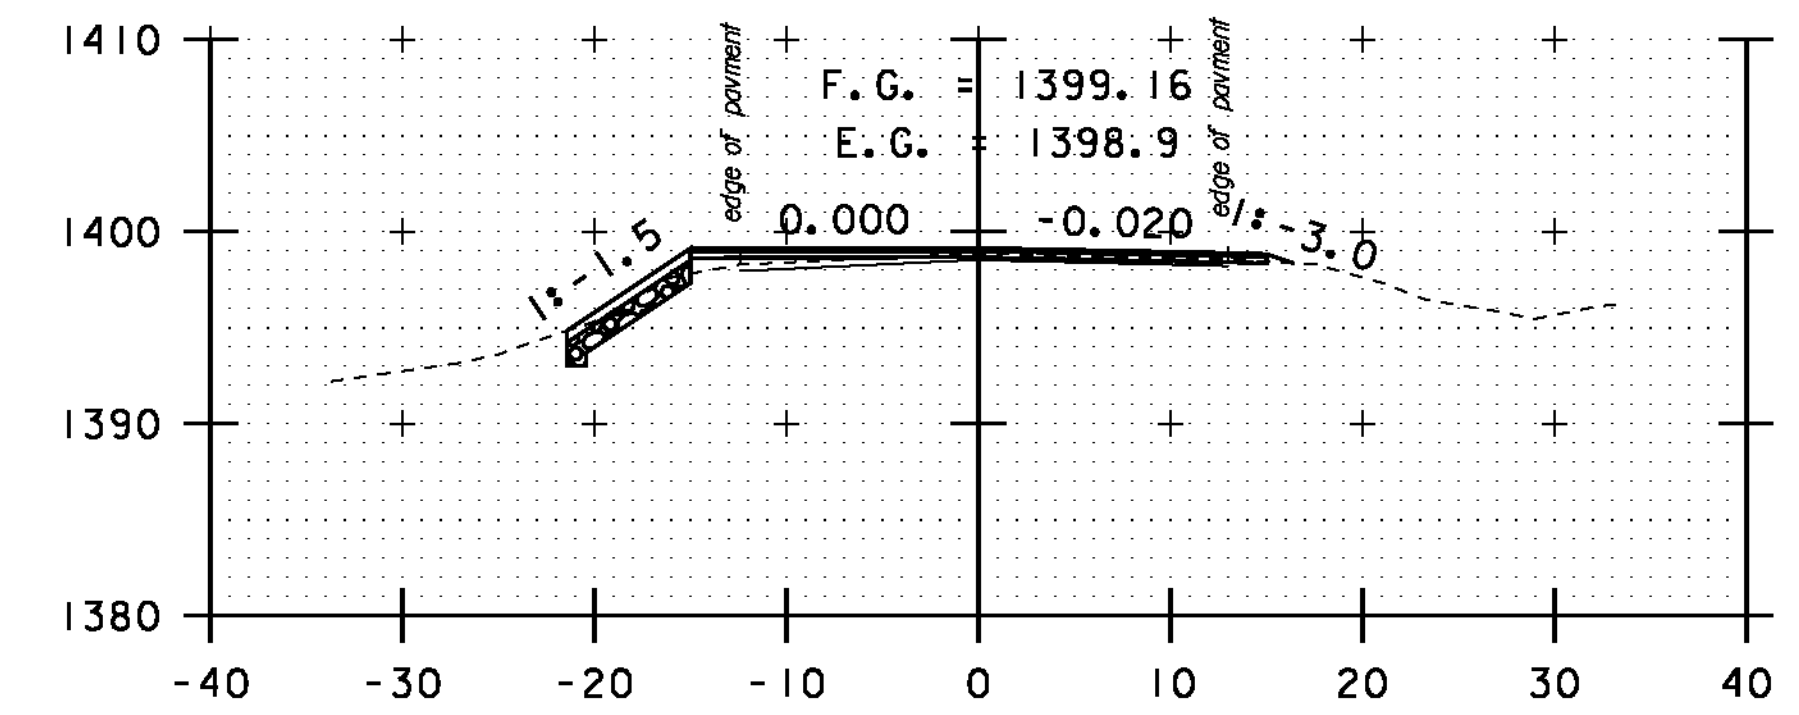


A 4+50

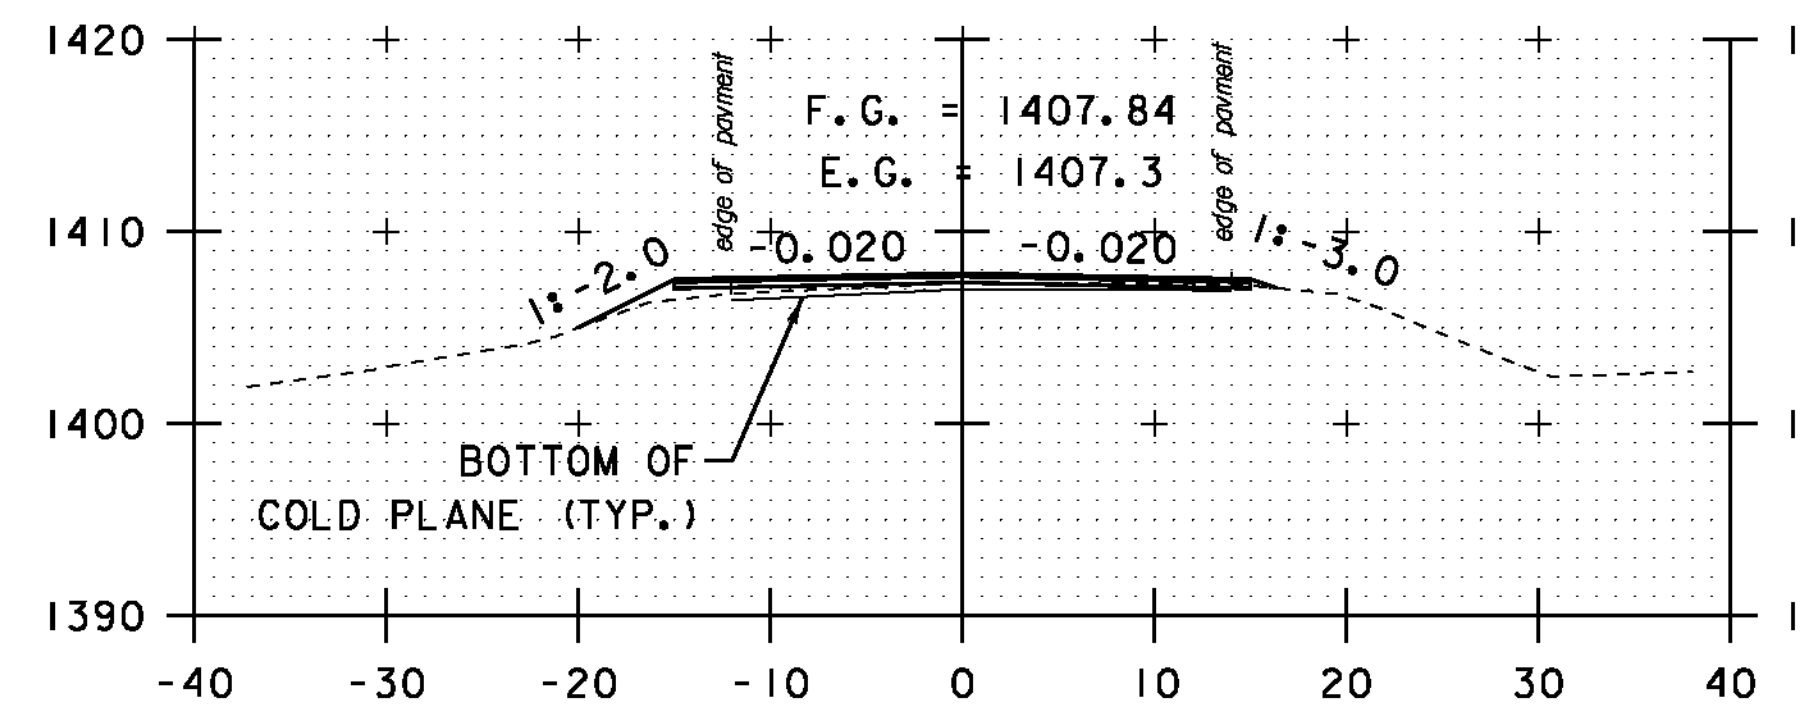


A 6+50

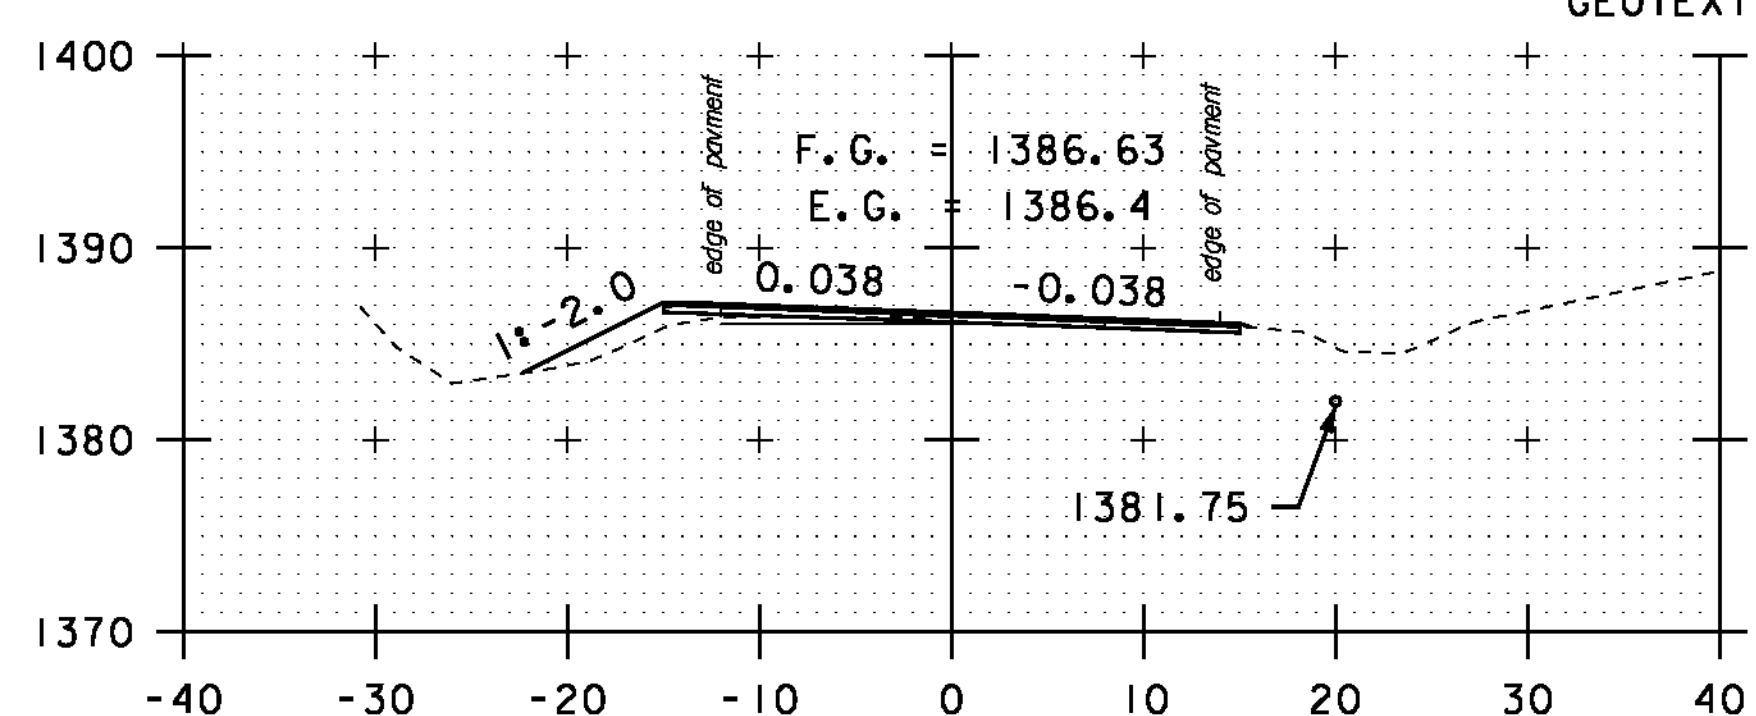


A 2+00

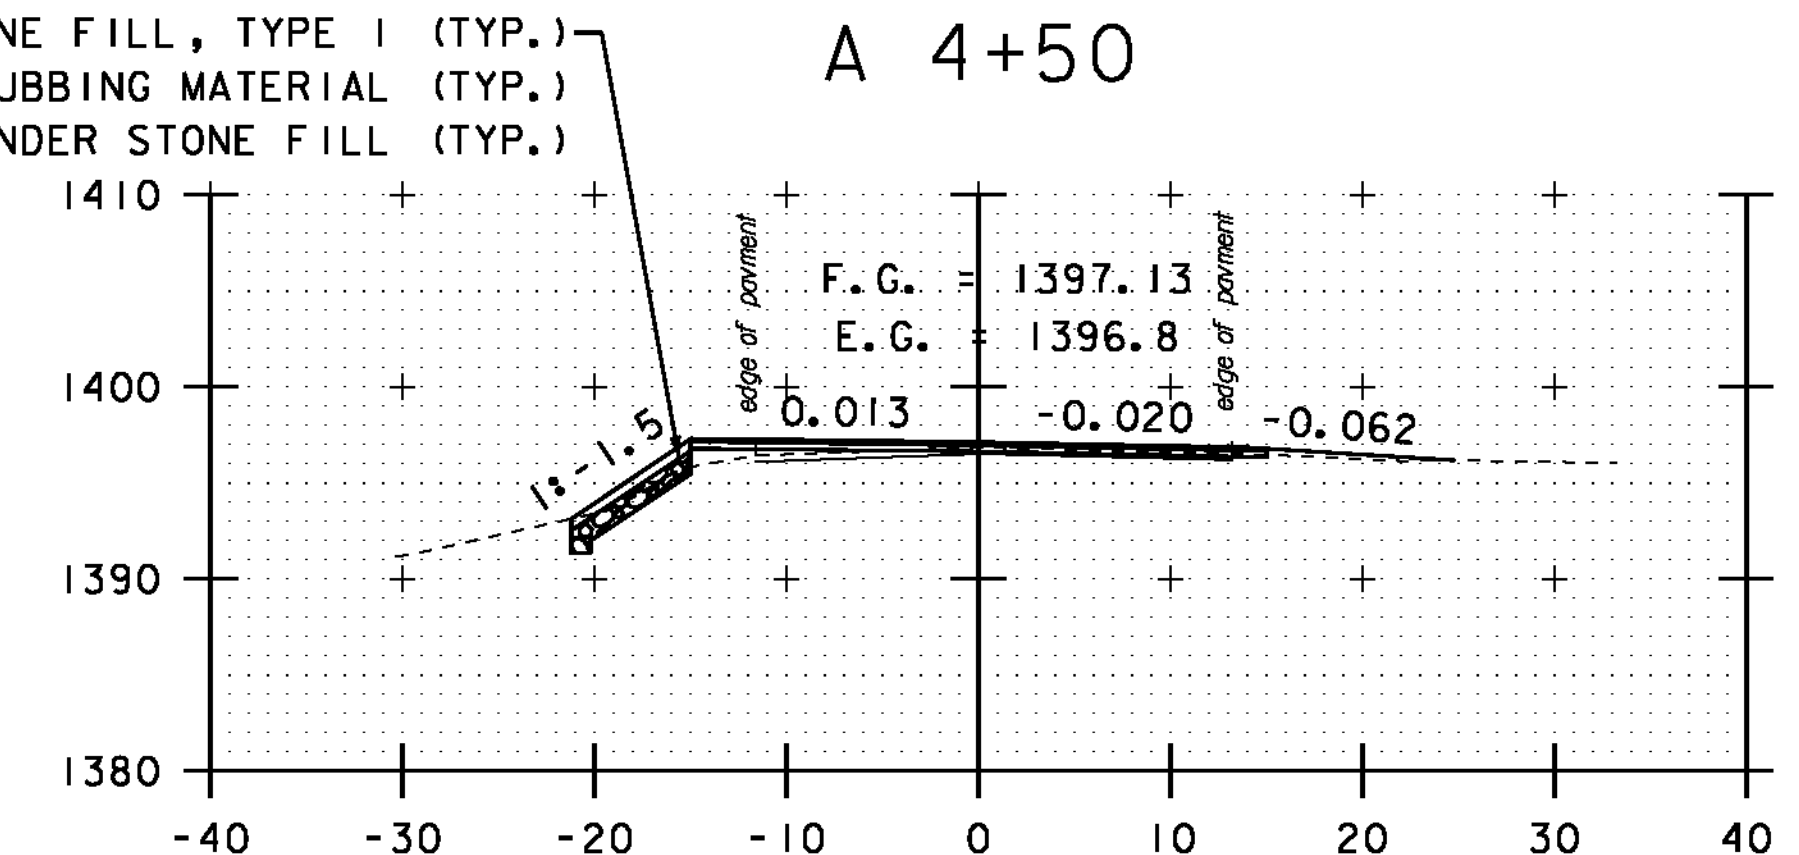


A 4+00

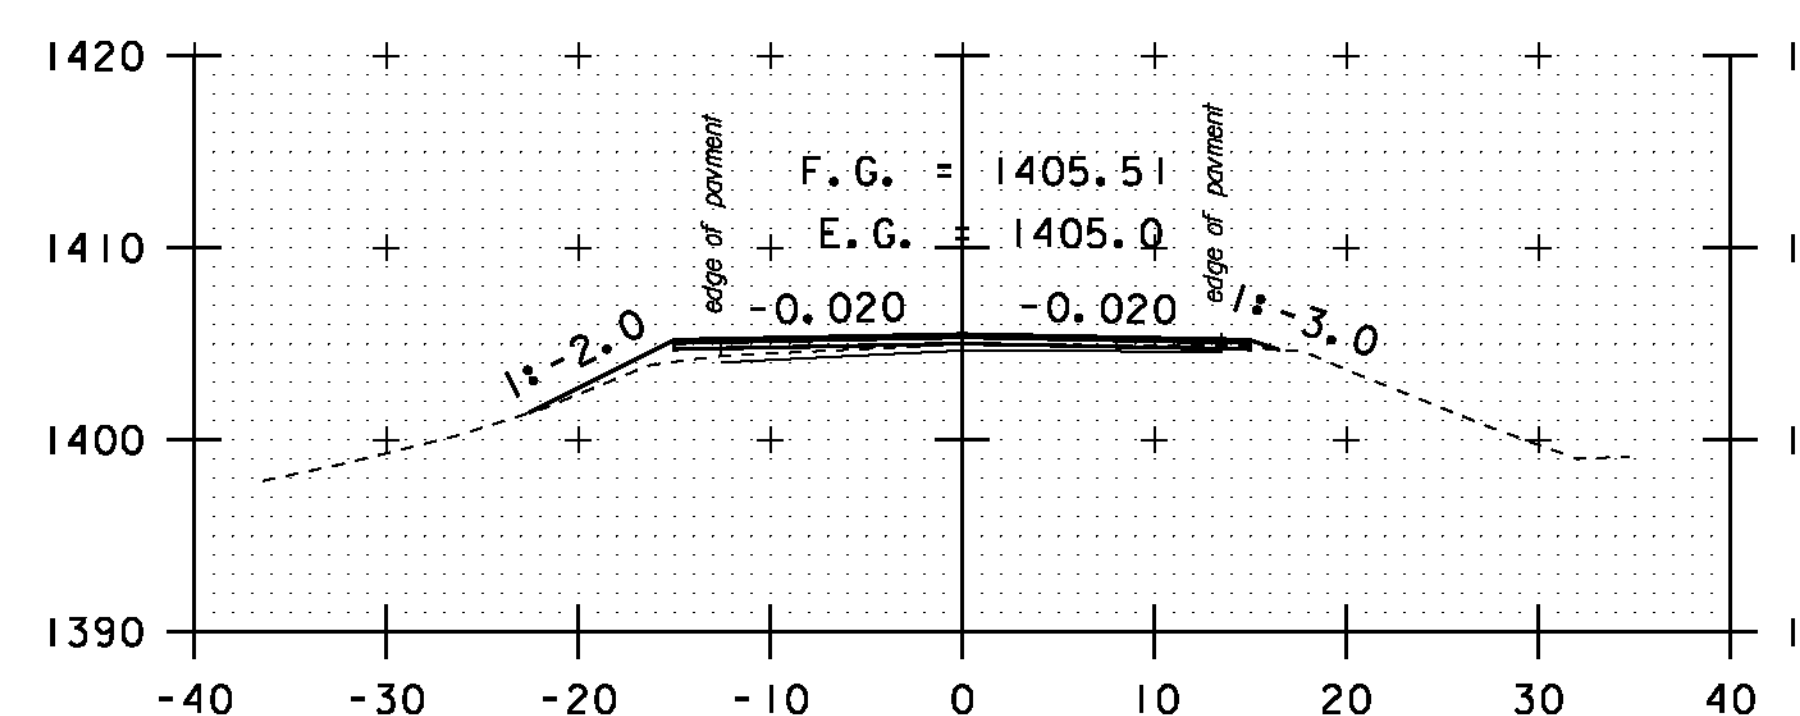


A 6+00

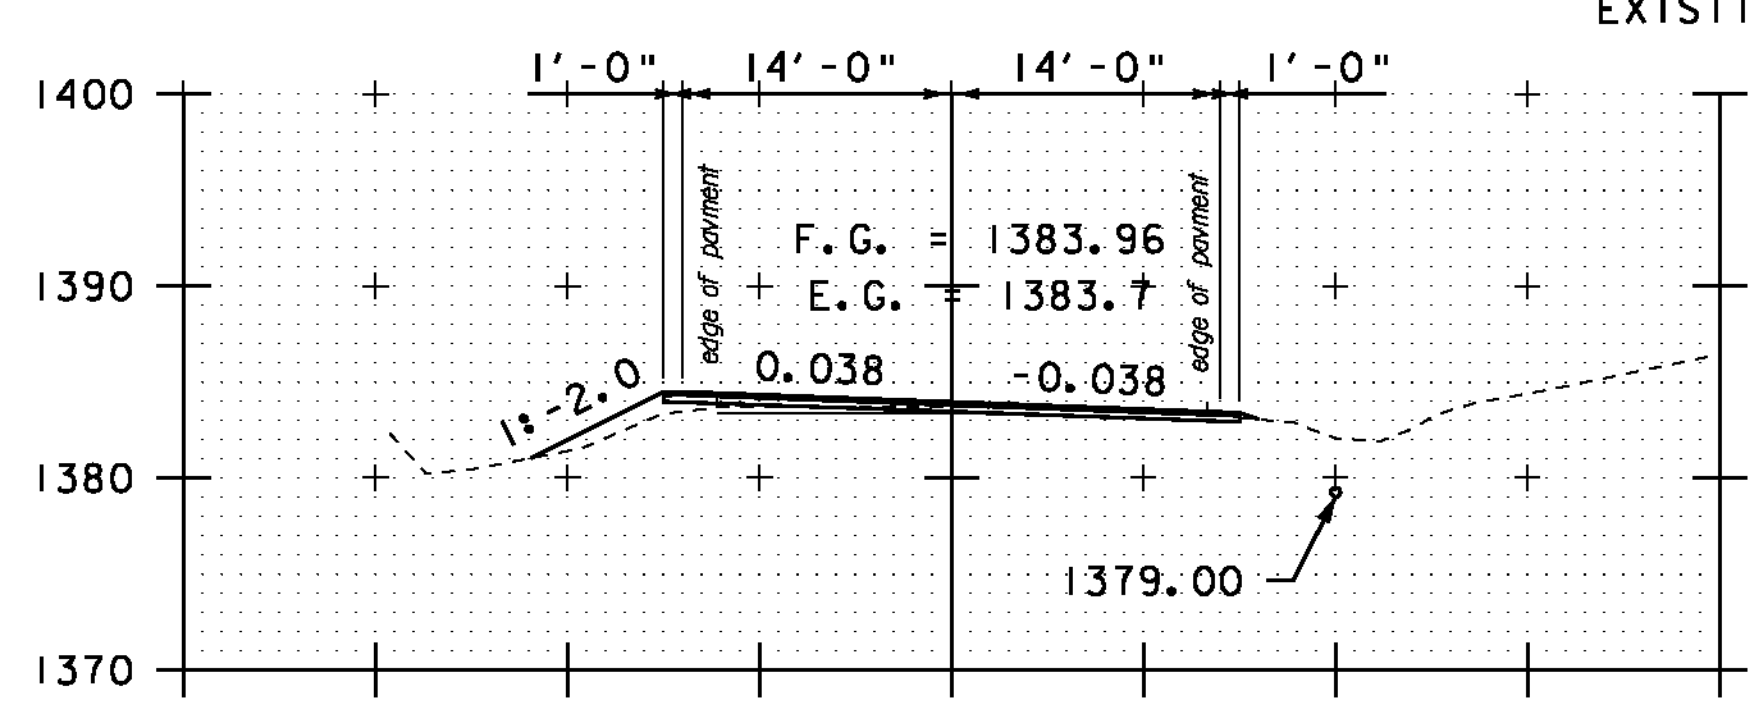


A 1+50

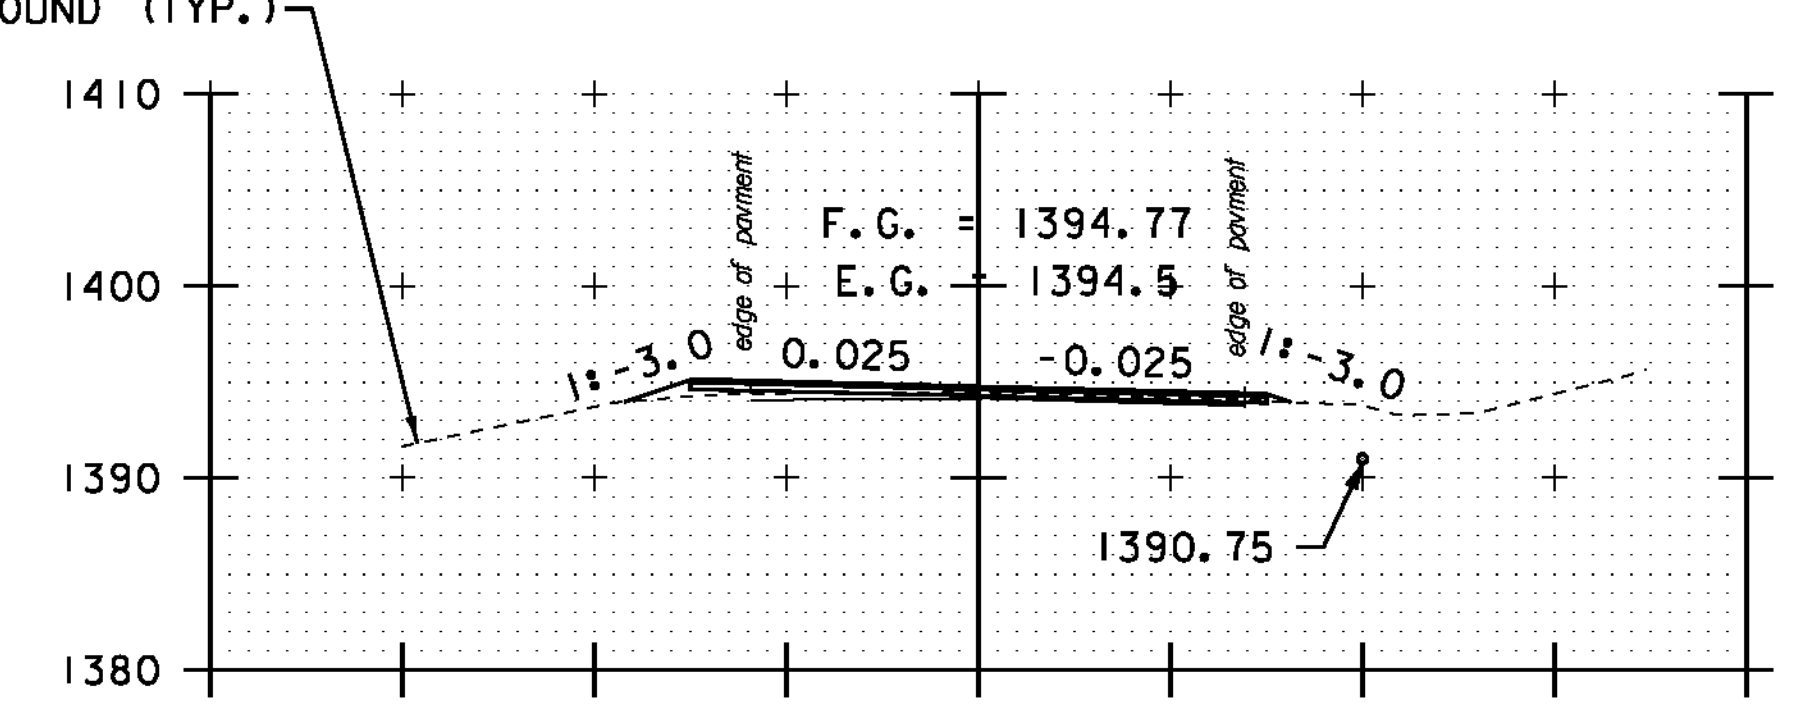


A 3+50

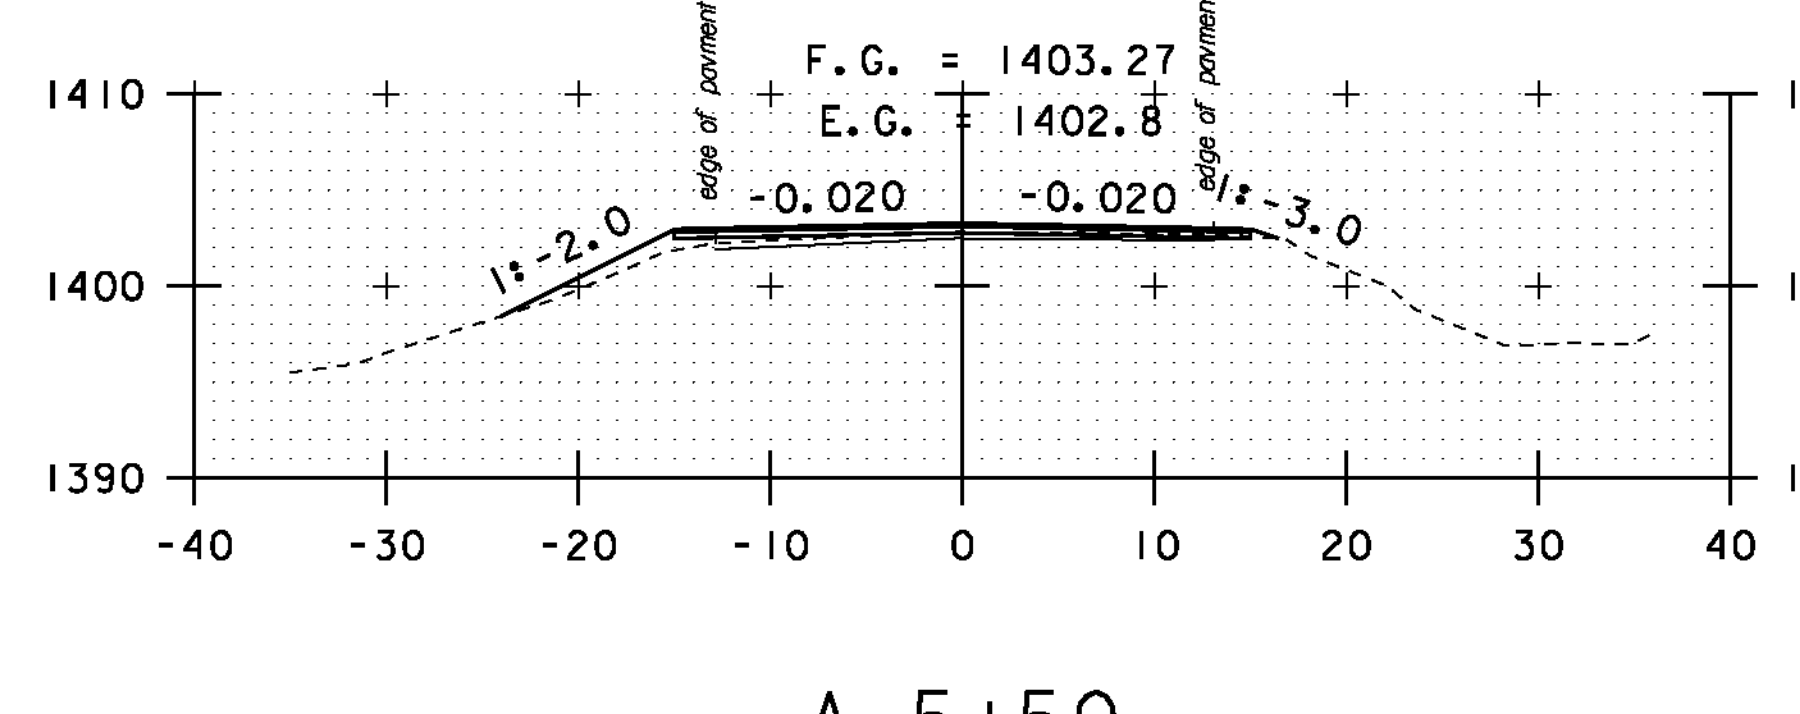


A 5+50

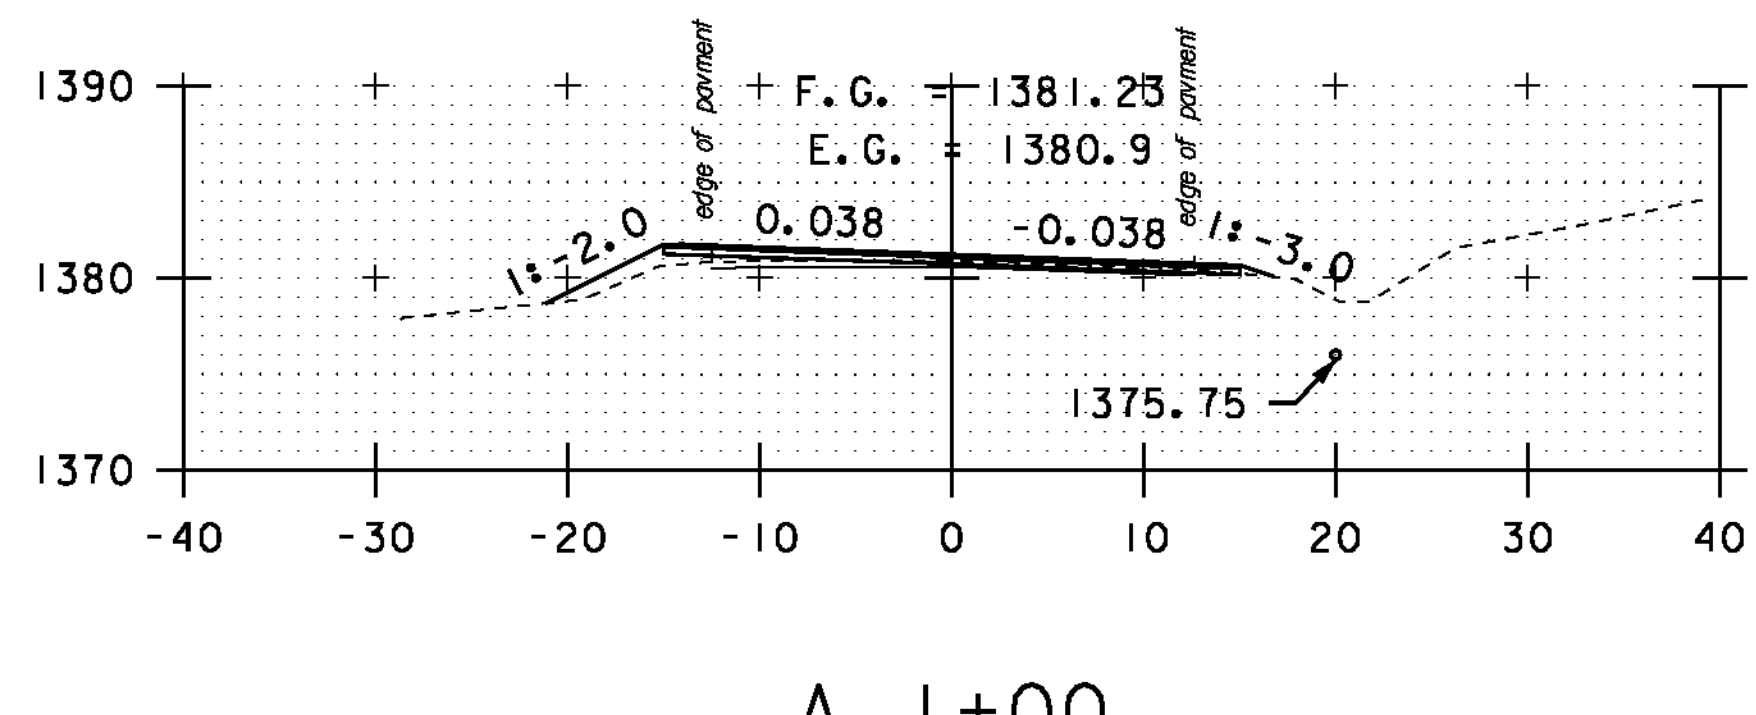

A 1+00

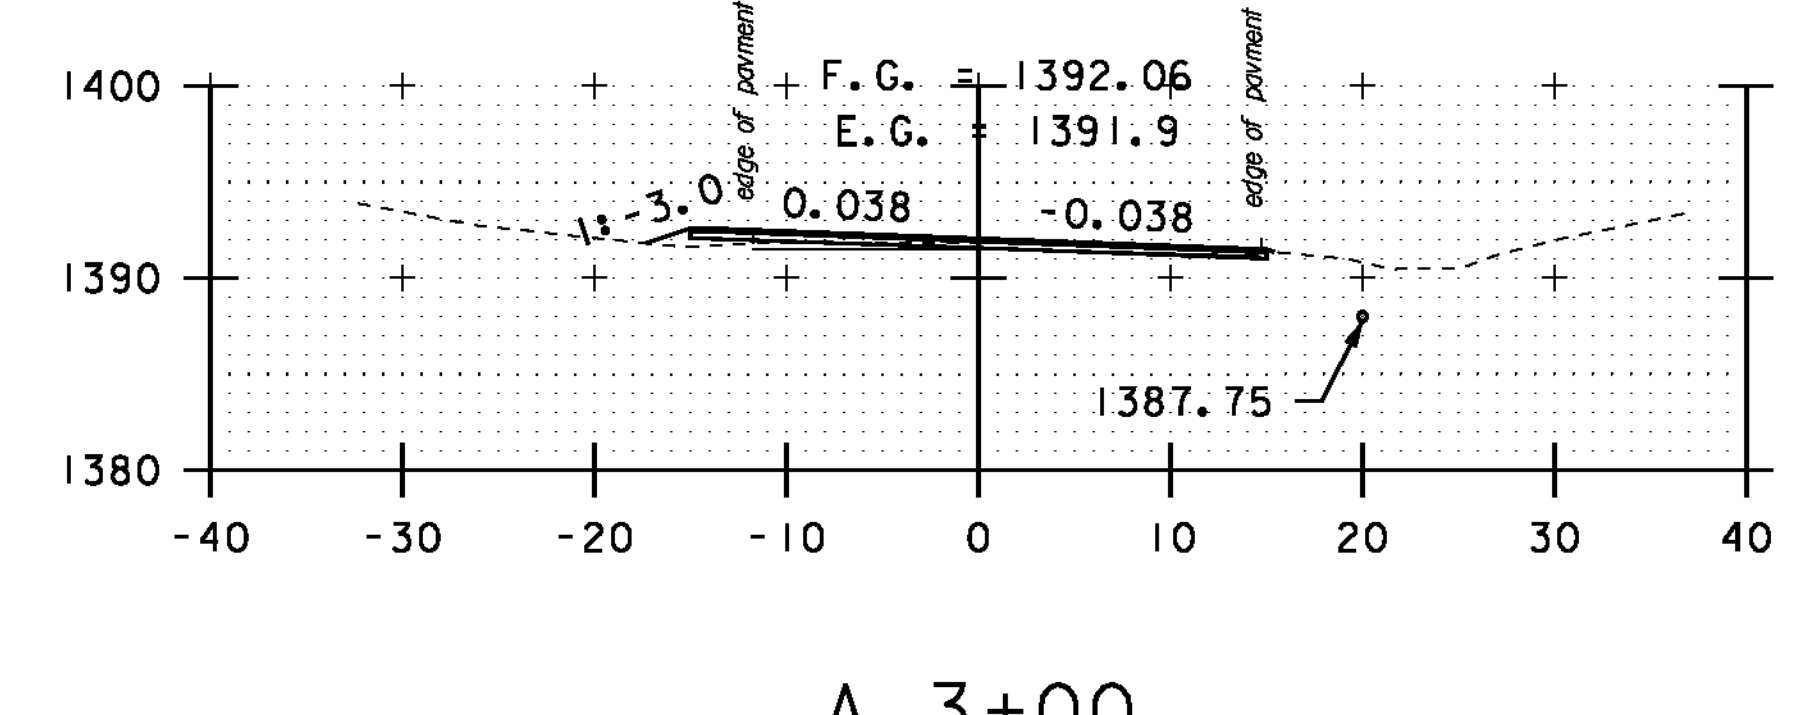


A 3+00

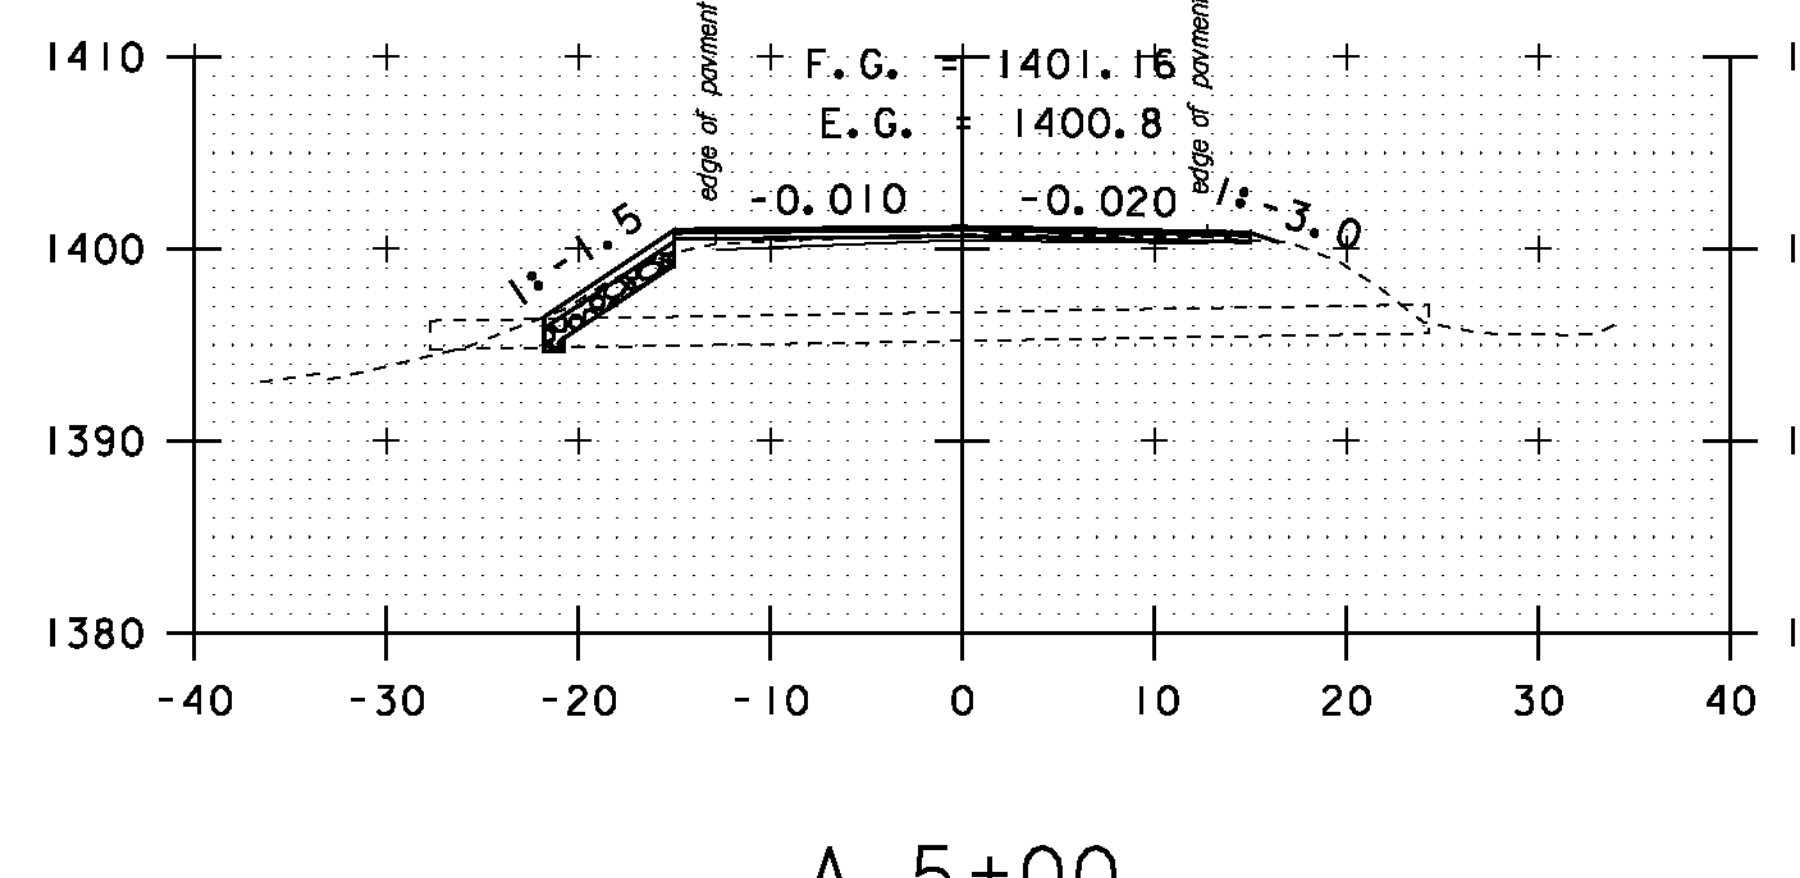

A 5+00

STA. A 1+00 TO STA. A 6+50

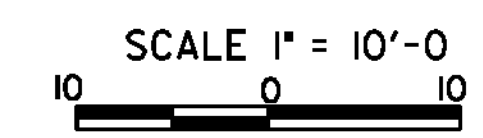

CROSS SECTION SHEET 38

PROJECT NAME:	MONTGOMERY-WESTFIELD
PROJECT NUMBER:	STP 2906(I)
FILE NAME:	p10ci90.dgn
PROJECT LEADER:	CDL
DESIGNED BY:	SJL
PLOT FILE:	p10ci90_152.j
PLOT DATE:	9/5/12
DRAWN BY:	SJL
CHECKED BY:	CDL
SHEET	152 OF 178