




A 14+00

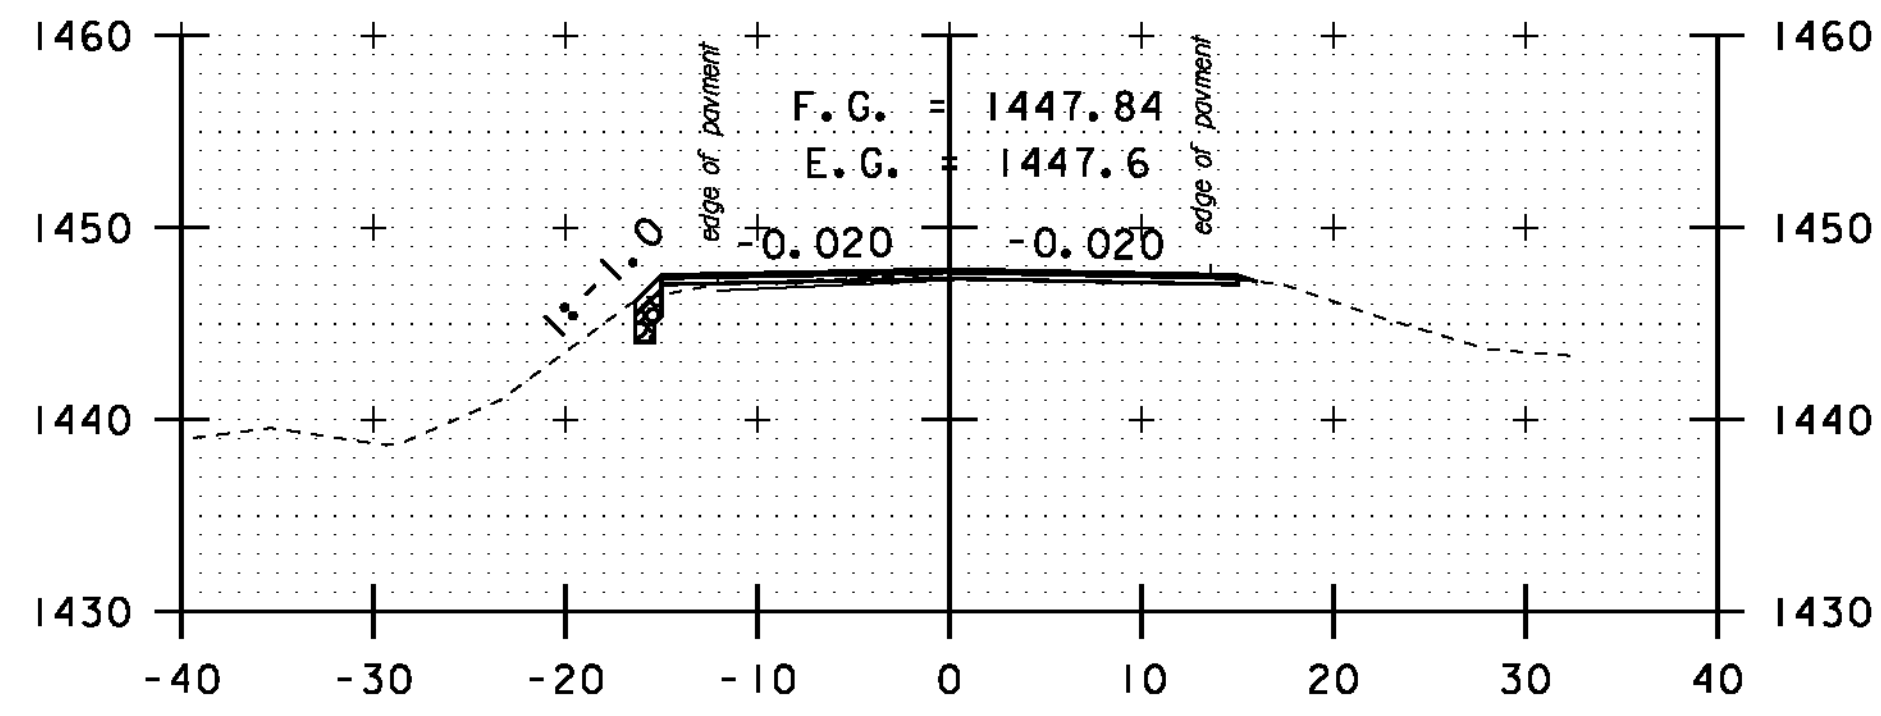


A 16+00

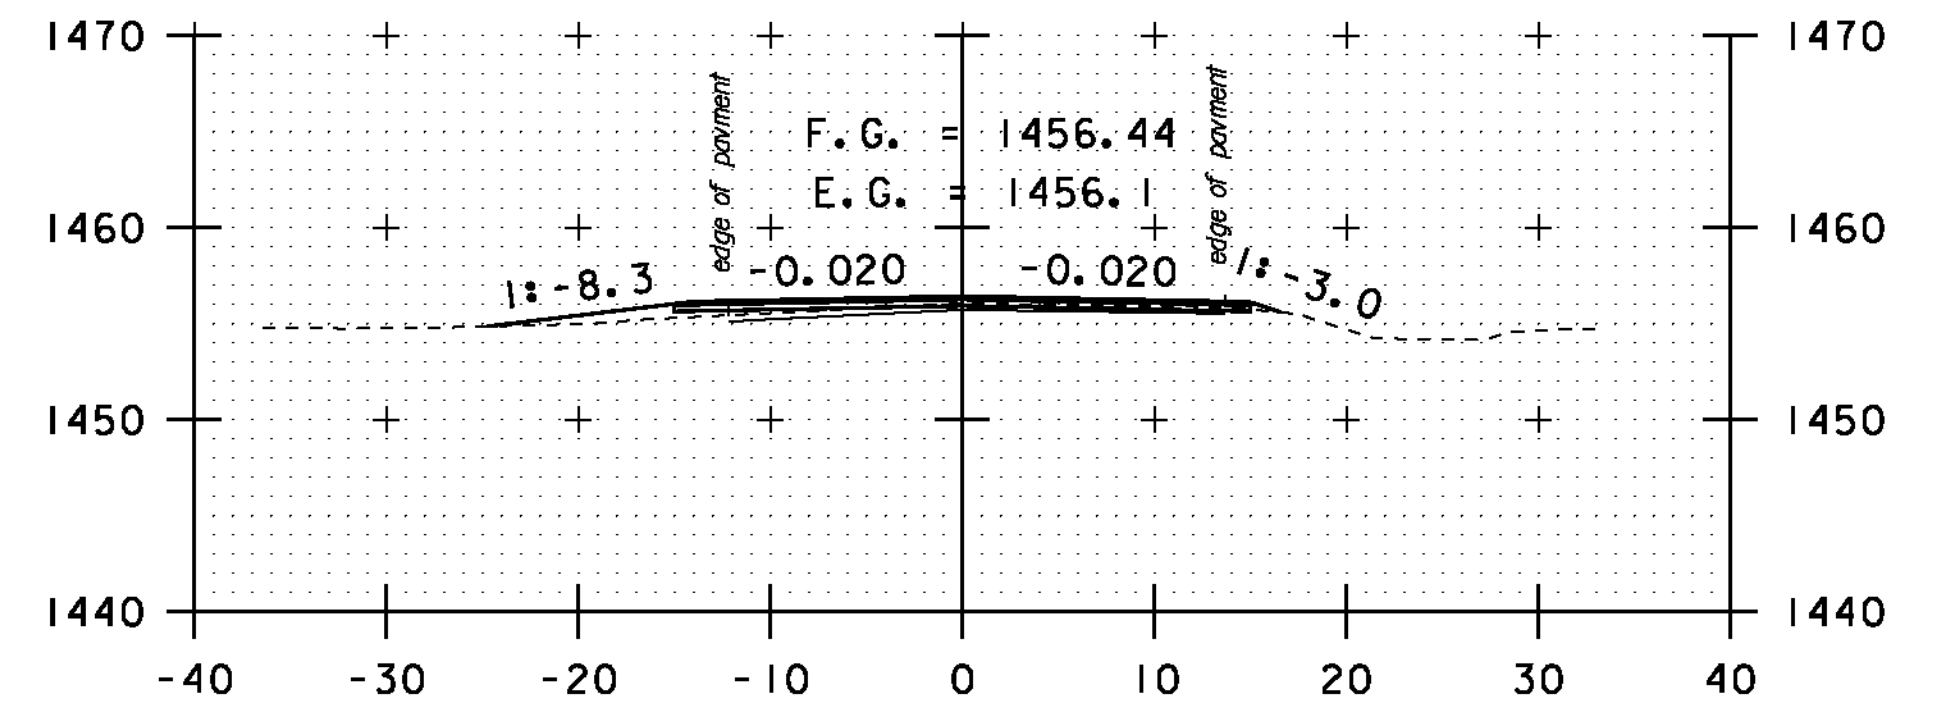


DRIVE LT
A 17+81

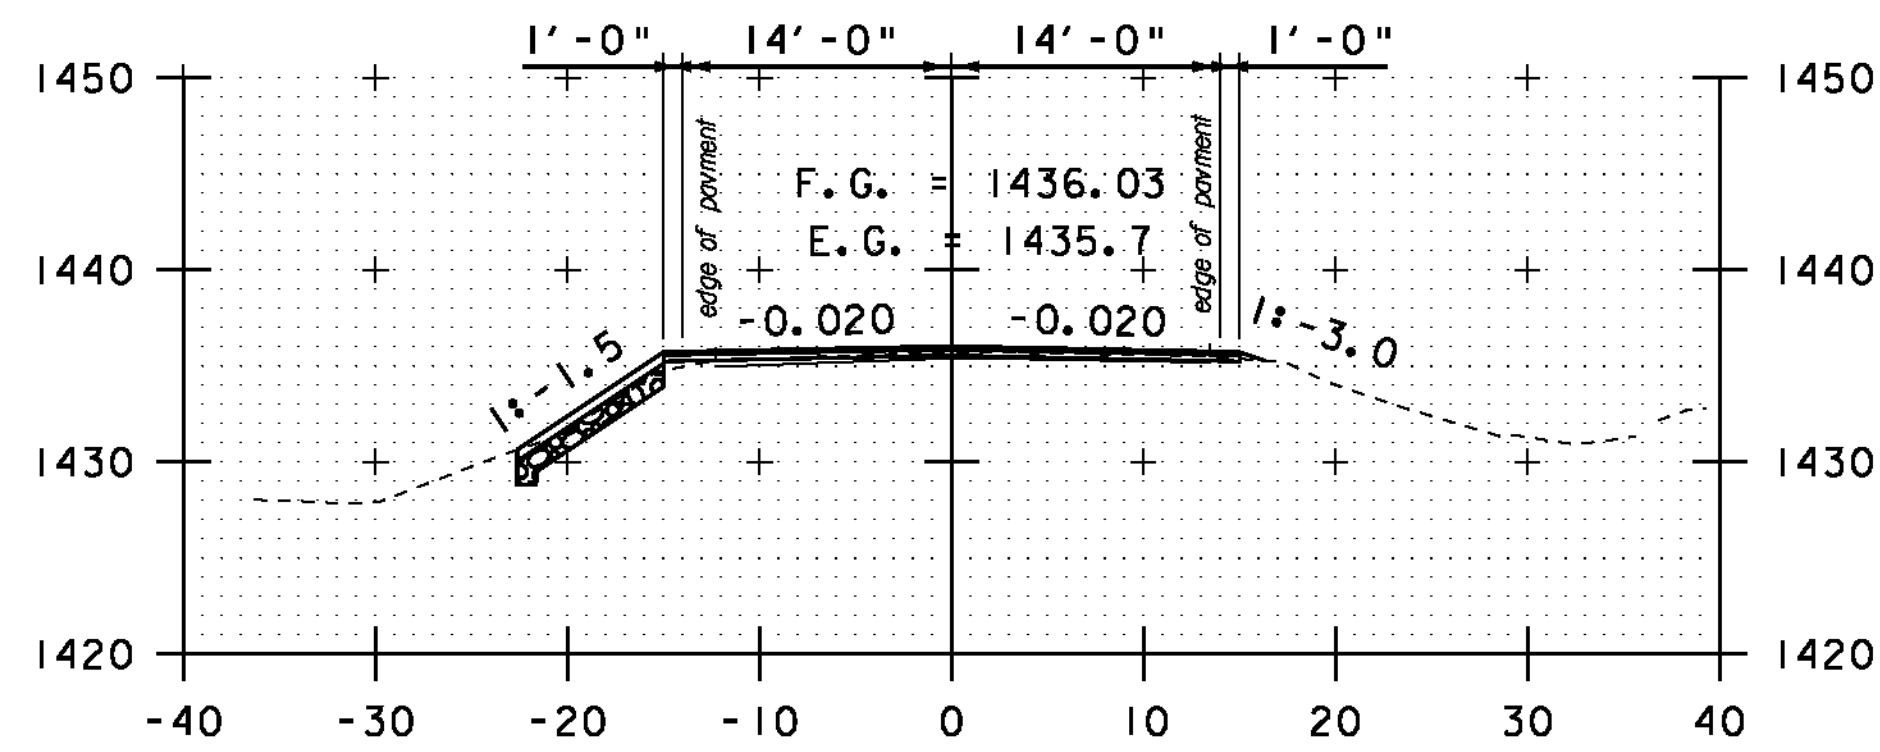


A 13+50

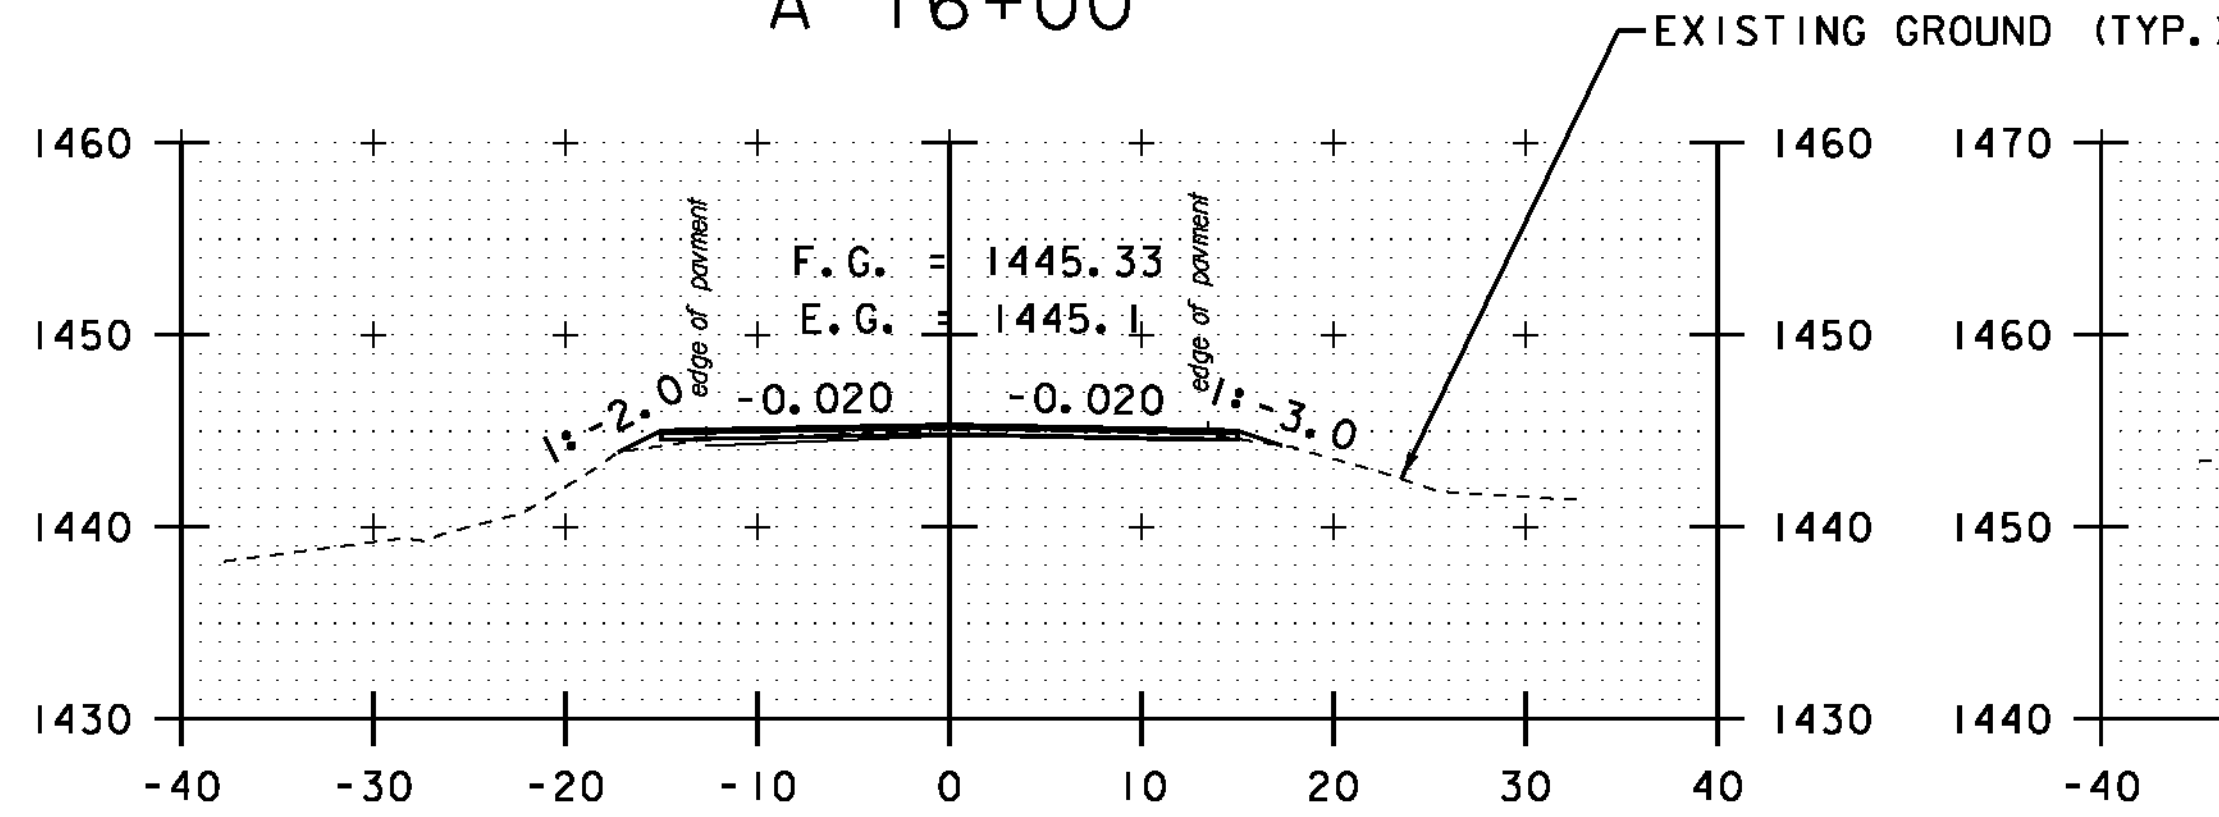


A 15+50

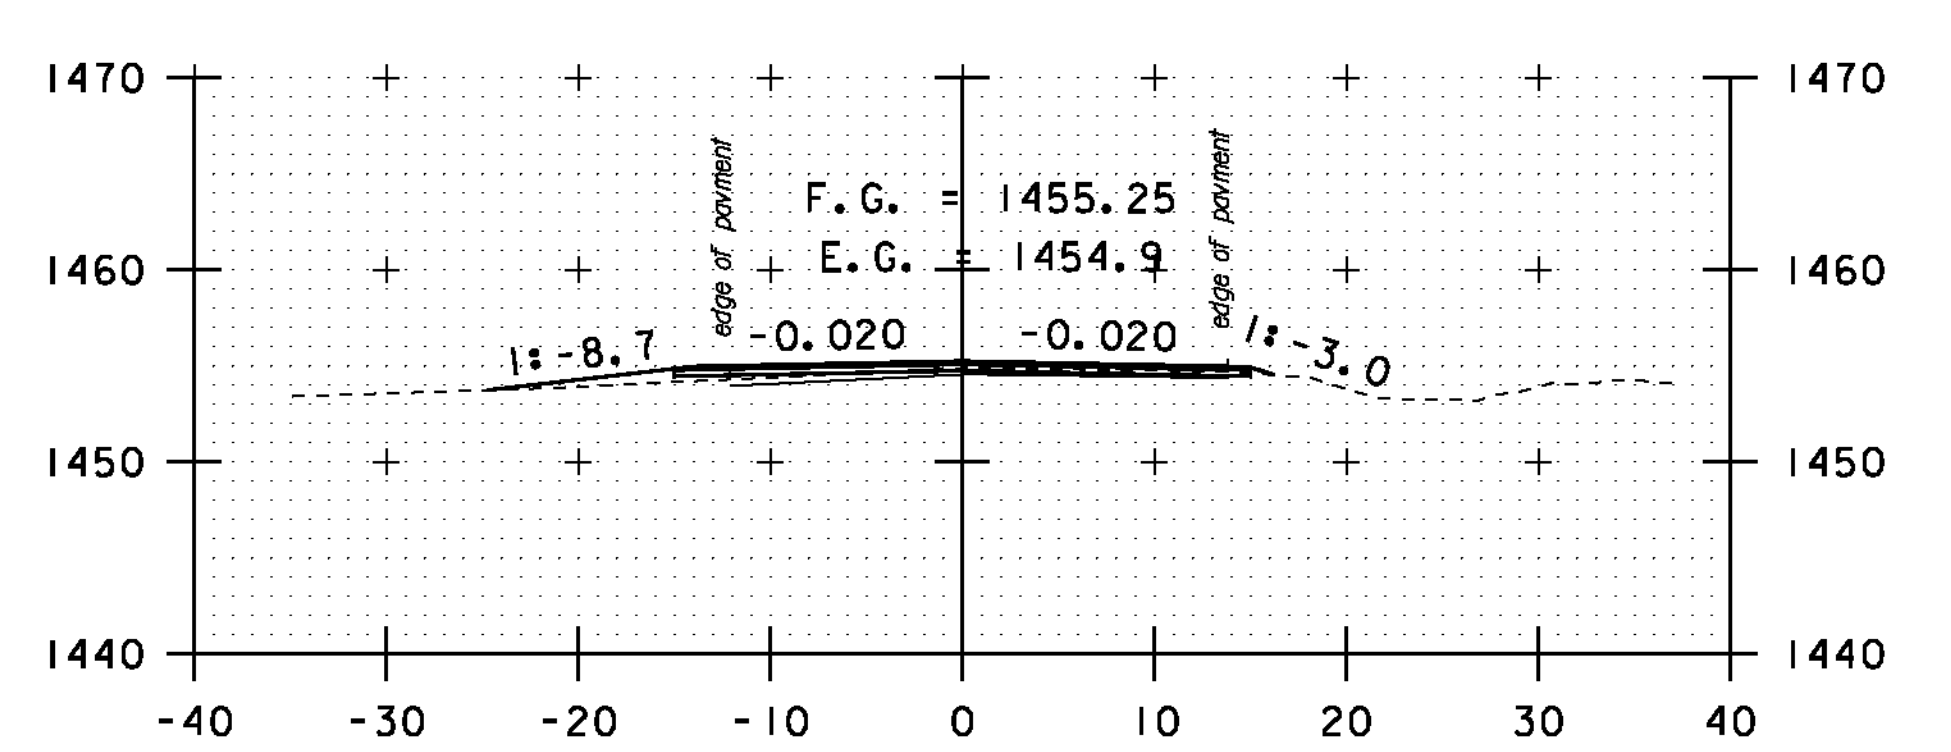


DRIVE LT
A 17+50

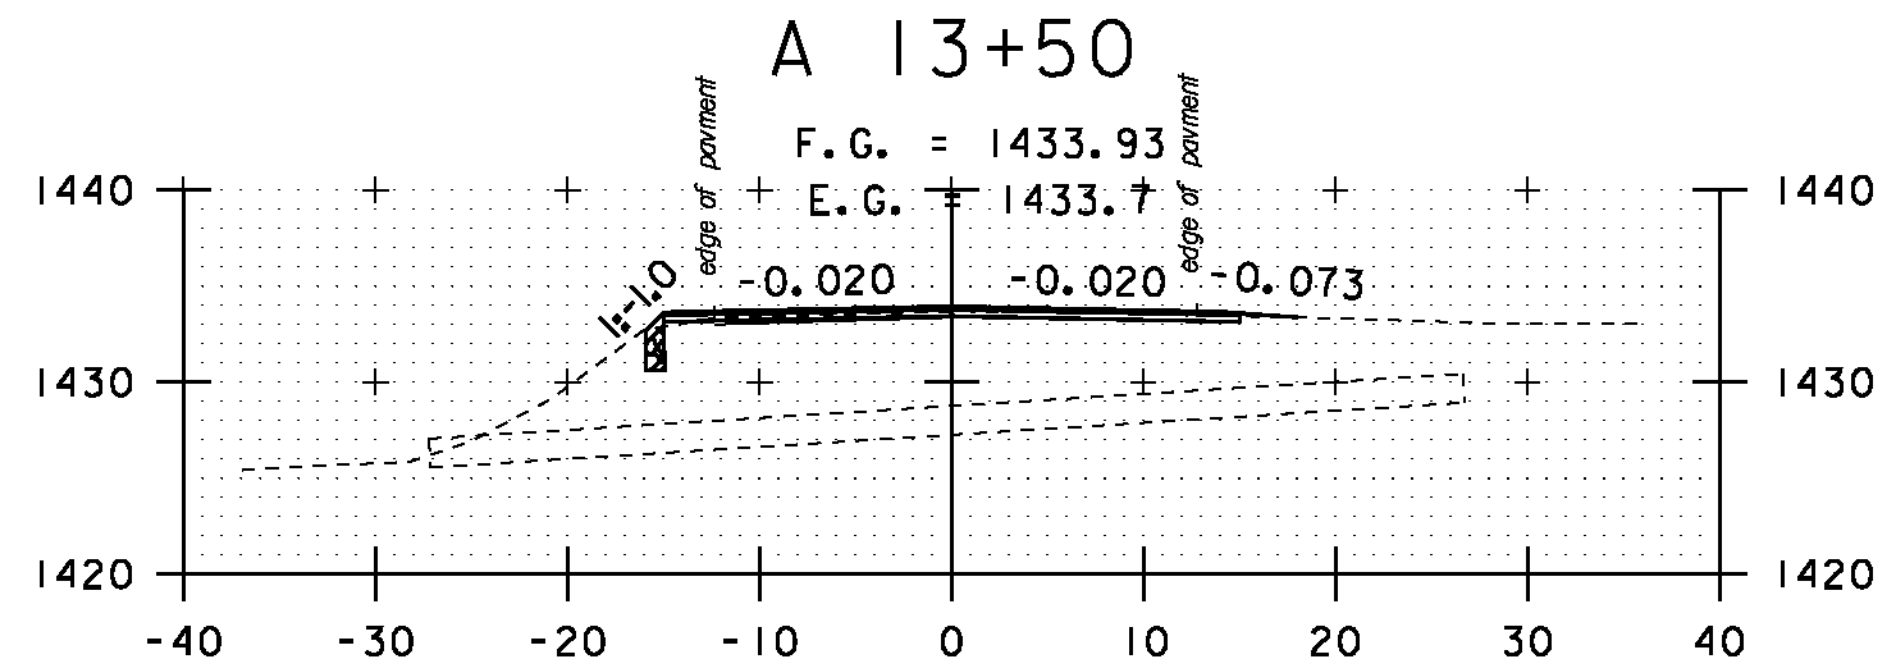


DRIVE RT
A 13+00

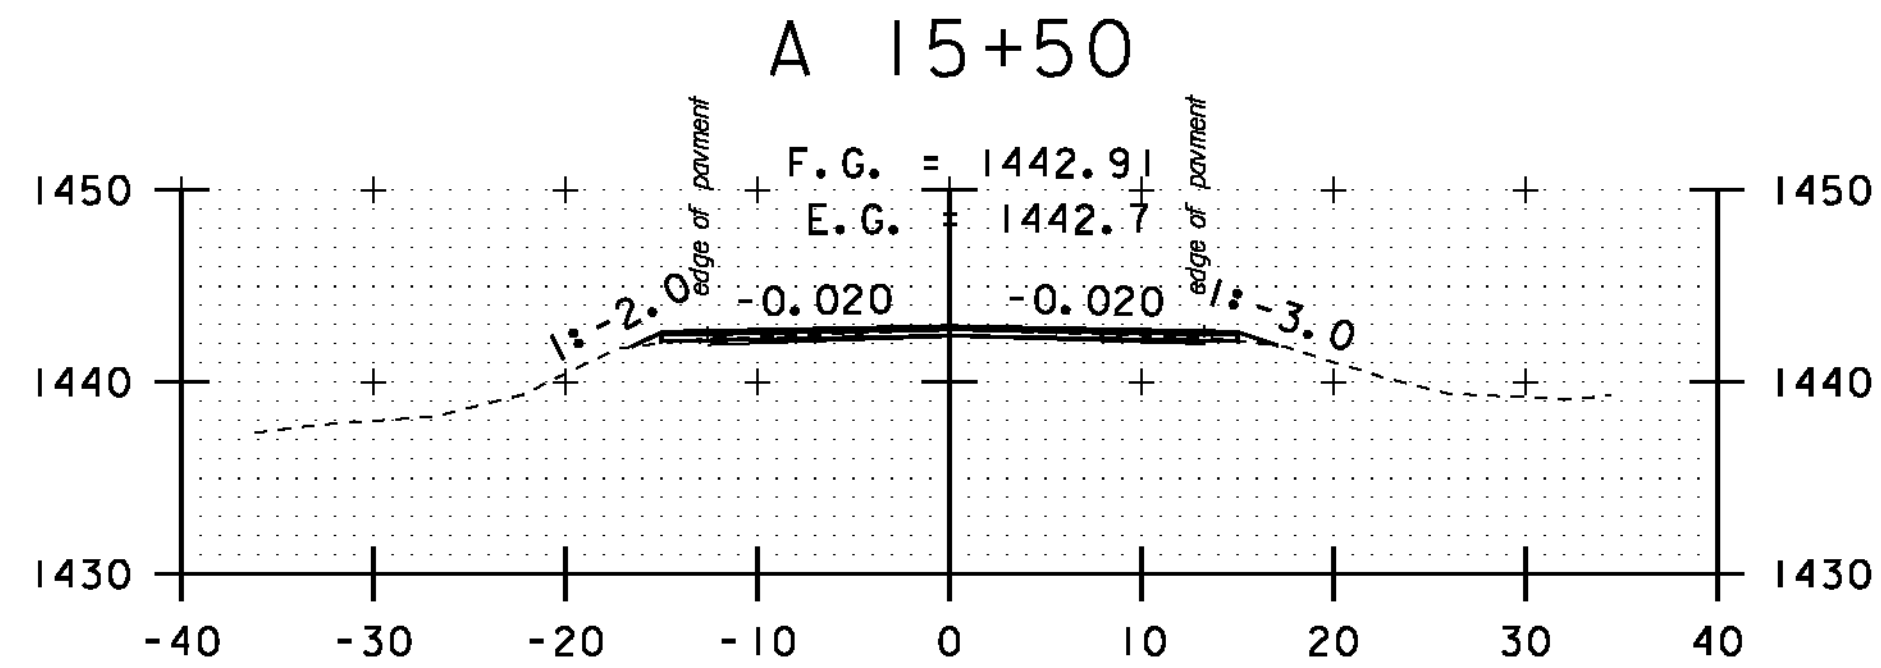


A 15+00

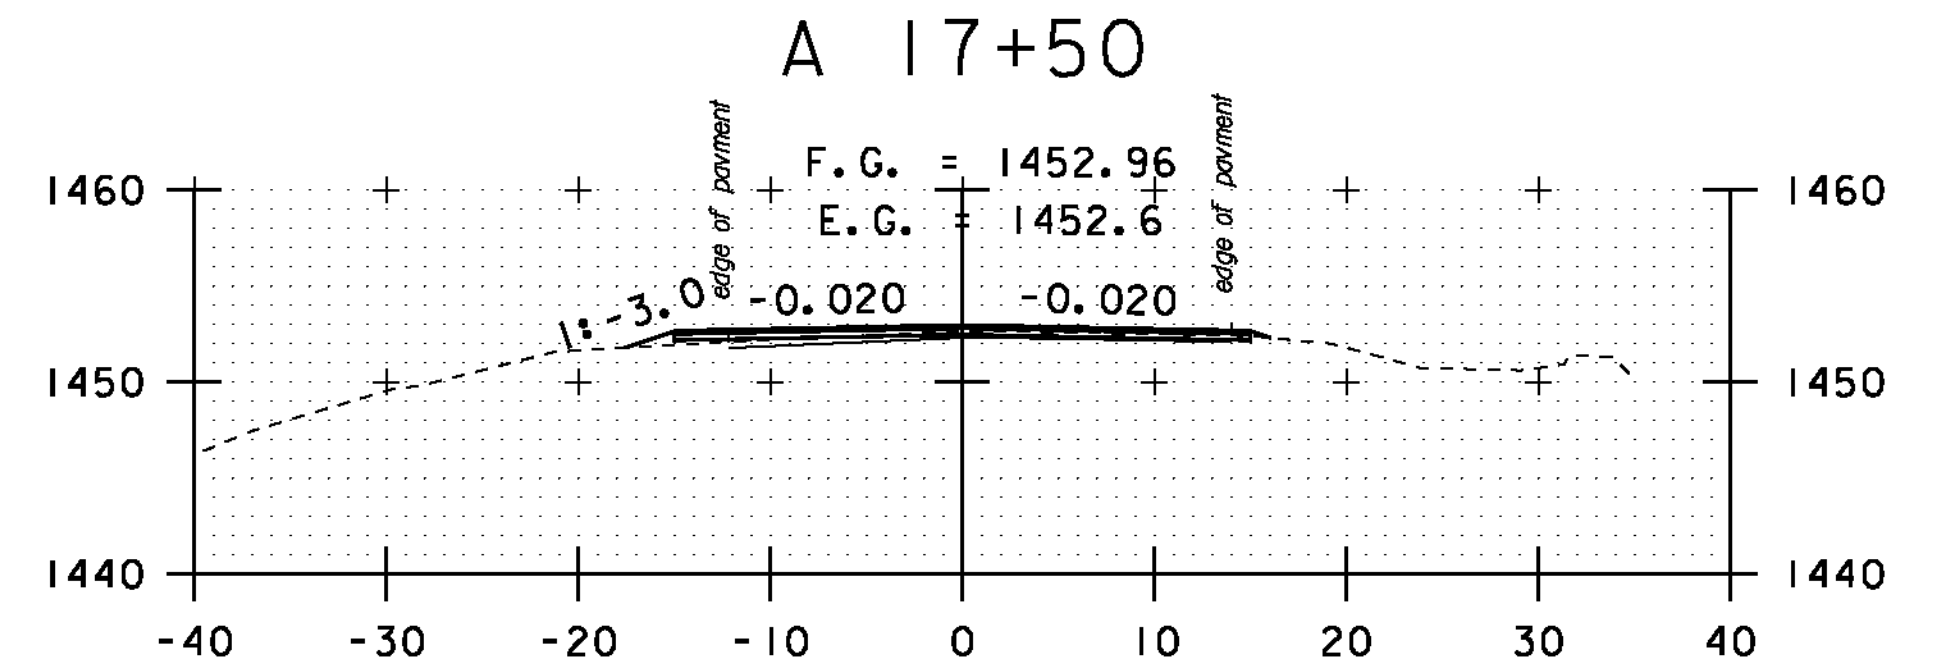


A 17+00

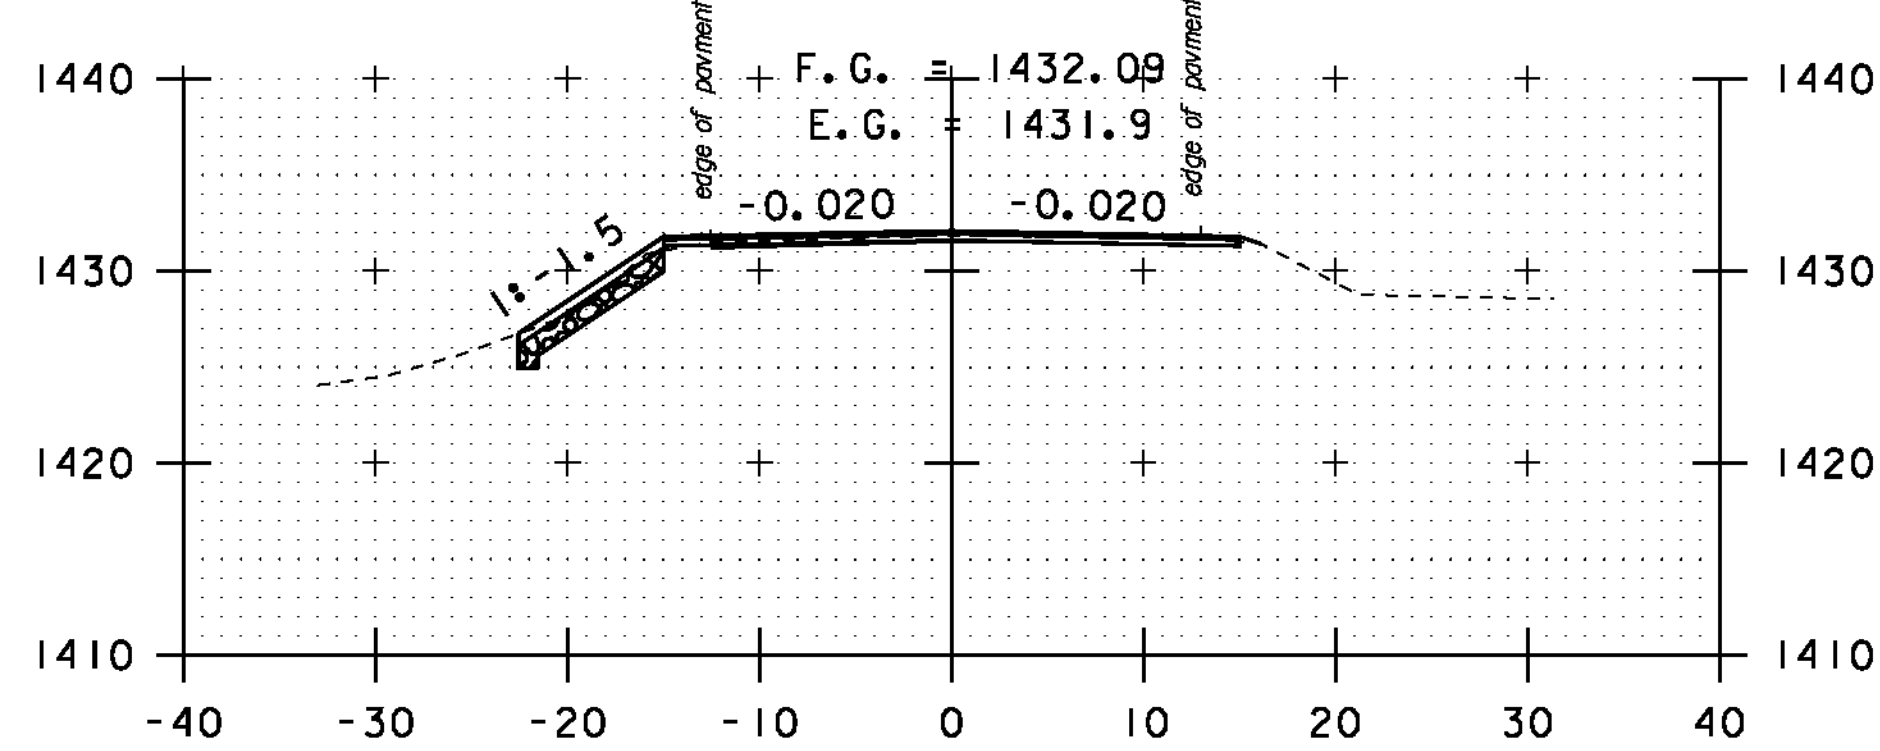

A 12+50

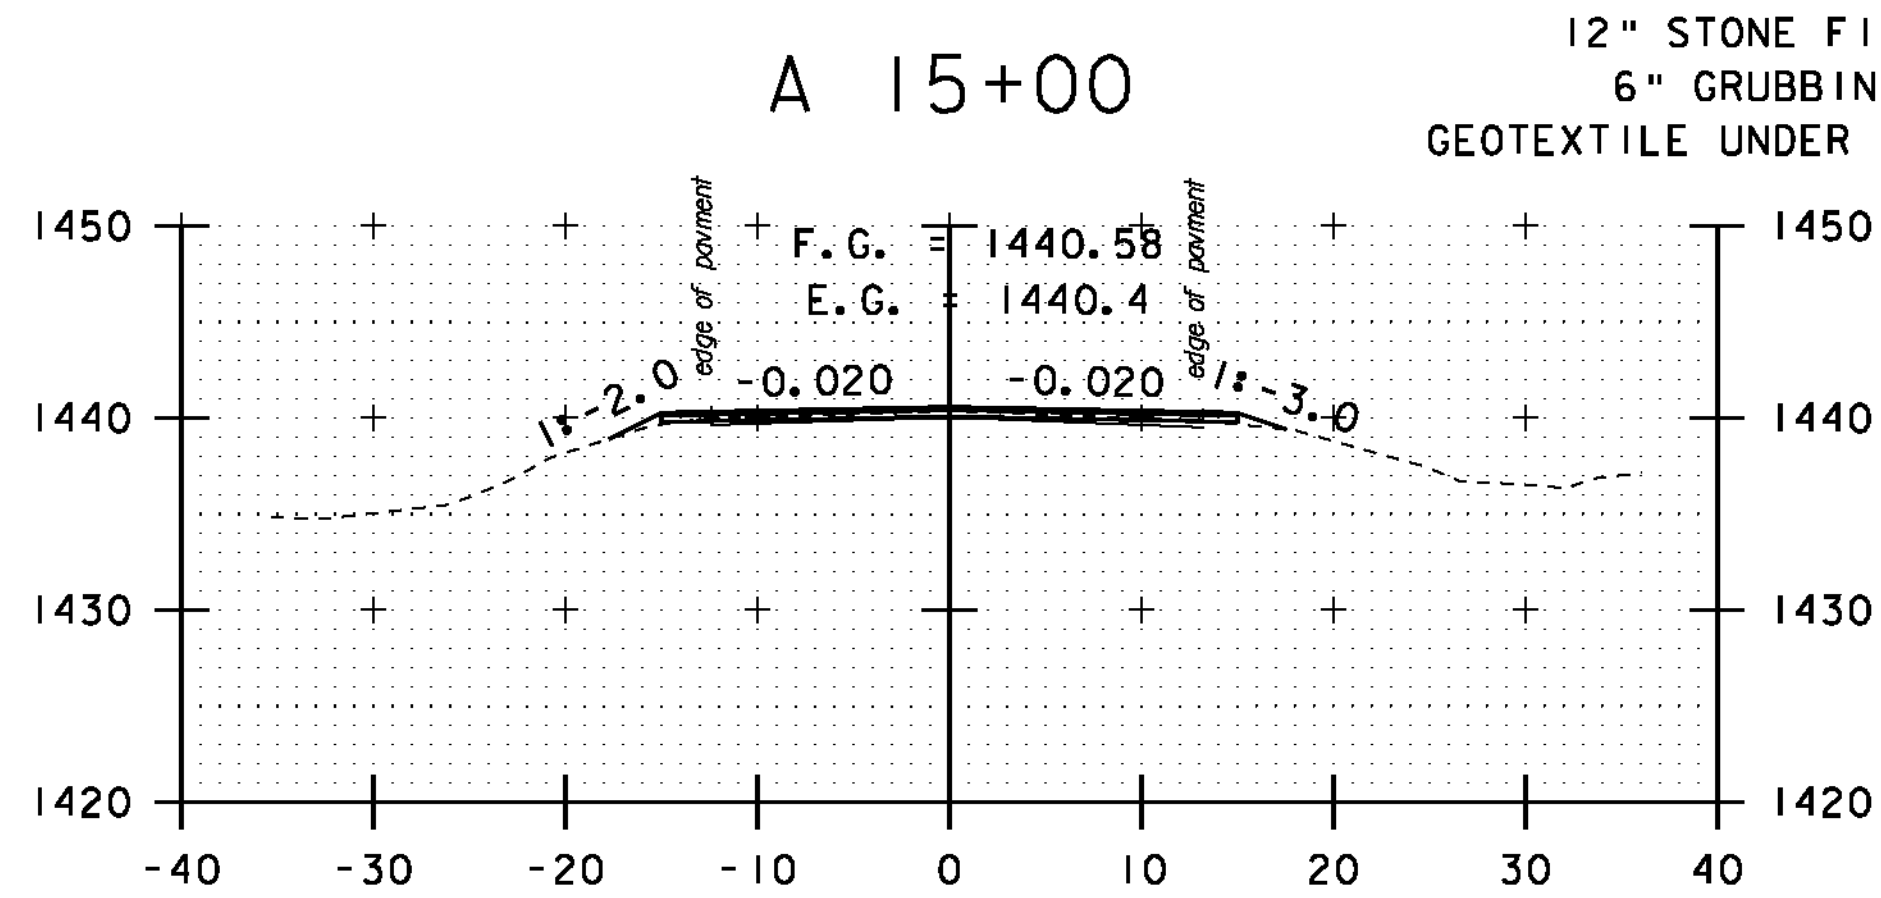

A 14+50

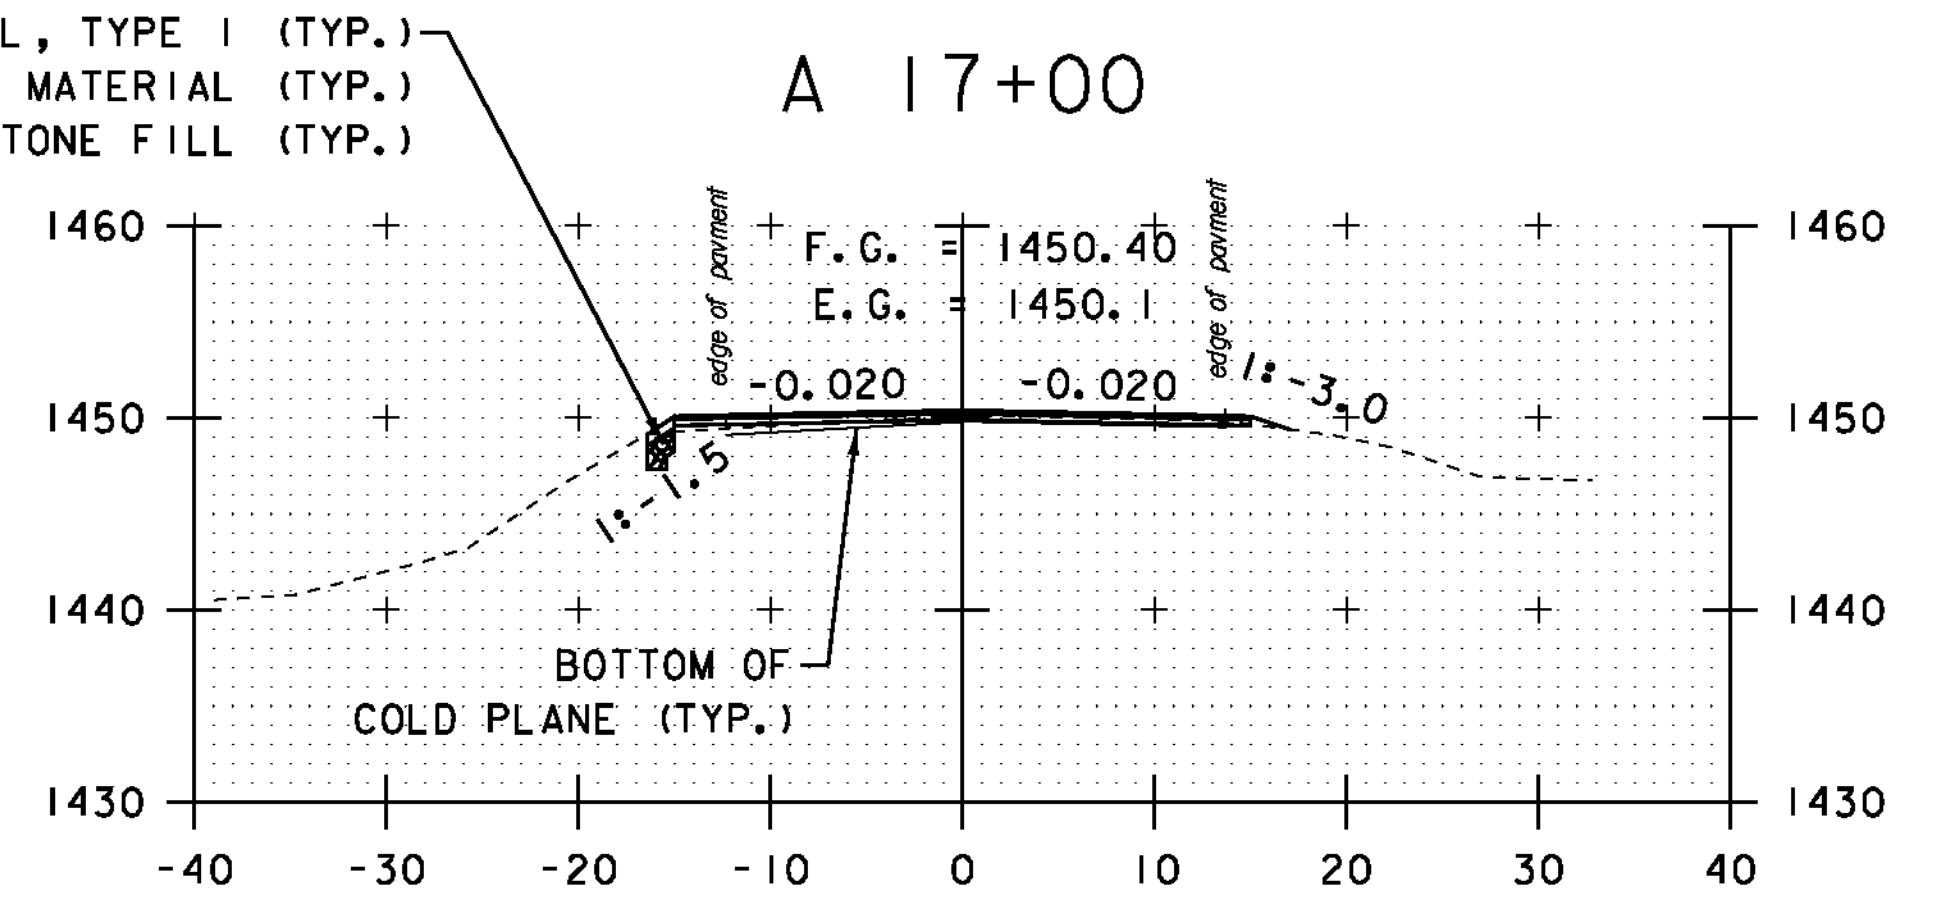

A 16+50

STA. A 12+50 TO STA. A 17+81



CROSS SECTION SHEET 40

PROJECT NAME: MONTGOMERY-WESTFIELD	PLOT DATE: 9/5/12
PROJECT NUMBER: STP 2906(I)	DRAWN BY: SJL
FILE NAME: p10CI90.dgn	CHECKED BY: CDL
PROJECT LEADER: CDL	SHEET 154 OF 178
DESIGNED BY: SJL	
PLOT FILE: p10CI90_154.I	