




A 19+50

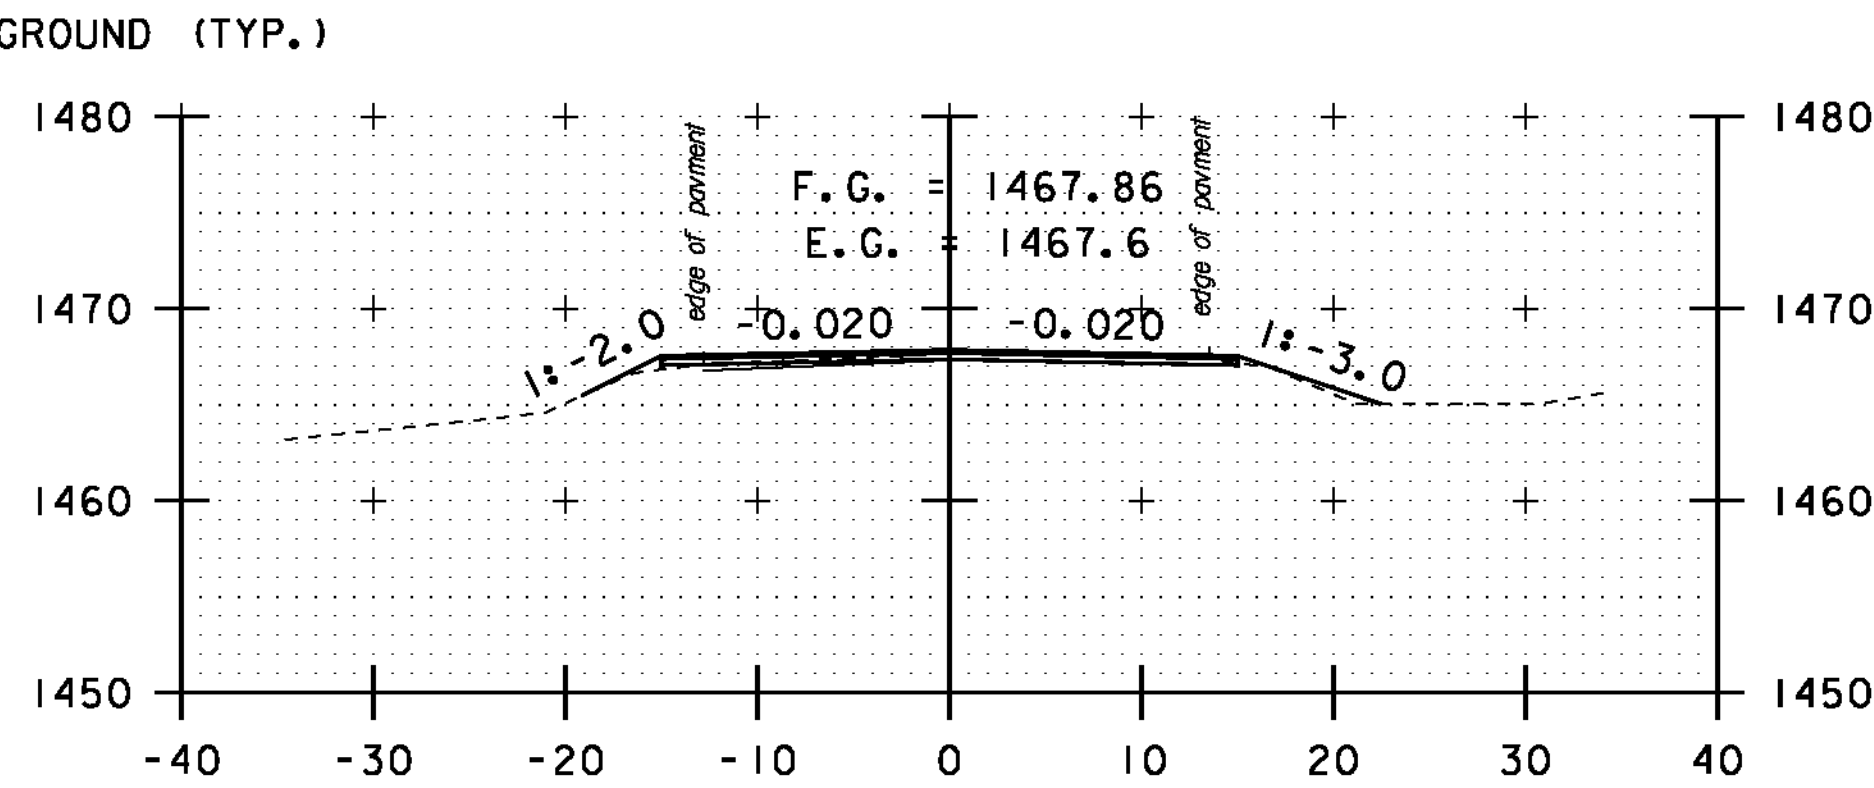


A 21+50

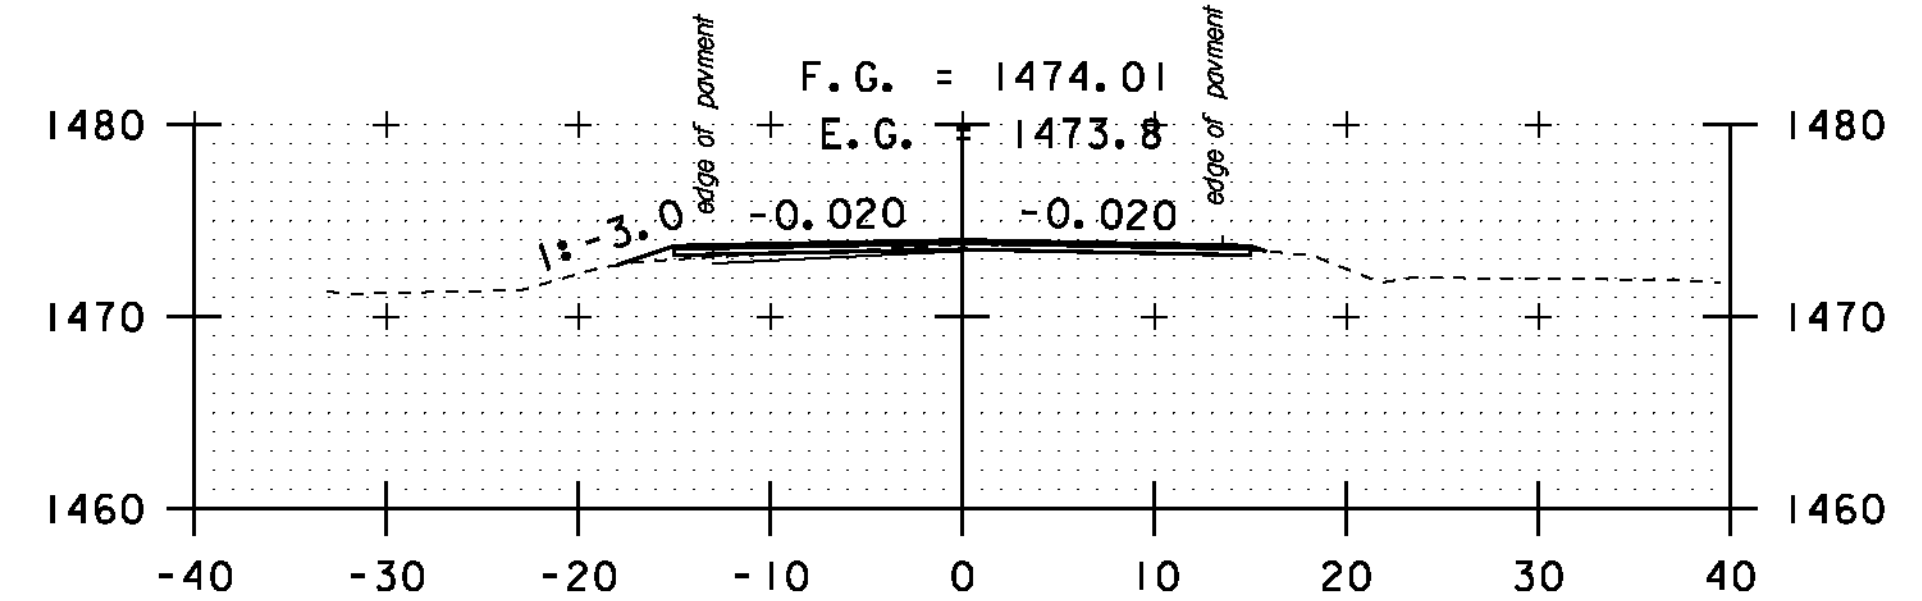


A 23+50

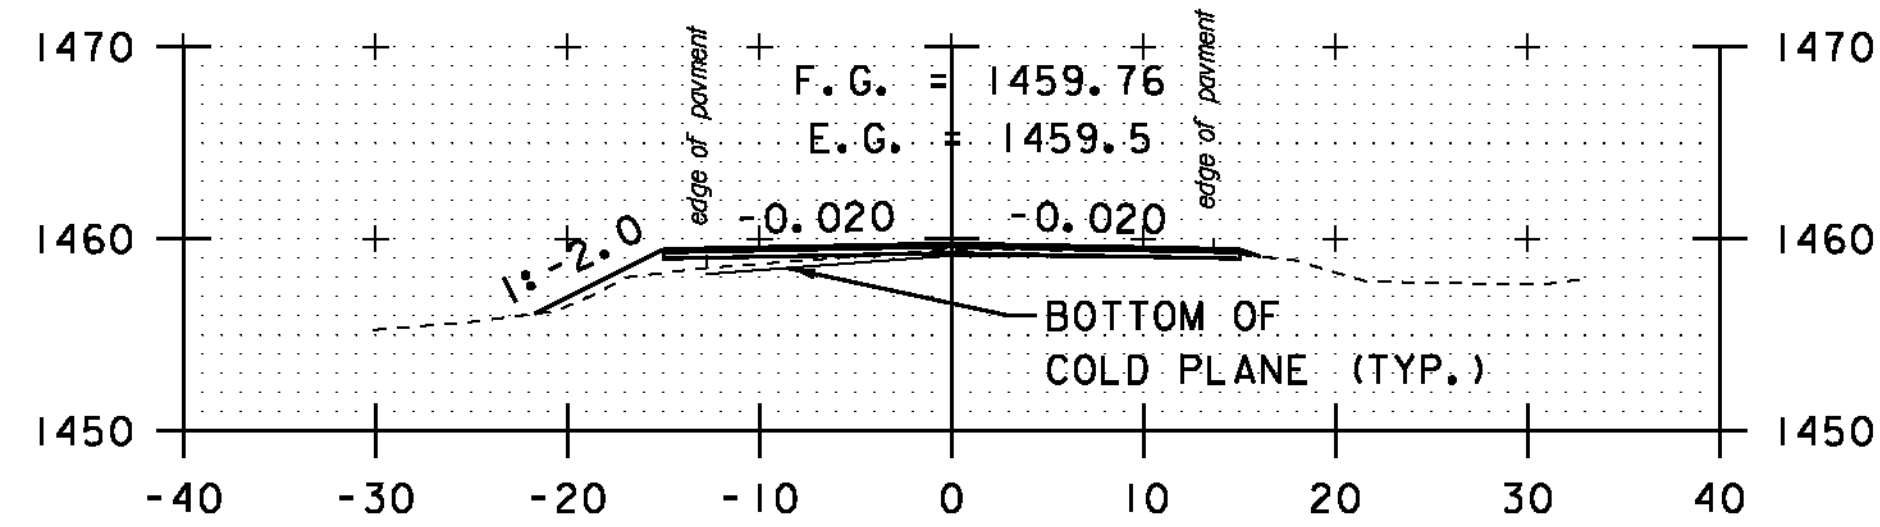


A 19+00

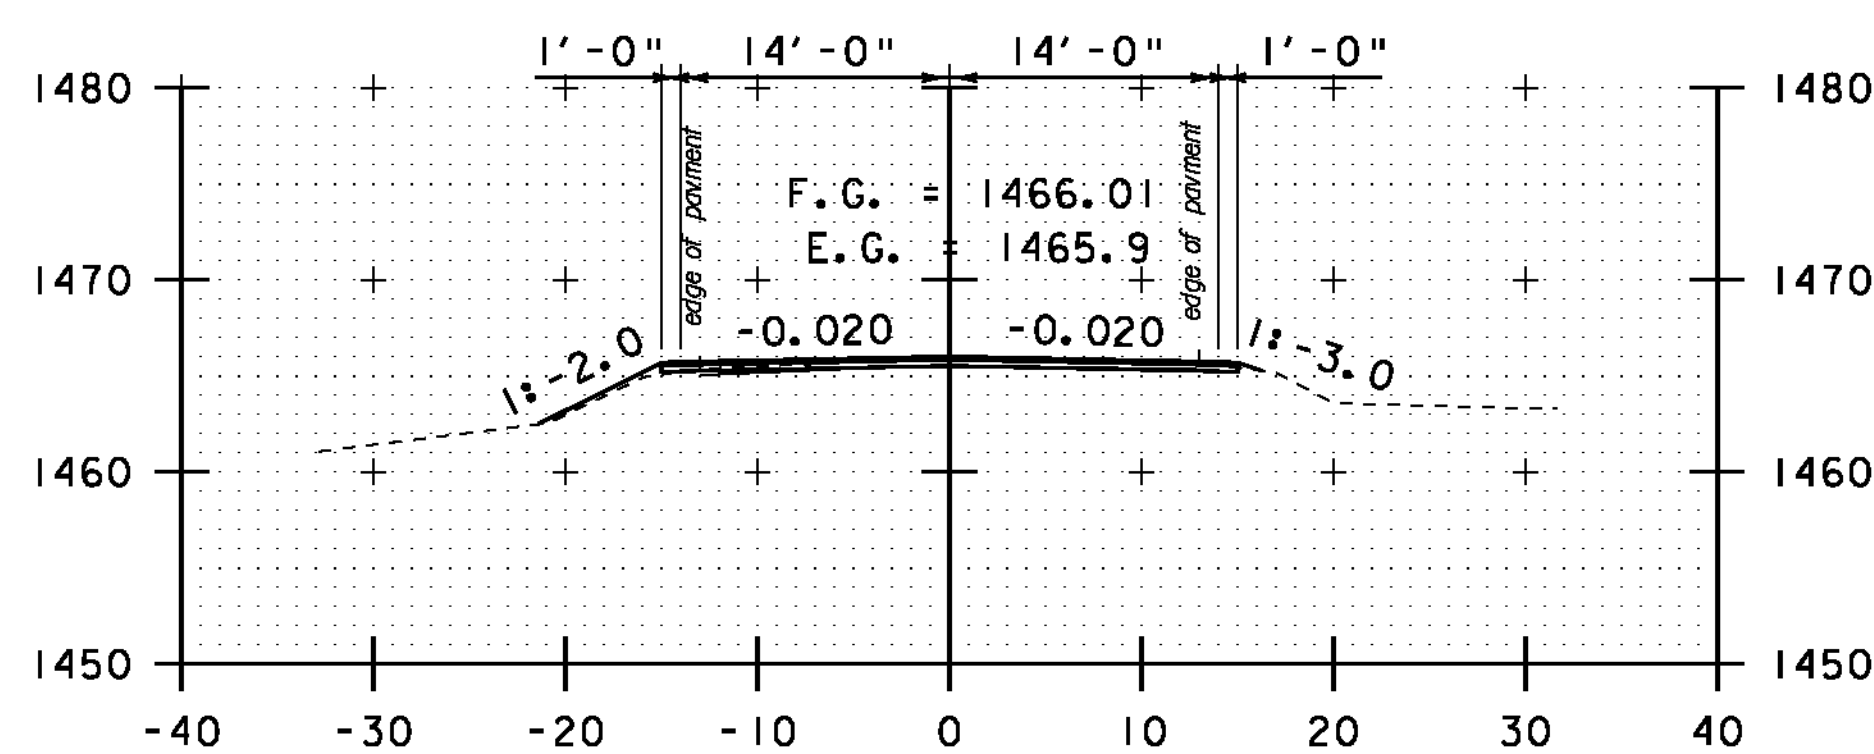


A 21+00

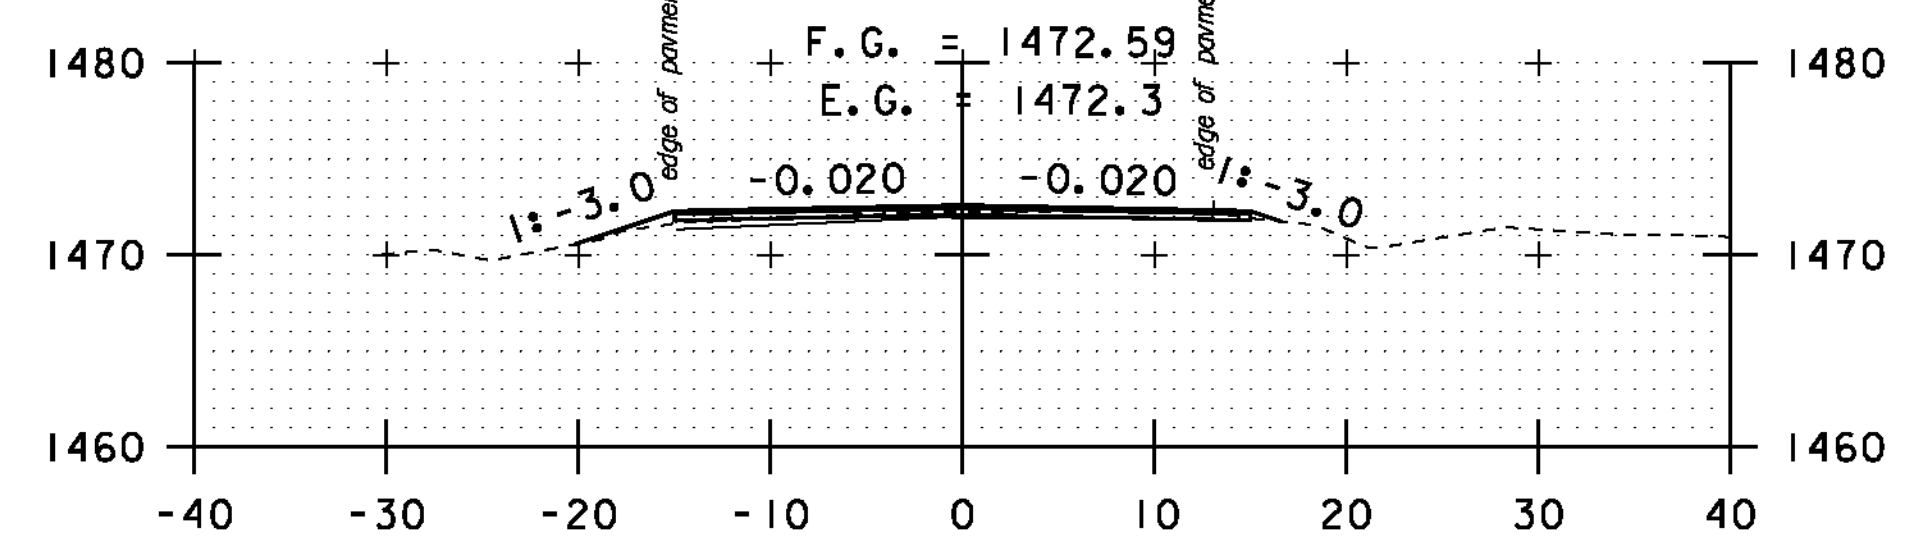


A 23+00

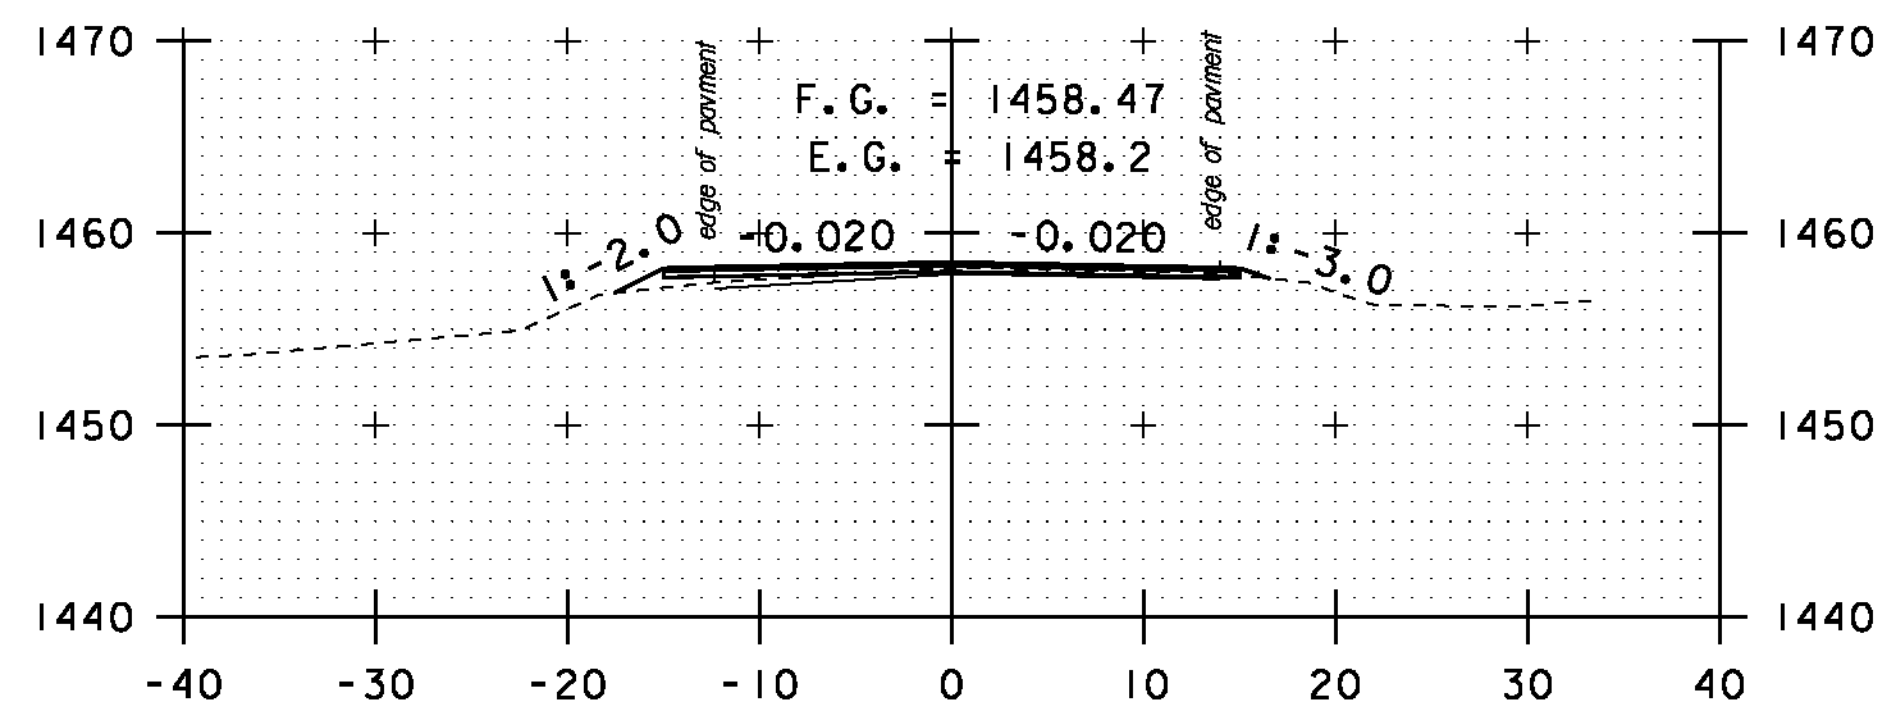


A 18+50

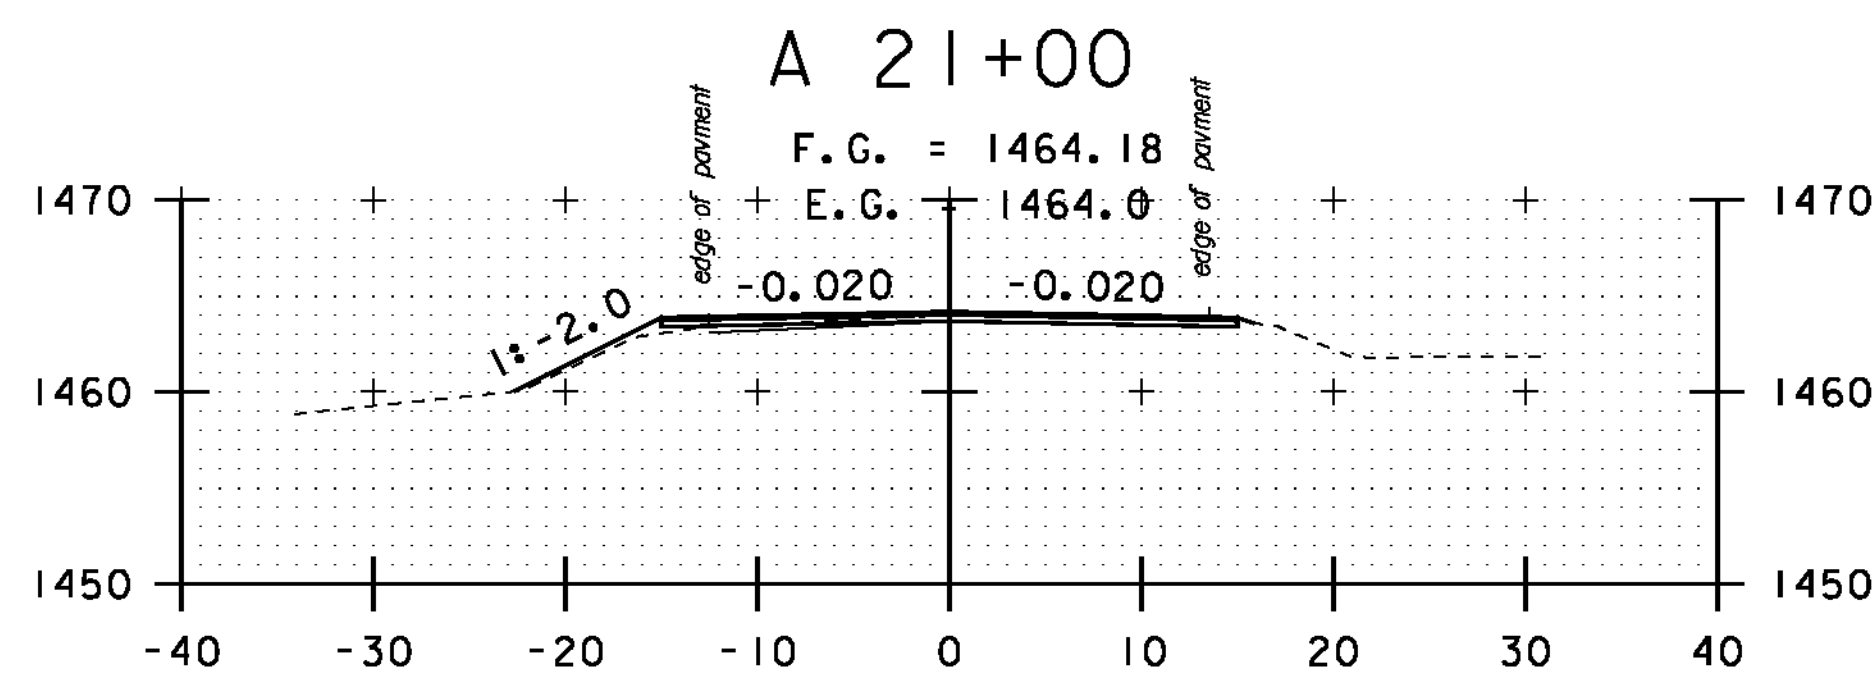


A 20+50

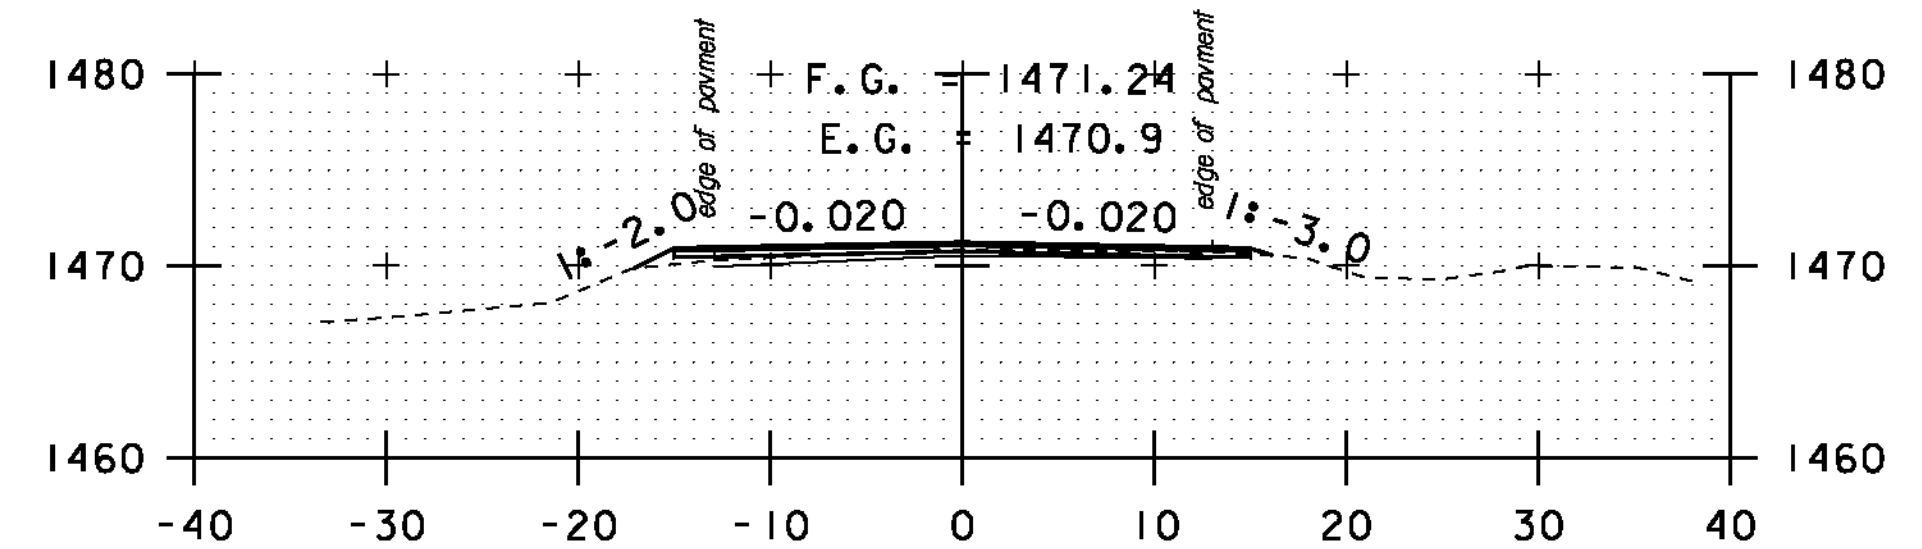


A 22+50

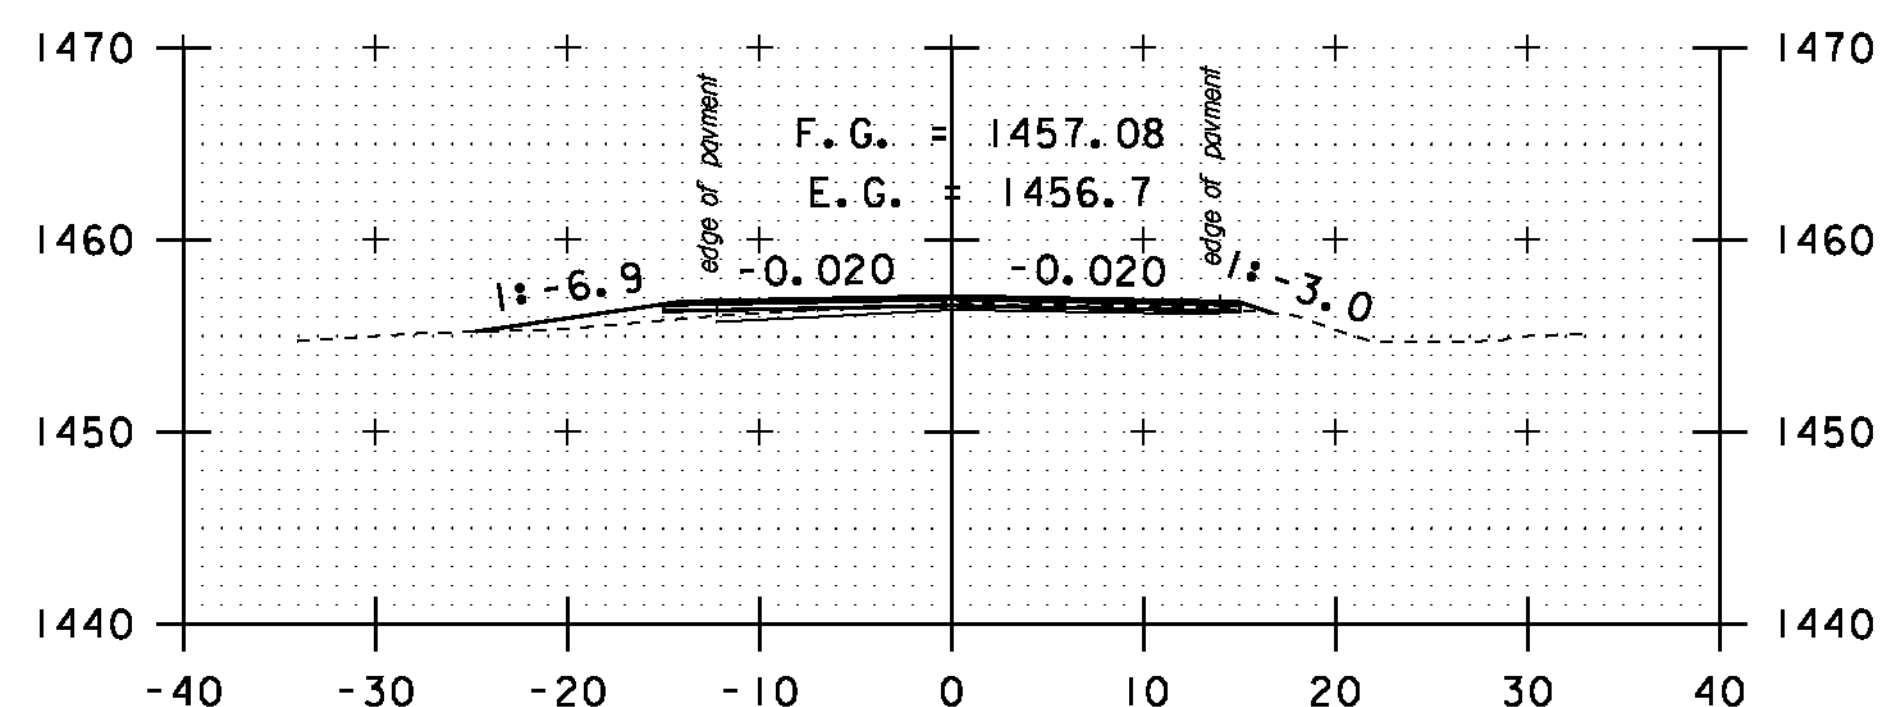

DRIVE LT
A 18+00

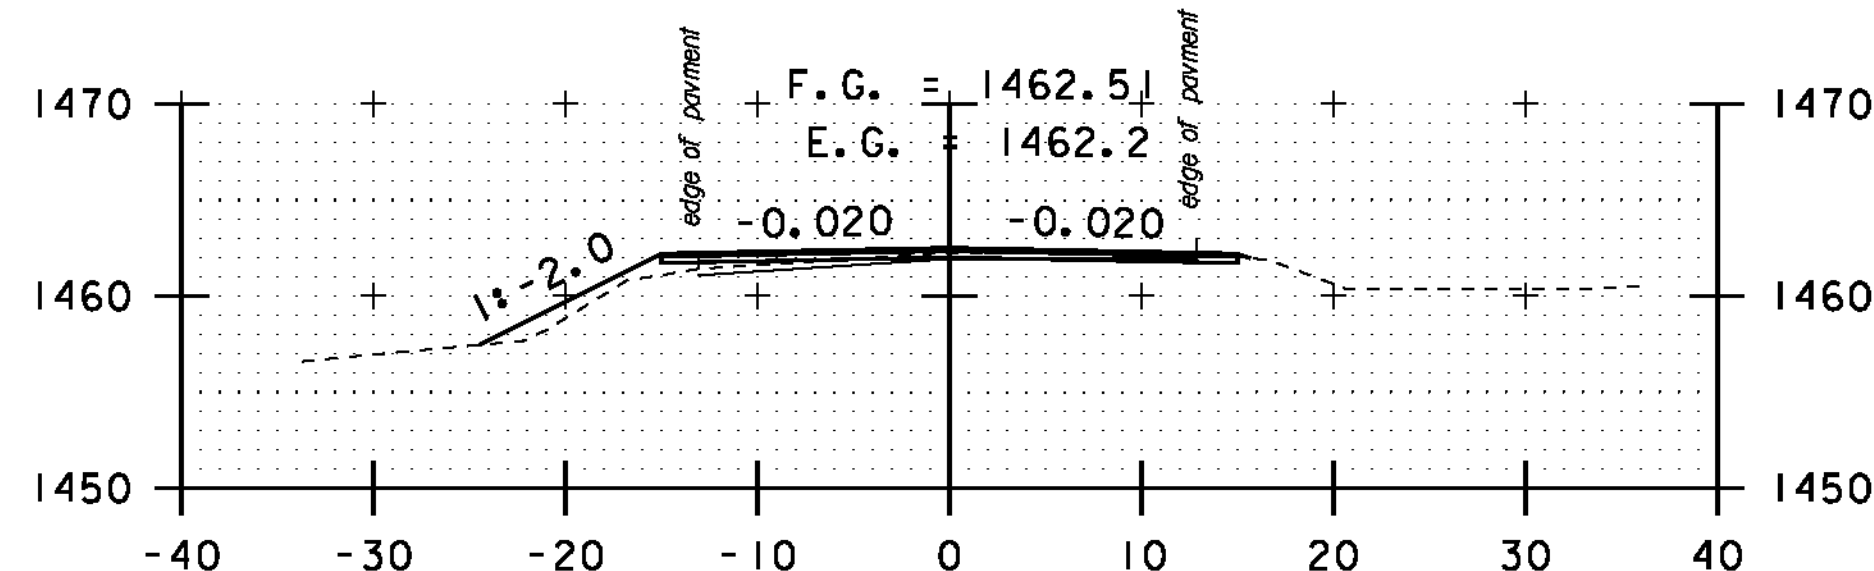

A 20+00

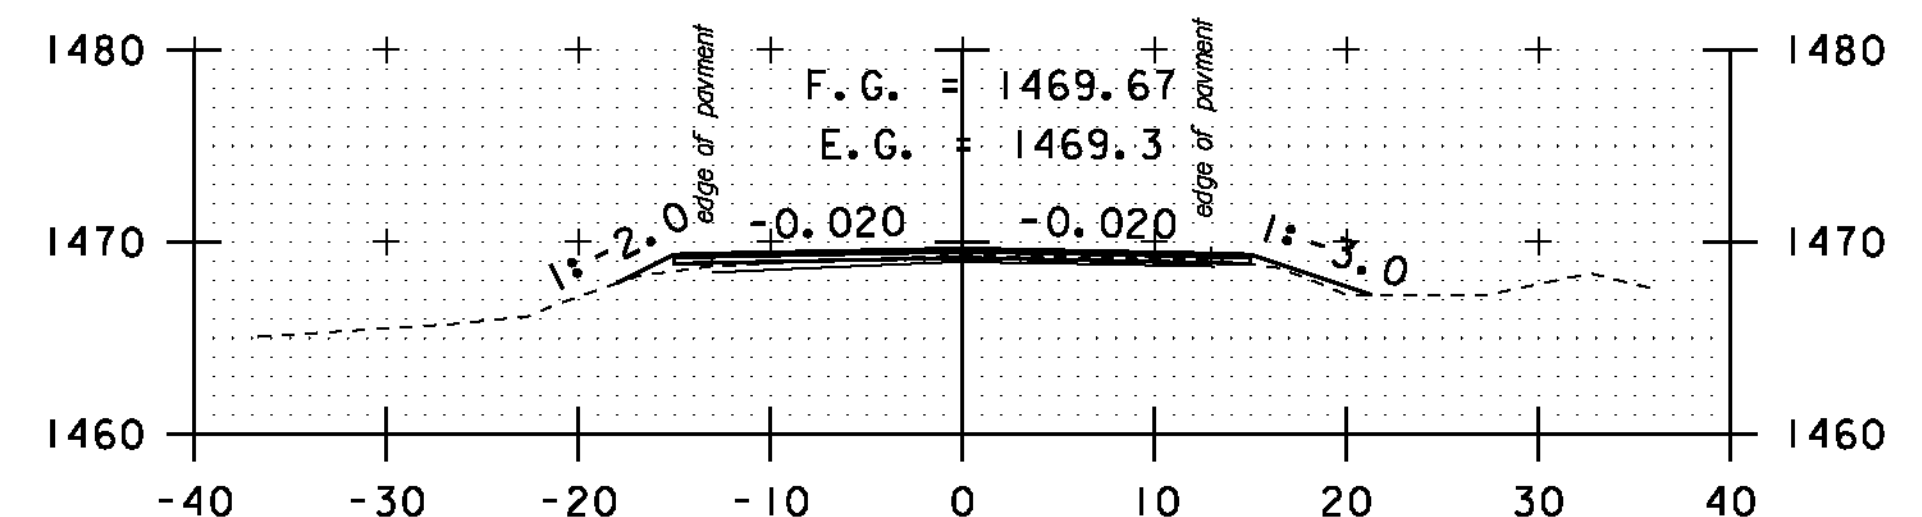

A 22+00

STA. A 18+00 TO STA. A 23+50



CROSS SECTION SHEET 41

PROJECT NAME: MONTGOMERY-WESTFIELD
 PROJECT NUMBER: STP 2906(I)
 FILE NAME: p10CI90.dgn
 PROJECT LEADER: CDL
 DESIGNED BY: SJL
 PLOT FILE: p10CI90_155.I

PLOT DATE: 9/5/12
 DRAWN BY: SJL
 CHECKED BY: CDL
 SHEET 155 OF 178