




A 25+50

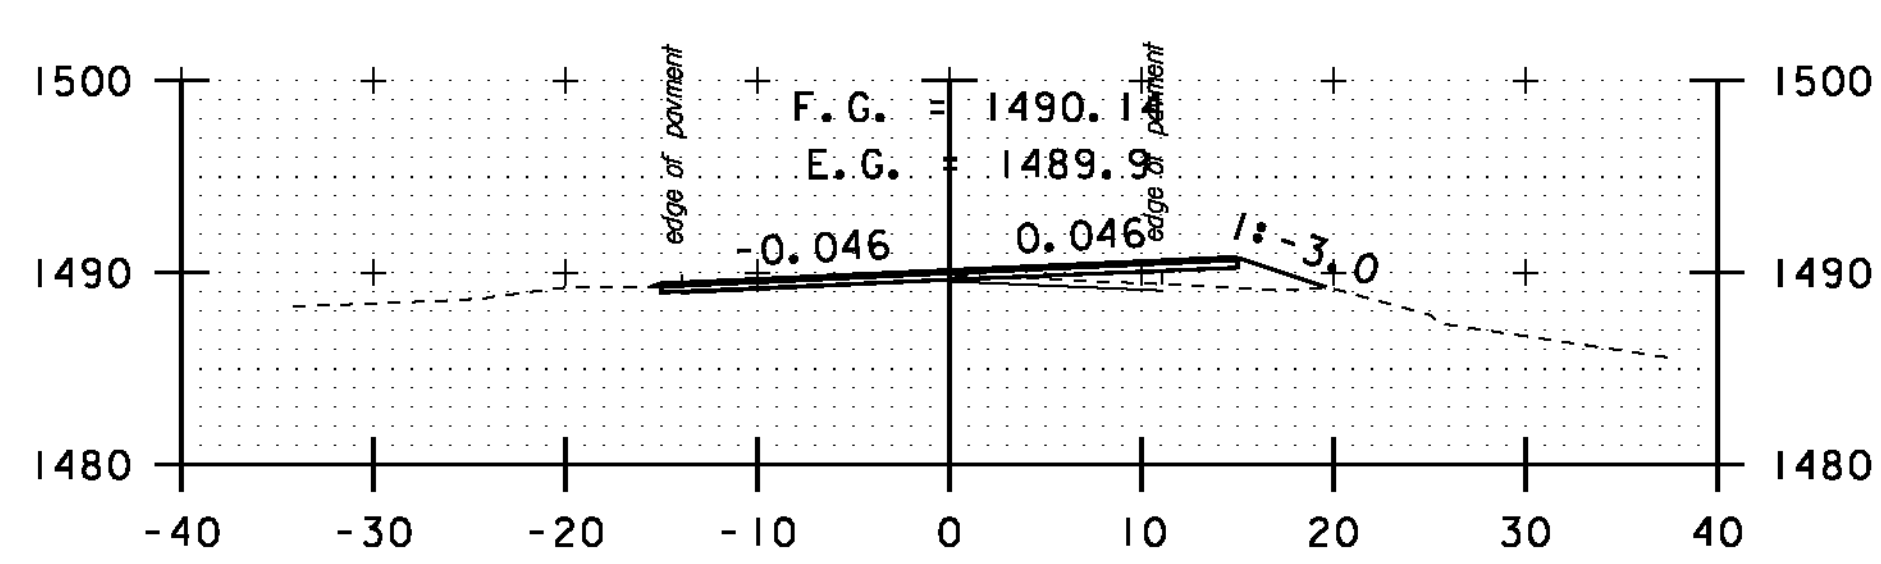


A 27+50

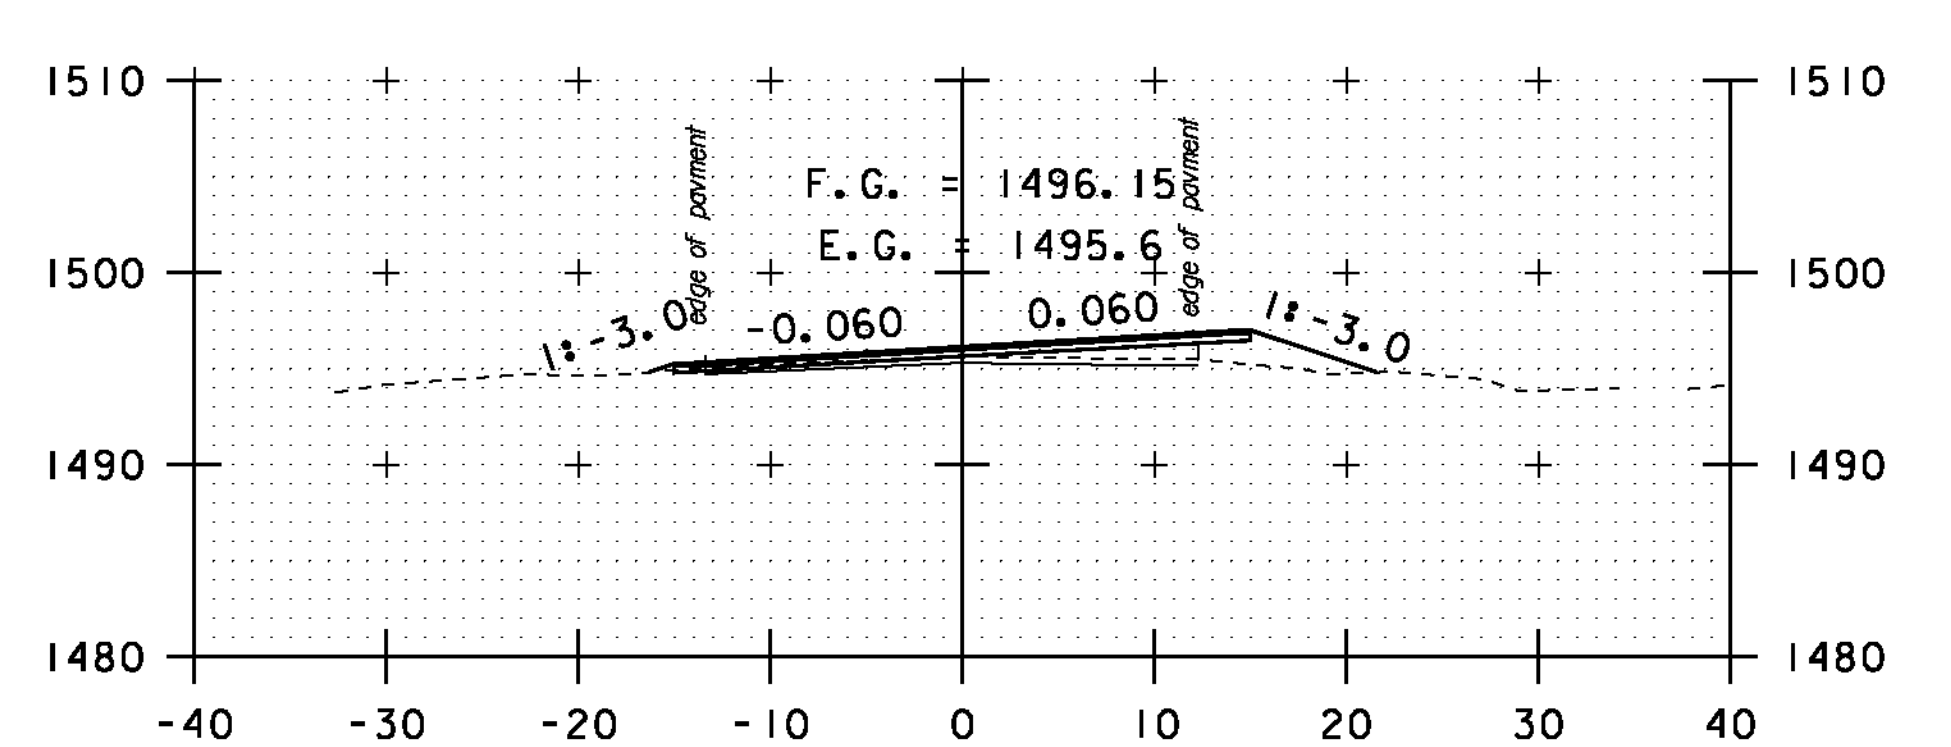


A 29+50

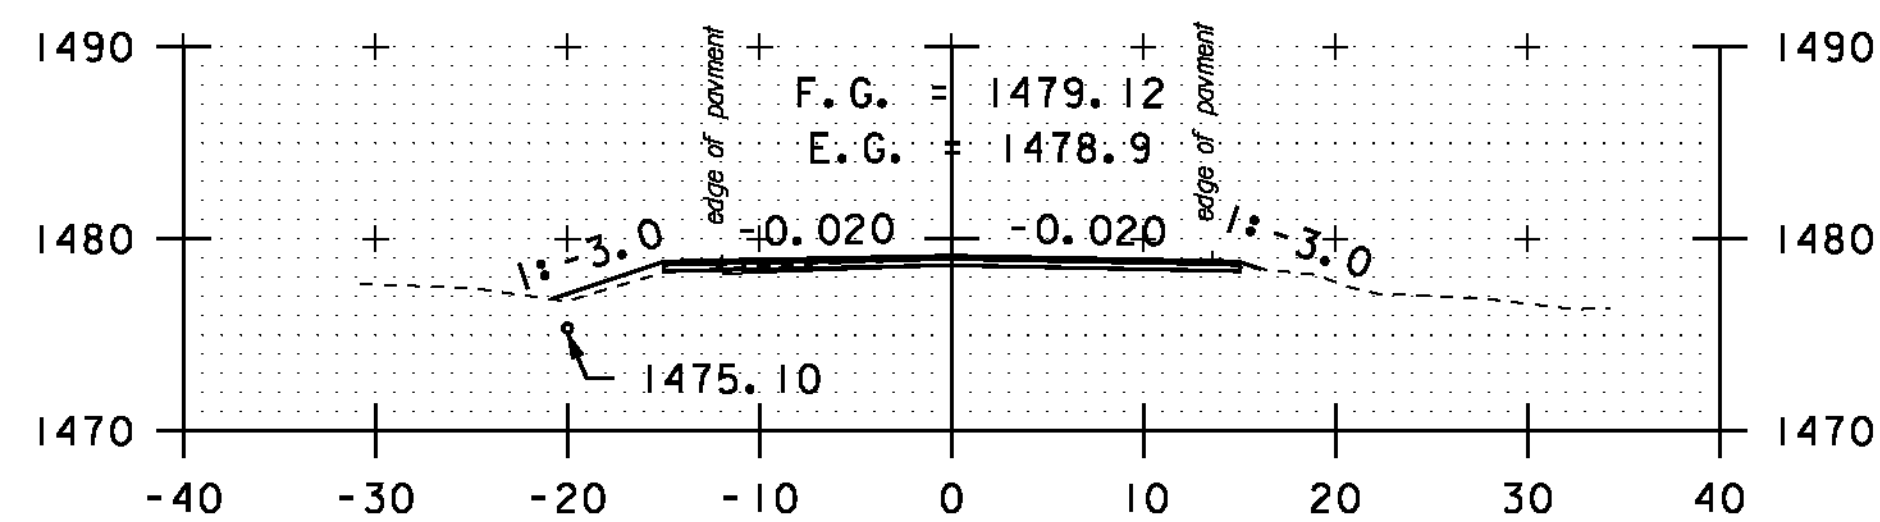


A 25+00

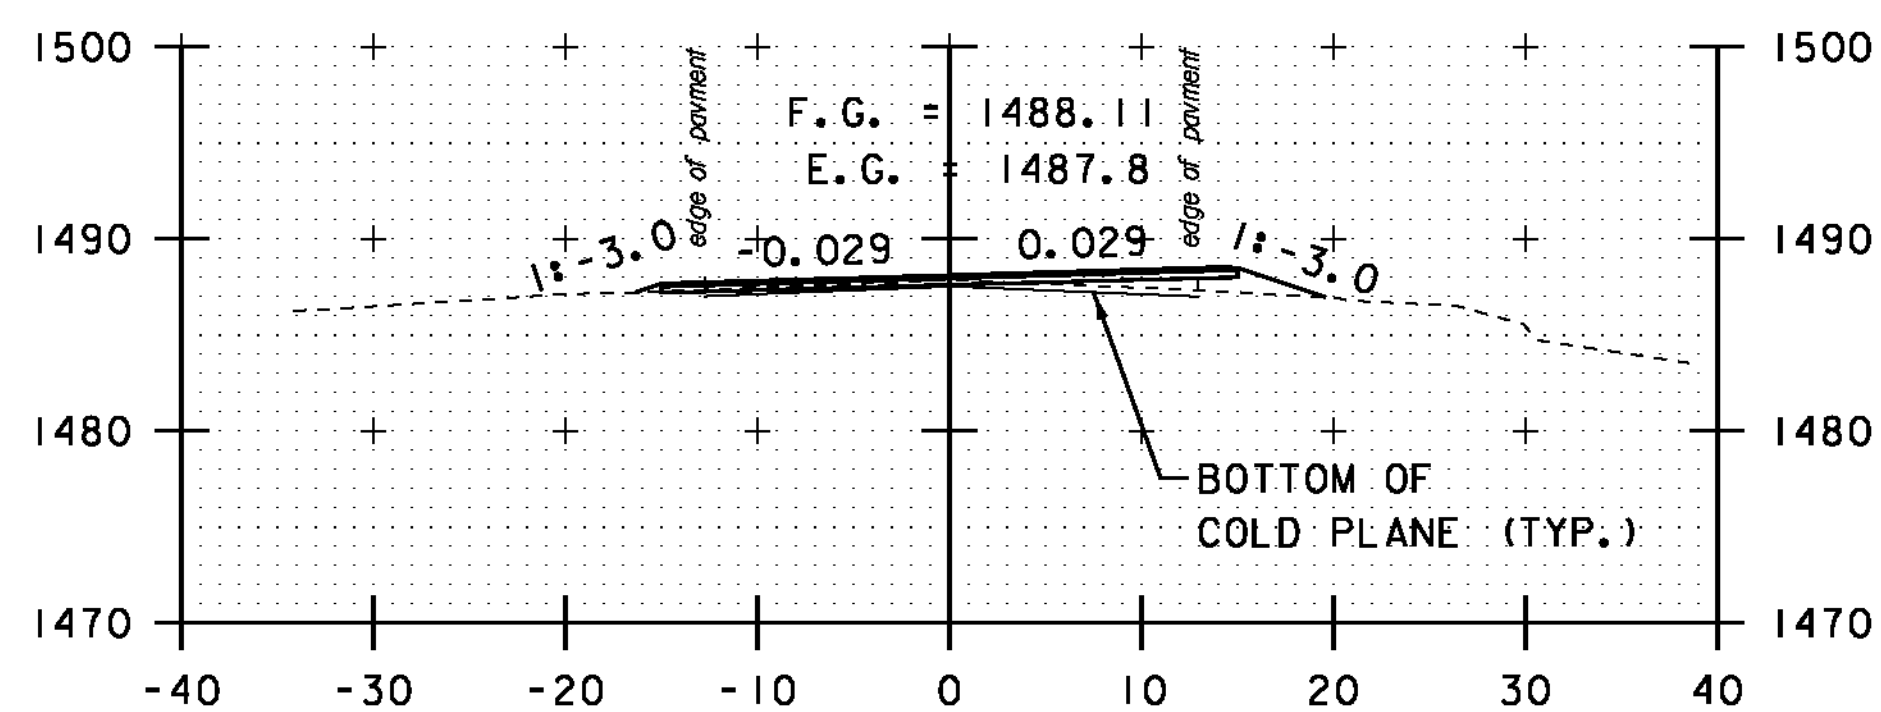


A 27+00

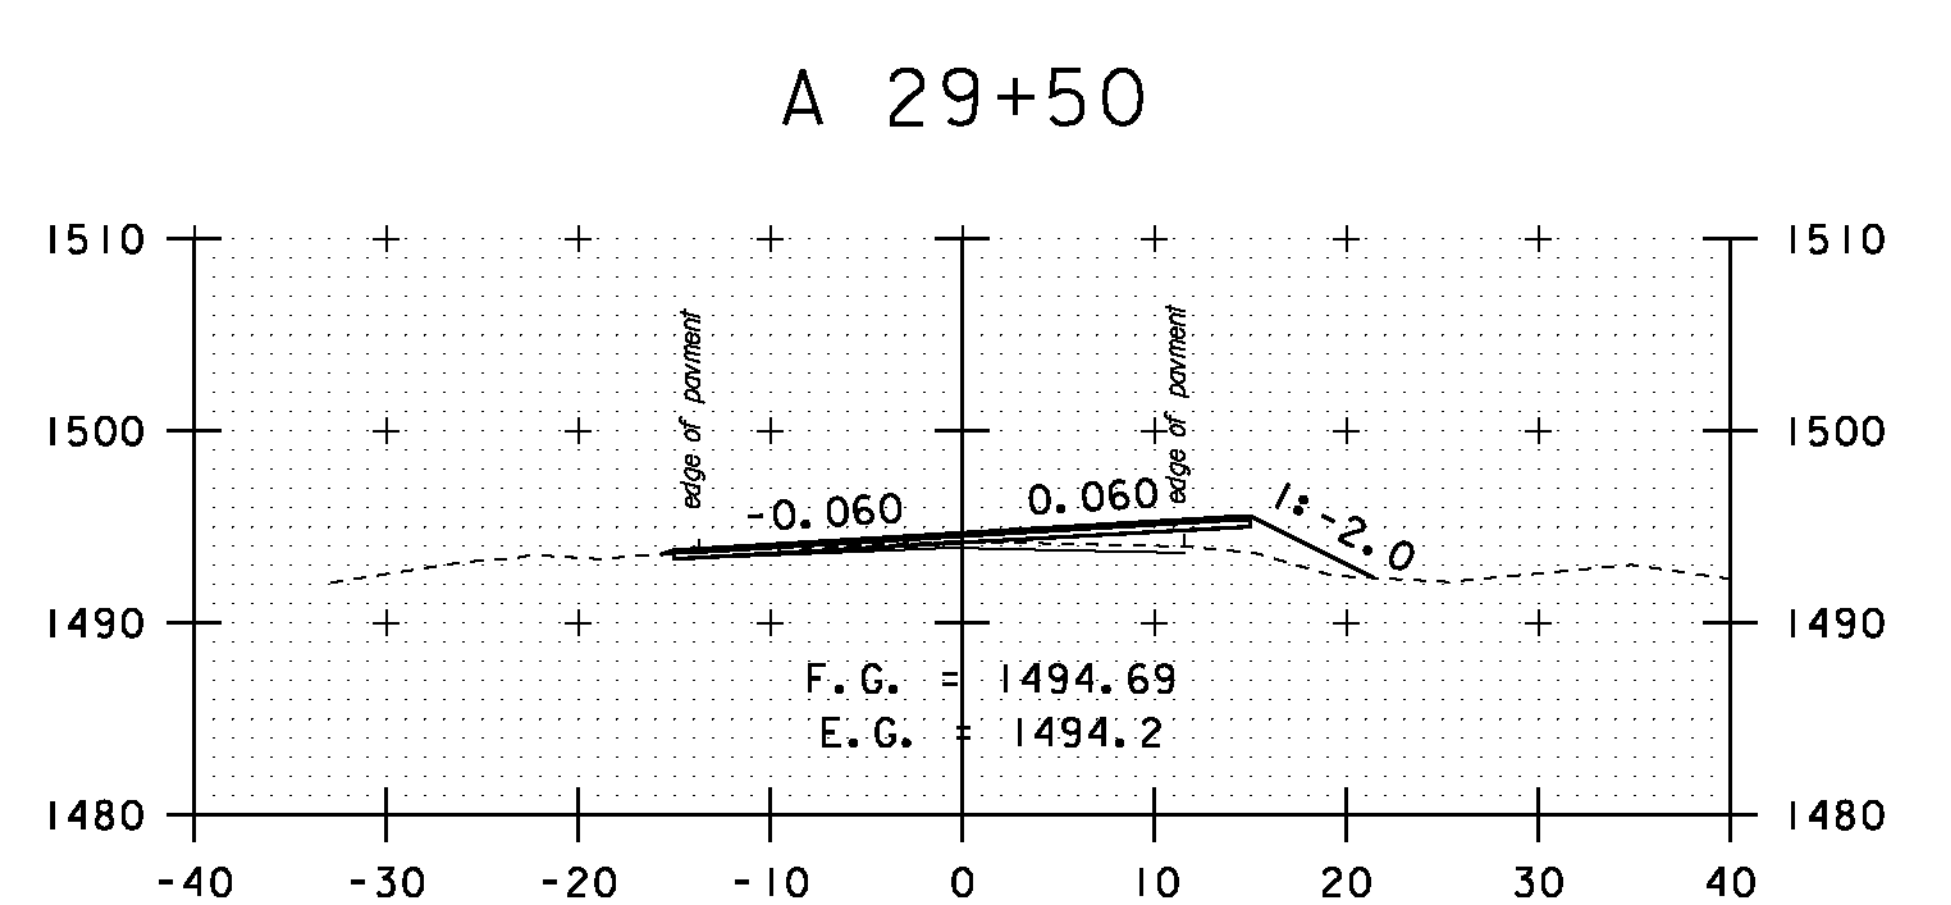


A 29+00

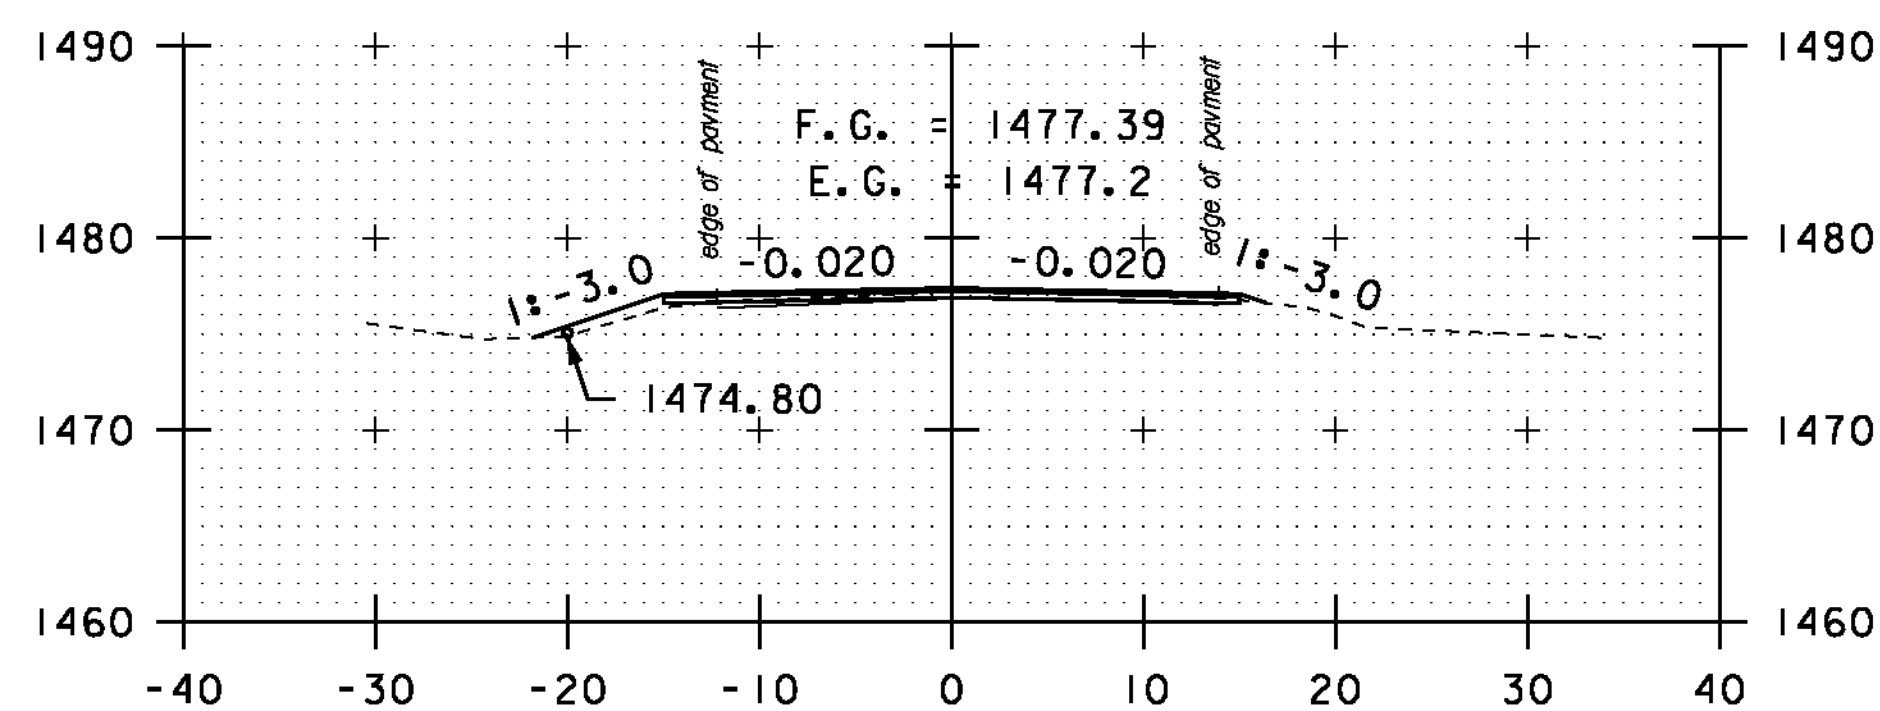


A 24+50

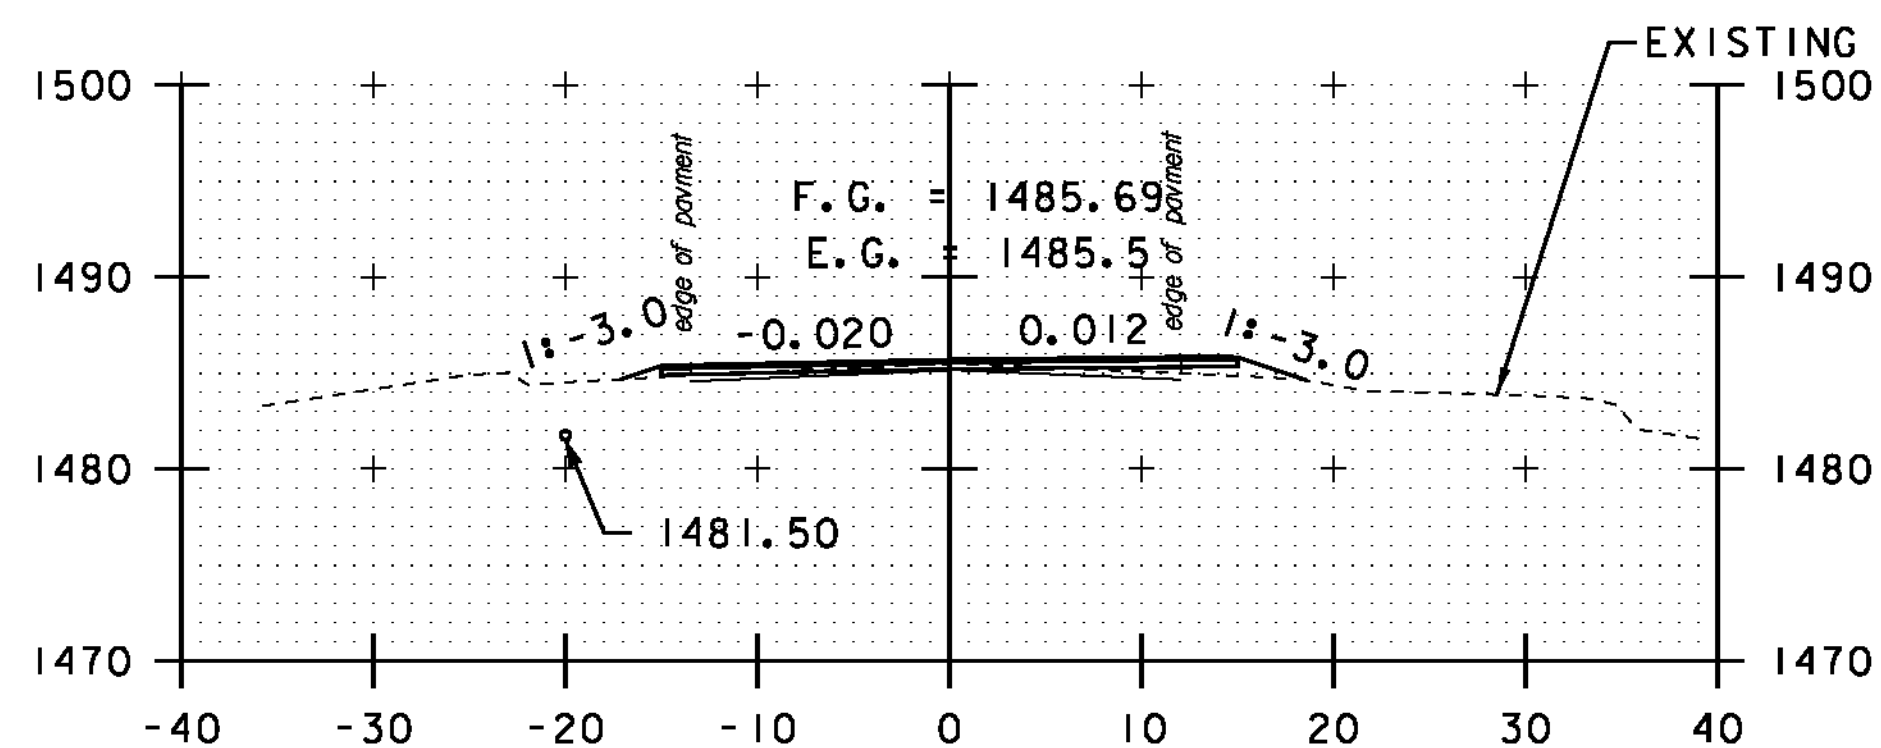


A 26+50

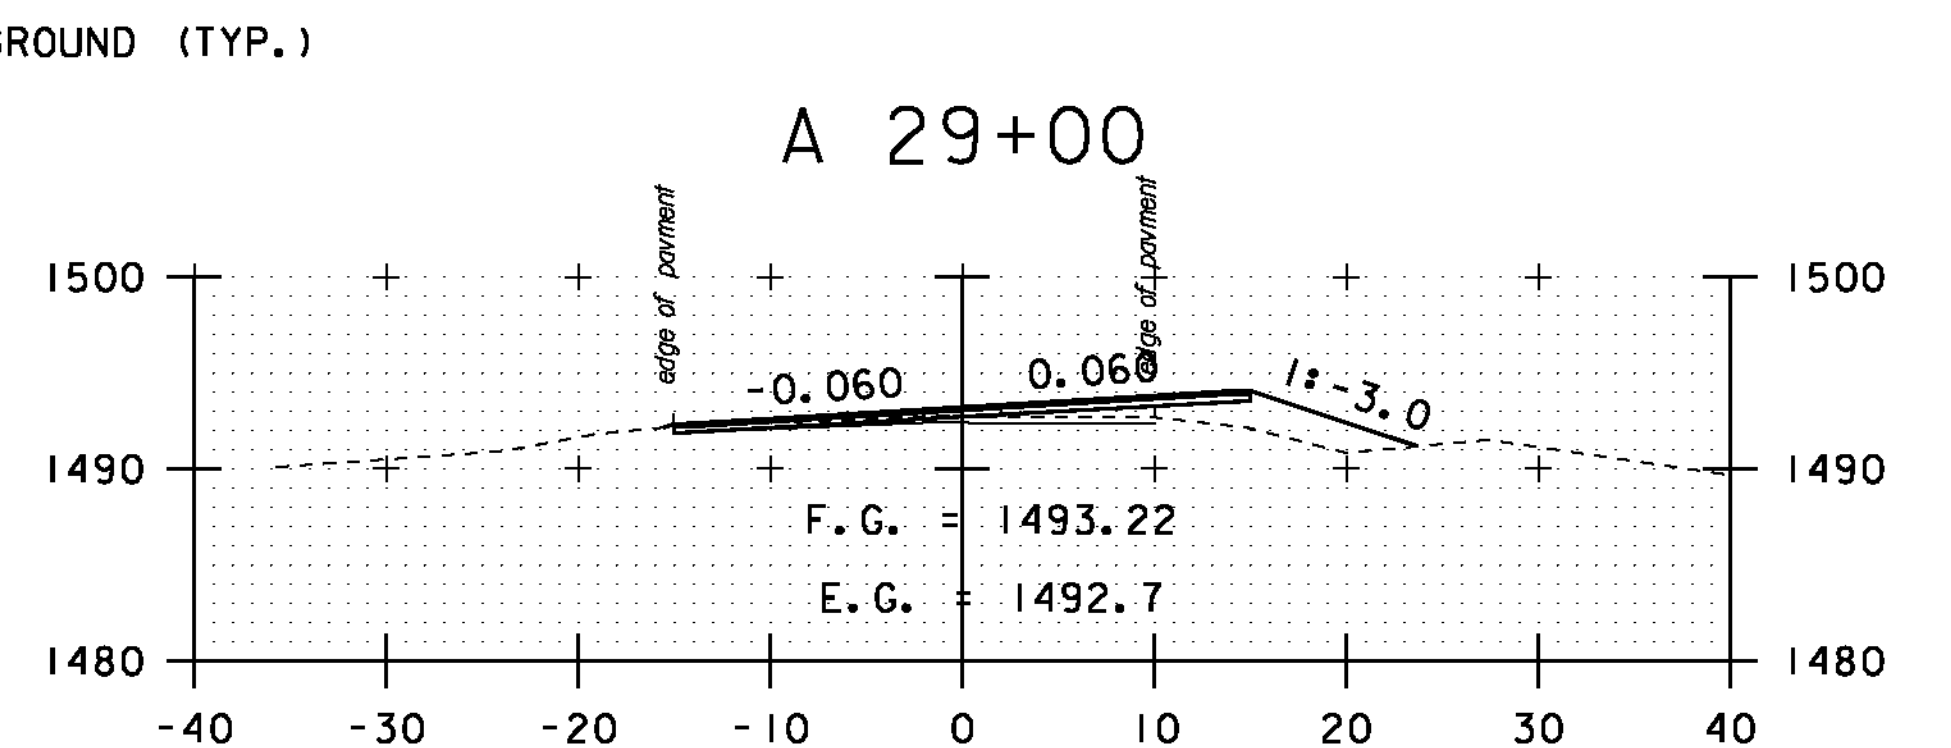


A 28+50

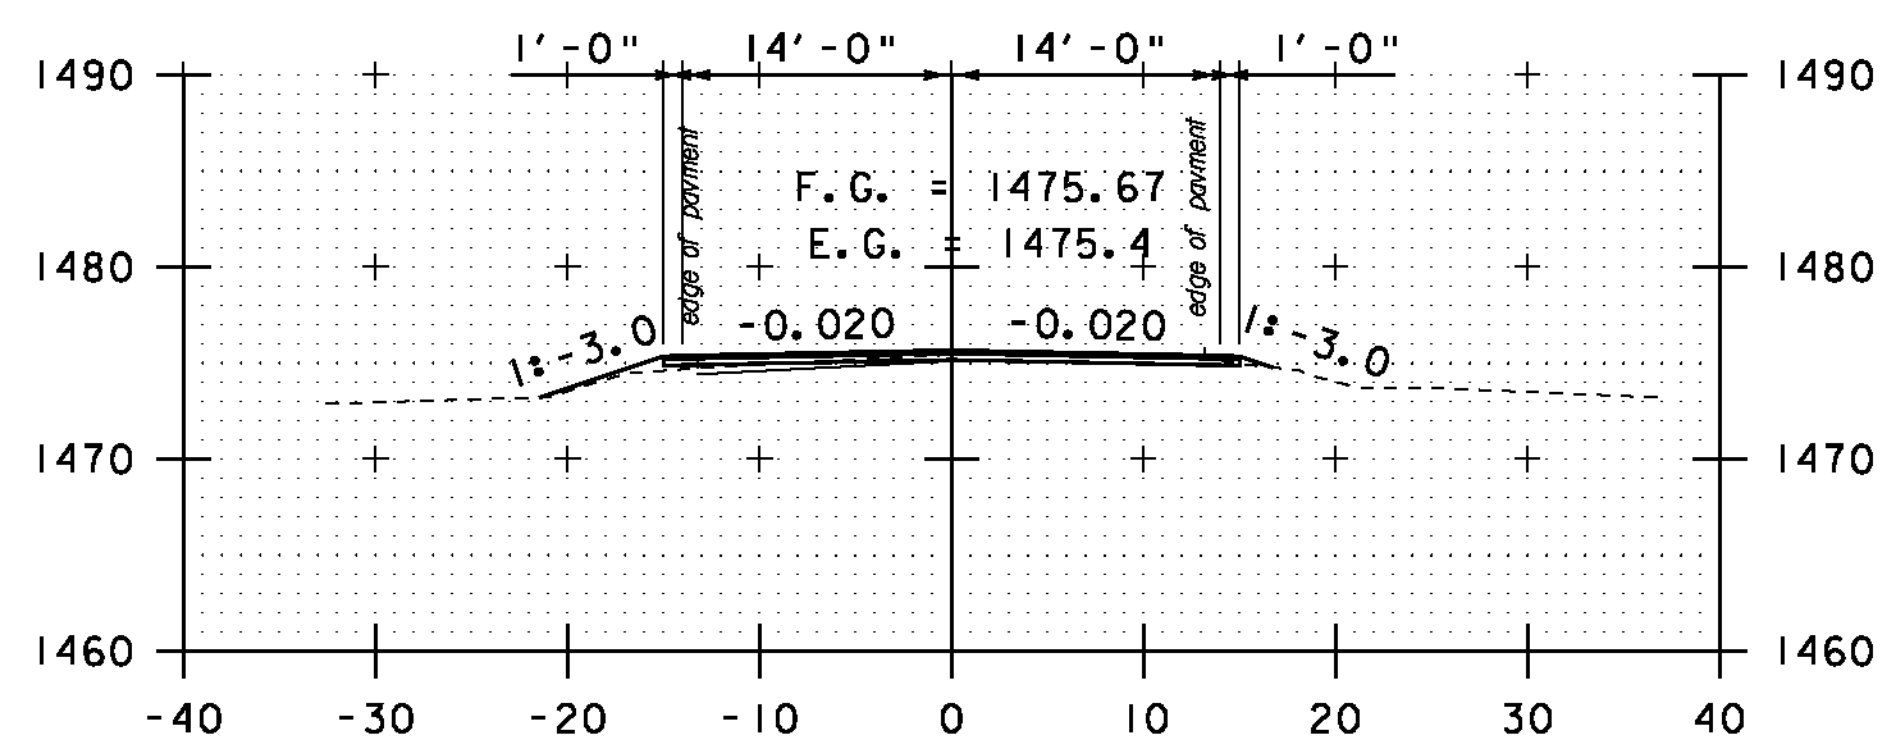

A 24+00

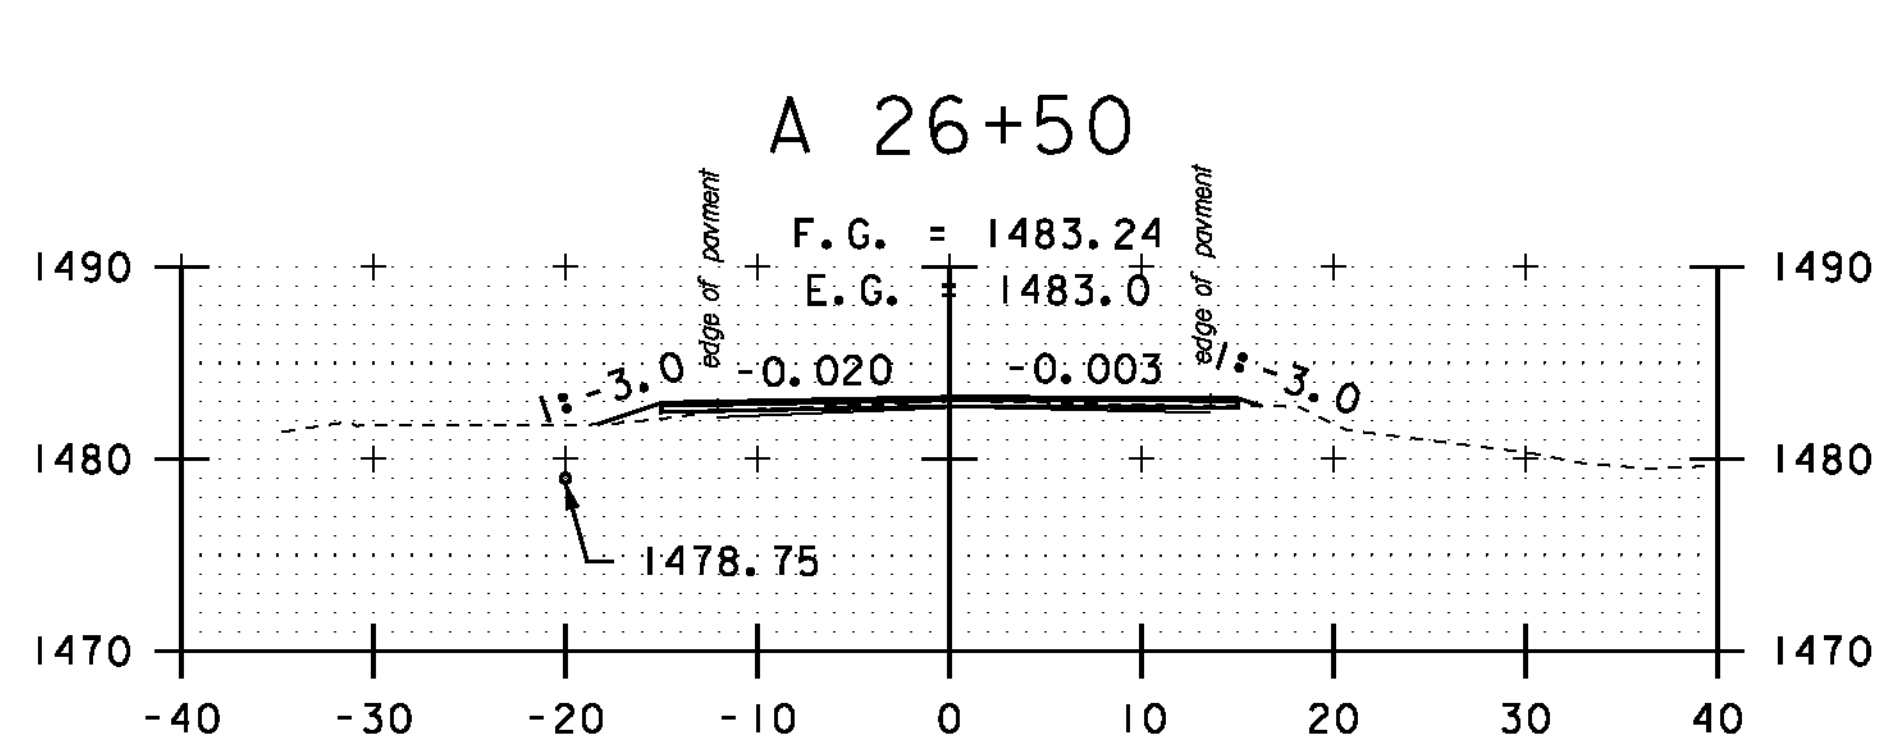

A 26+00

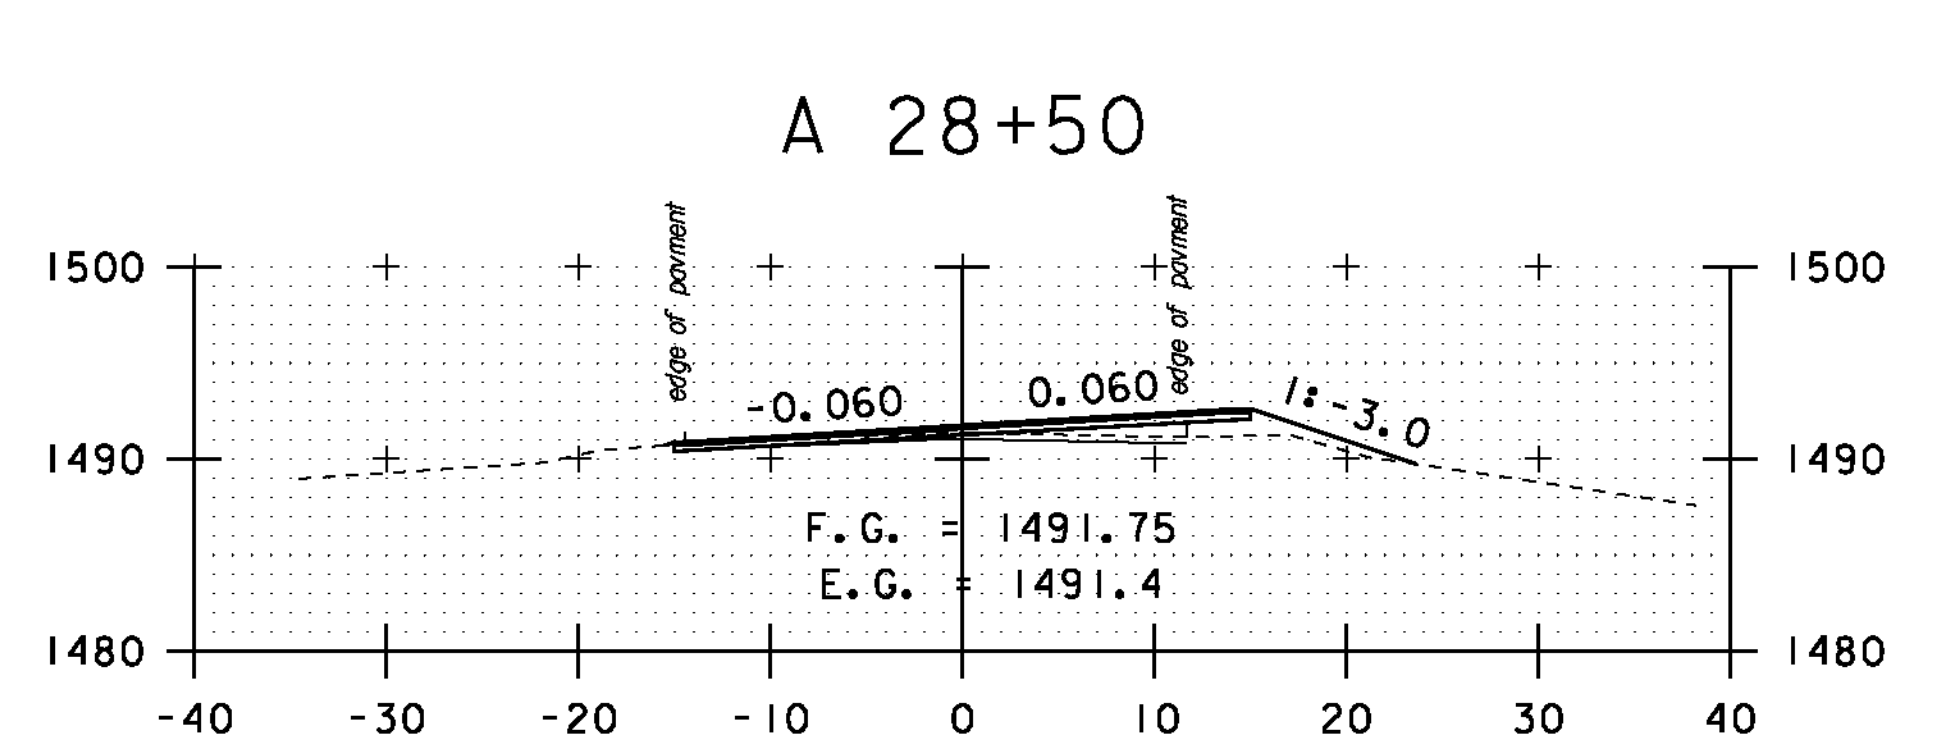

A 28+00

STA. A 24+00 TO STA. A 29+50



**CROSS SECTION SHEET 42**

PROJECT NAME: MONTGOMERY-WESTFIELD  
 PROJECT NUMBER: STP 2906(I)  
 FILE NAME: p10ci90.dgn  
 PROJECT LEADER: CDL  
 DESIGNED BY: SJL  
 PLOT FILE: p10ci90\_156.1  
 PLOT DATE: 9/5/12  
 DRAWN BY: SJL  
 CHECKED BY: CDL  
 SHEET 156 OF 178