




A 31+50

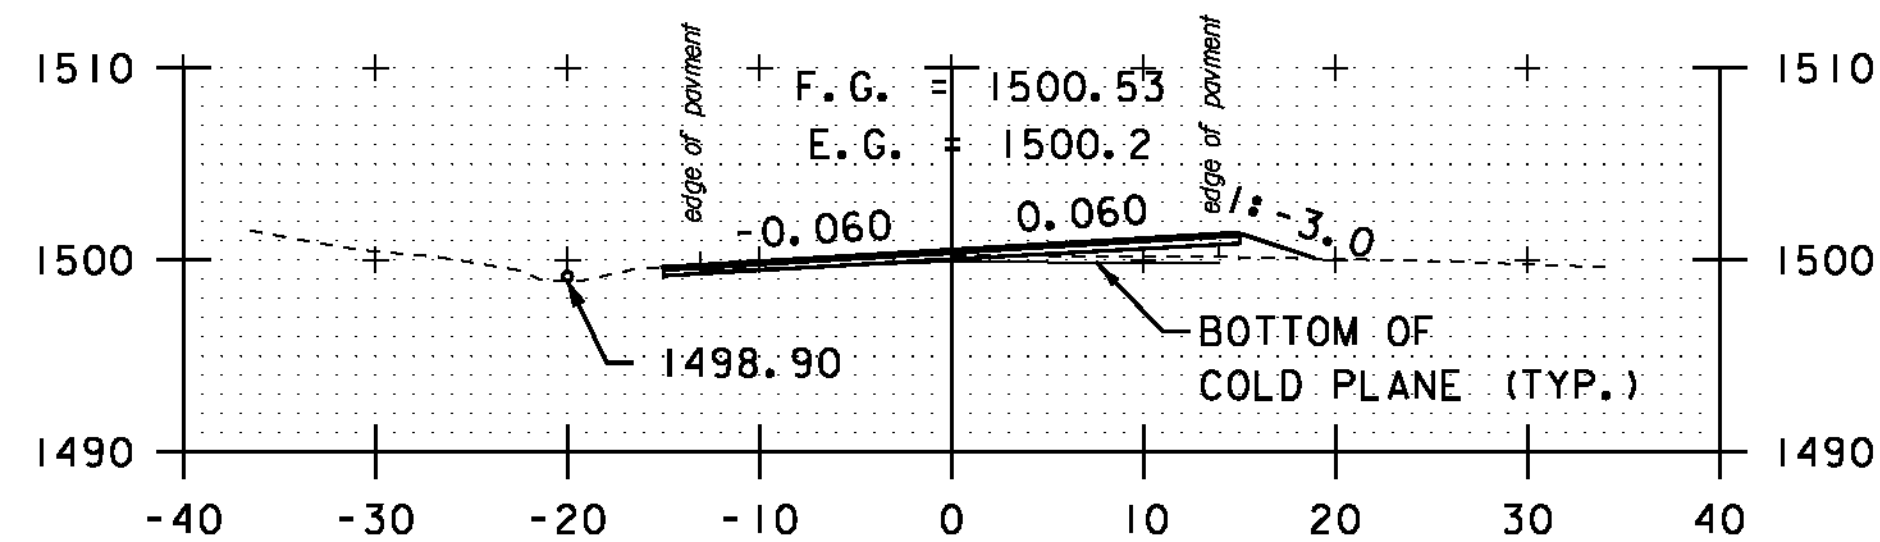


A 31+00

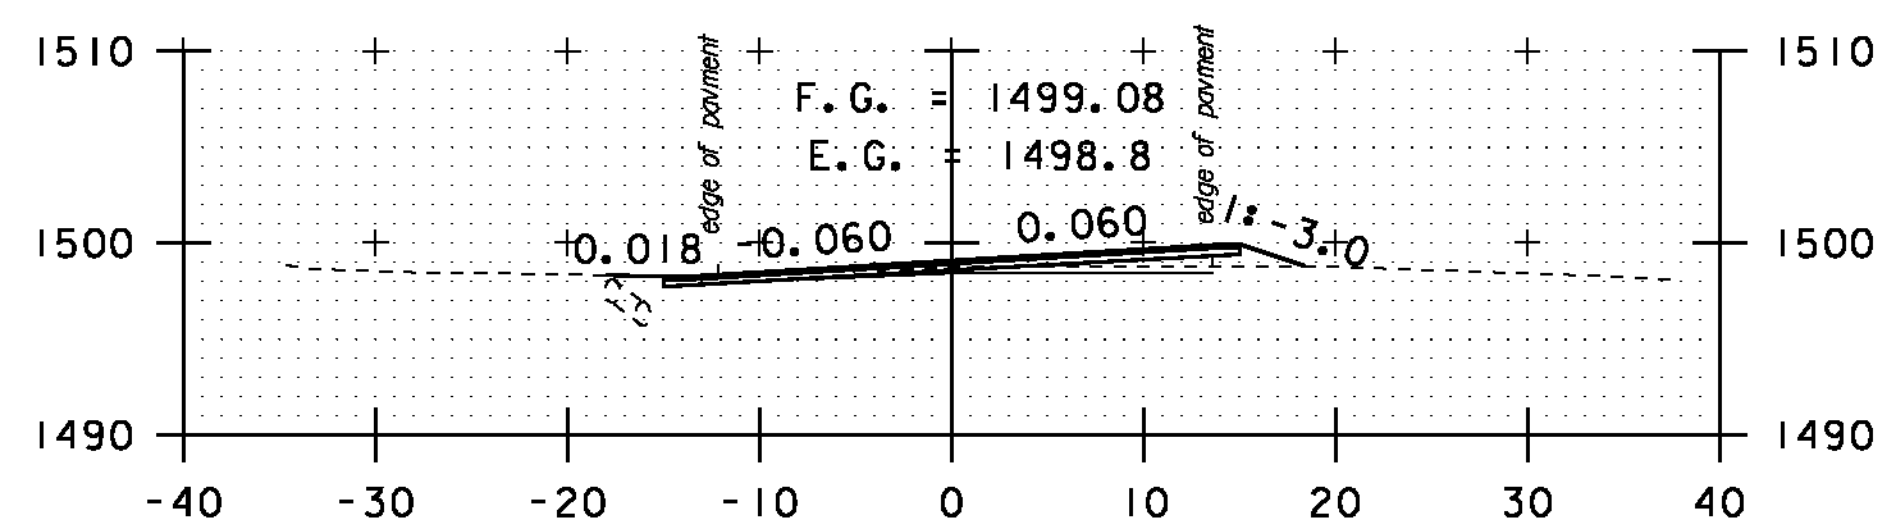


DRIVE LT
A 30+50

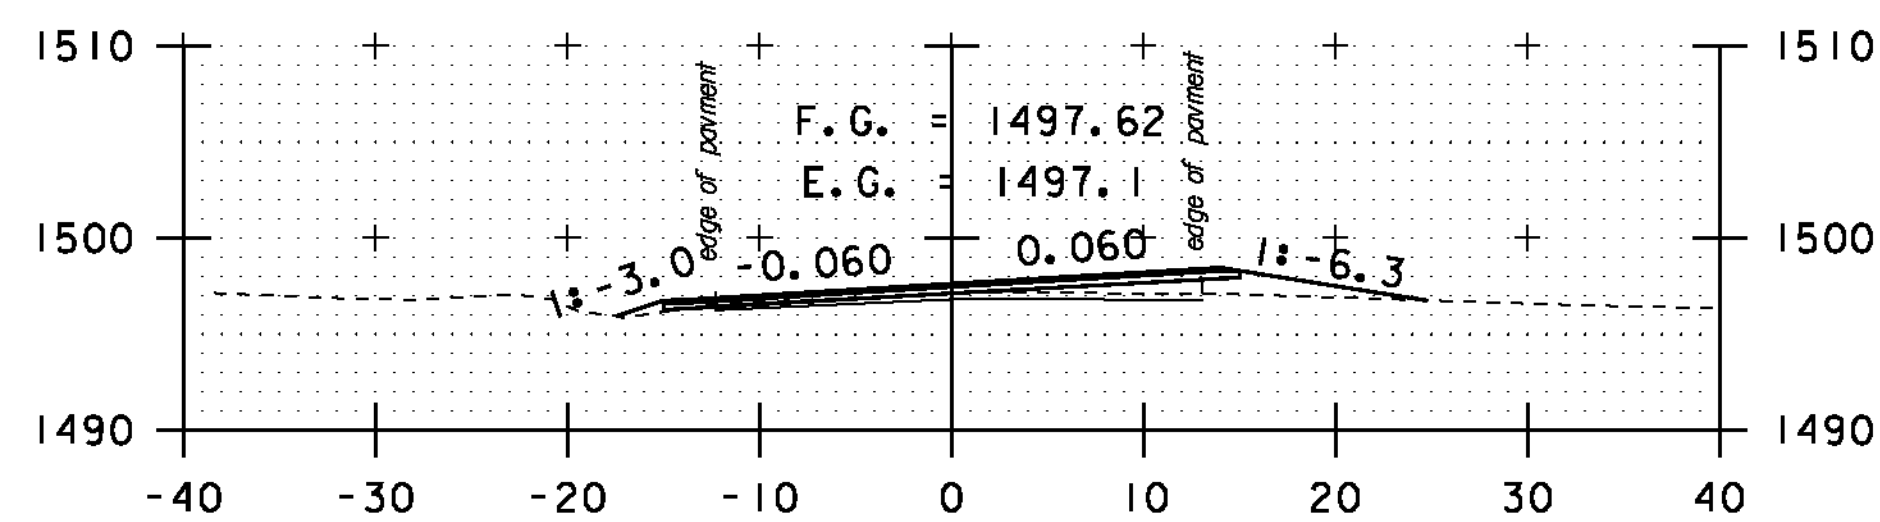


DRIVE RT
A 30+00

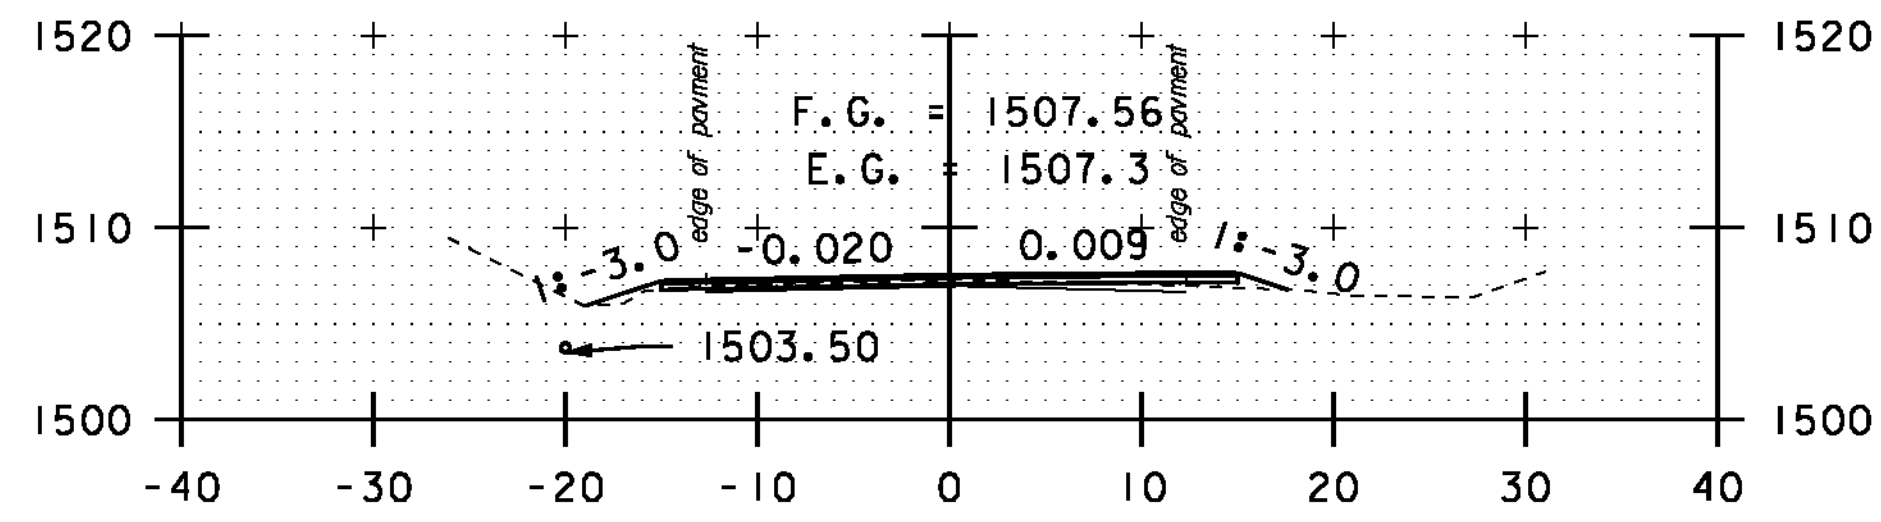


A 33+50

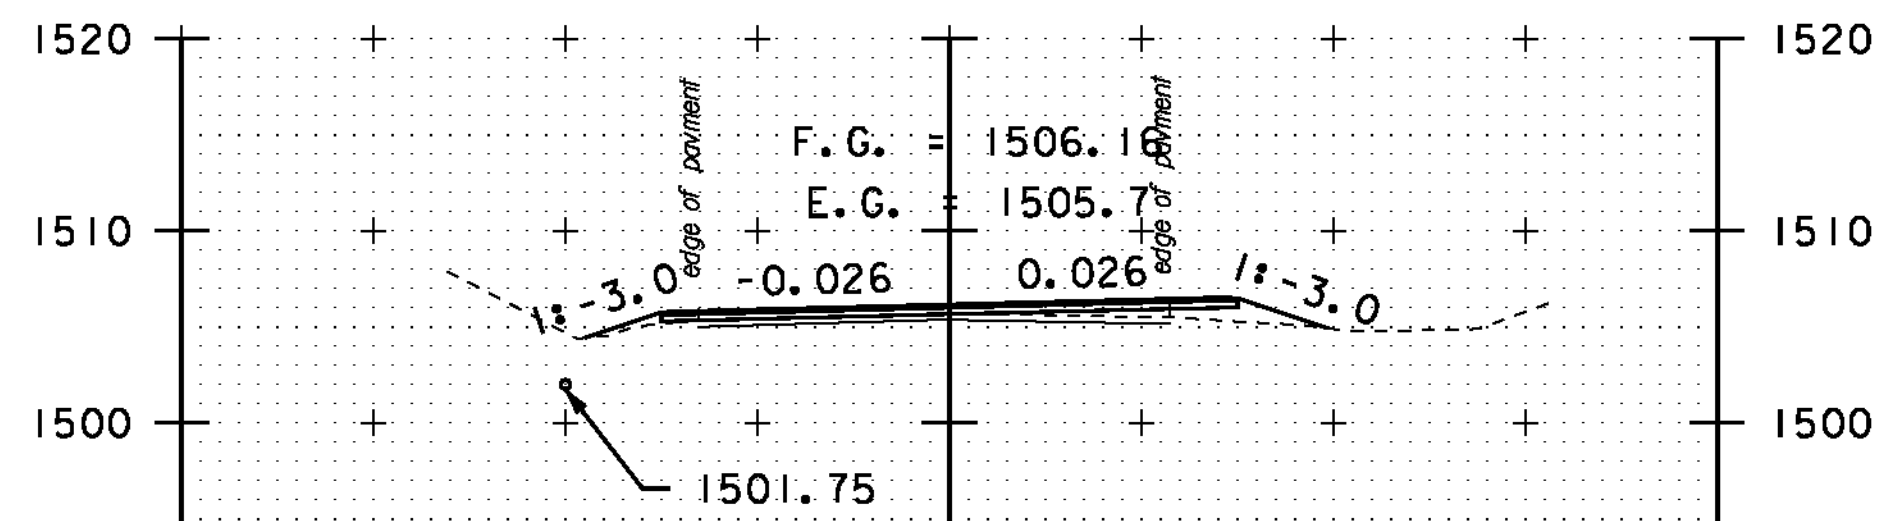


A 33+00

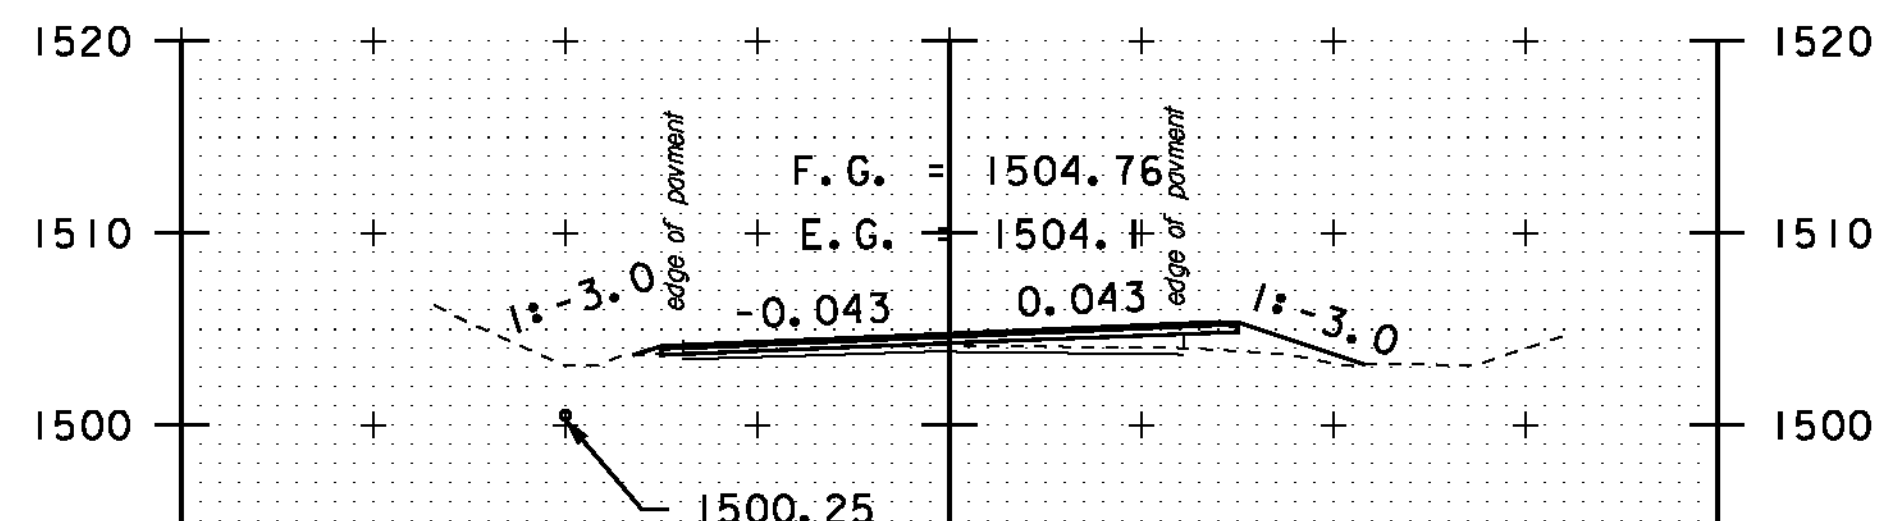


A 32+50

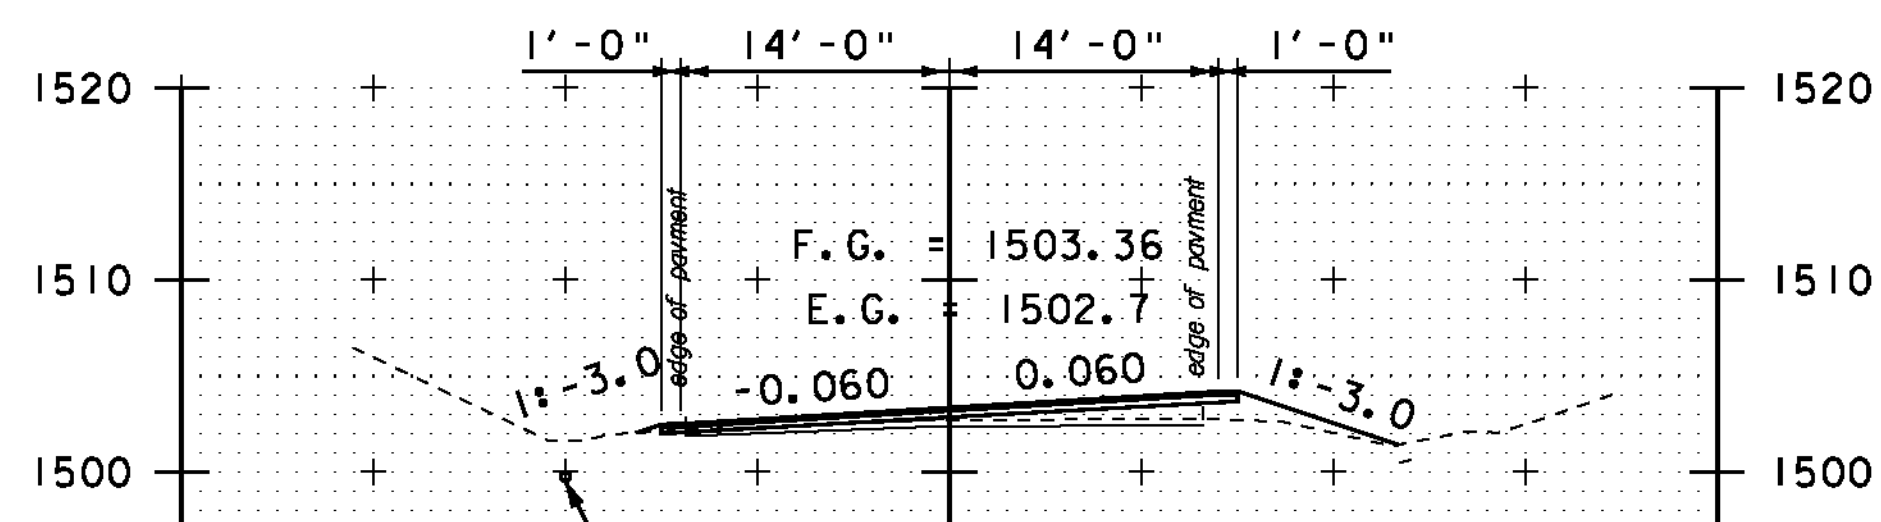


A 32+00

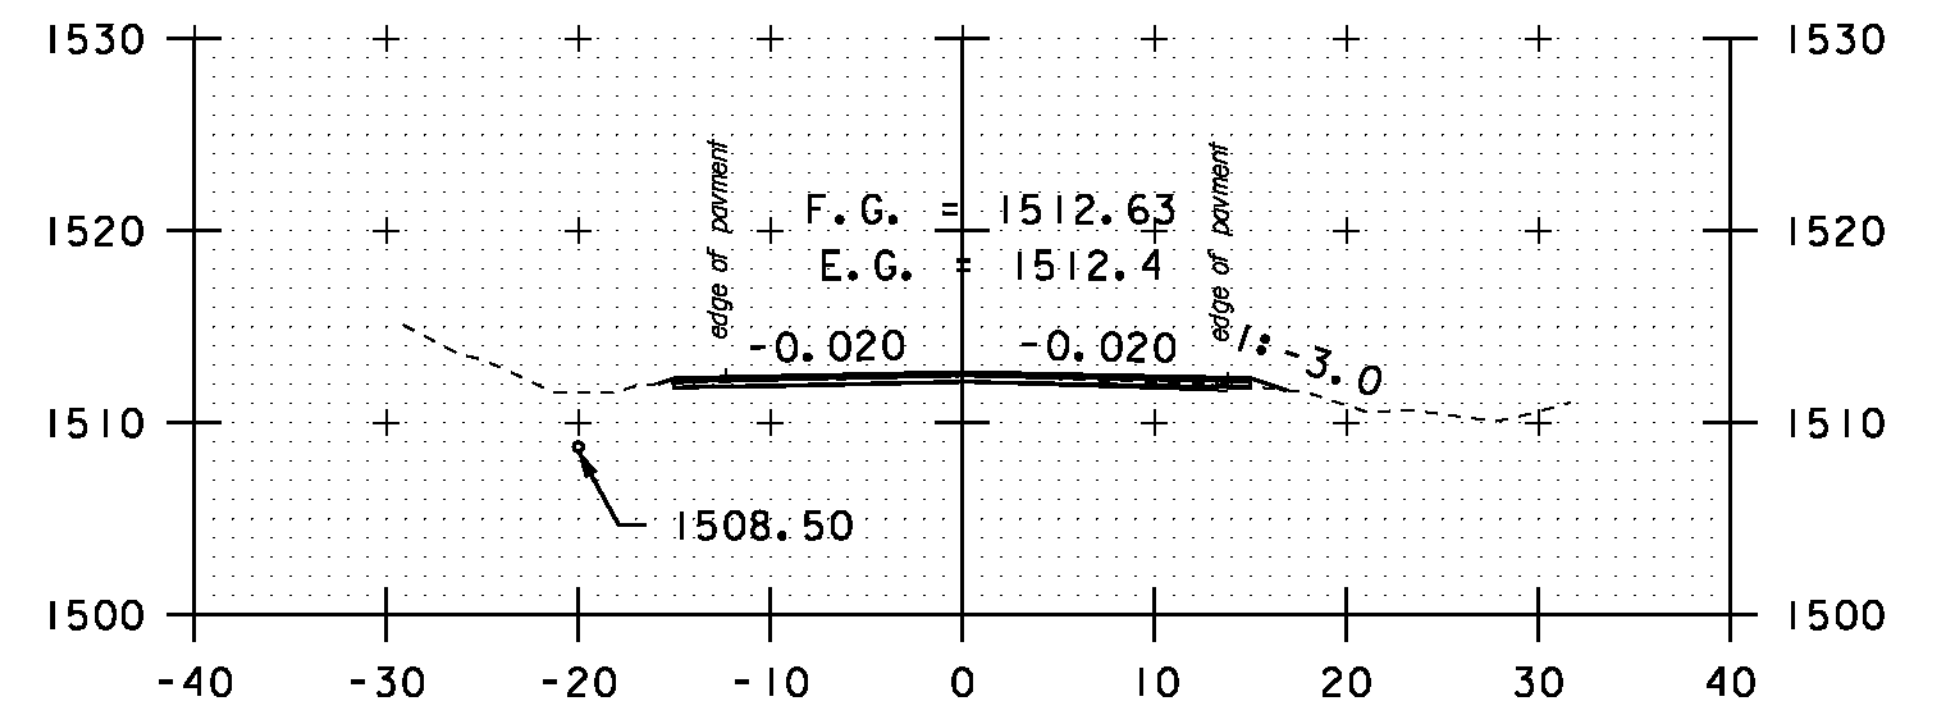


A 35+50

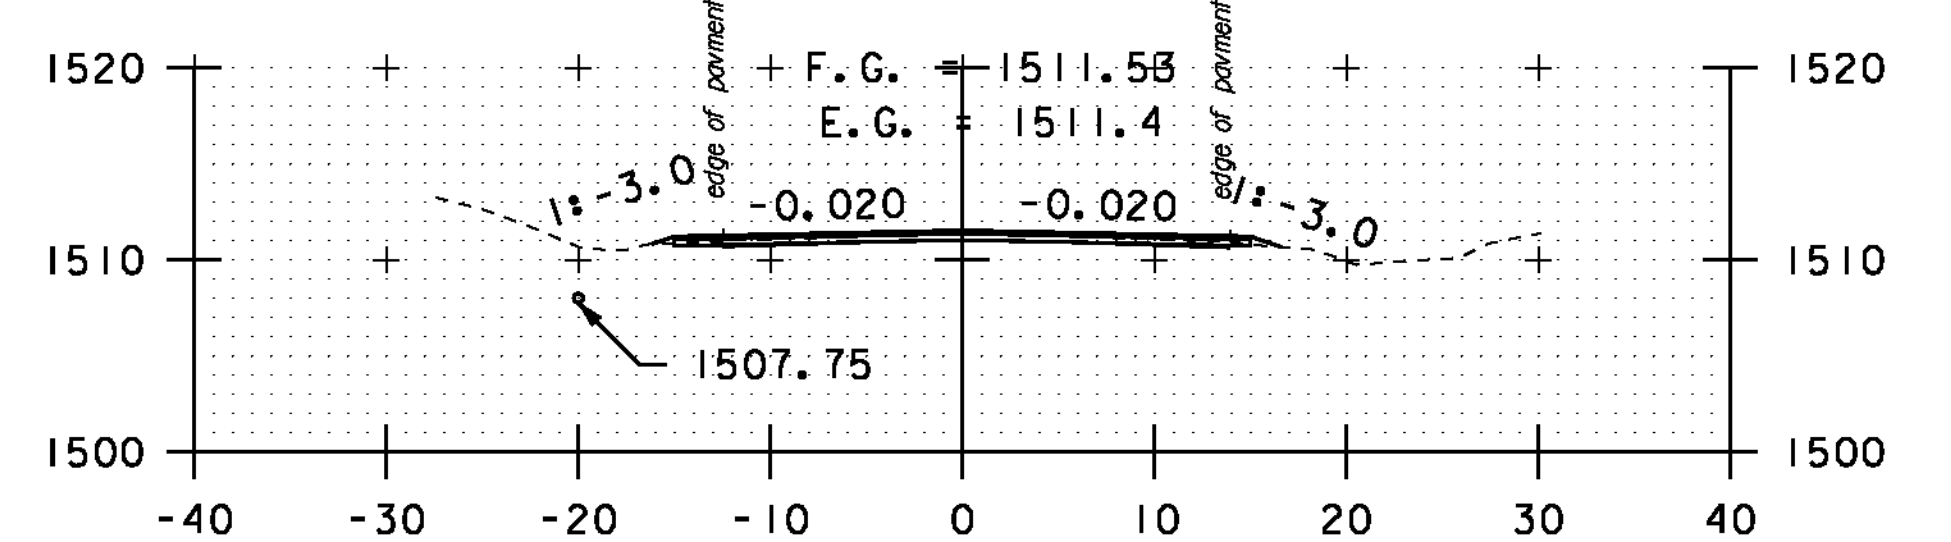

A 35+00

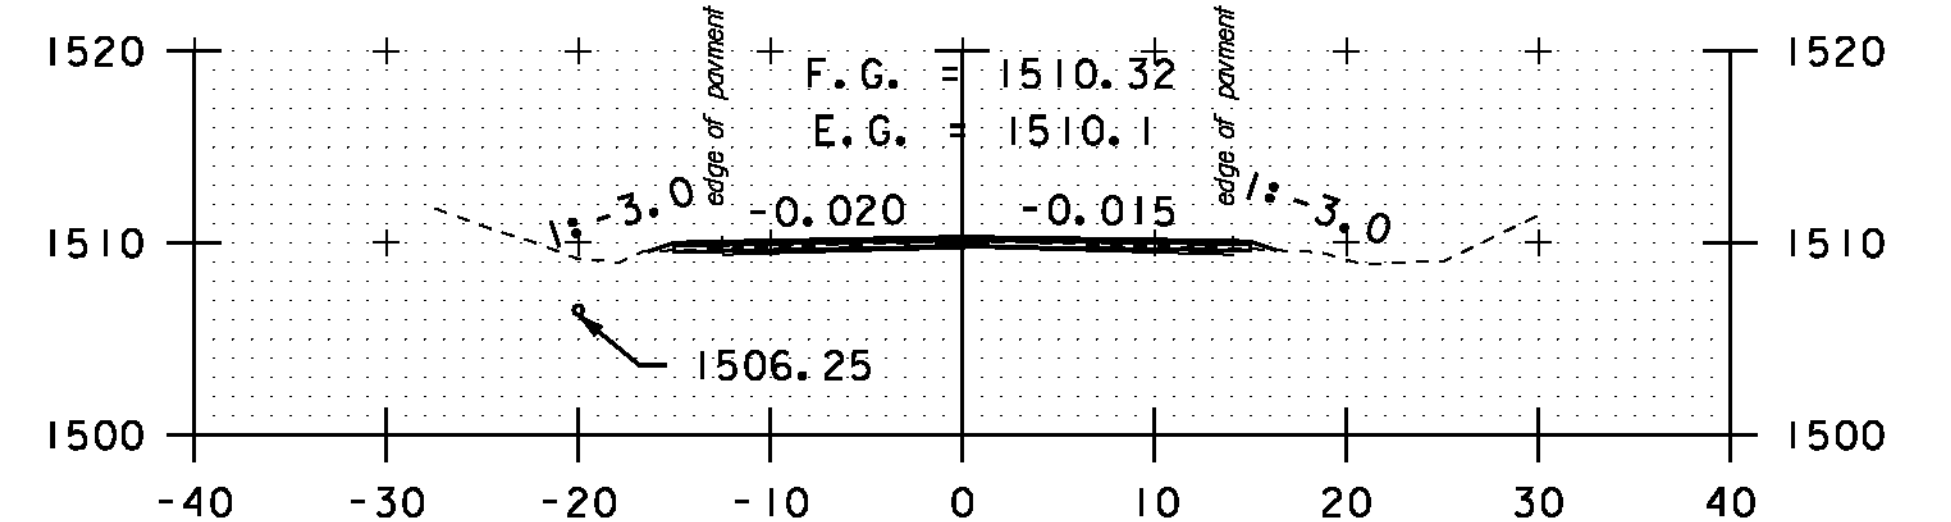


A 34+50

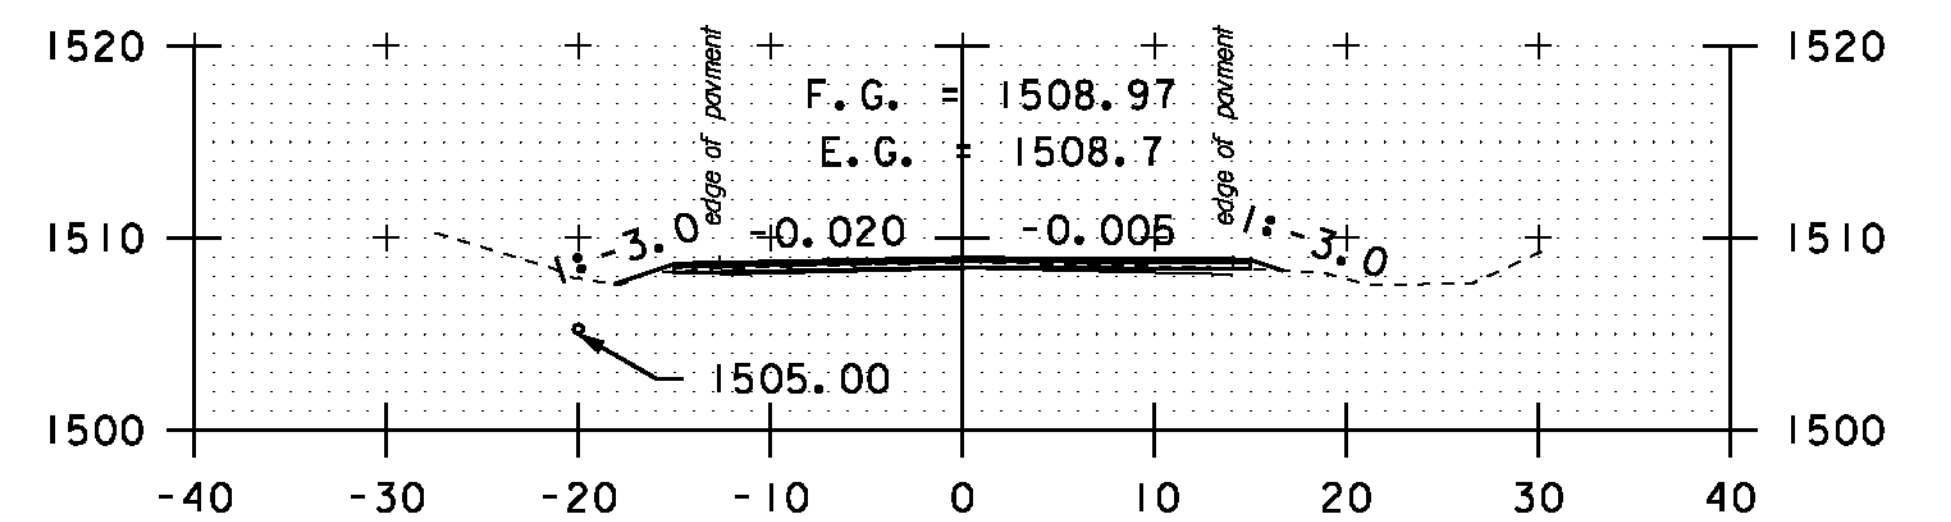

A 34+00

STA. A 30+00 TO STA. A 35+50

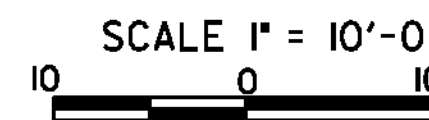

CROSS SECTION SHEET 43

PROJECT NAME: MONTGOMERY-WESTFIELD
PROJECT NUMBER: STP 2906(I)
FILE NAME: p10ci90.dgn
PROJECT LEADER: CDL
DESIGNED BY: SJL
PLOT FILE: p10ci90_157.J
PLOT DATE: 9/5/12
DRAWN BY: SJL
CHECKED BY: CDL
SHEET 157 OF 178