




A 37+50

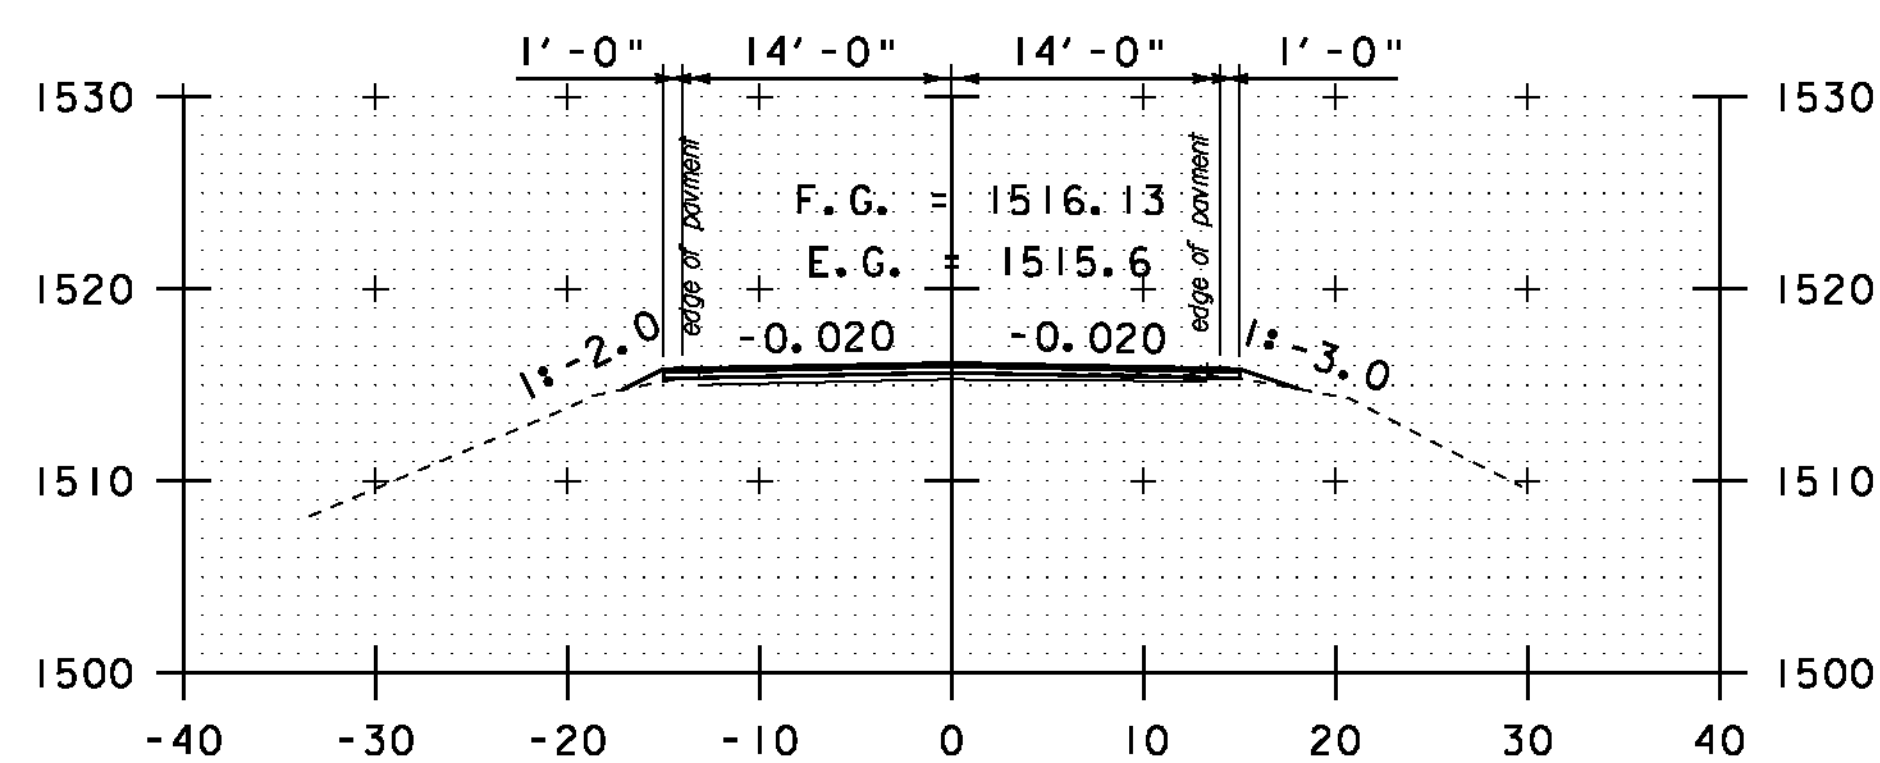


A 37+00

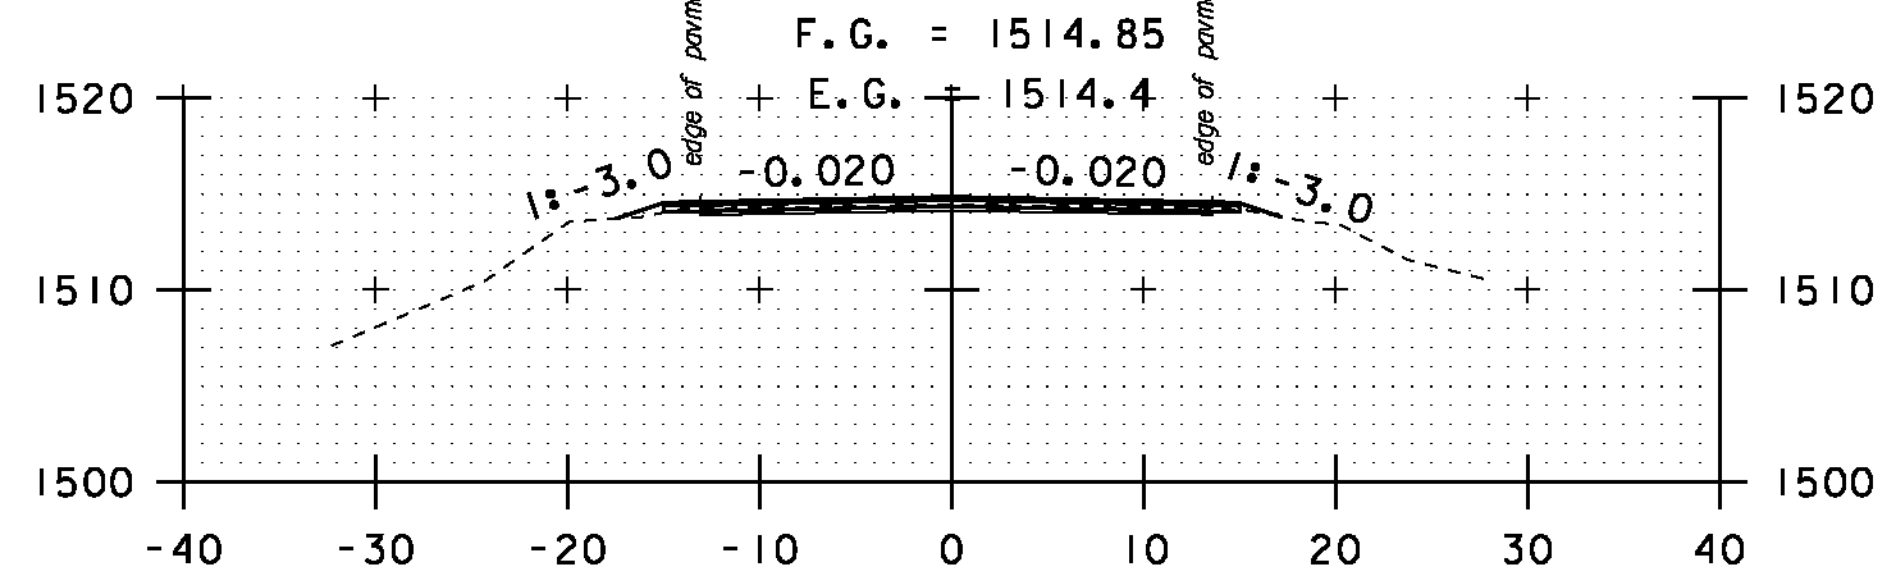


A 36+50

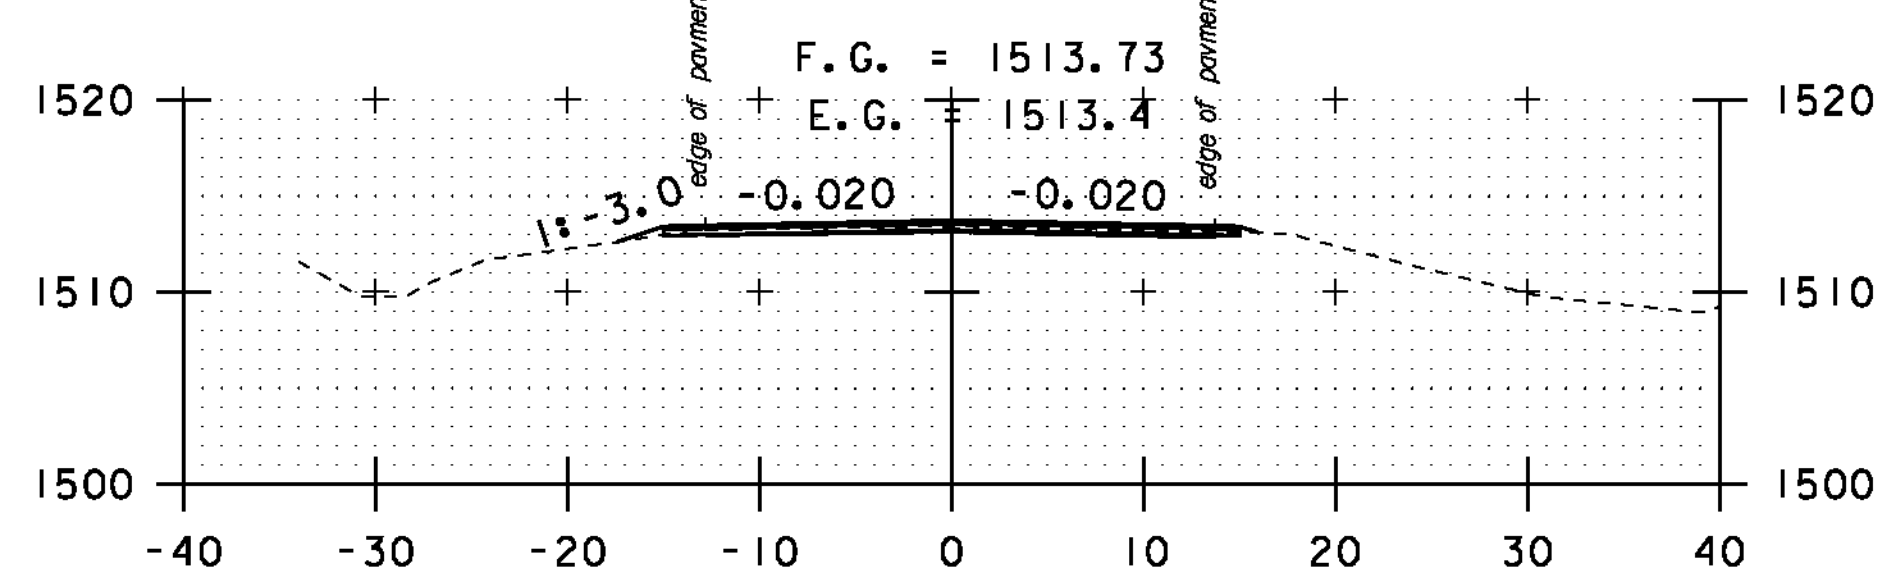


A 36+00

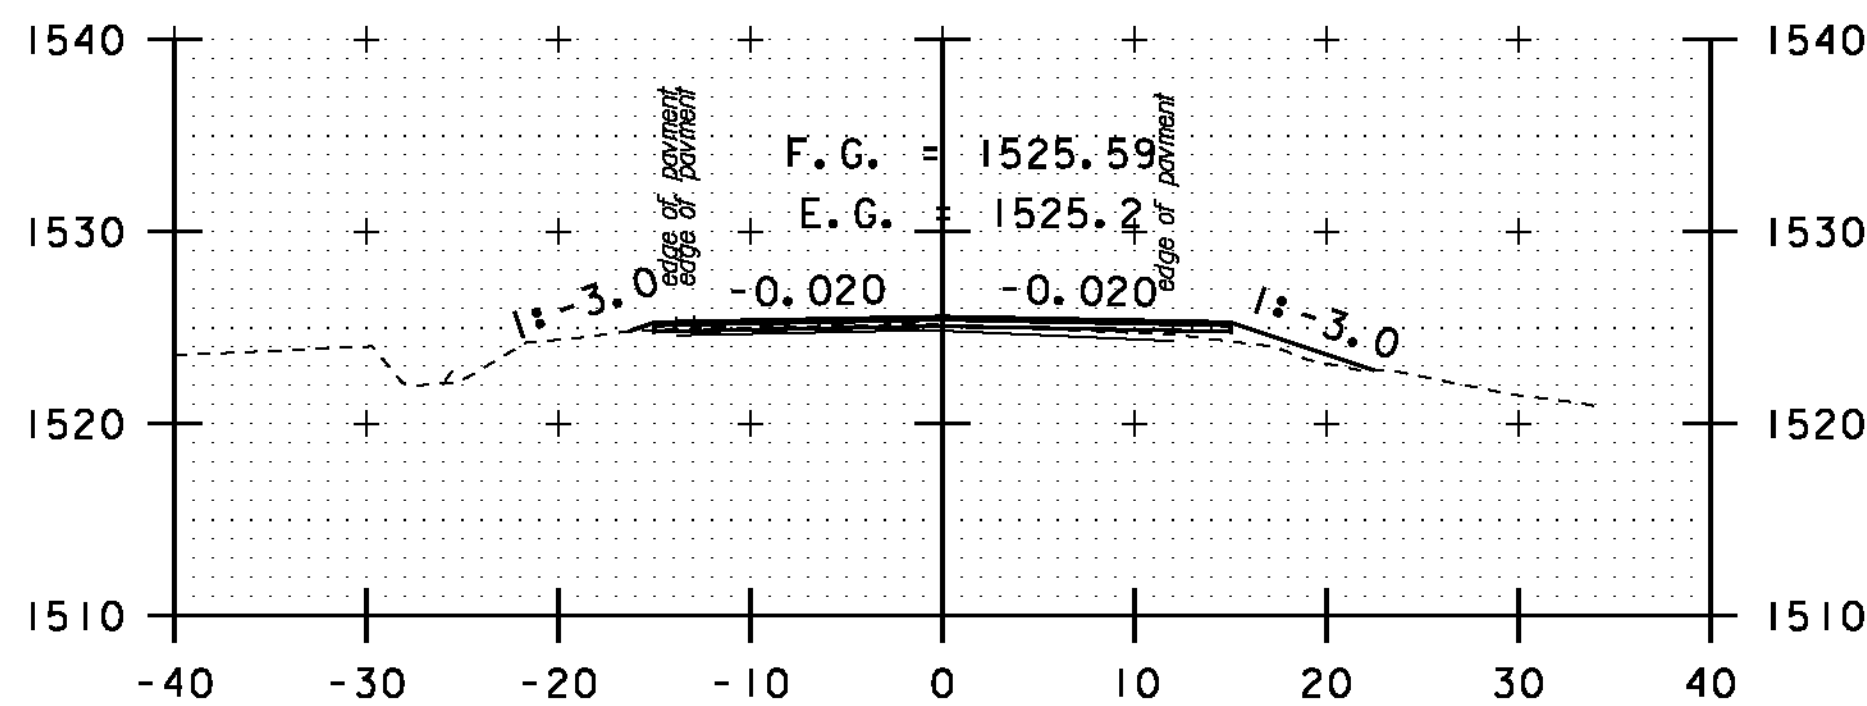


A 39+50

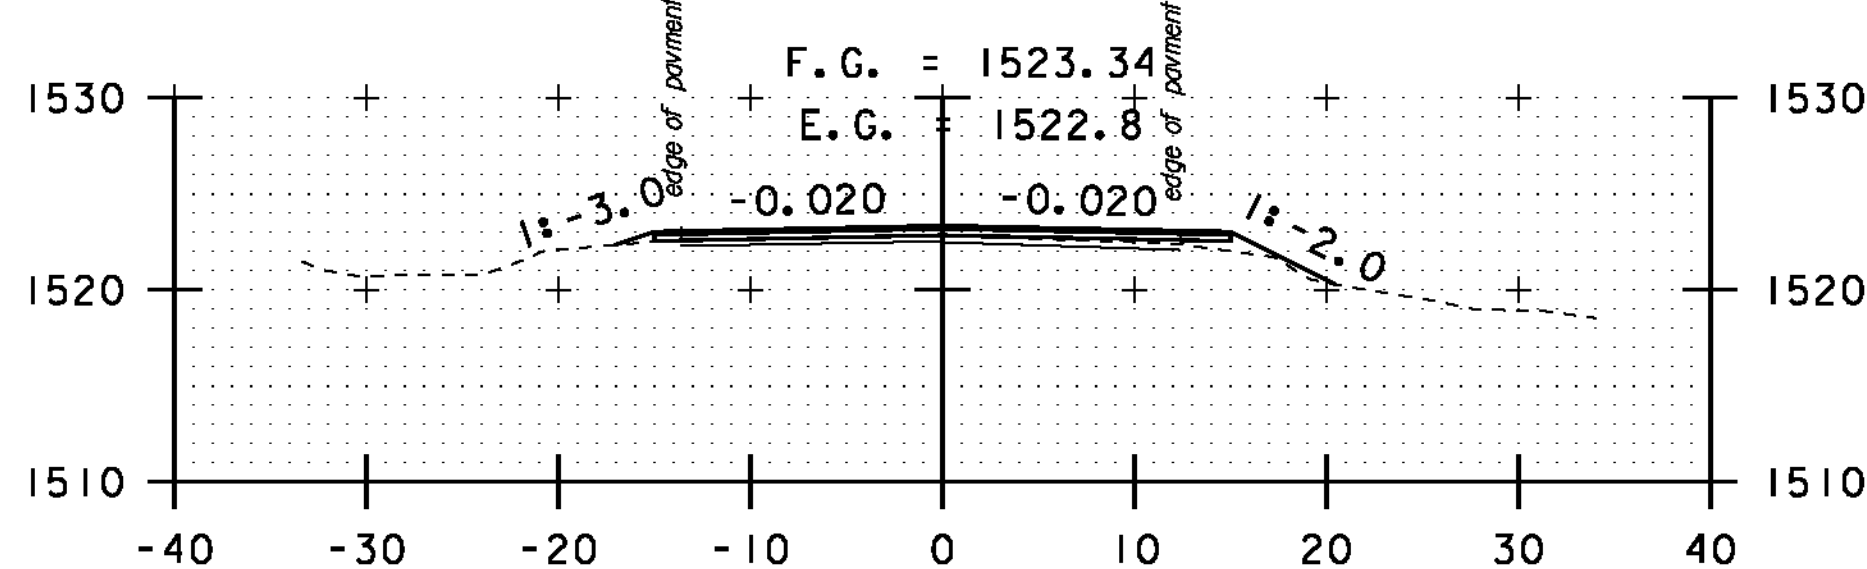


A 39+00

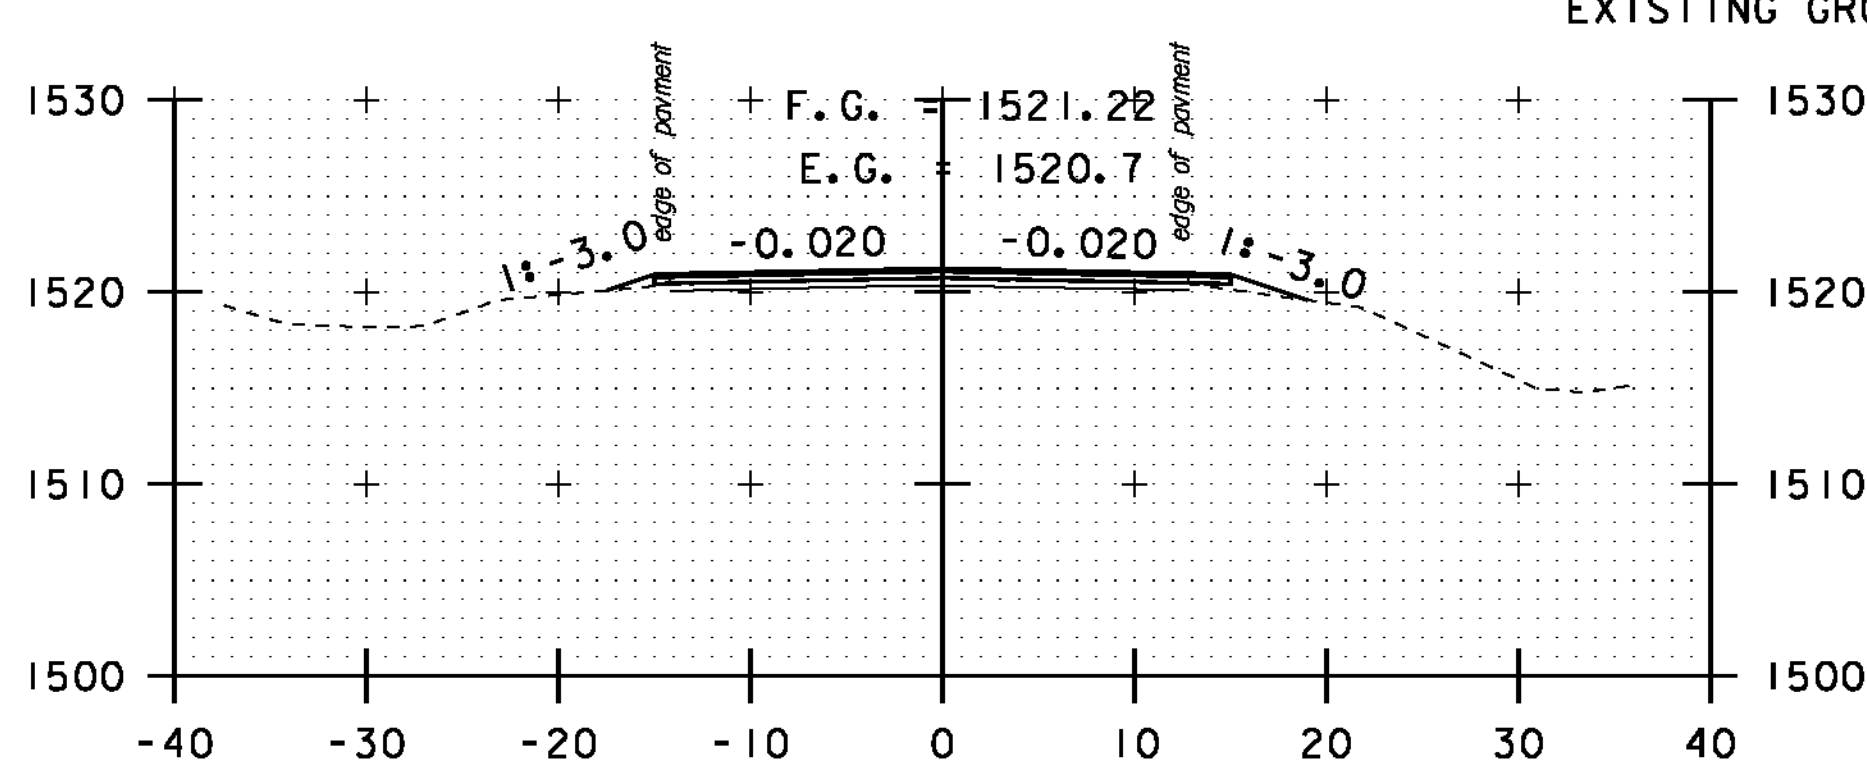


A 38+50

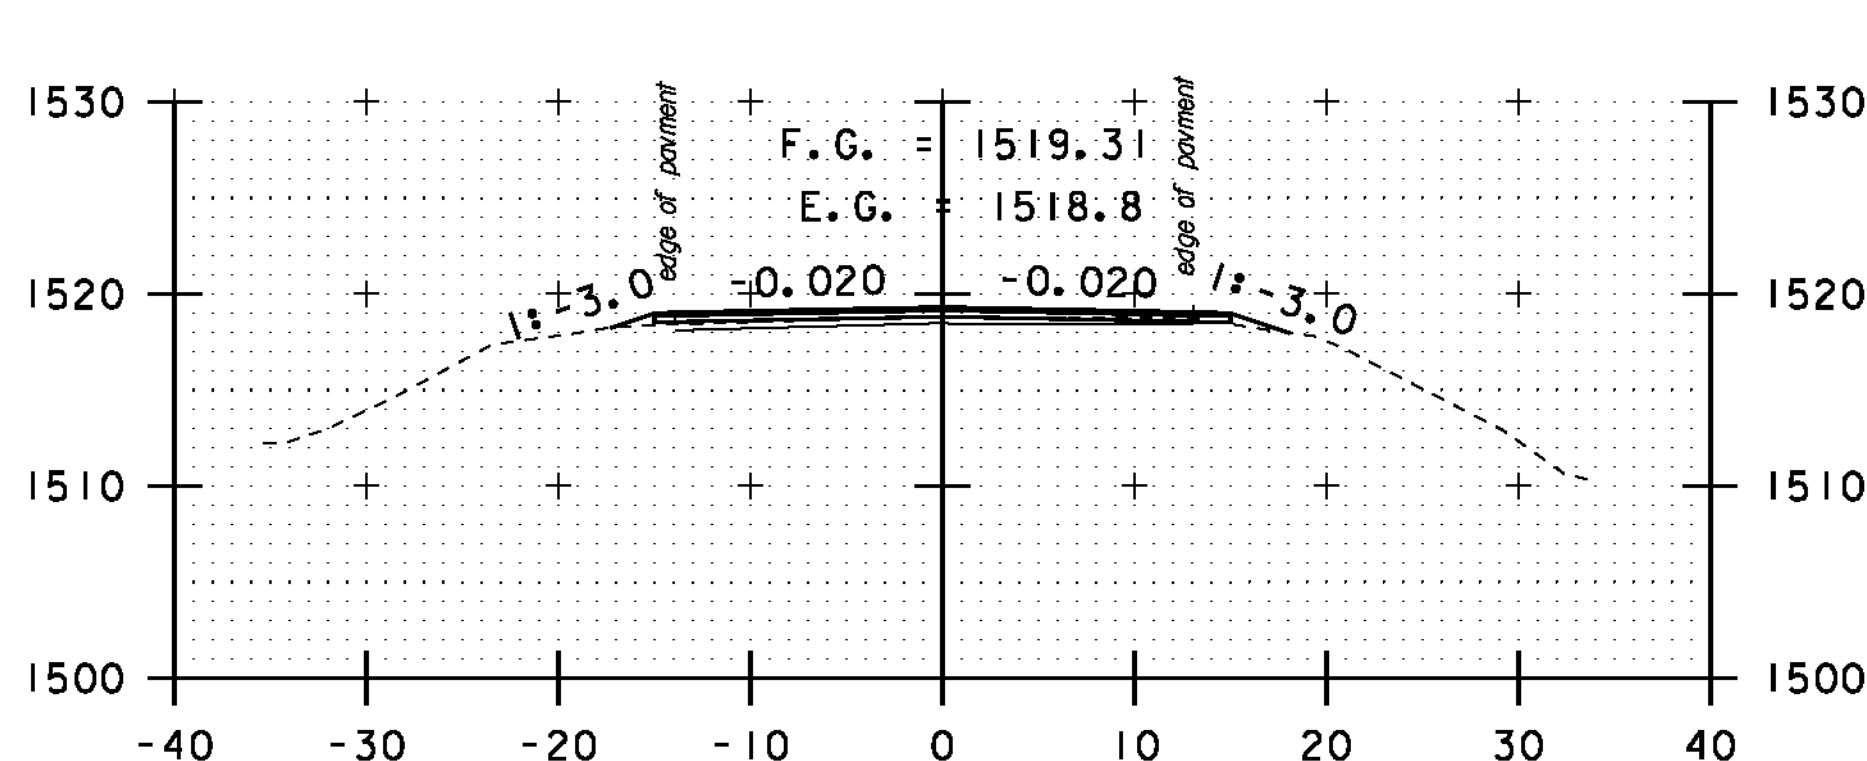


A 38+00

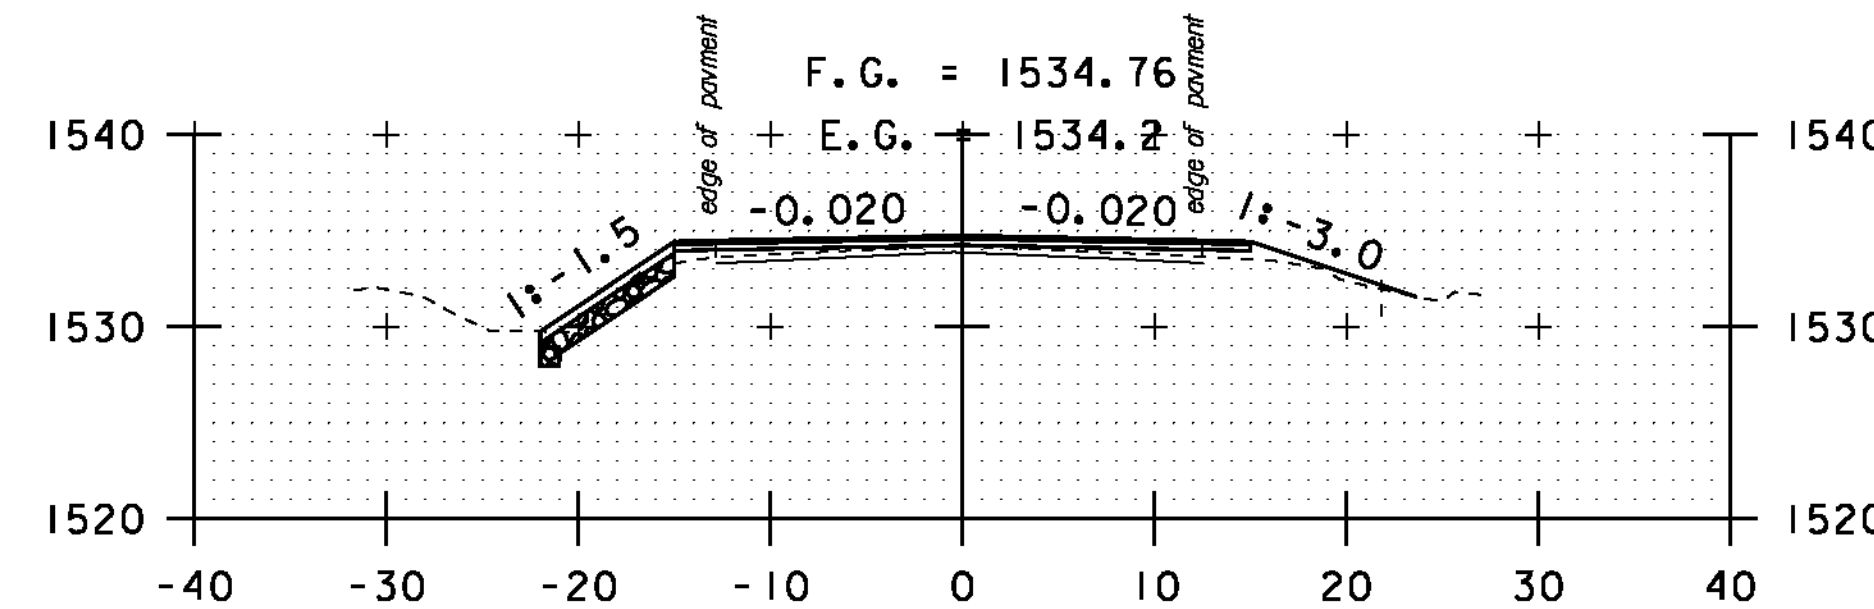


A 41+50

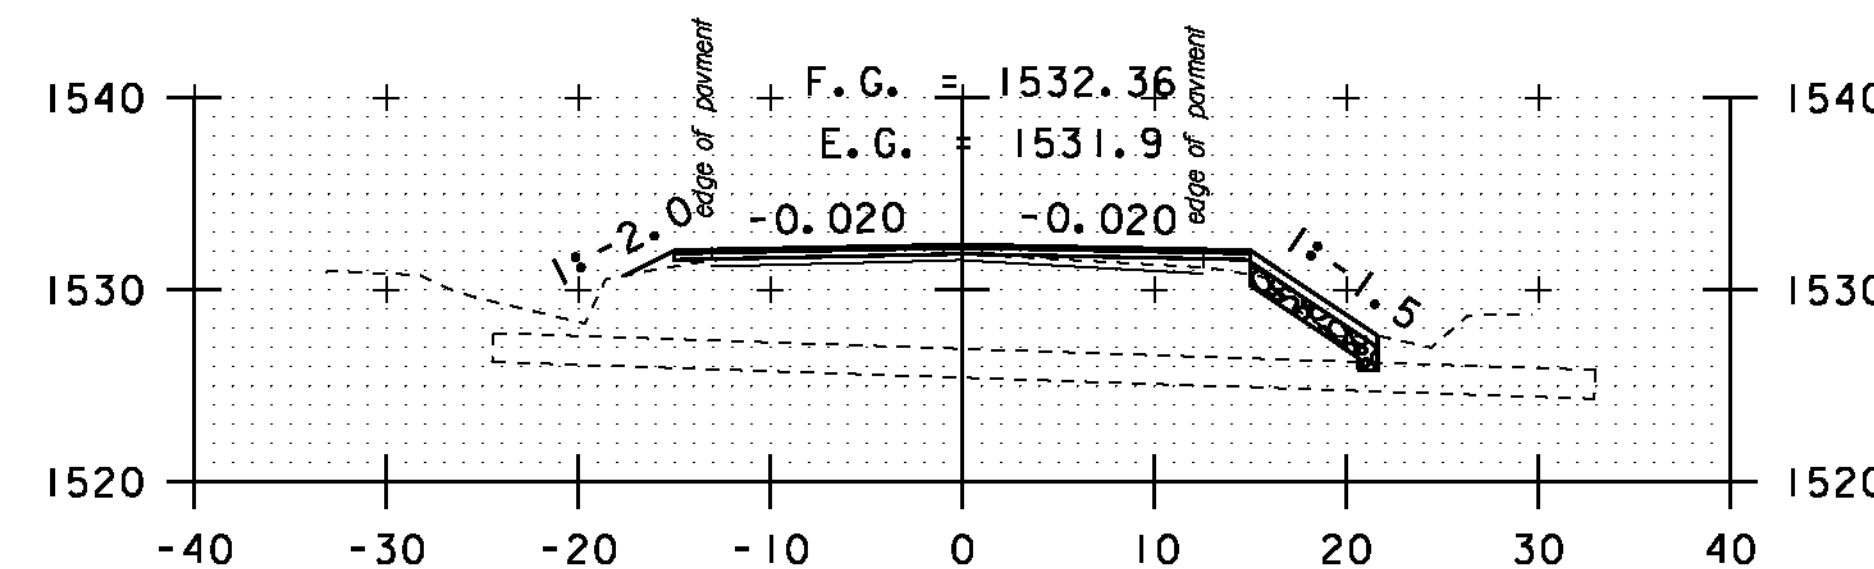

A 41+00

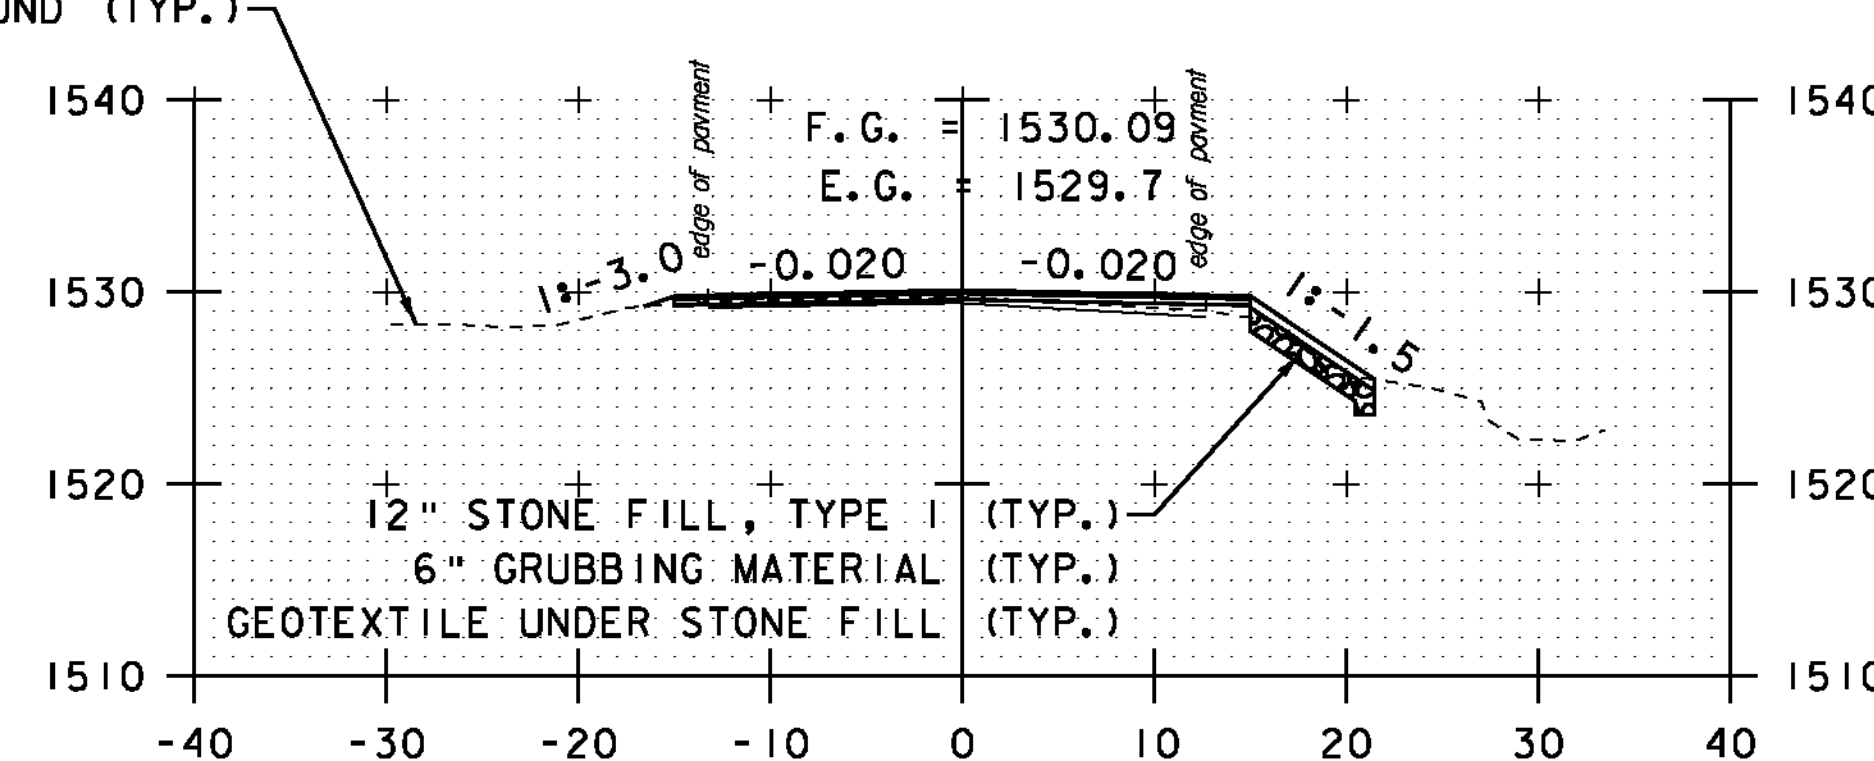


A 40+50

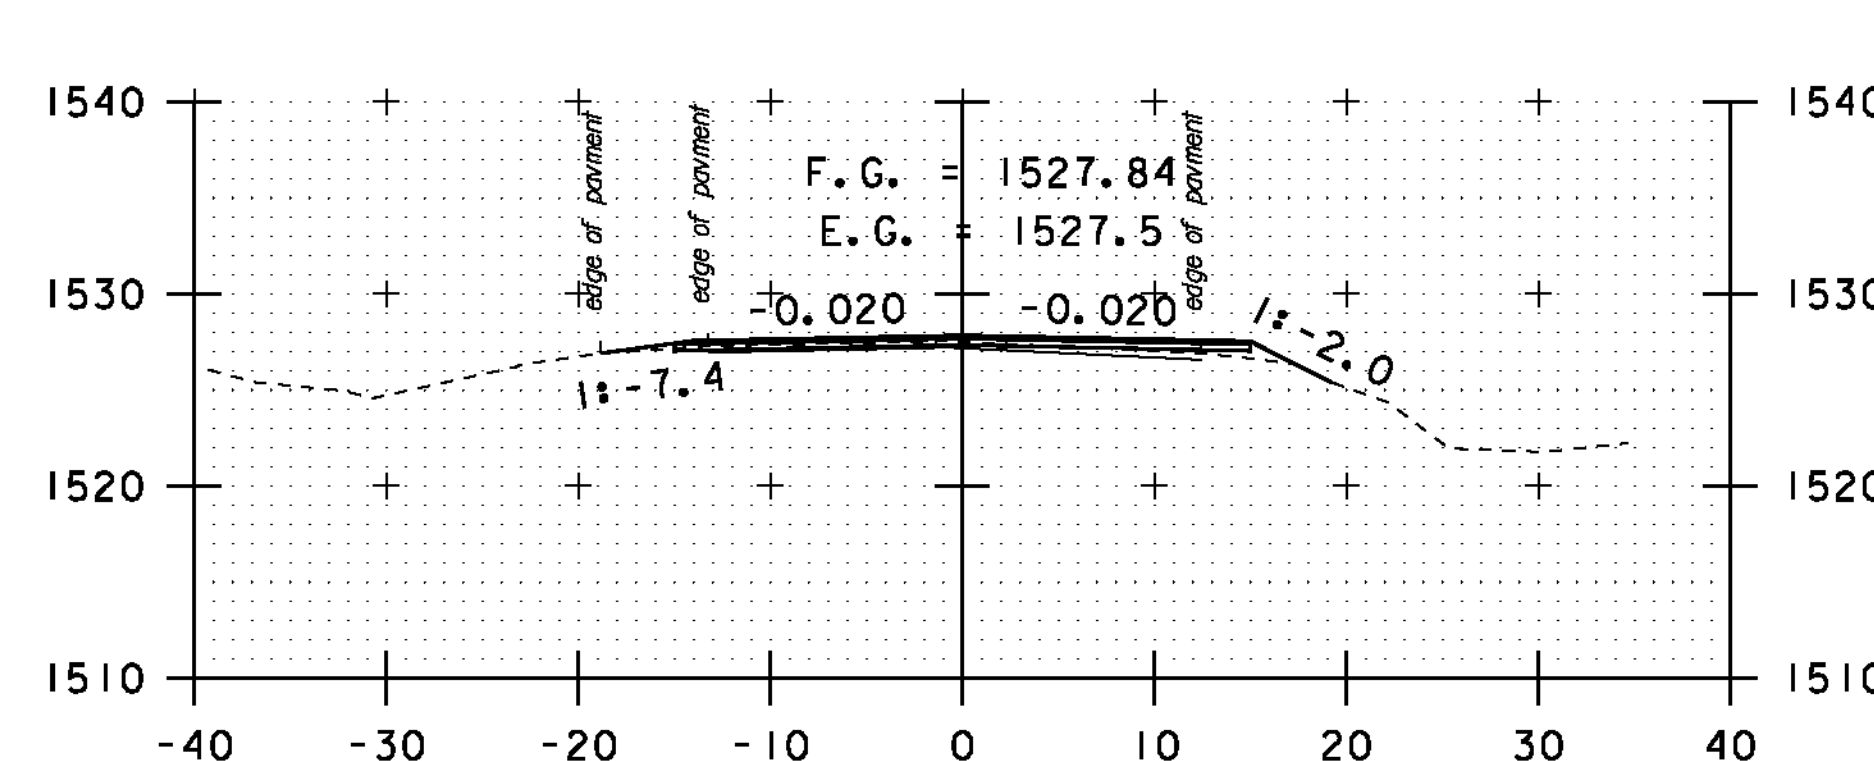

DRIVE LT  
A 40+00

STA. A 36+00 TO STA. A 41+50

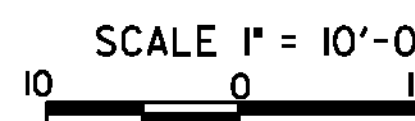

**CROSS SECTION SHEET 44**

PROJECT NAME: MONTGOMERY-WESTFIELD  
 PROJECT NUMBER: STP 2906(I)  
 FILE NAME: p10ci90.dgn  
 PROJECT LEADER: CDL  
 DESIGNED BY: SJL  
 PLOT FILE: p10ci90\_158.I  
 PLOT DATE: 9/5/12  
 DRAWN BY: SJL  
 CHECKED BY: CDL  
 SHEET 158 OF 178