




A 49+50

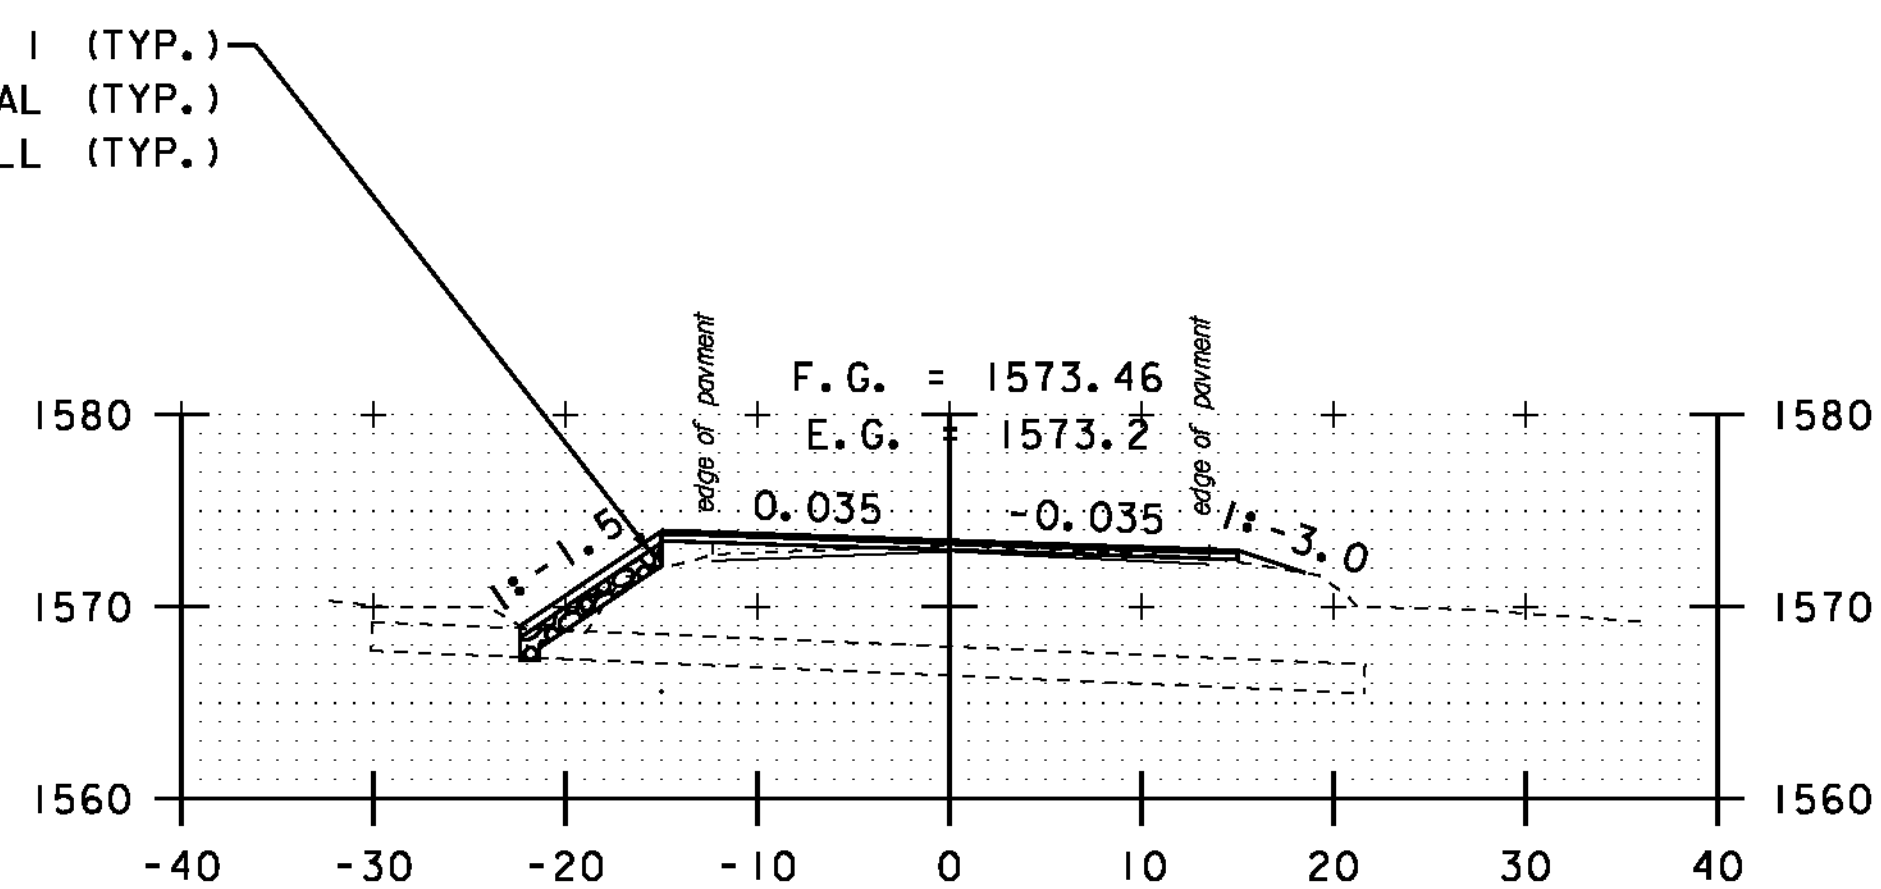


A 51+50

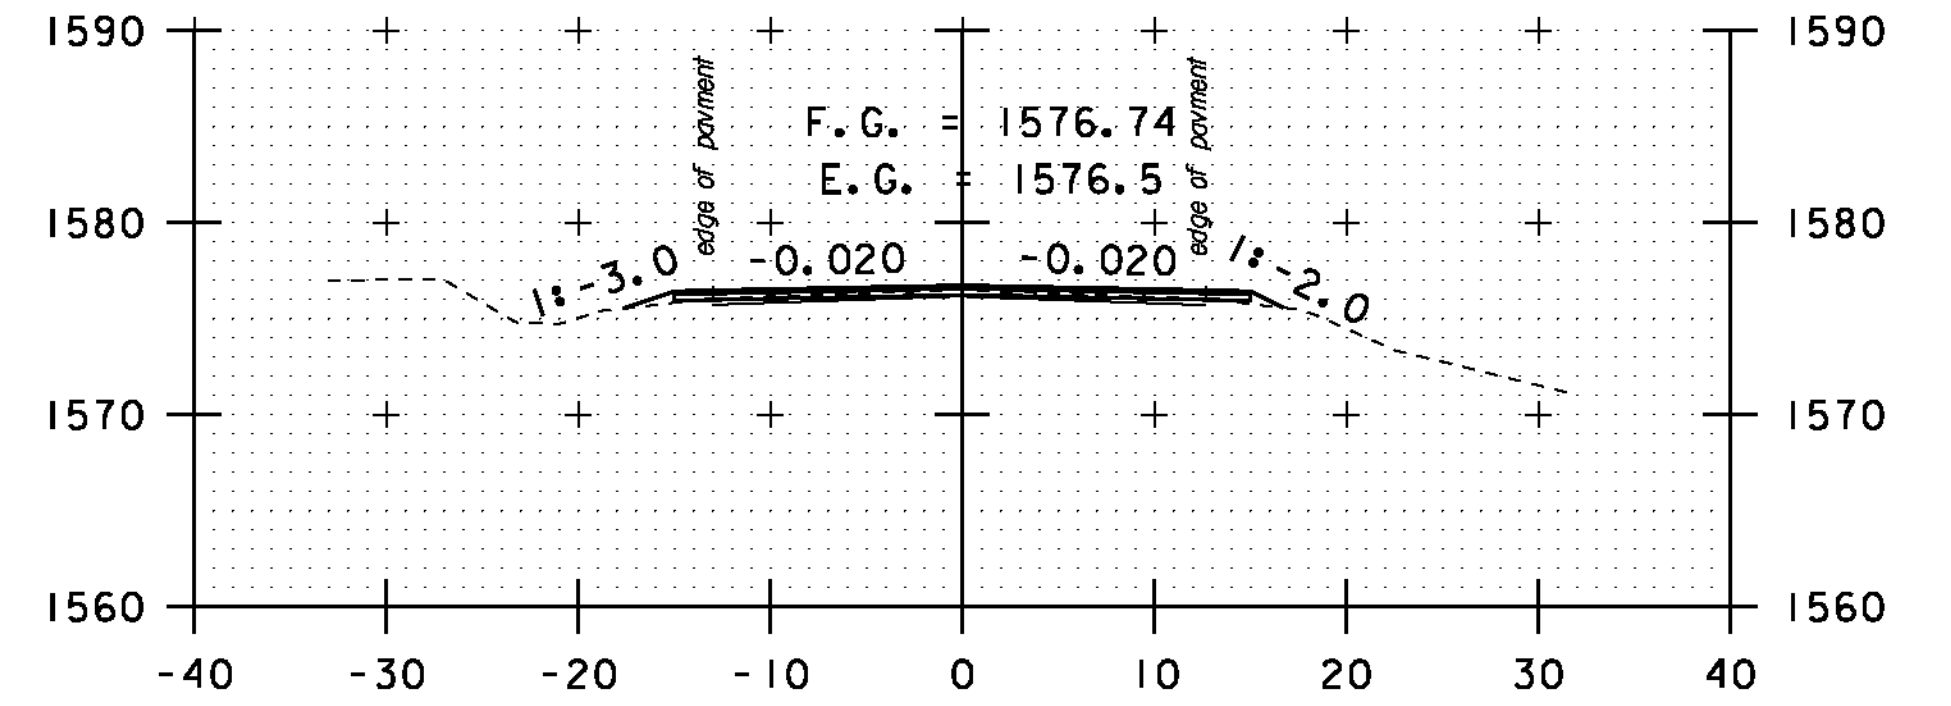


A 53+50

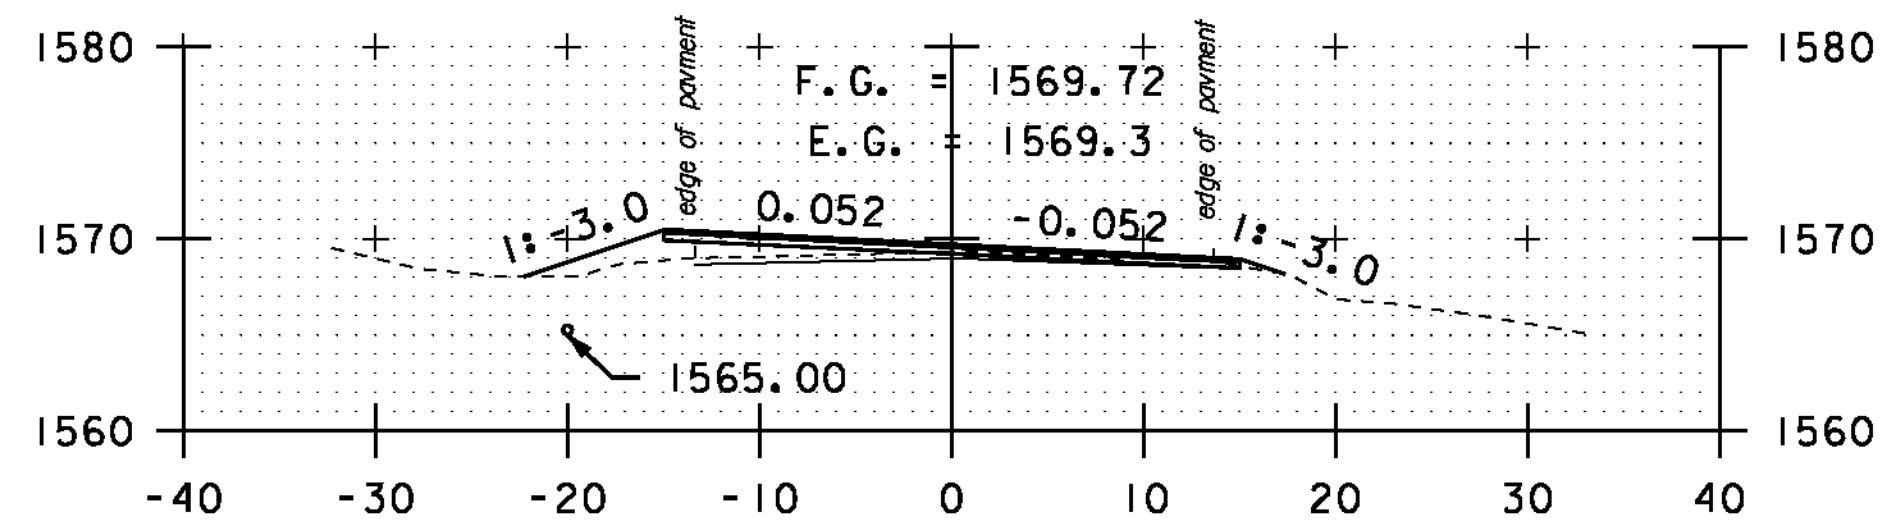


A 49+00

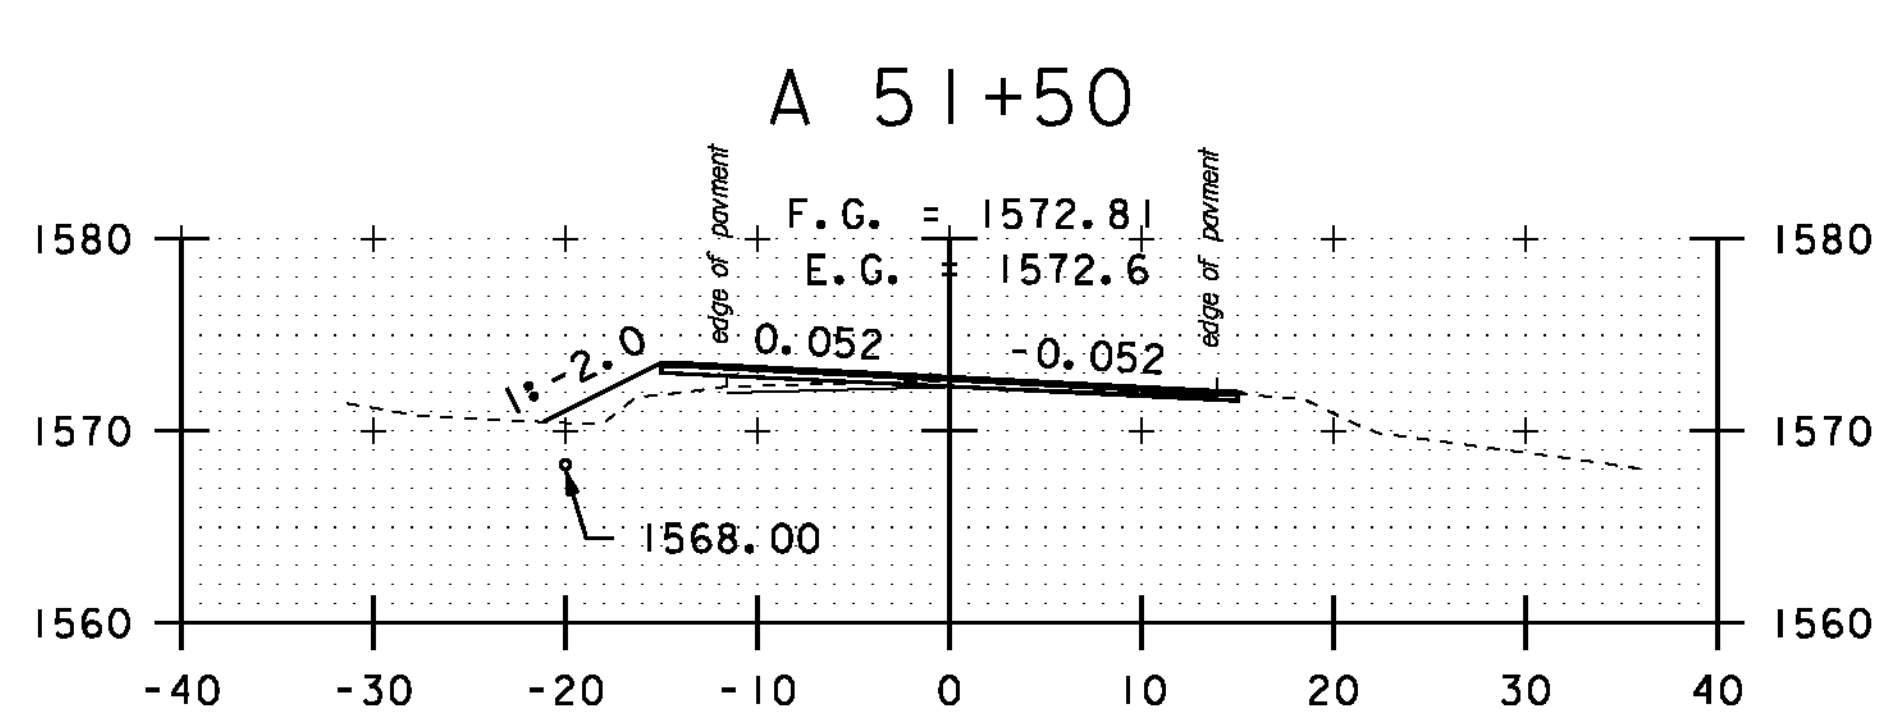


A 51+00

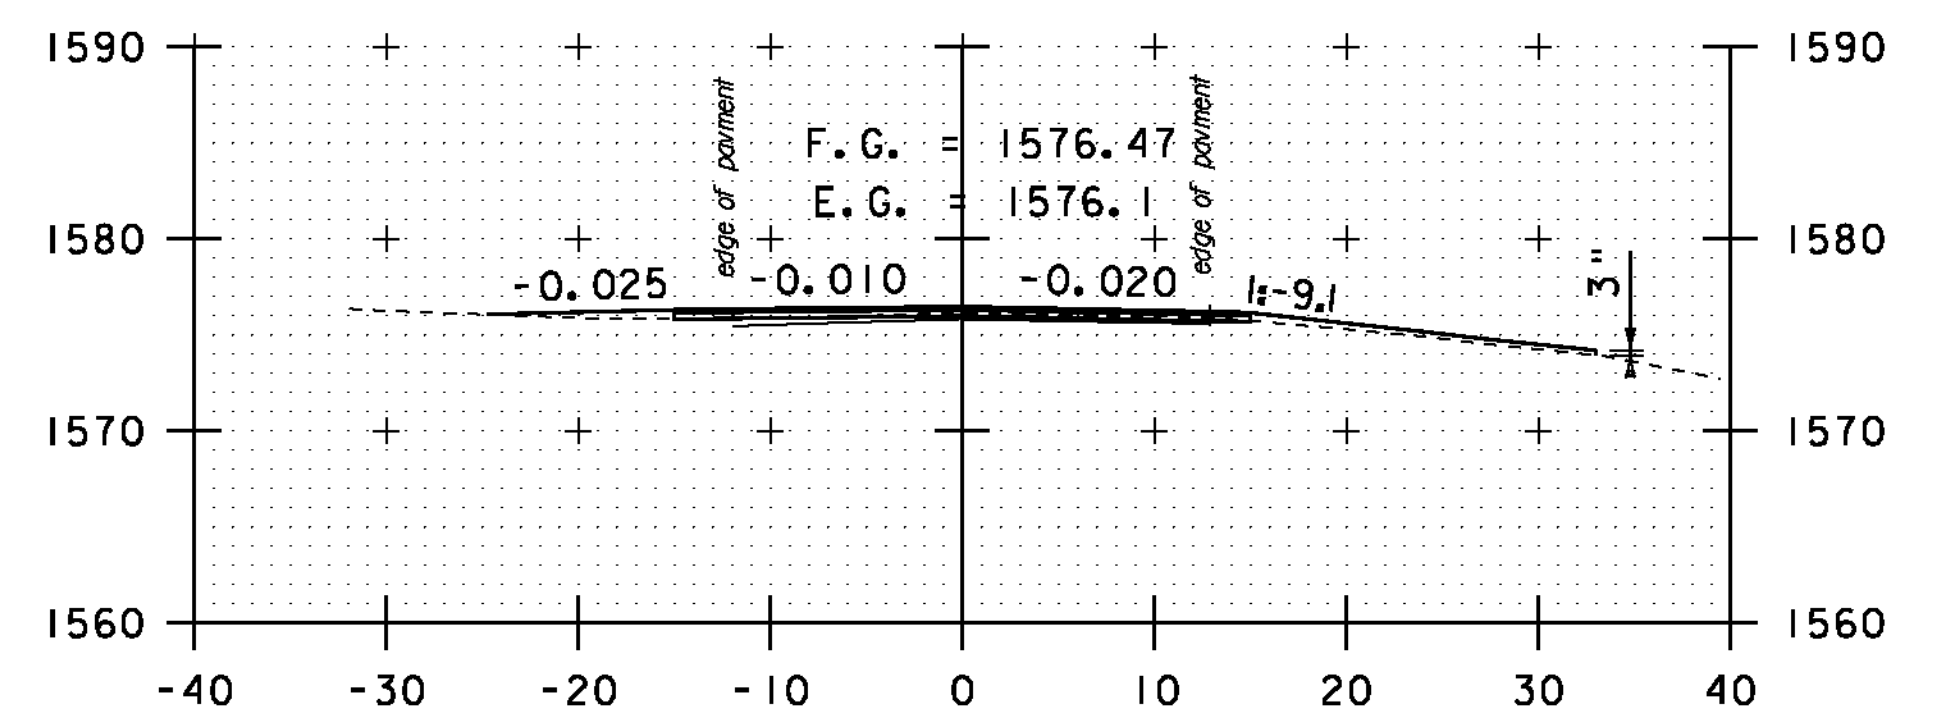


DRIVE LT/ PULL OFF RT
A 53+00

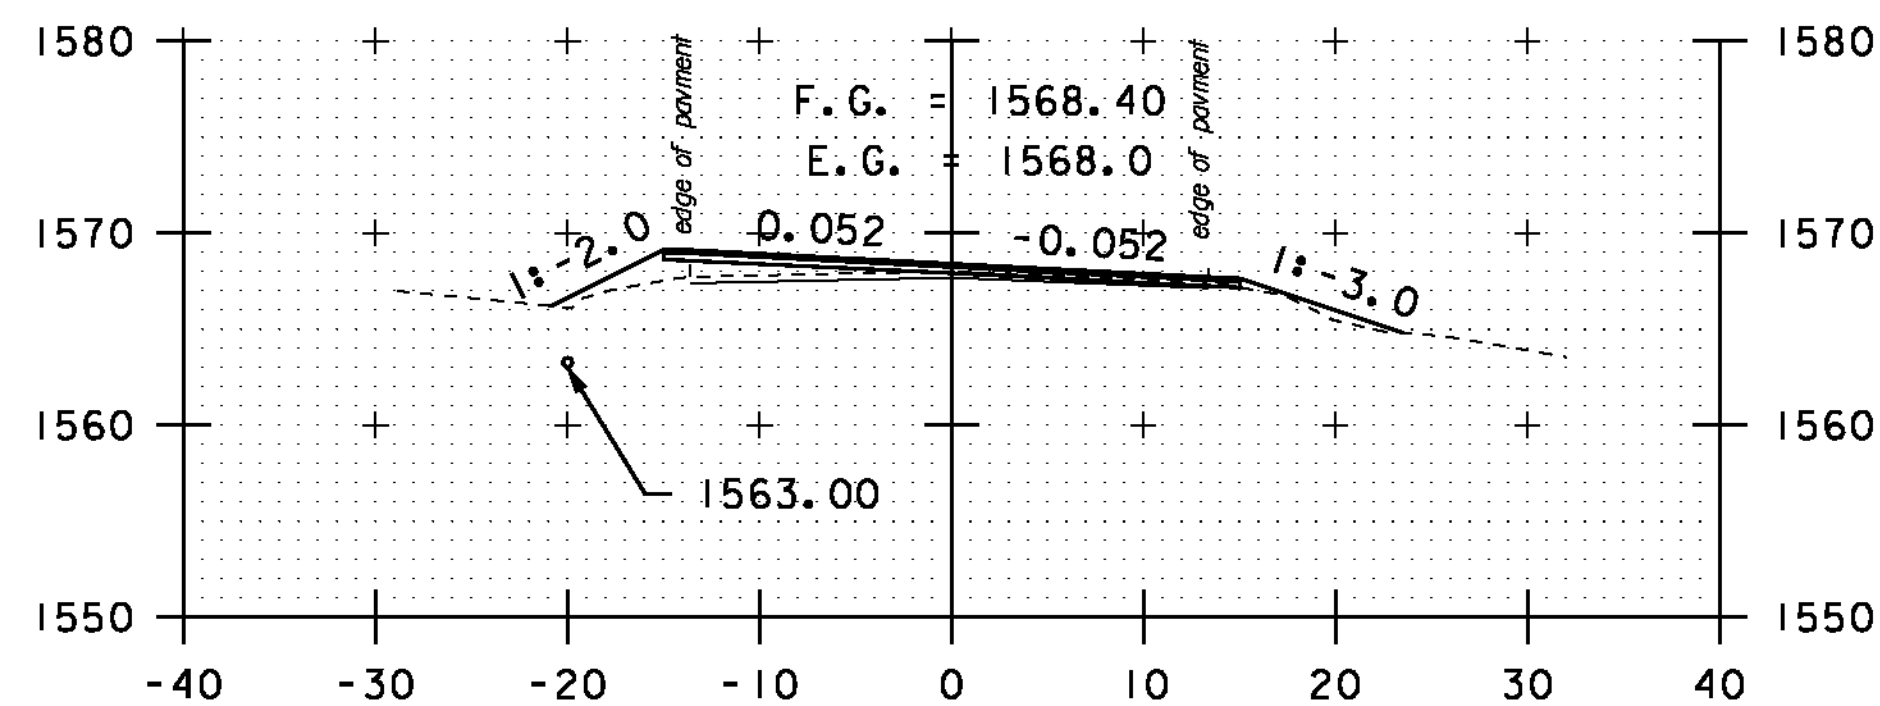


A 48+50

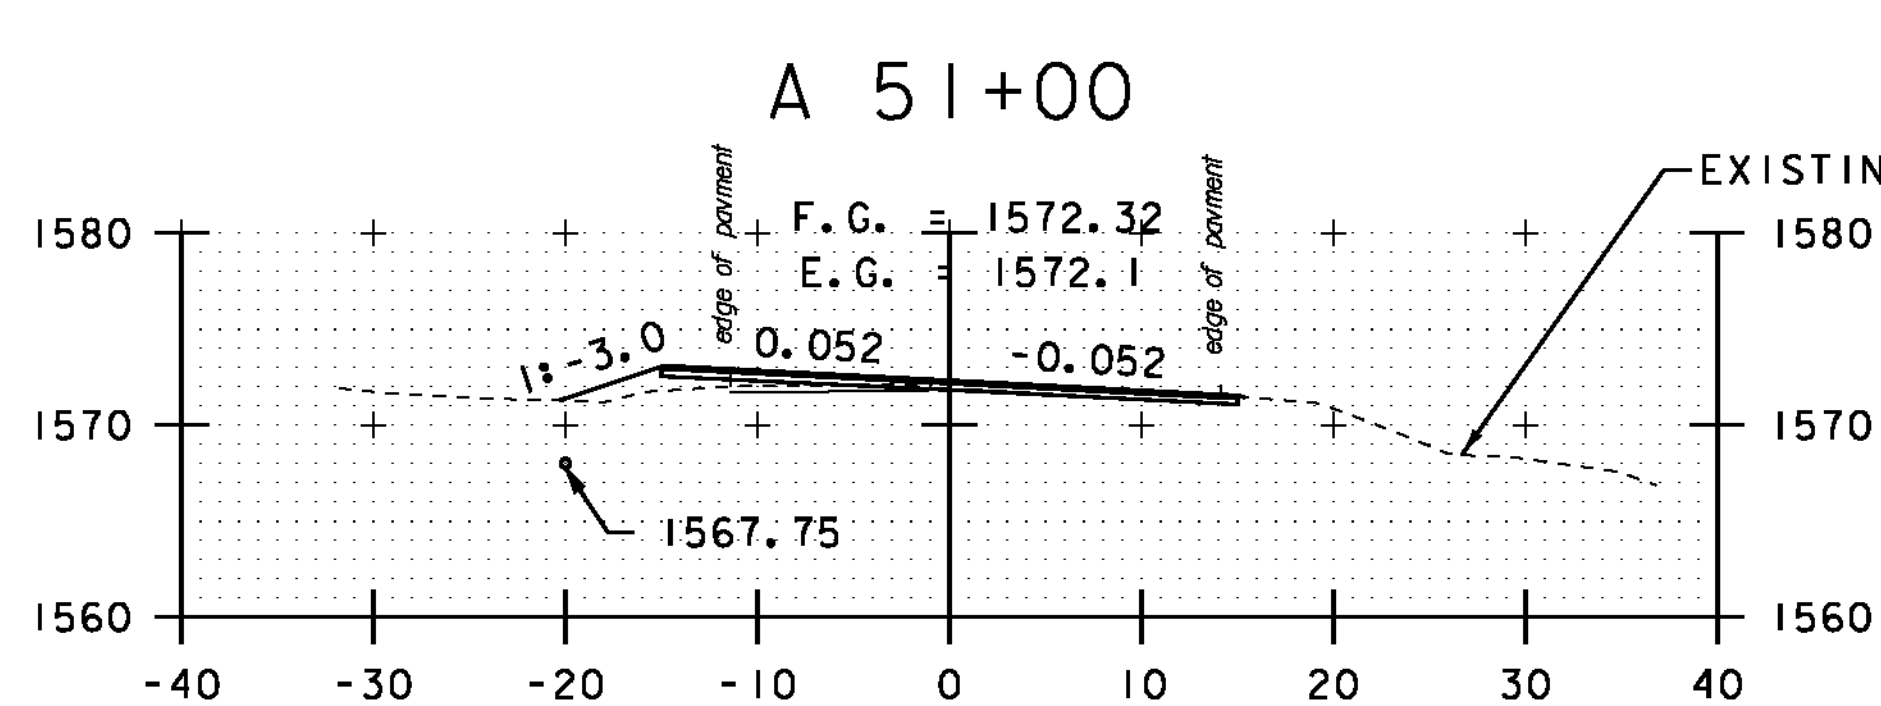


A 50+50

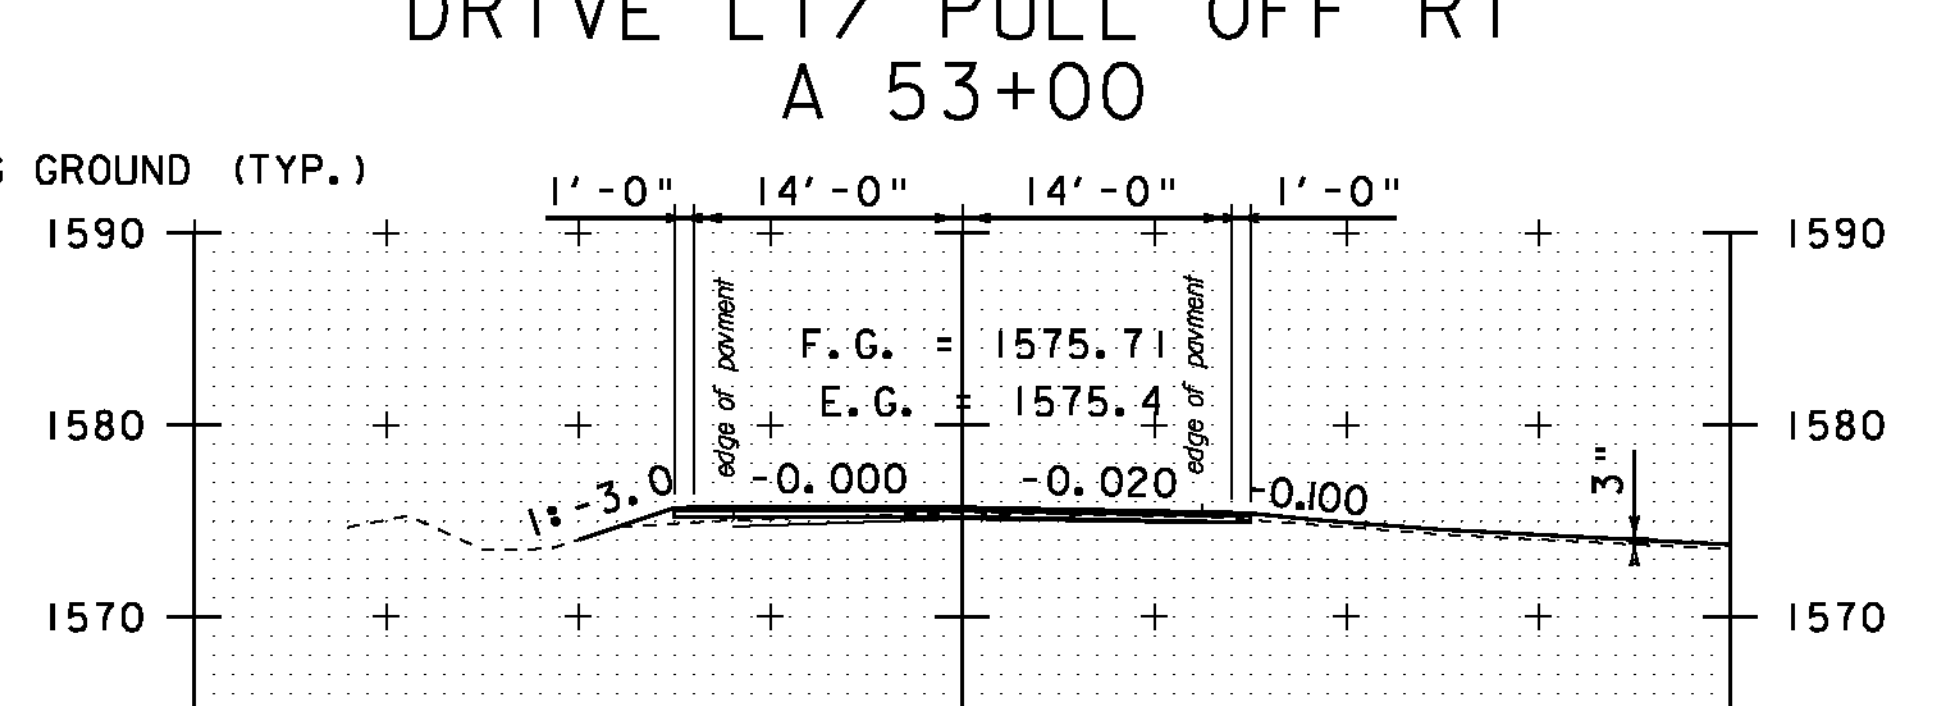


PULL OFF RT
A 52+50

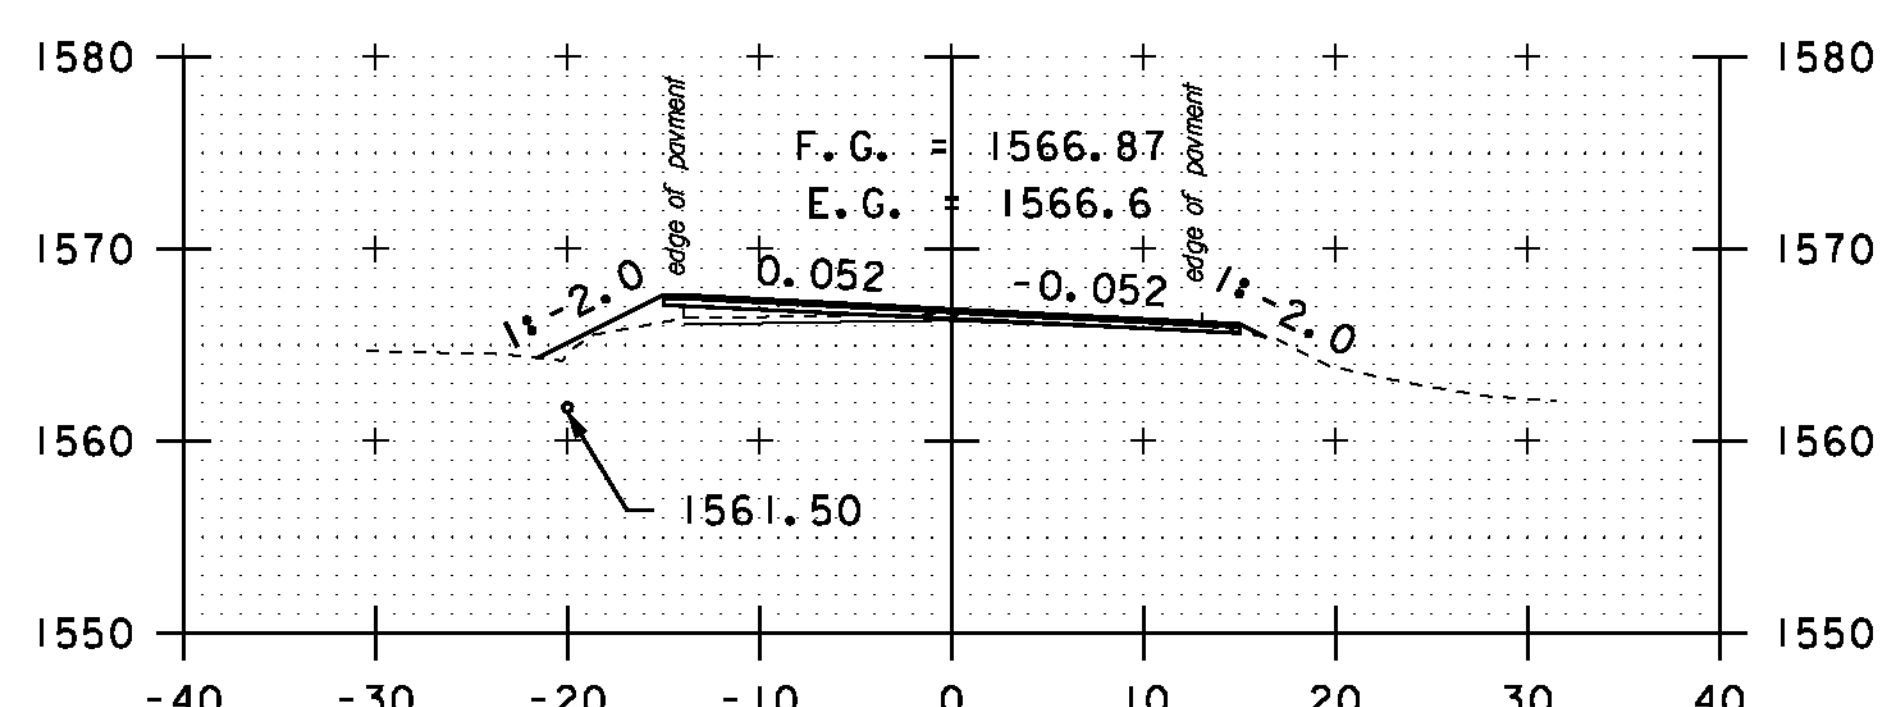

A 48+00

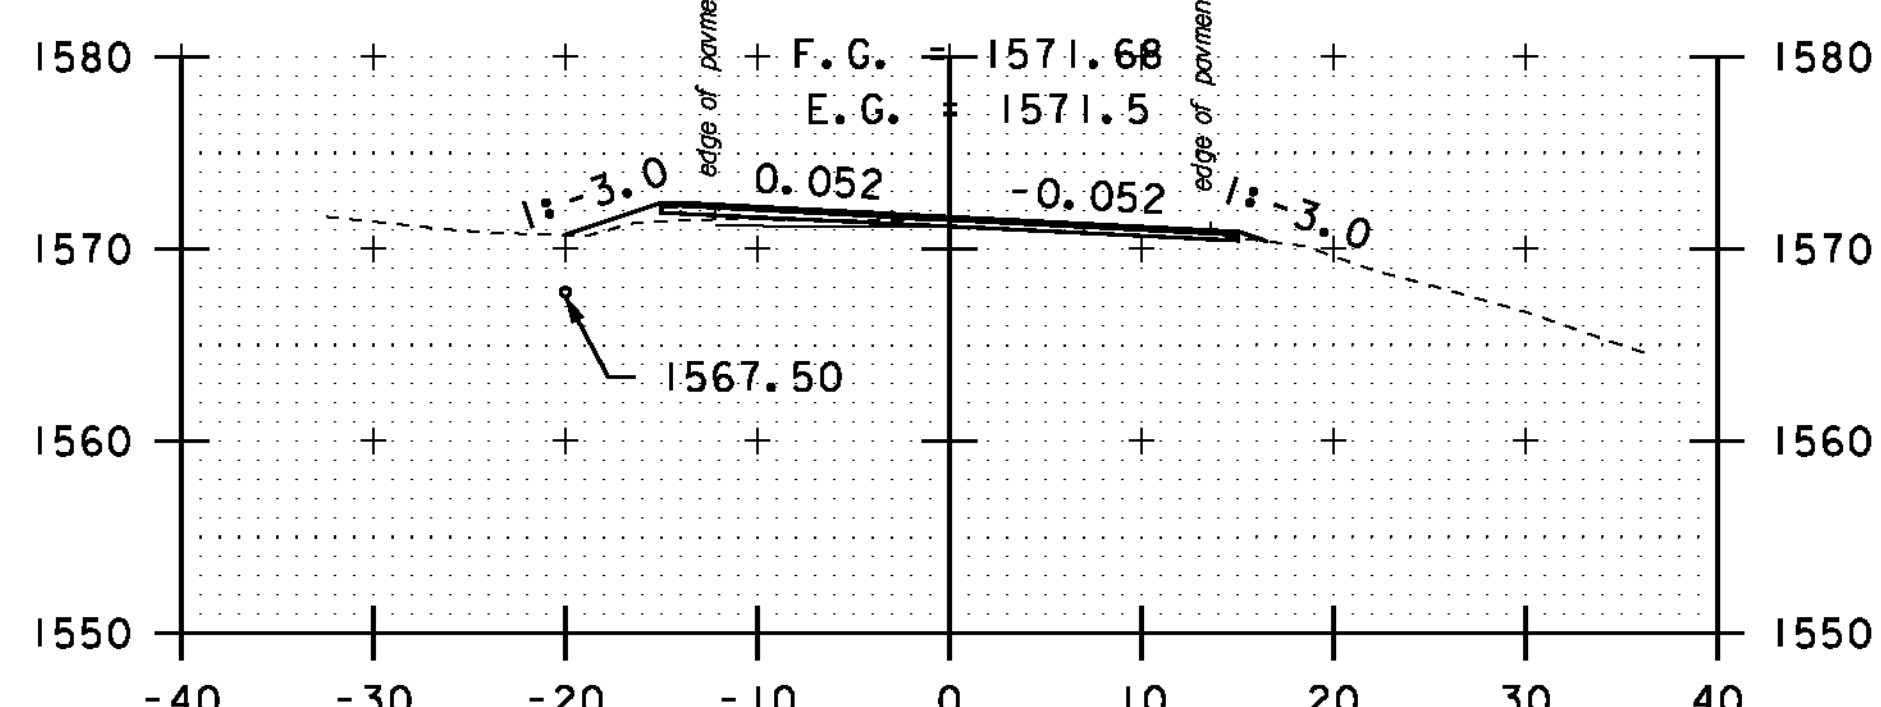

A 50+00

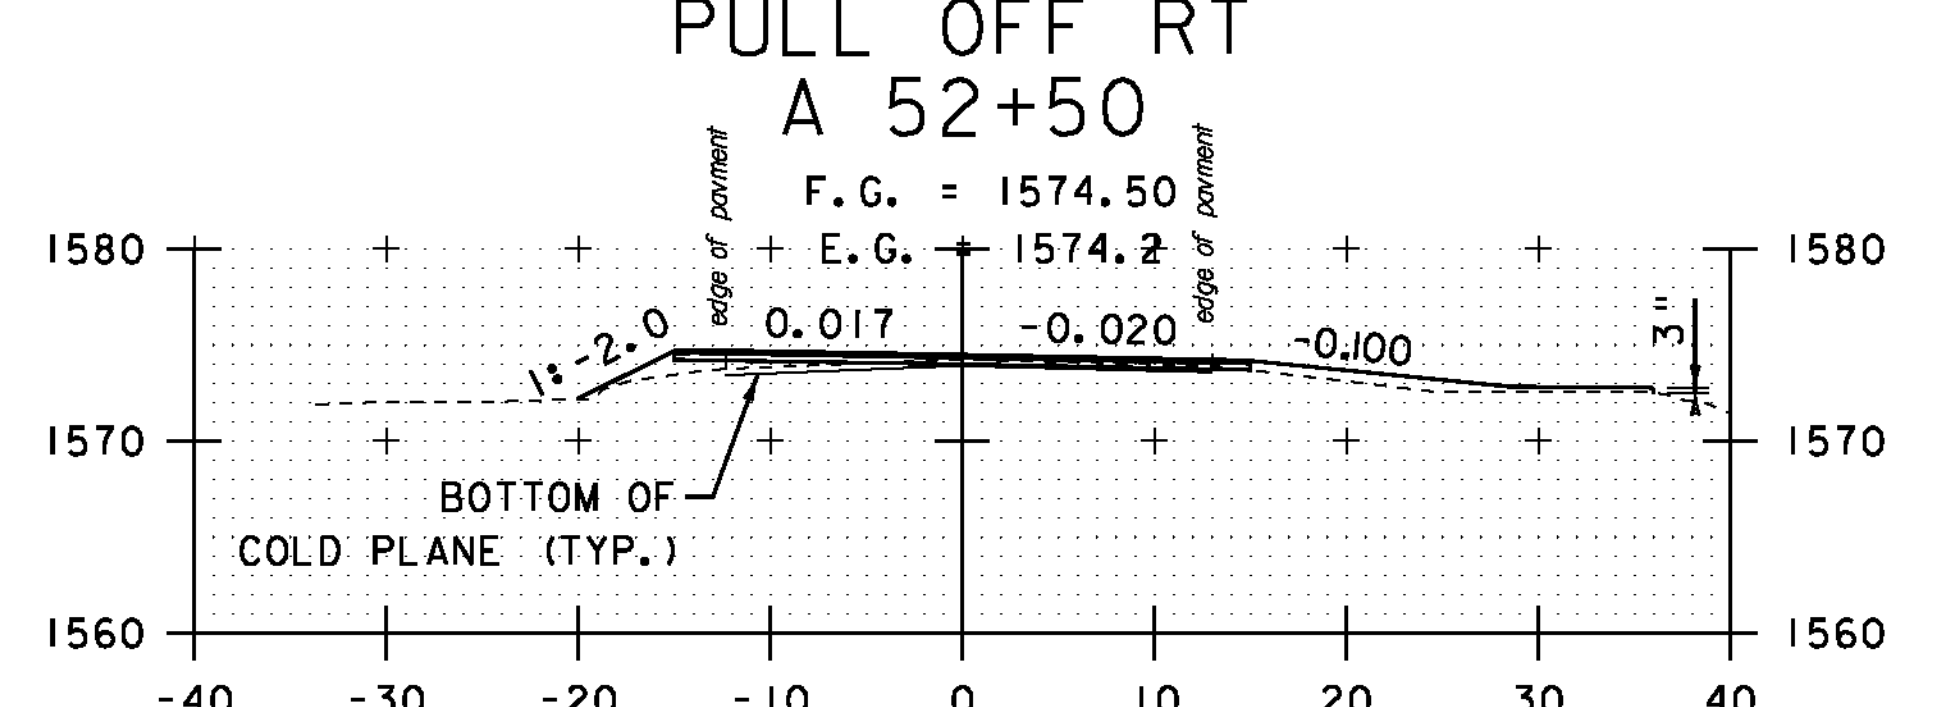

PULL OFF RT
A 52+00

STA. A 48+00 TO STA. A 53+50

SCALE 1" = 10'-0"
10 0 10

CROSS SECTION SHEET 46

PROJECT NAME: MONTGOMERY-WESTFIELD
PROJECT NUMBER: STP 2906(I)
FILE NAME: p10CI90.dgn
PROJECT LEADER: CDL
DESIGNED BY: SJL
PLOT FILE: p10CI90_160.plt
PLOT DATE: 9/5/12
DRAWN BY: SJL
CHECKED BY: CDL
SHEET 160 OF 178