




A 55+00

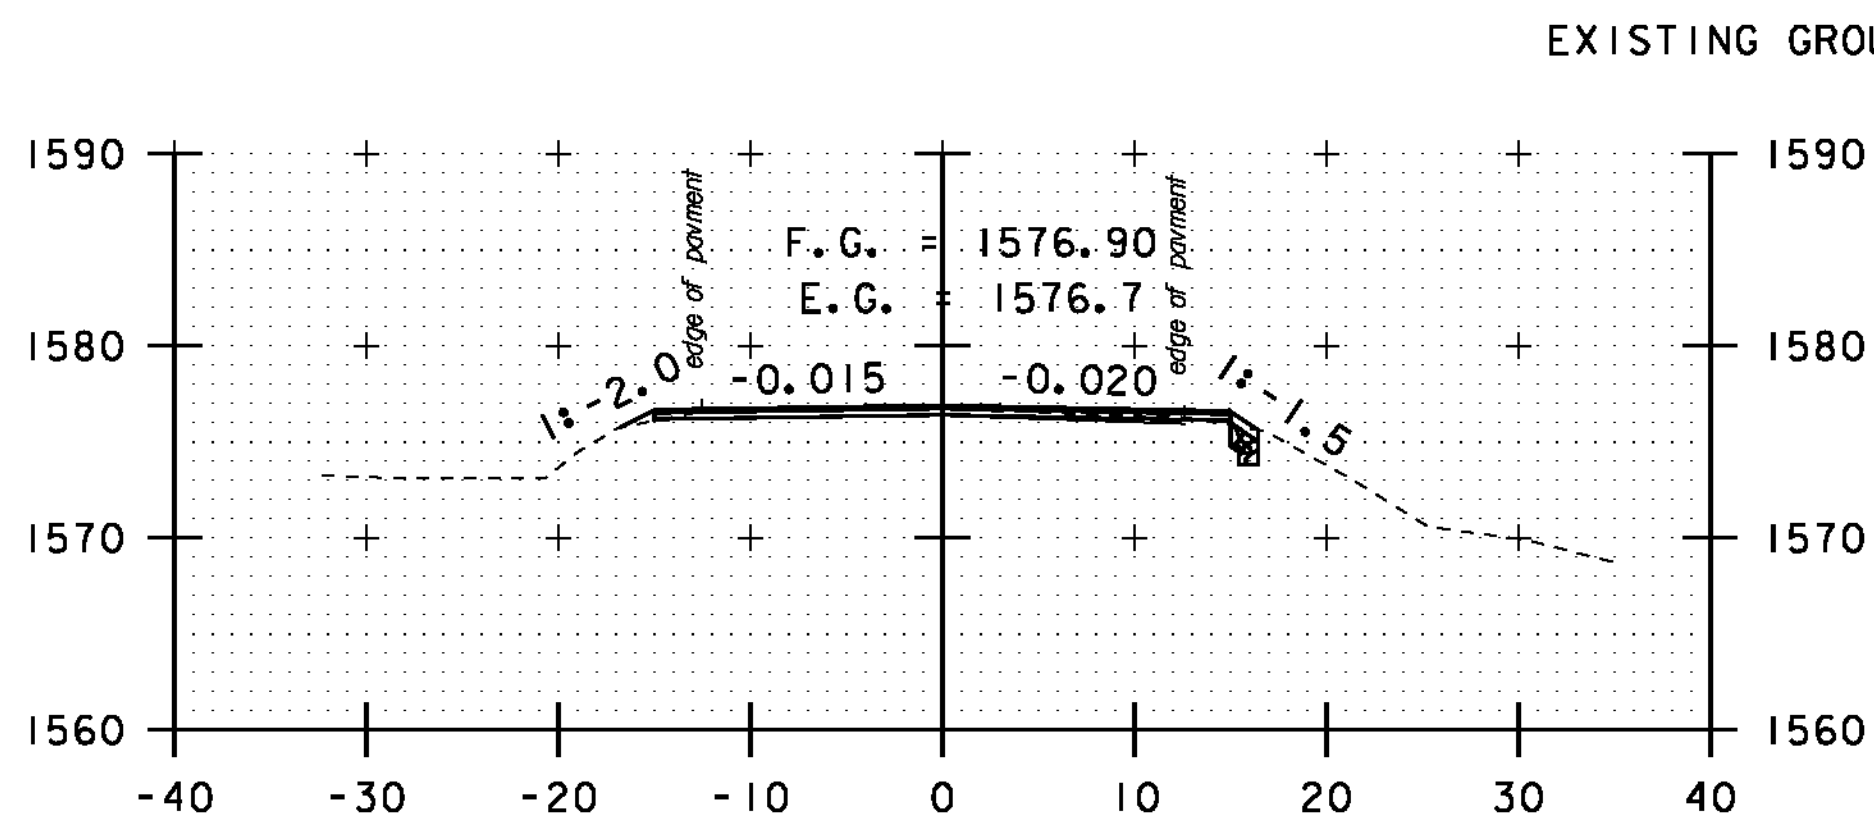


A 56+50

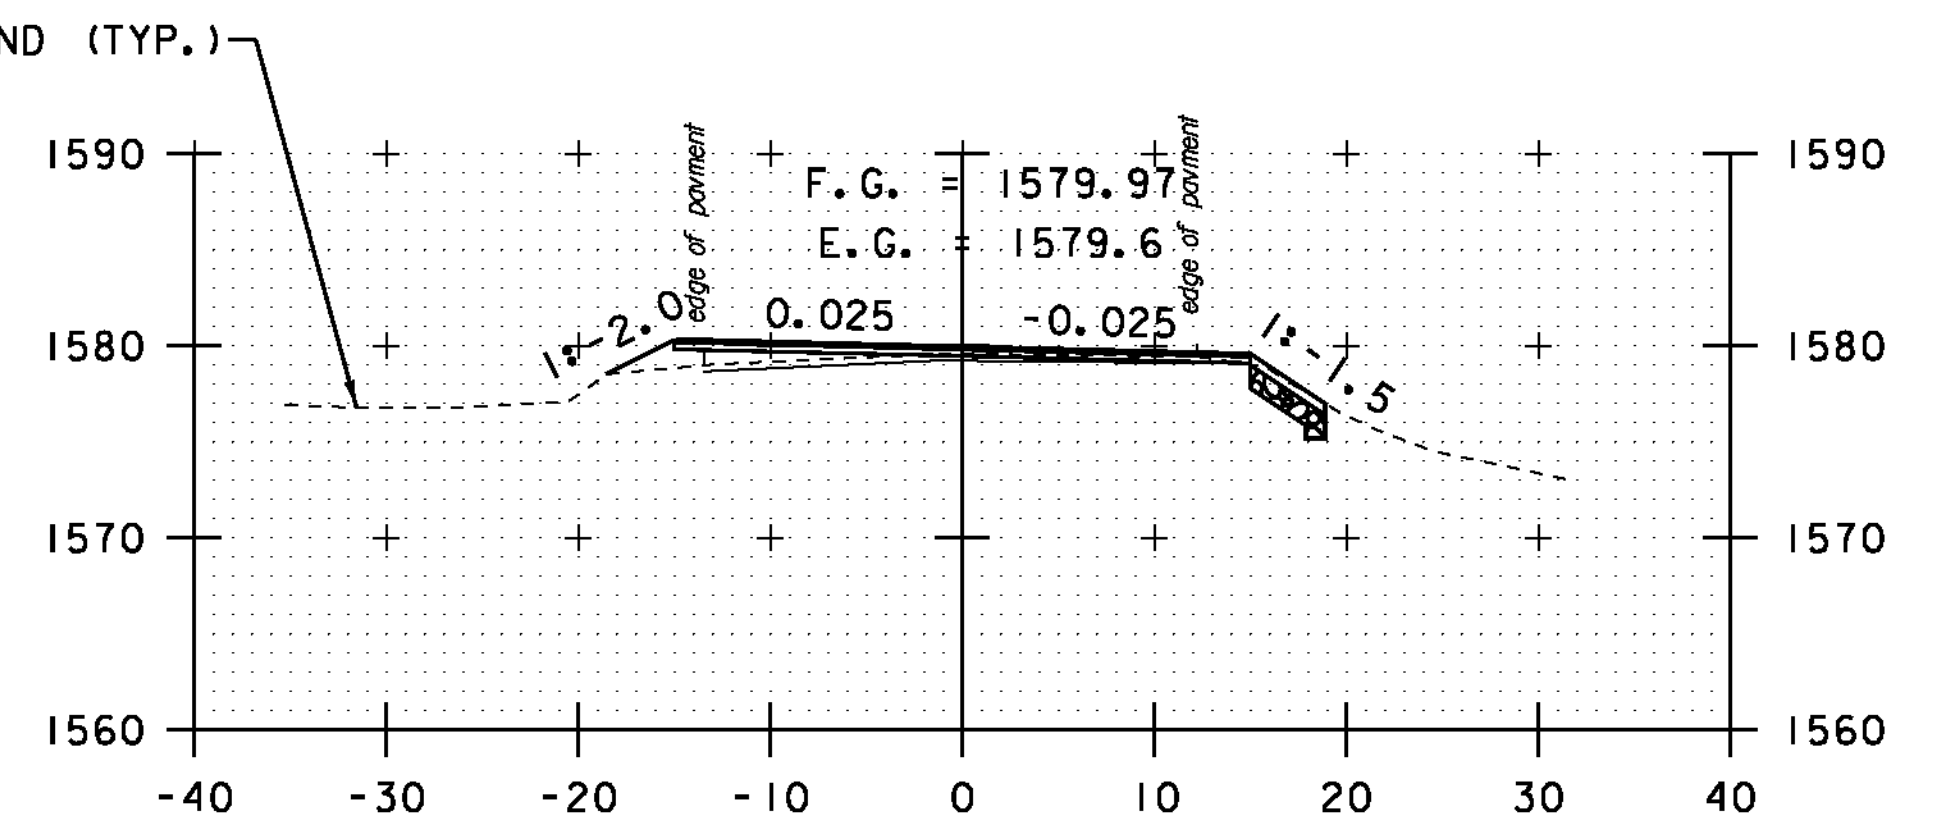


A 58+00

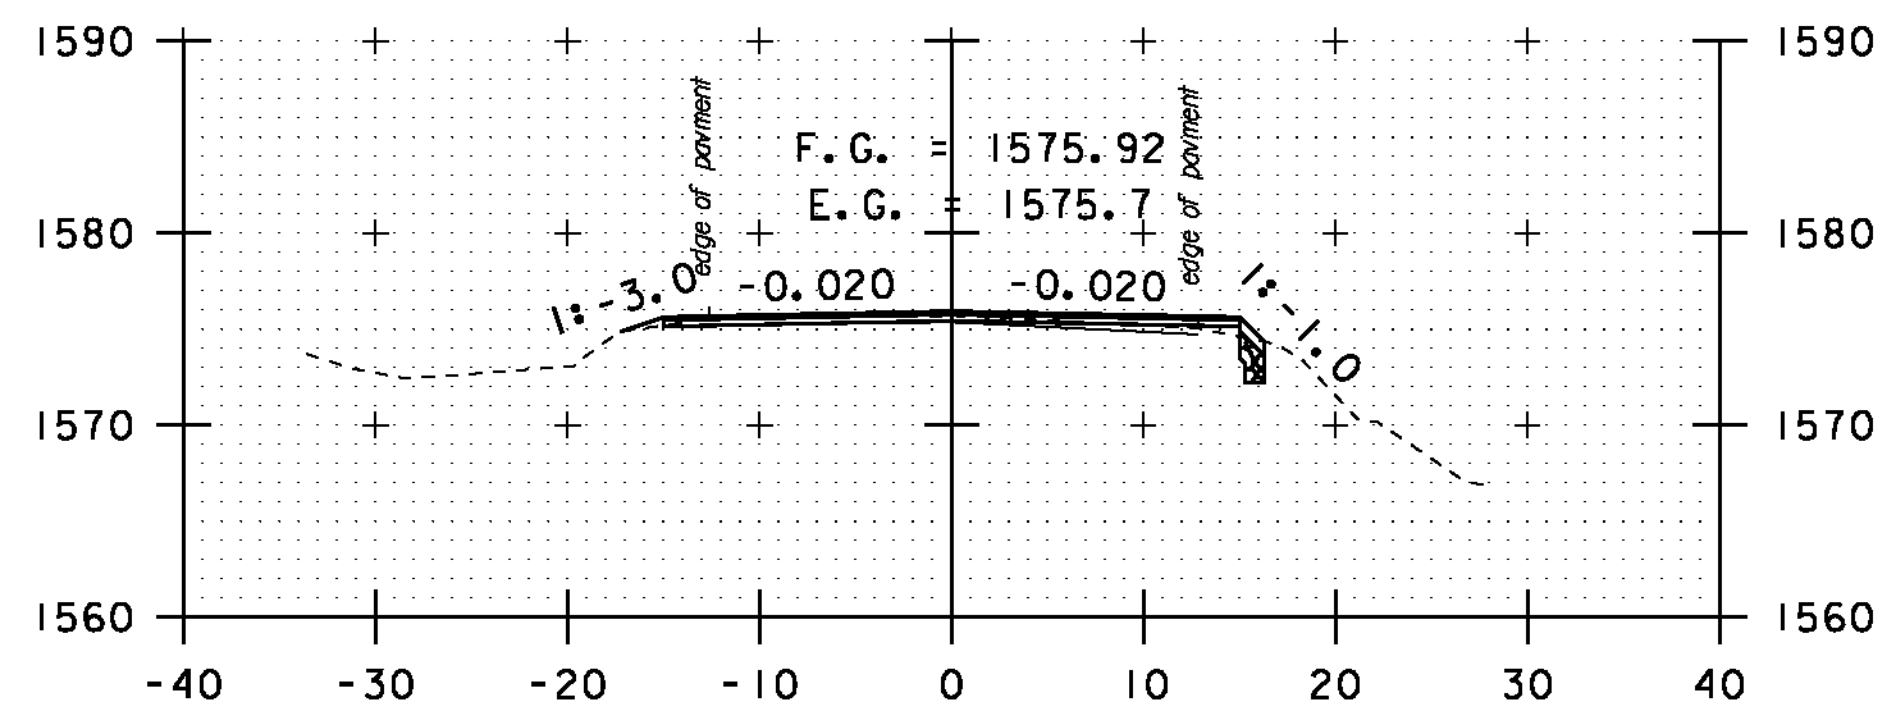


A 54+50

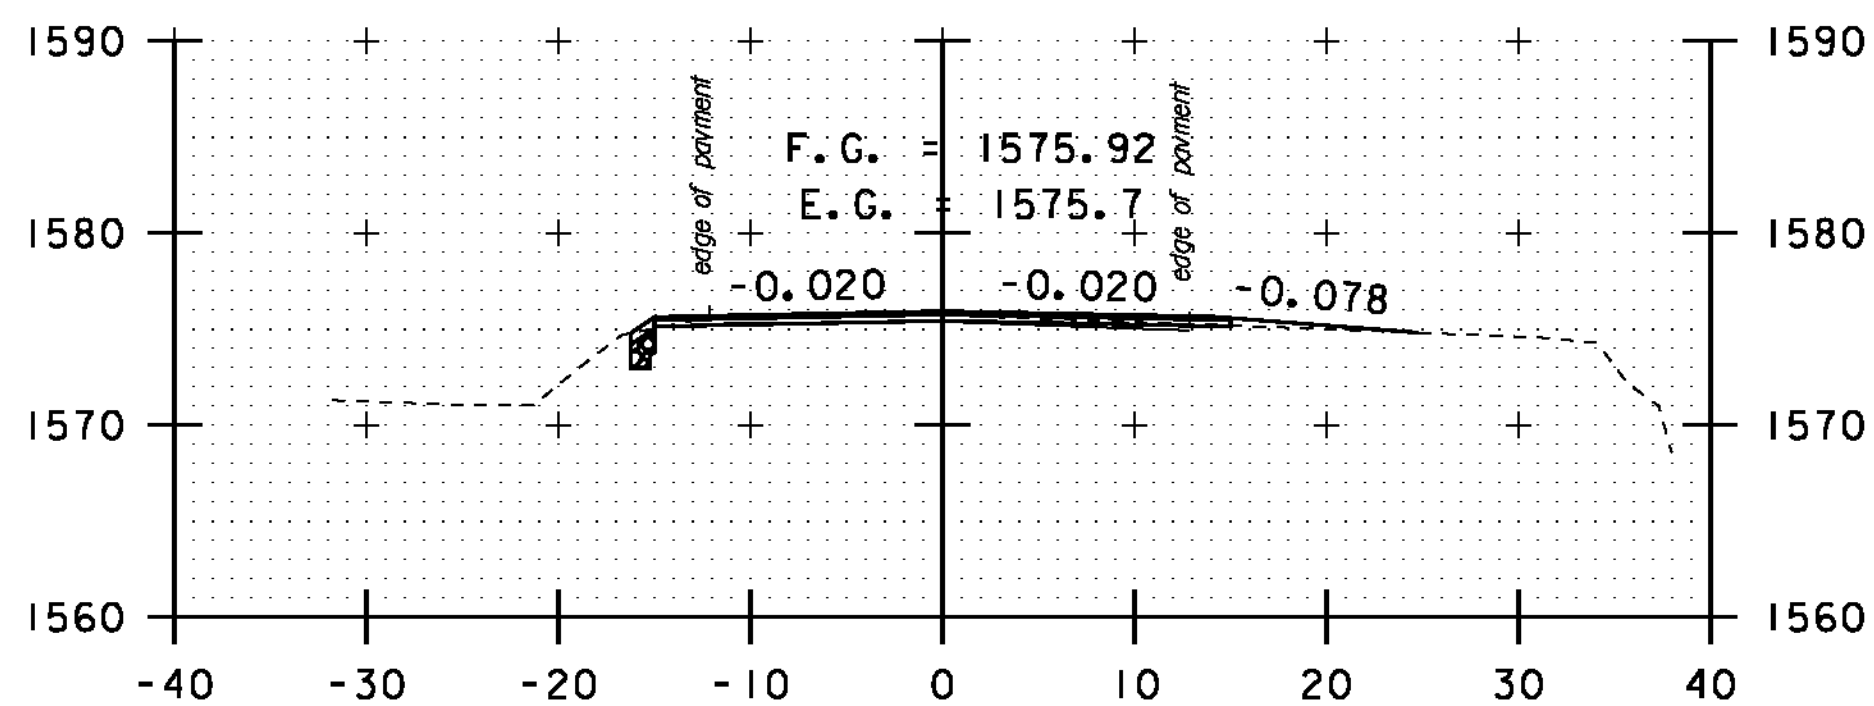


DRIVE RT
A 56+00

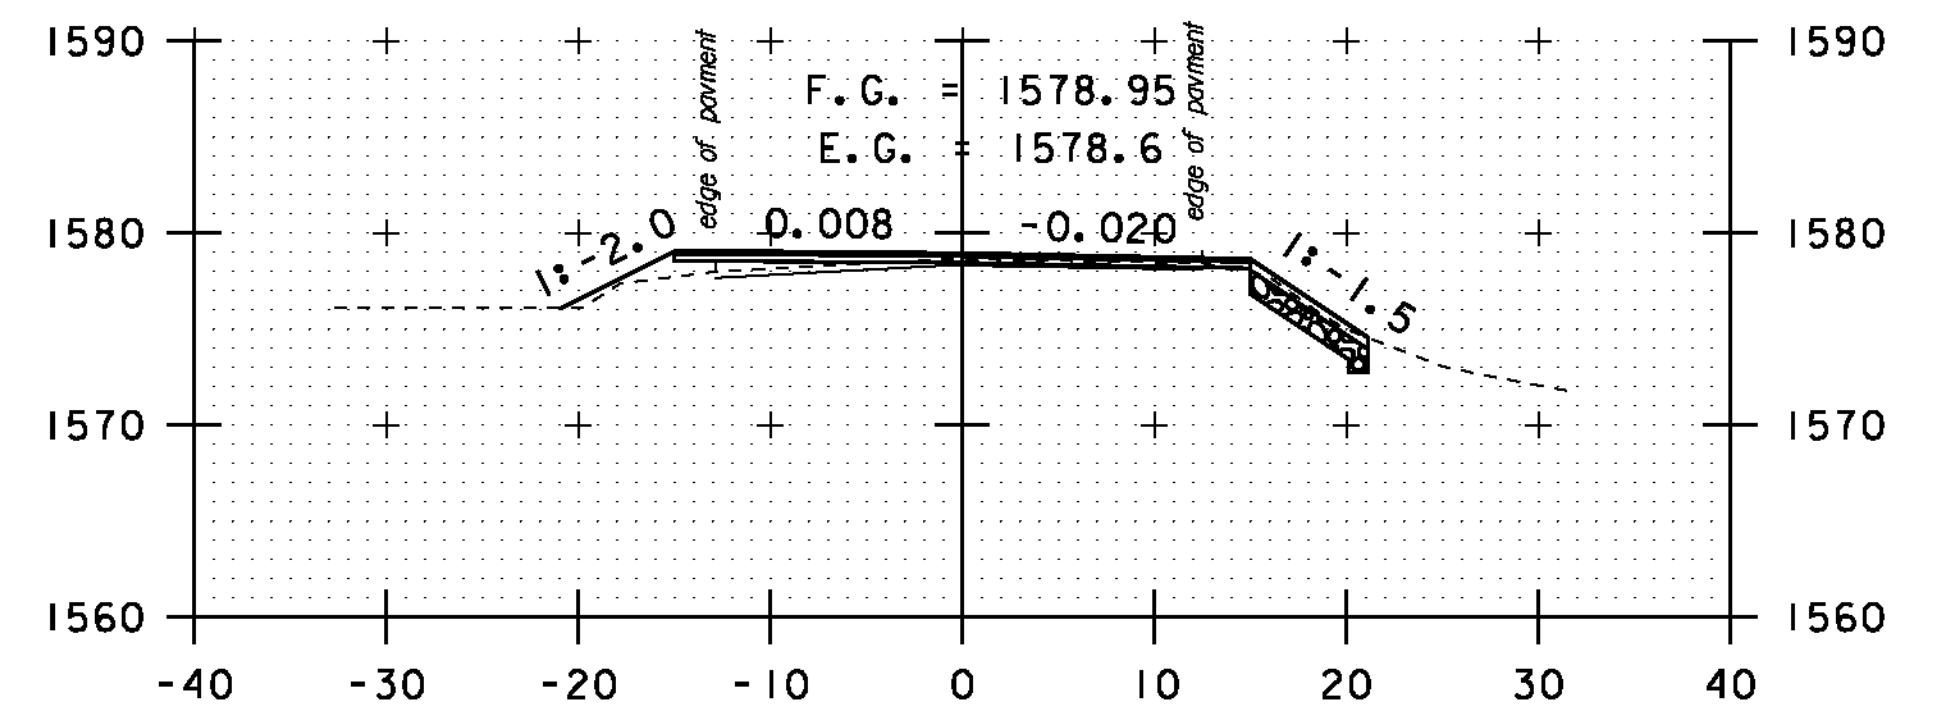


A 57+50

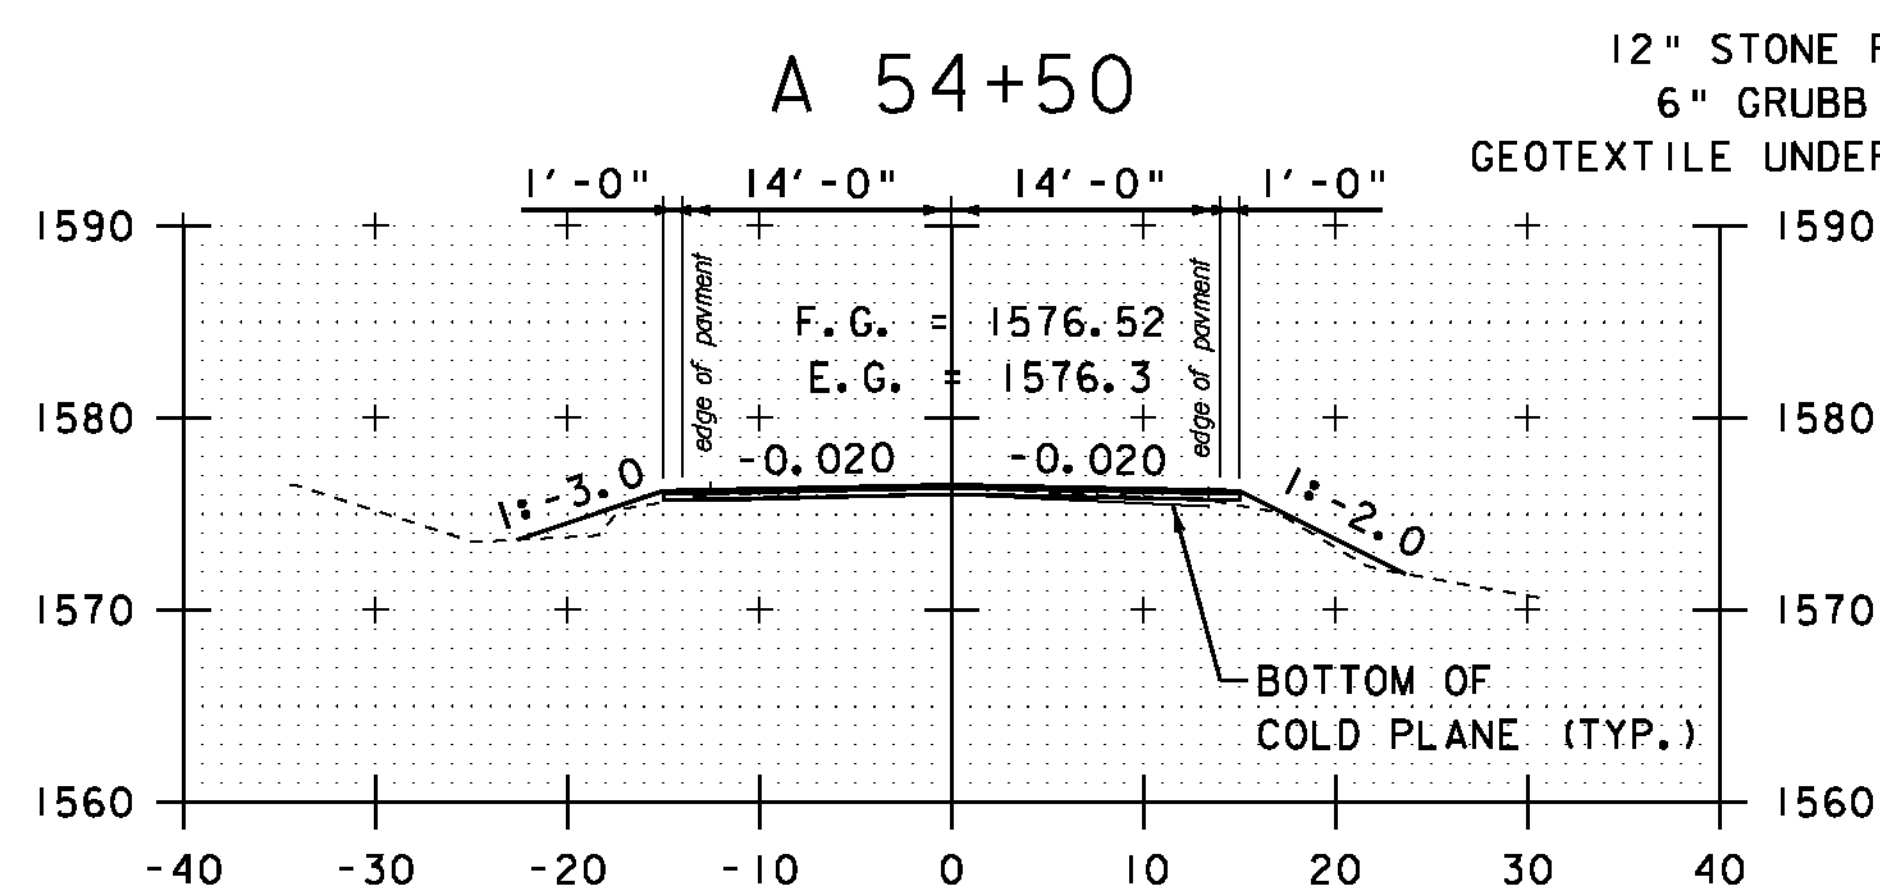

A 54+00

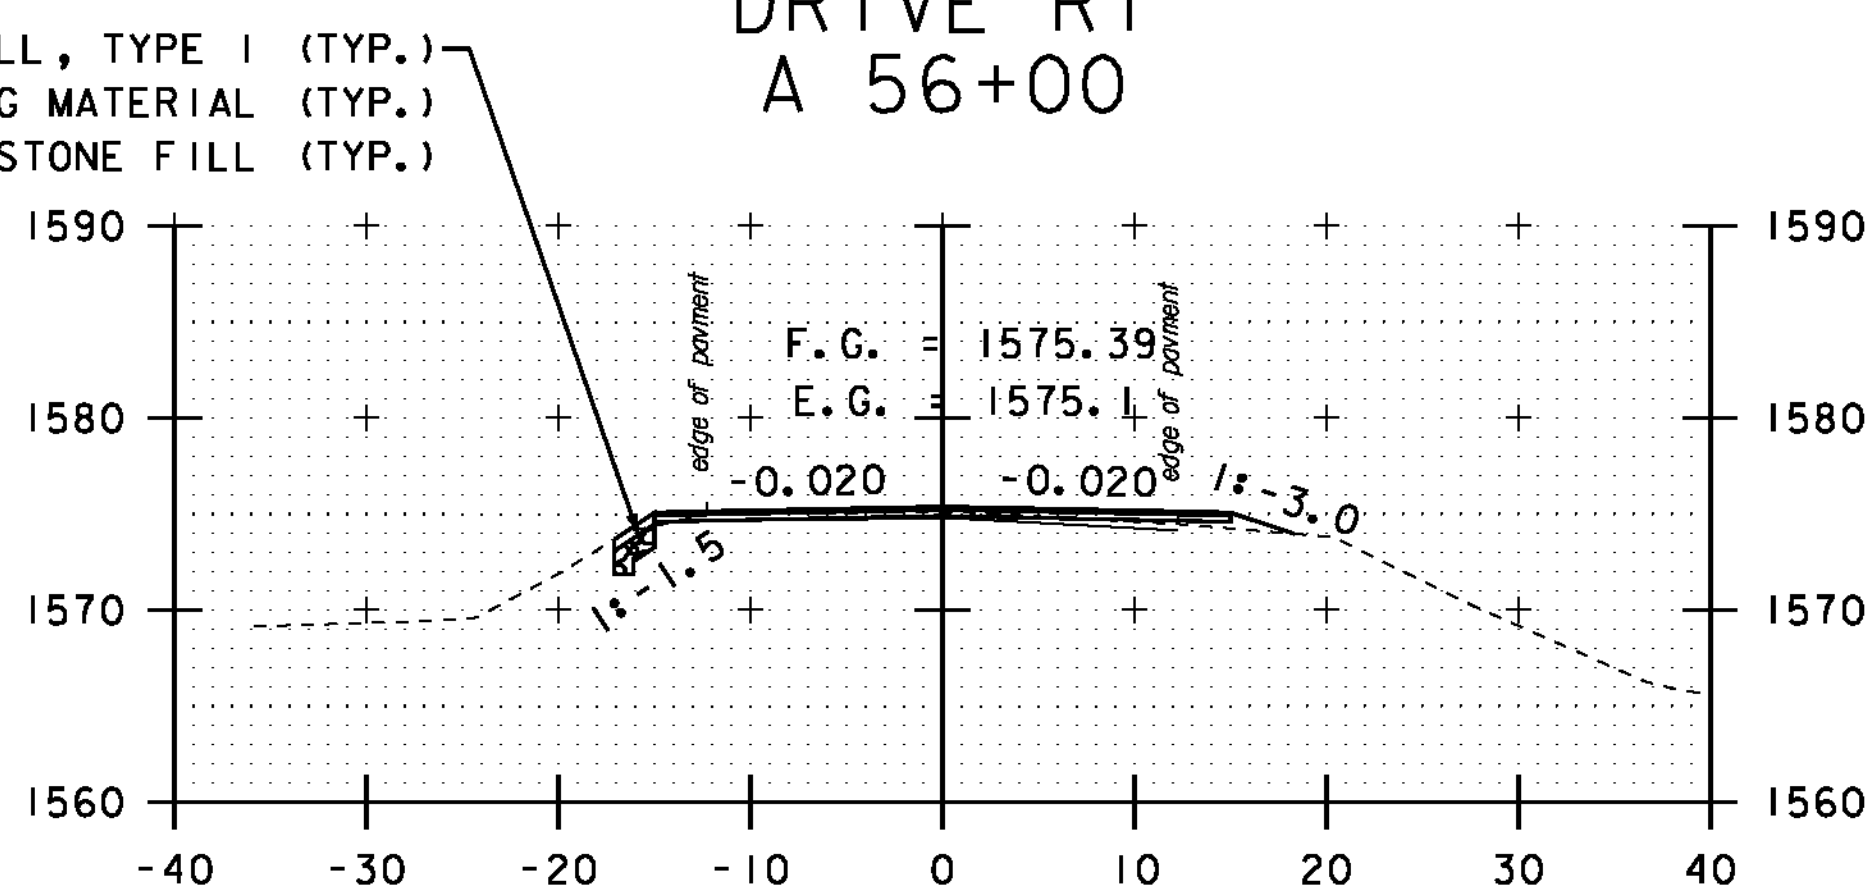

A 55+50

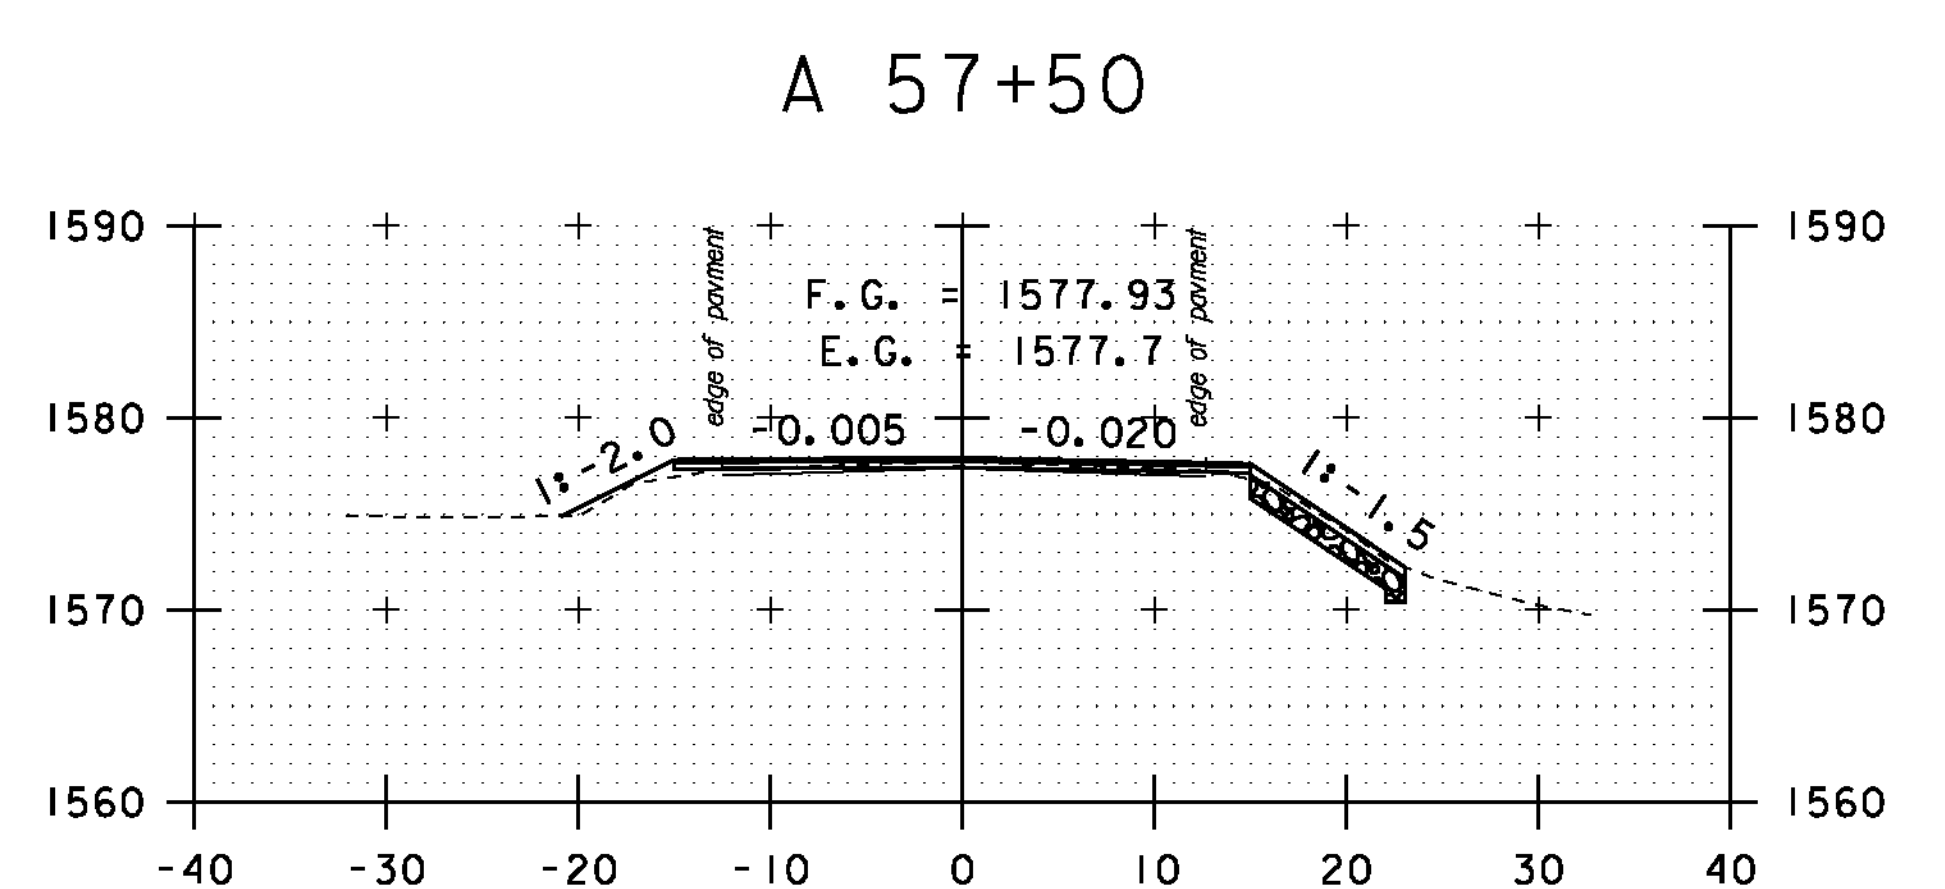

A 57+00

STA. A 54+00 TO STA. A 58+00



CROSS SECTION SHEET 47

PROJECT NAME: MONTGOMERY-WESTFIELD
 PROJECT NUMBER: STP 2906(I)
 FILE NAME: p10CI90.dgn
 PROJECT LEADER: CDL
 DESIGNED BY: SJL
 PLOT FILE: p10CI90_161.I
 PLOT DATE: 9/5/12
 DRAWN BY: SJL
 CHECKED BY: CDL
 SHEET 161 OF 178