




A 60+00

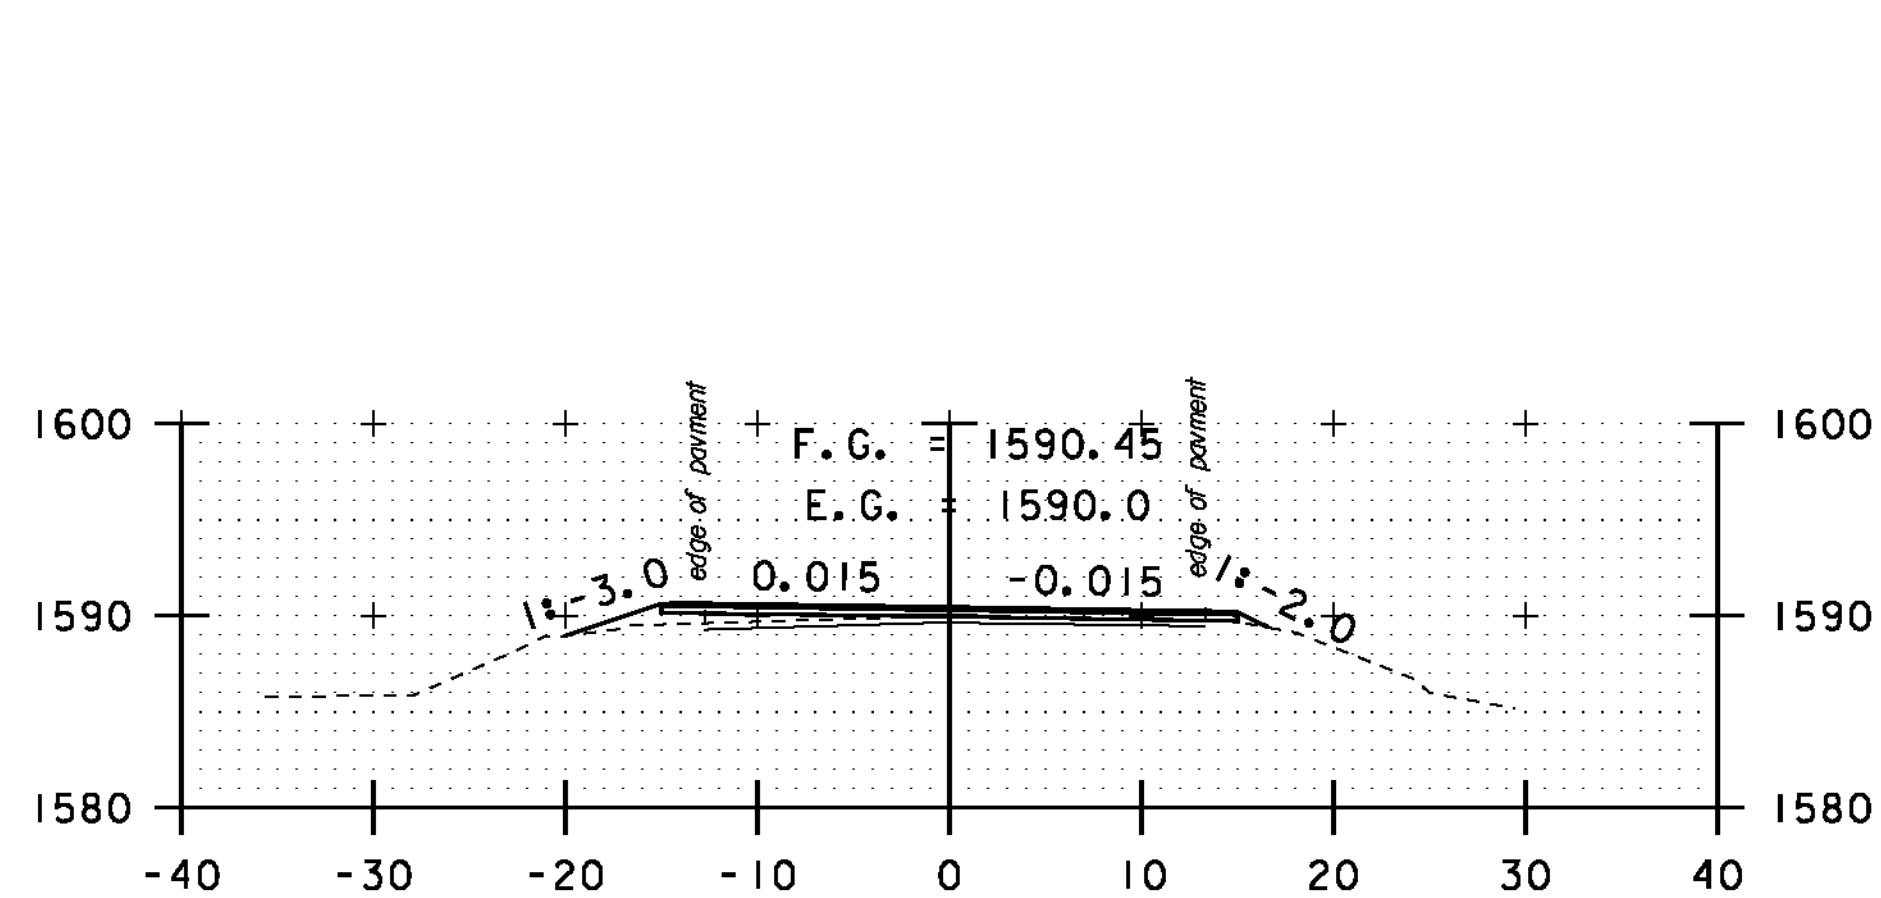


A 62+00

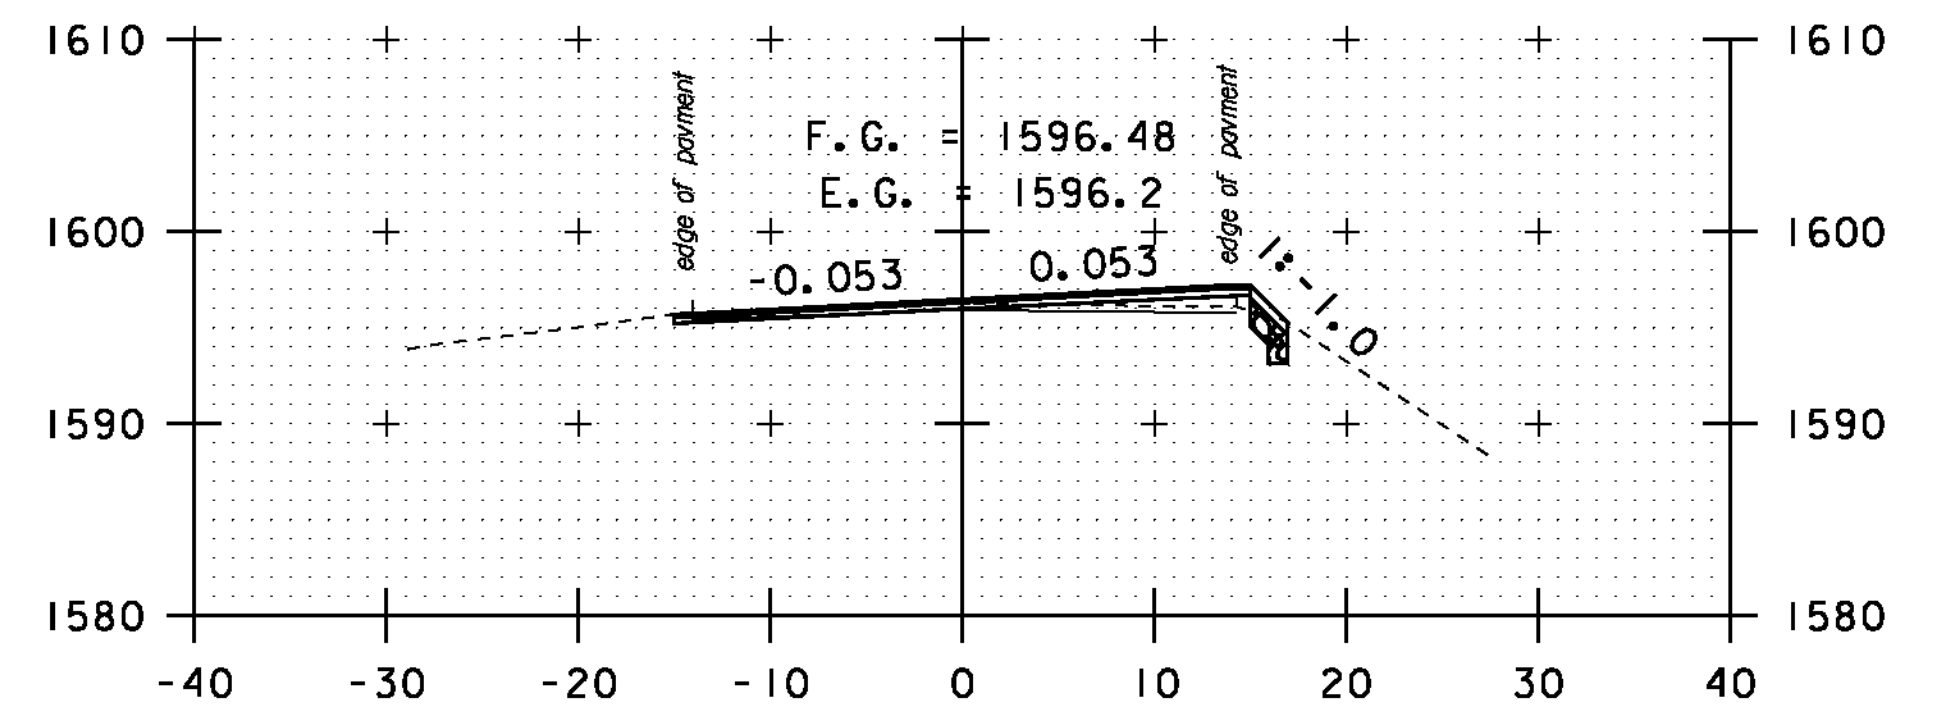


A 64+00

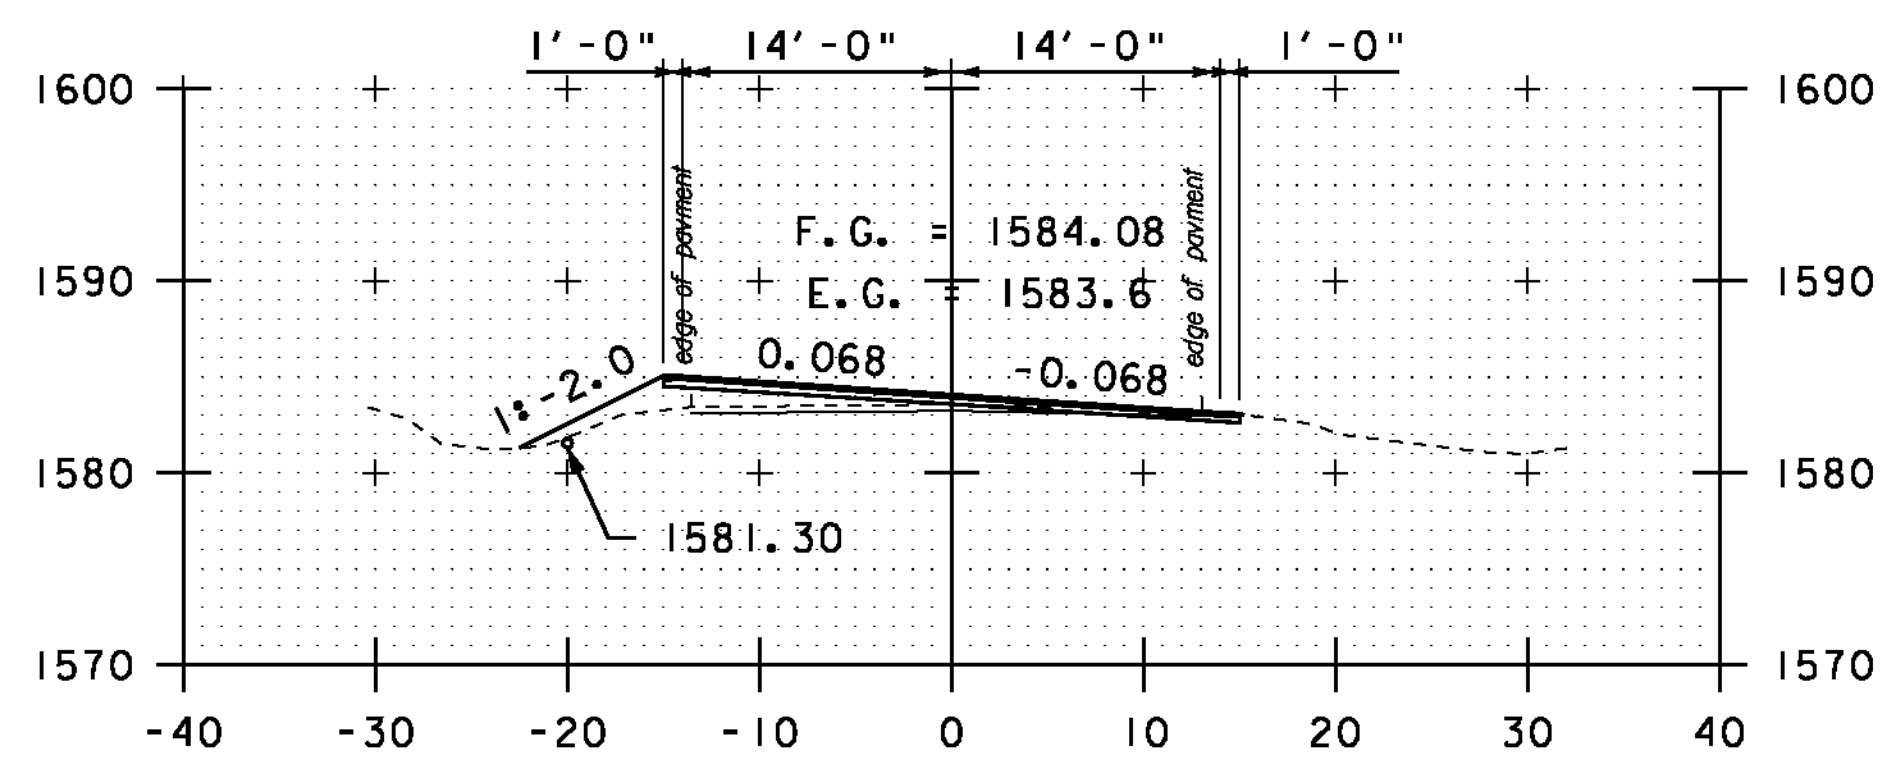


A 59+50

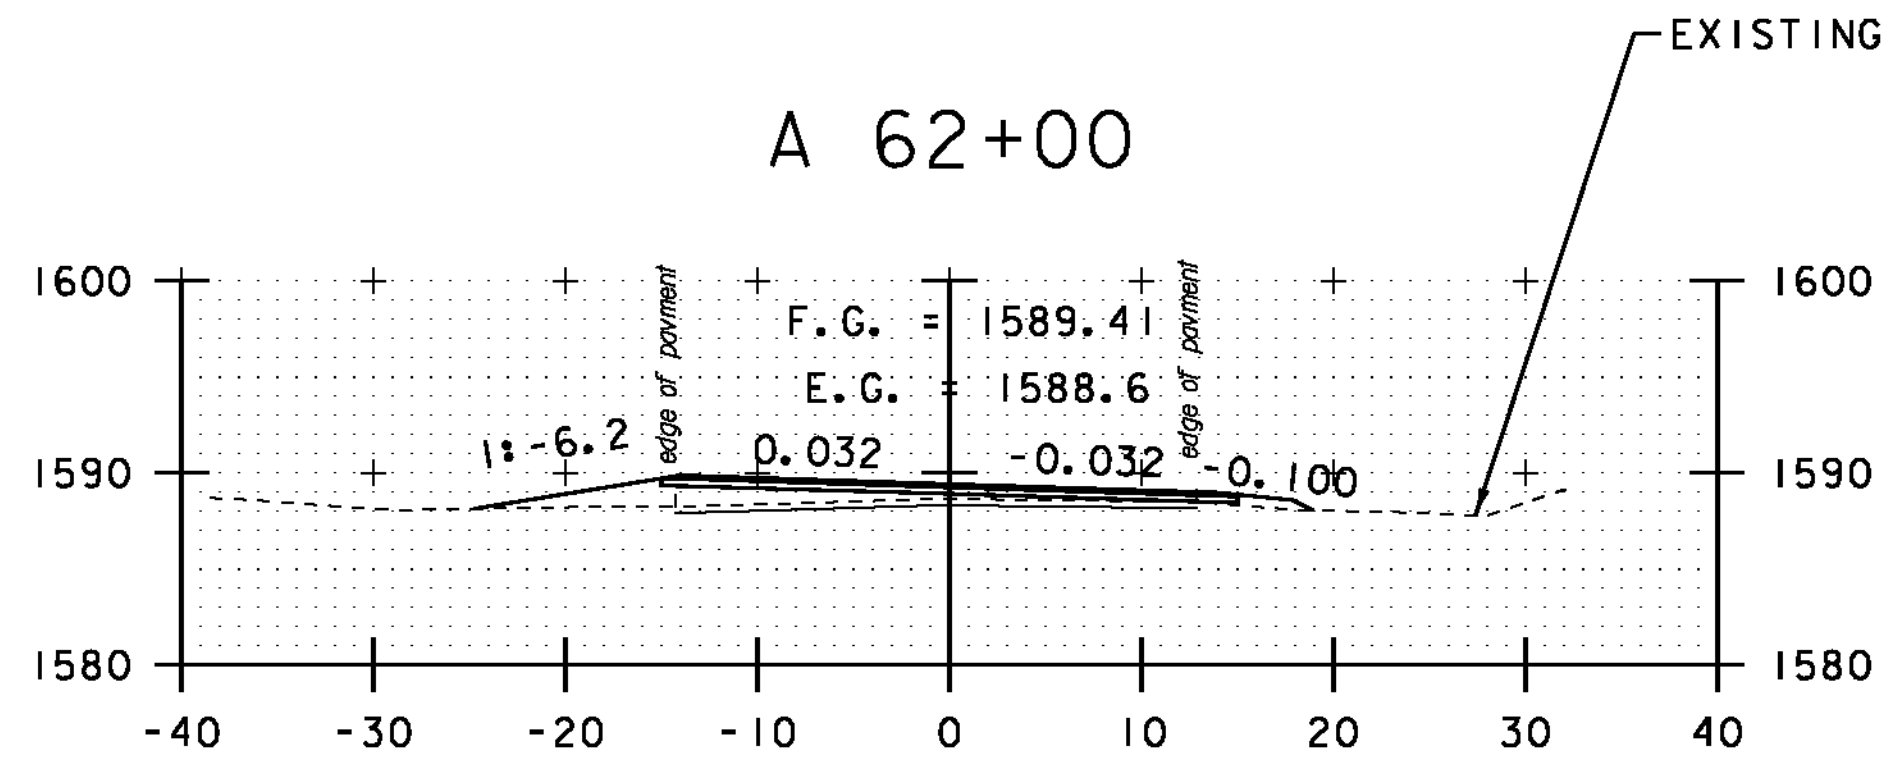


DRIVE LT/ RT
A 61+50

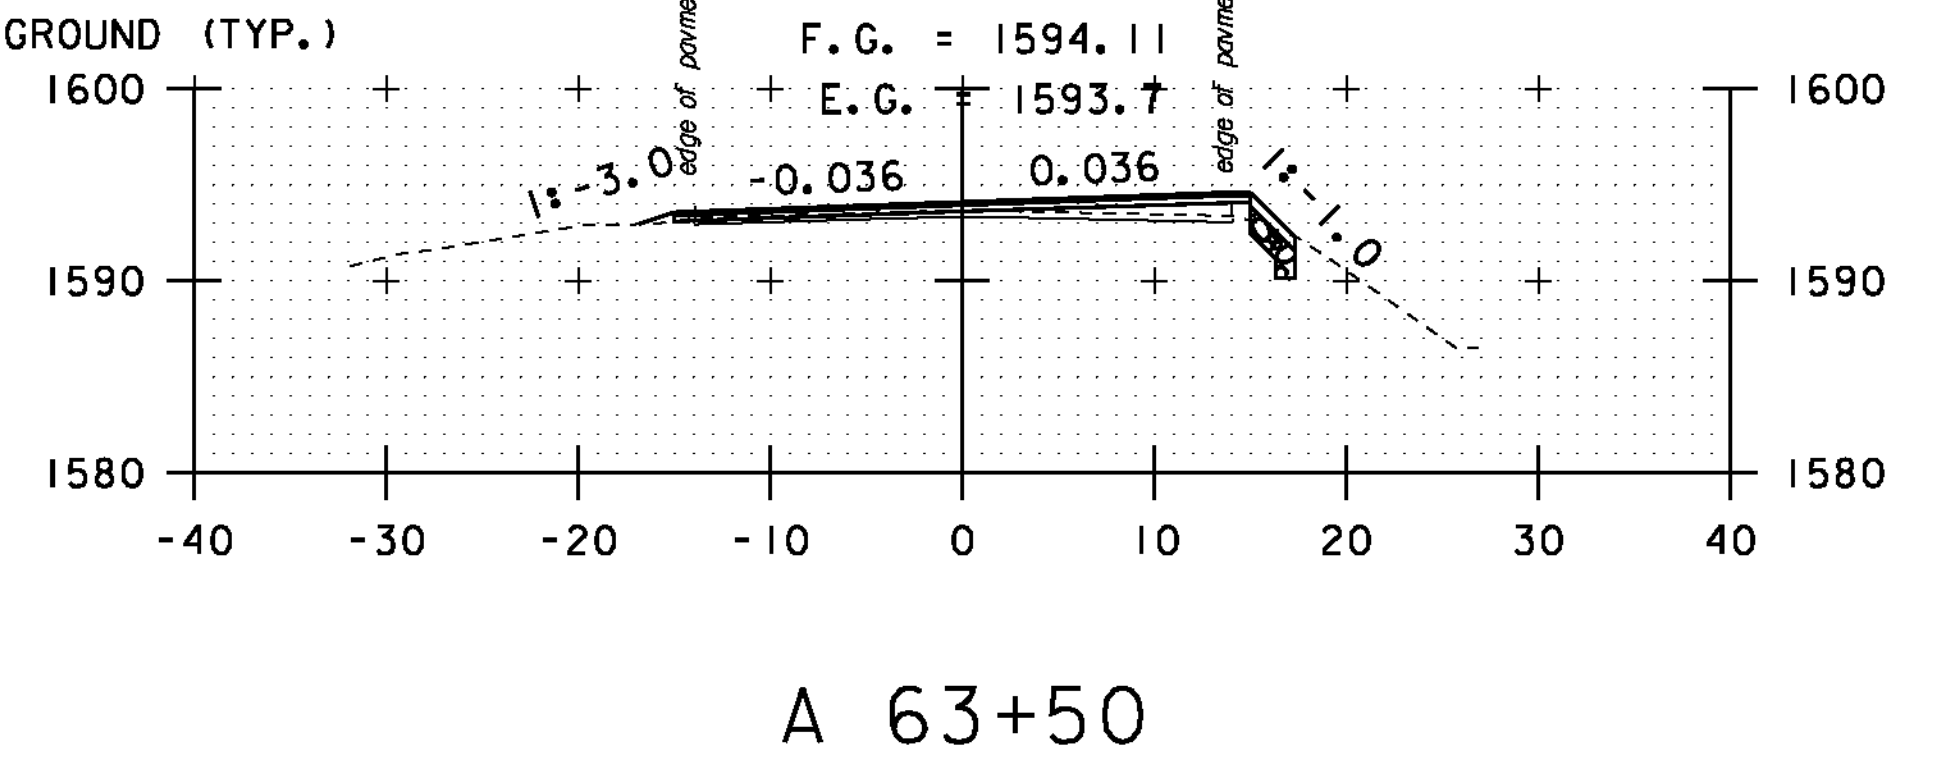


A 63+50

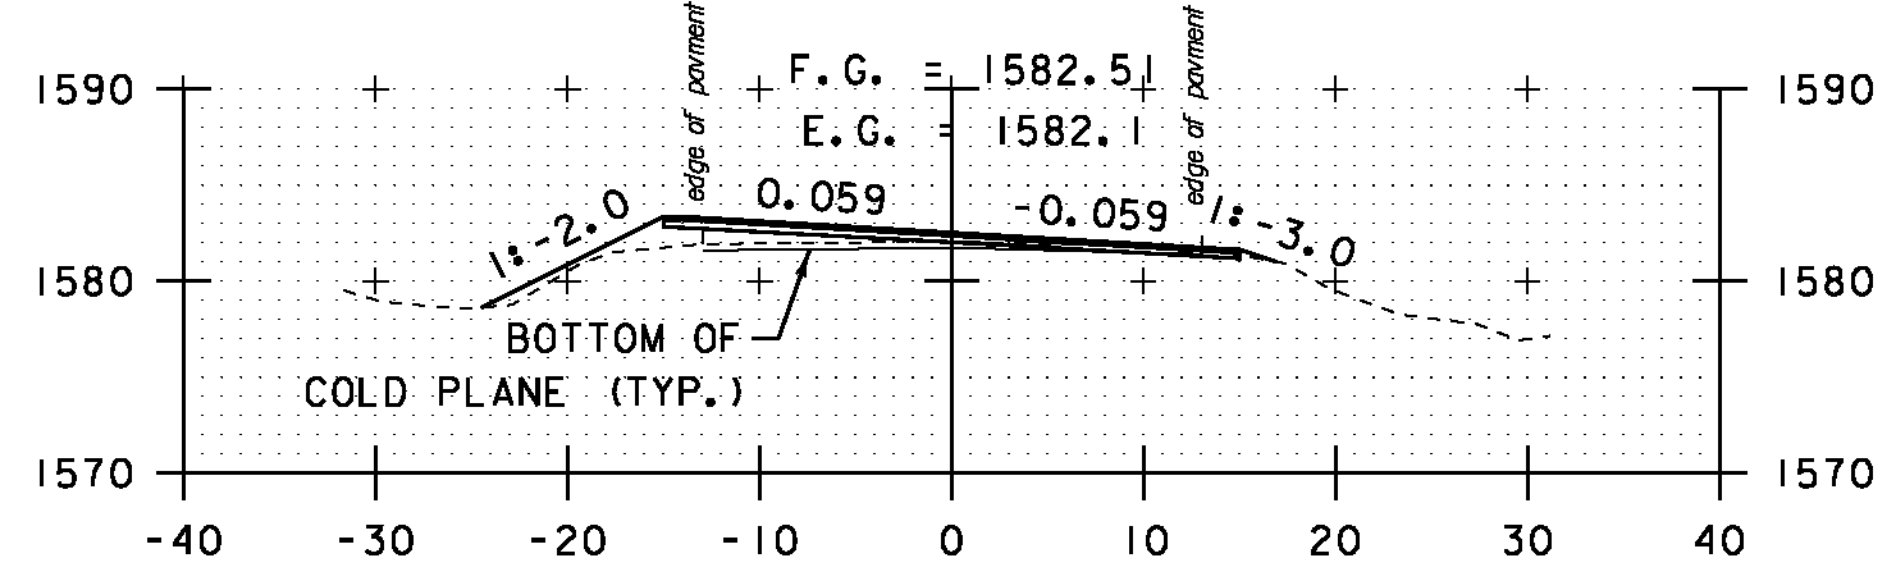


A 59+00

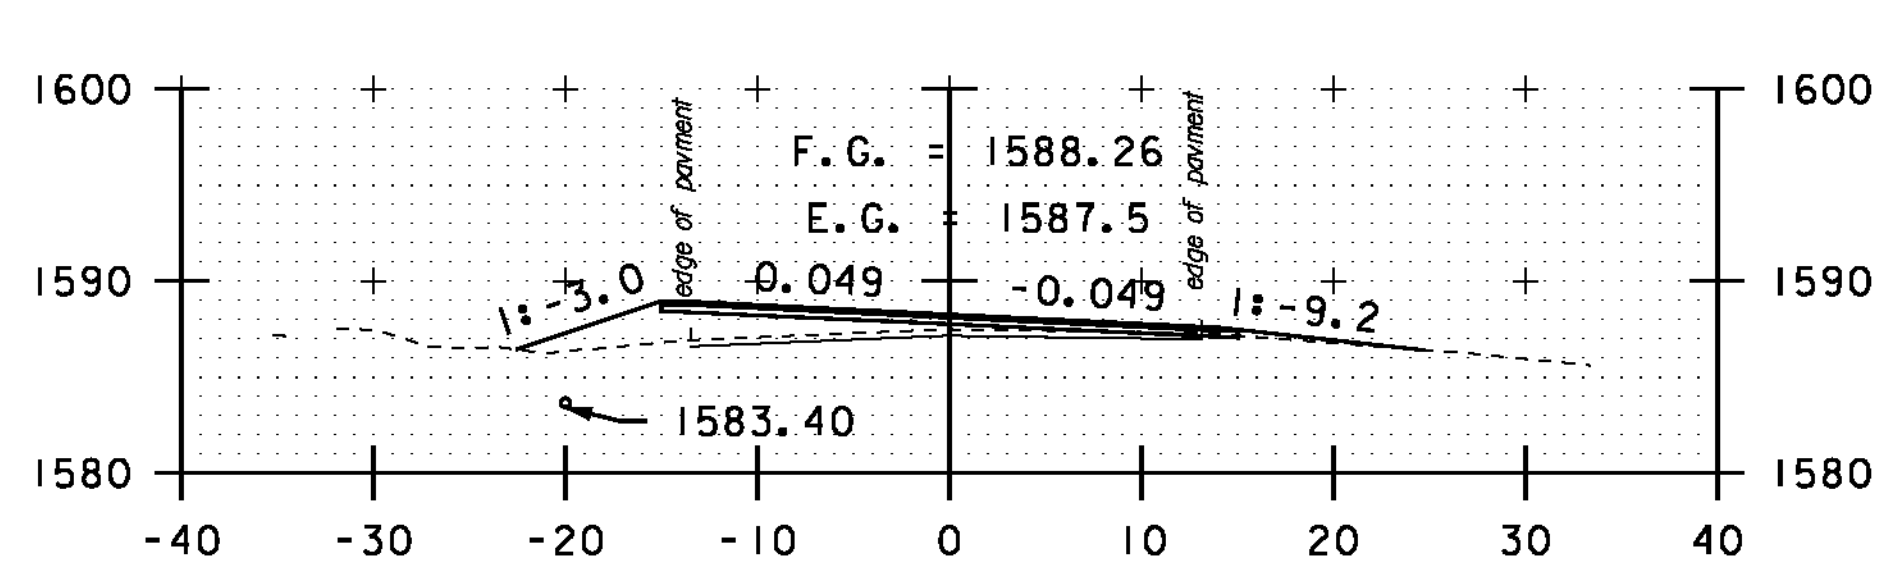


DRIVE RT
A 61+00

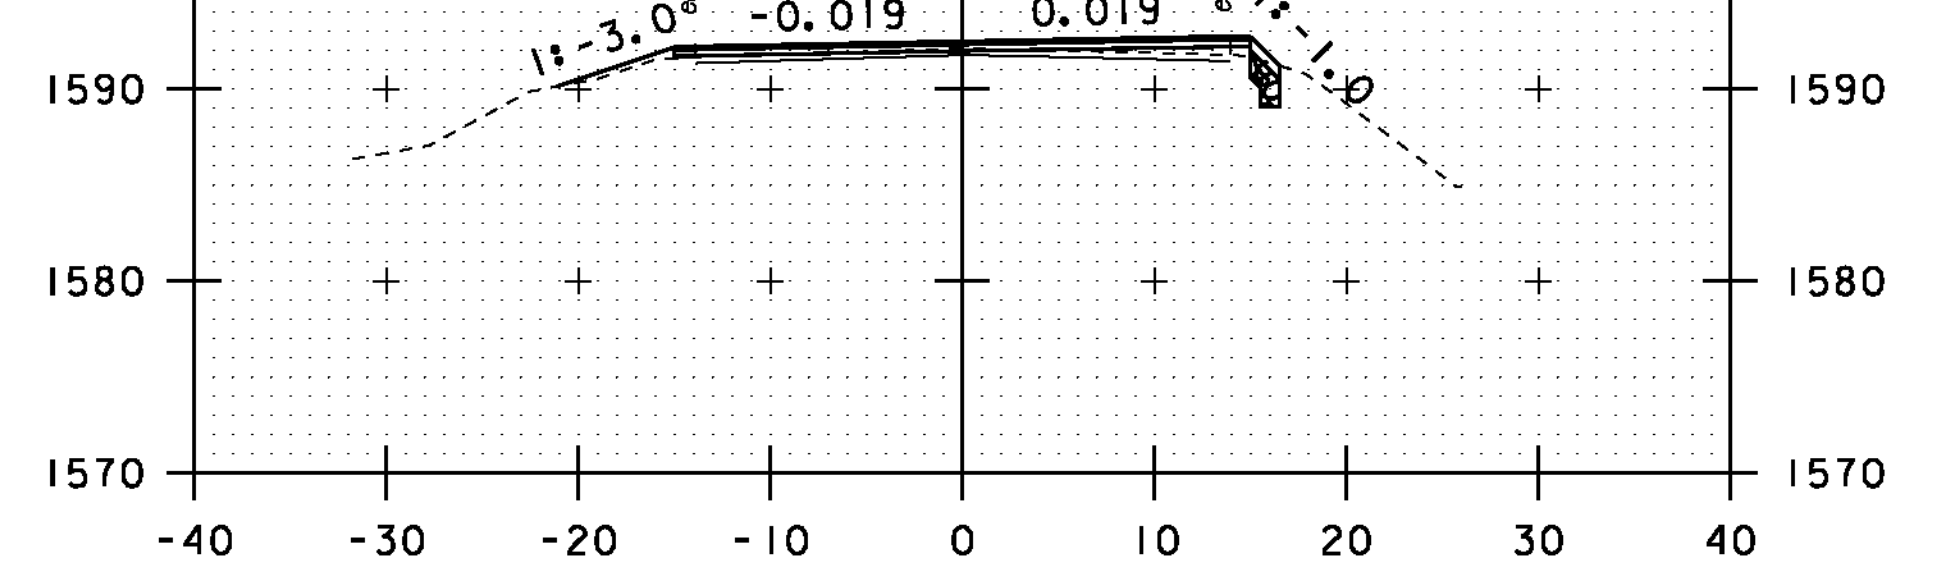


A 63+00

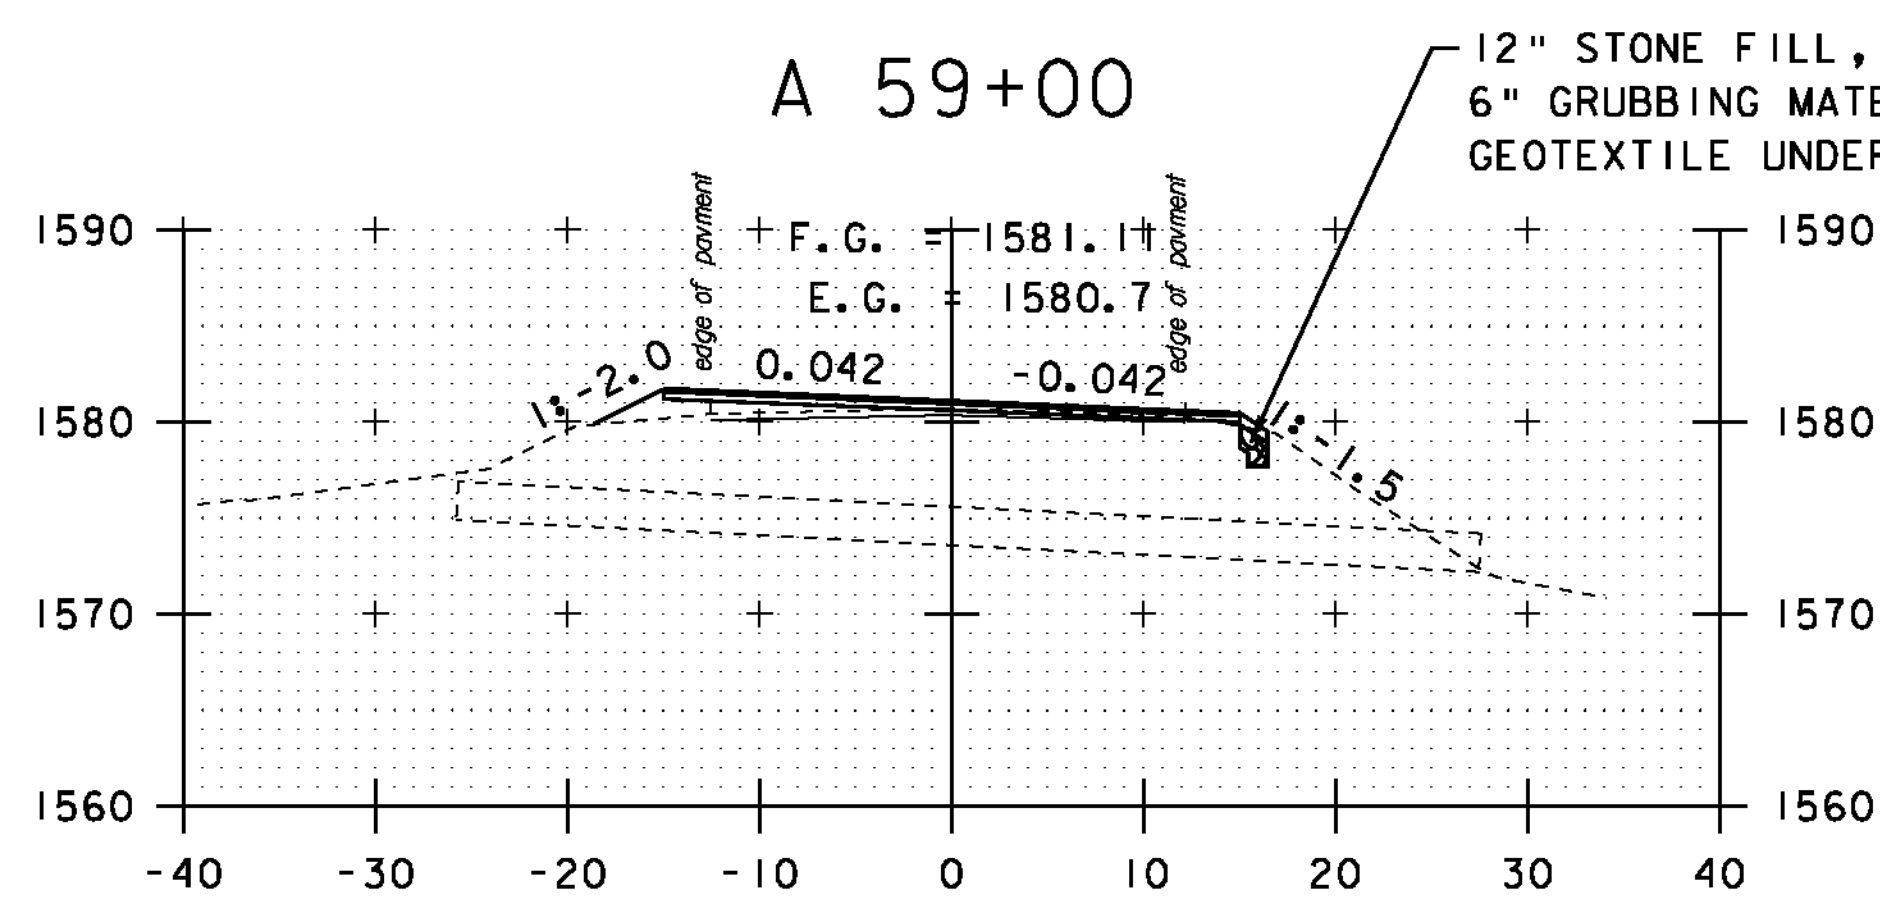

A 58+50

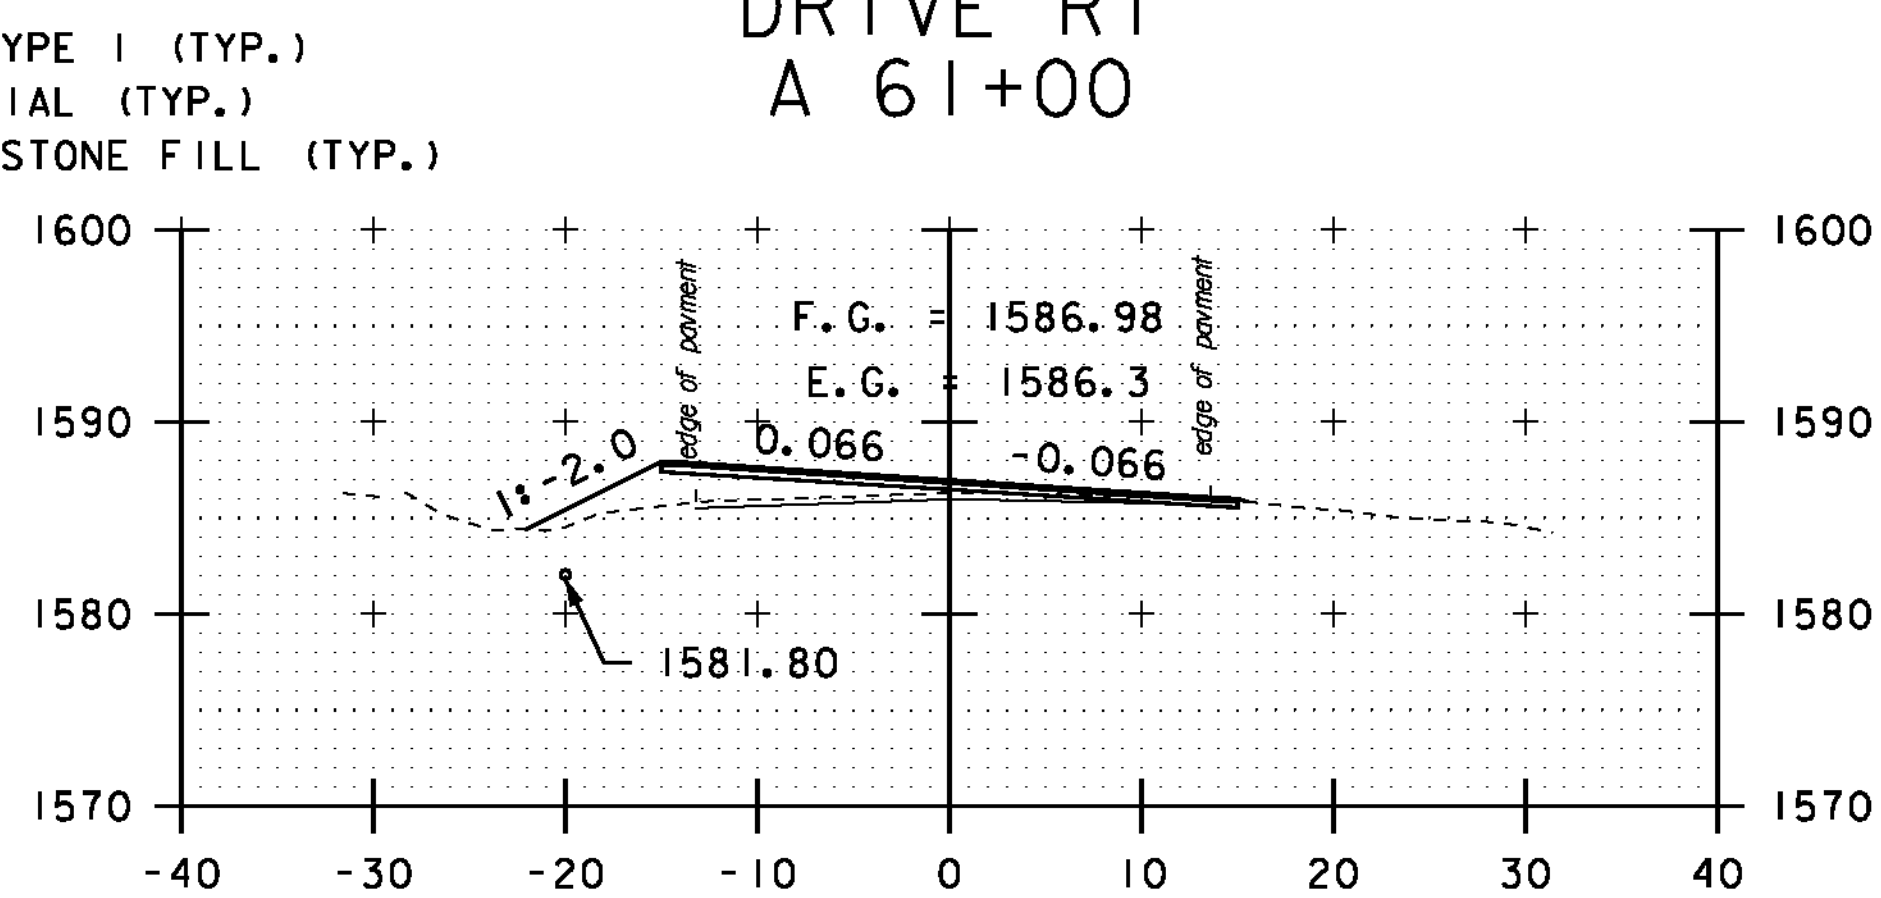

A 60+50

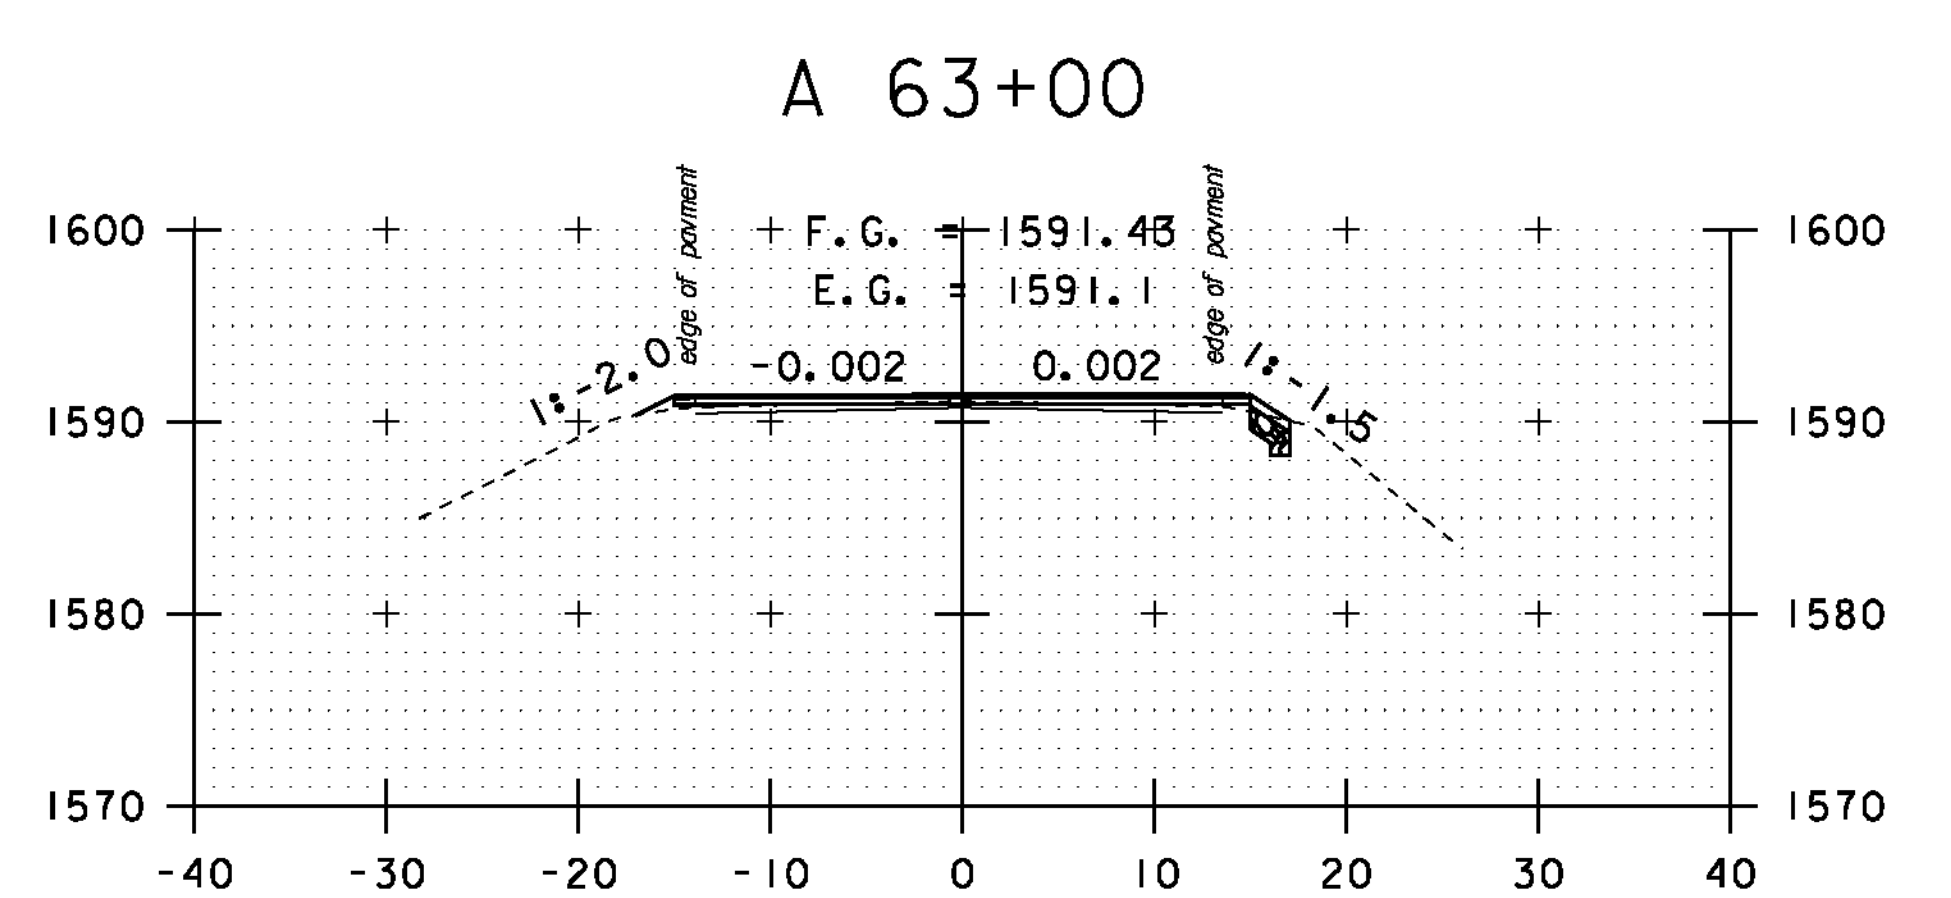

A 62+50

STA. A 58+50 TO STA. A 64+00



CROSS SECTION SHEET 48

PROJECT NAME:	MONTGOMERY-WESTFIELD
PROJECT NUMBER:	STP 2906(I)
FILE NAME:	p10ci90.dgn
PROJECT LEADER:	CDL
DESIGNED BY:	SJL
PLOT FILE:	p10ci90_162.1
PLOT DATE:	9/5/12
DRAWN BY:	SJL
CHECKED BY:	CDL
SHEET	162 OF 178