




A 76+00

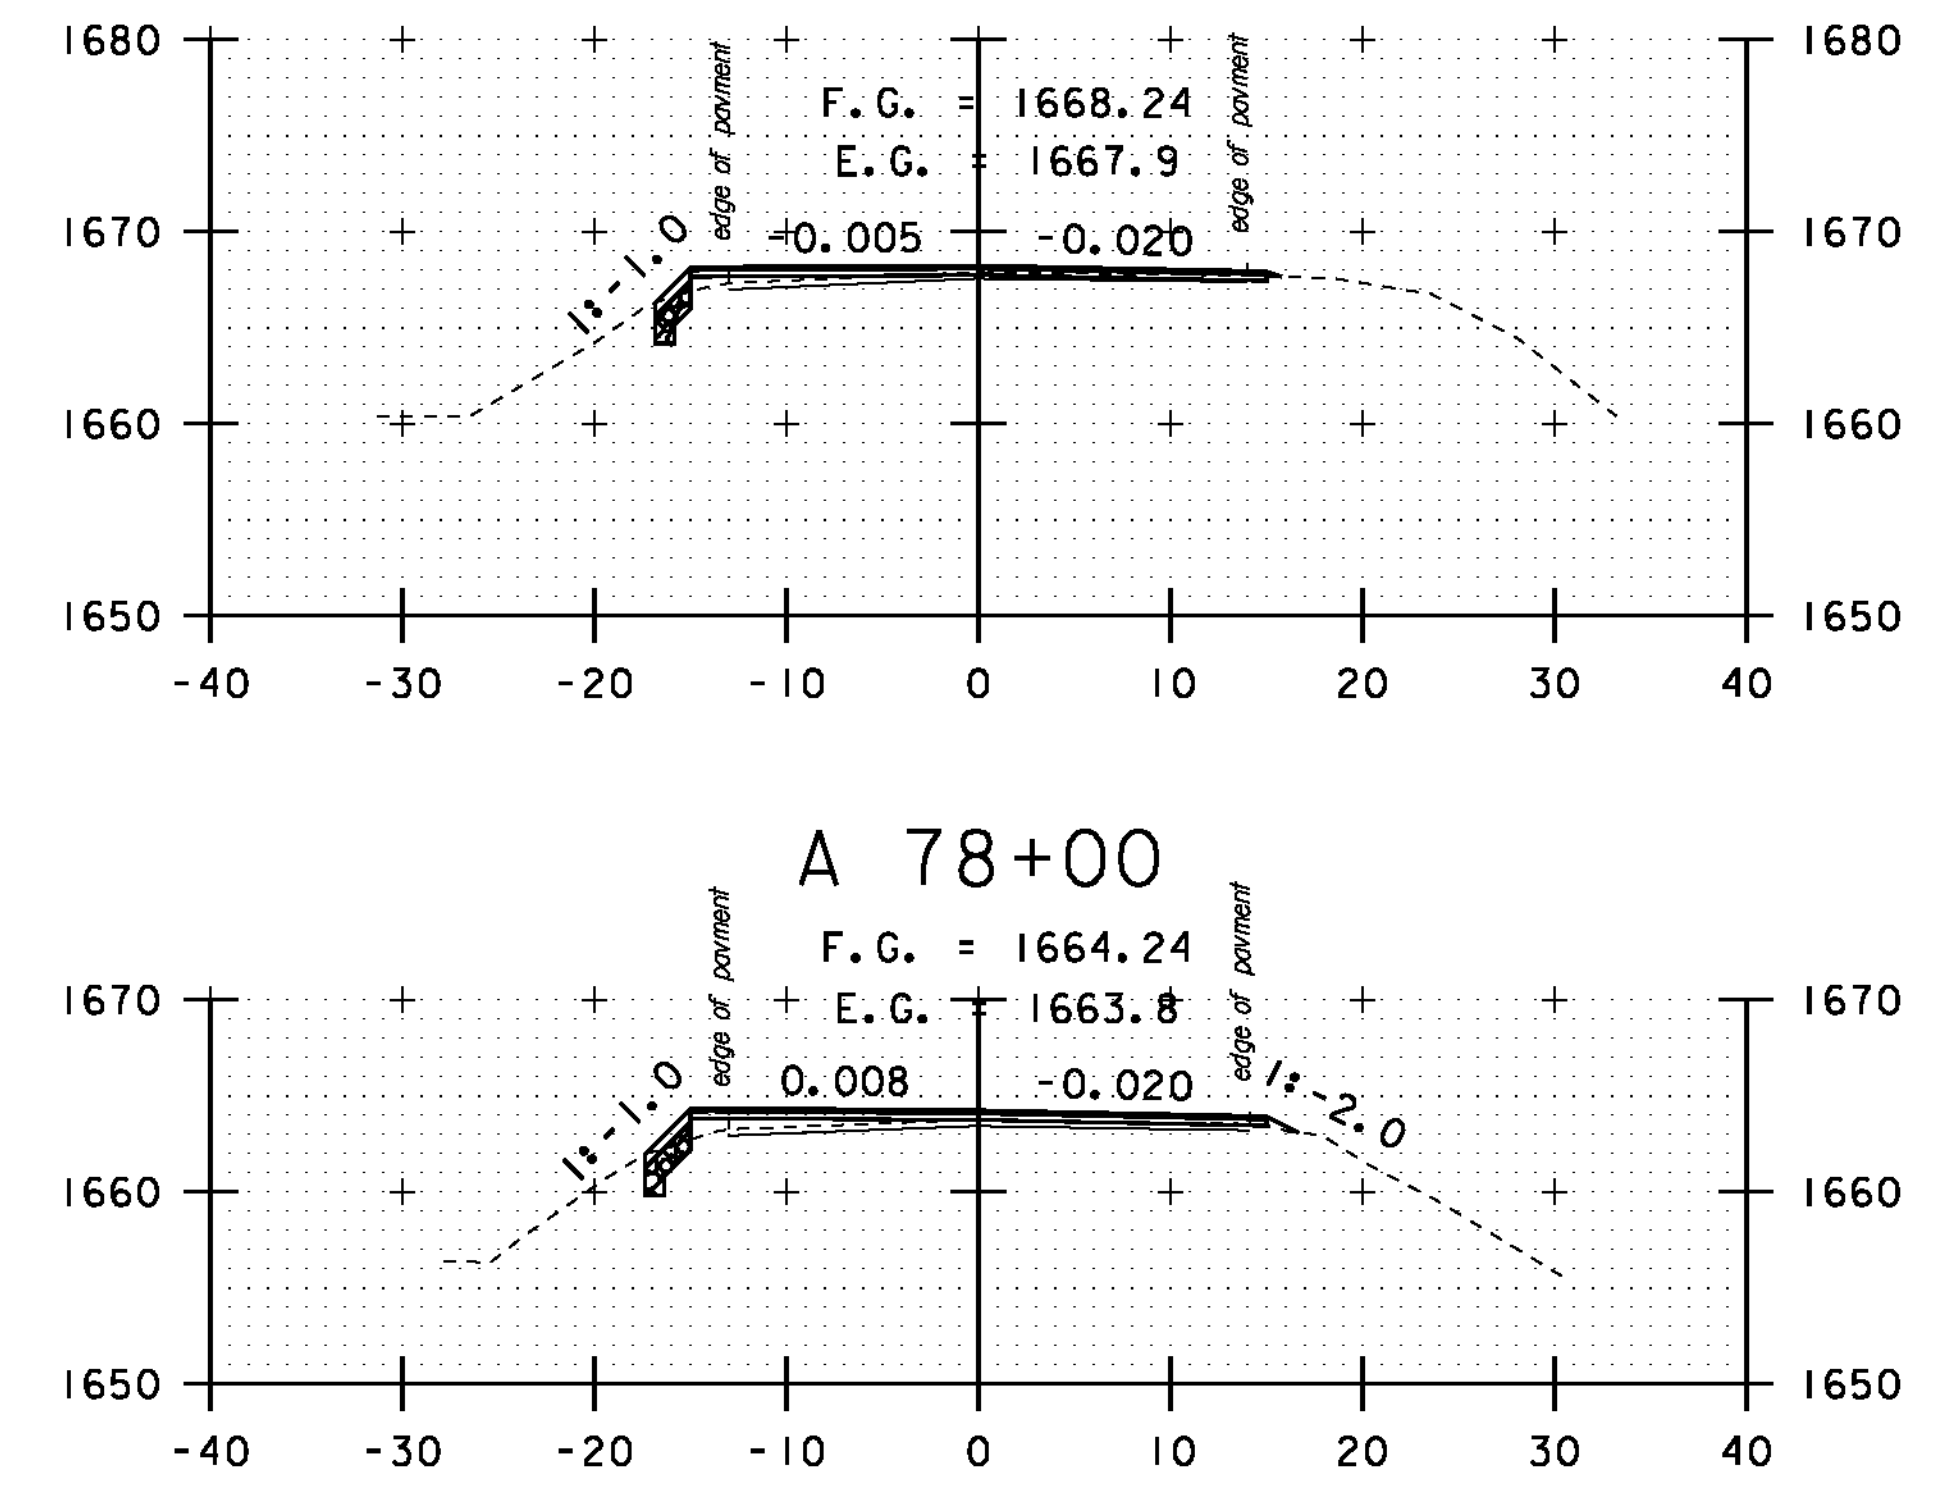


A 77+00

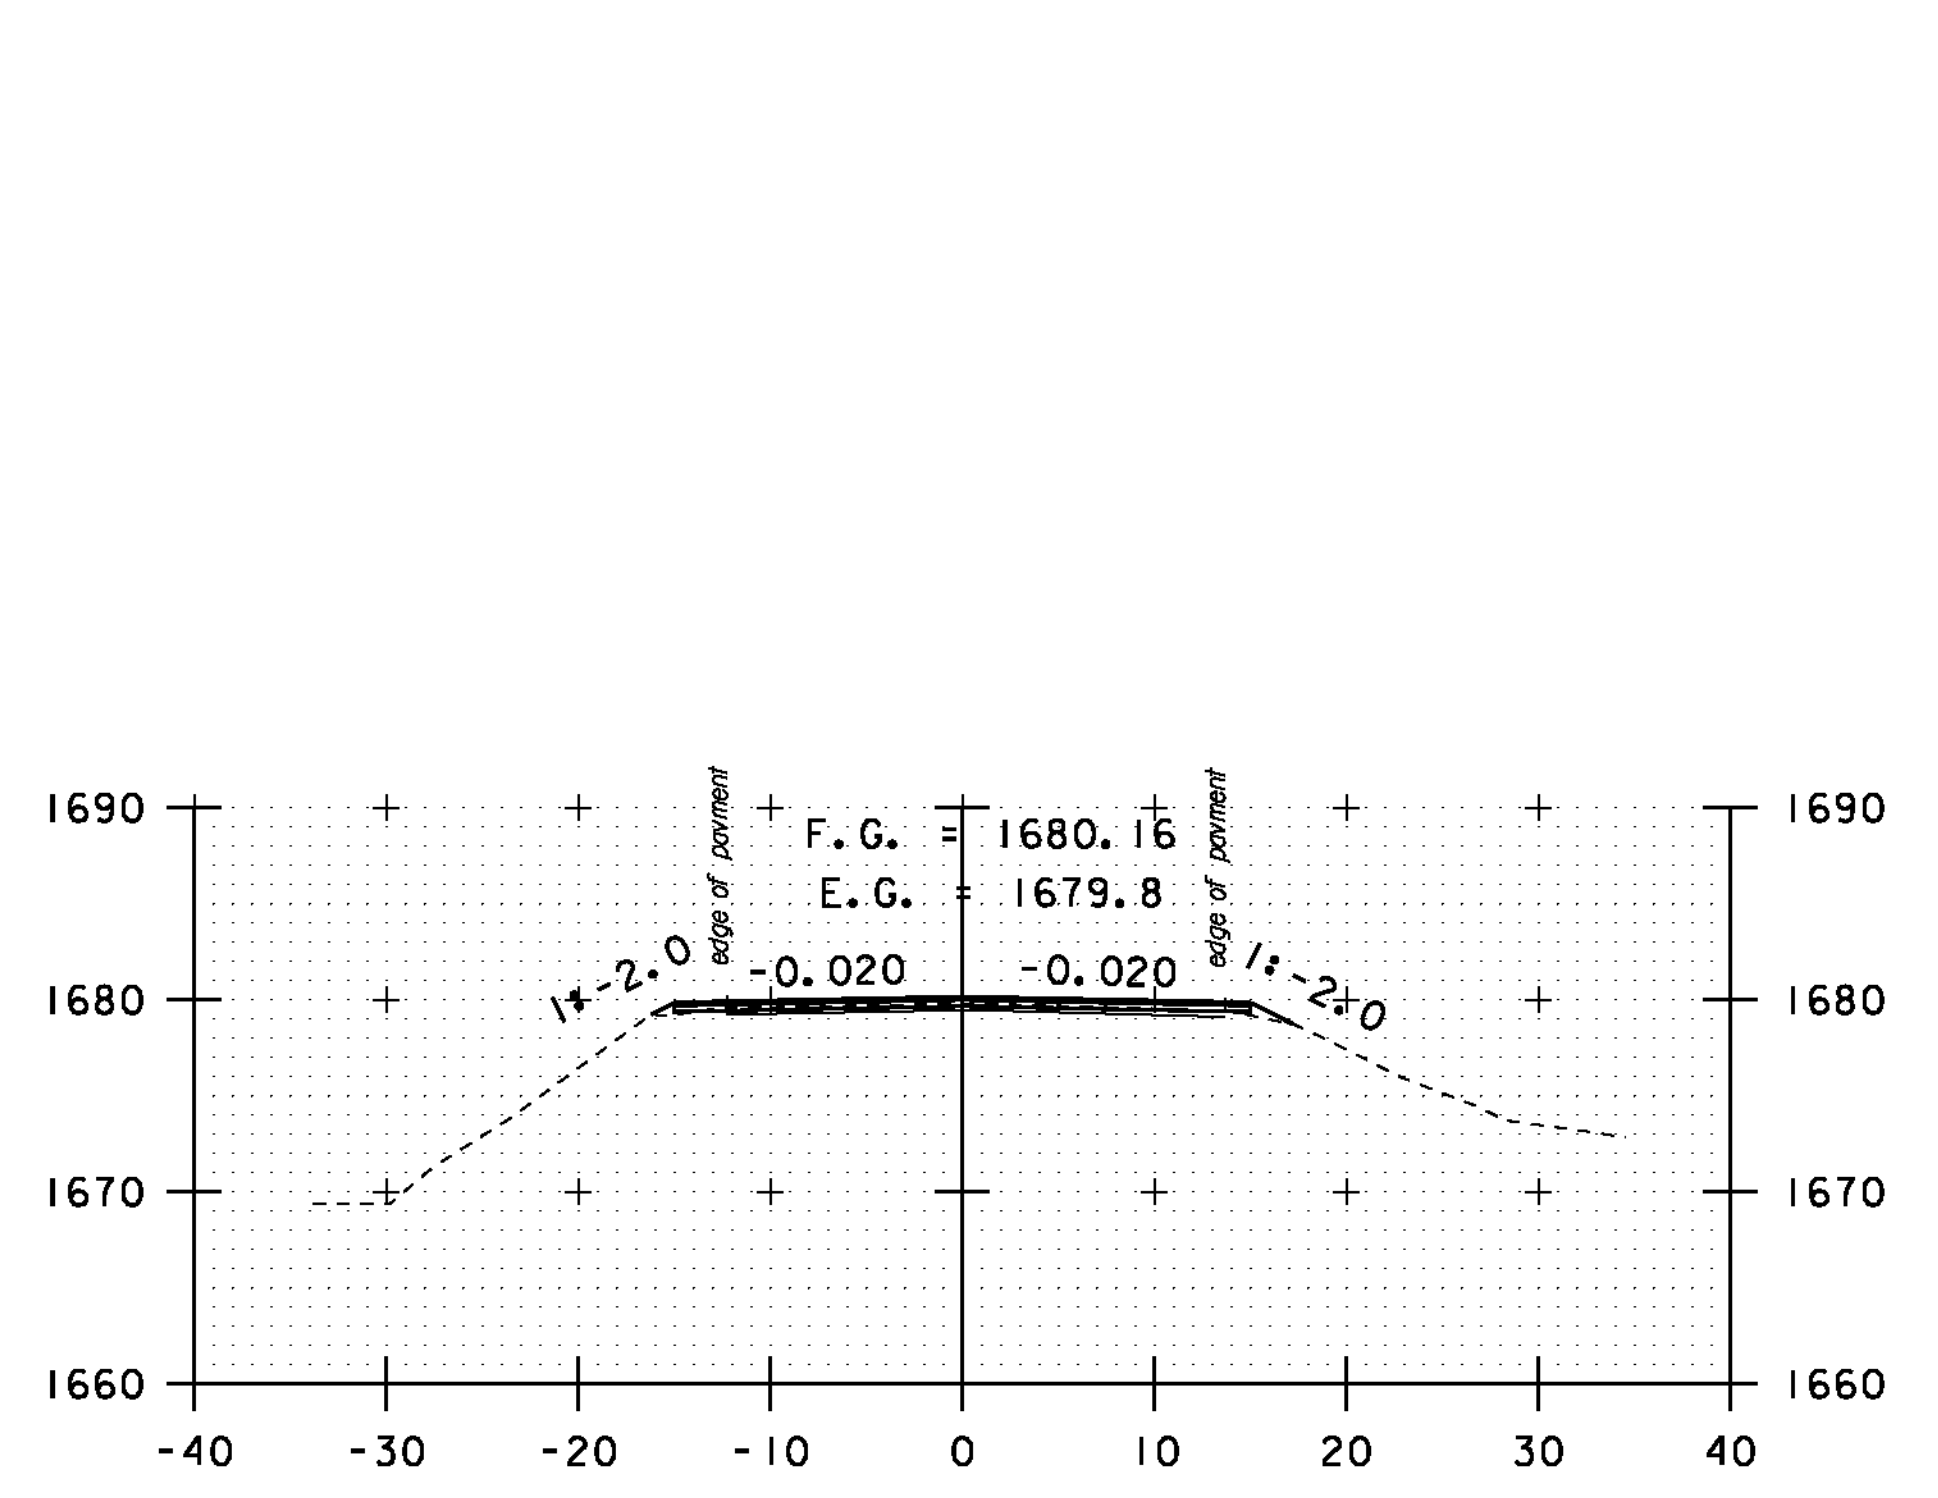


A 78+00

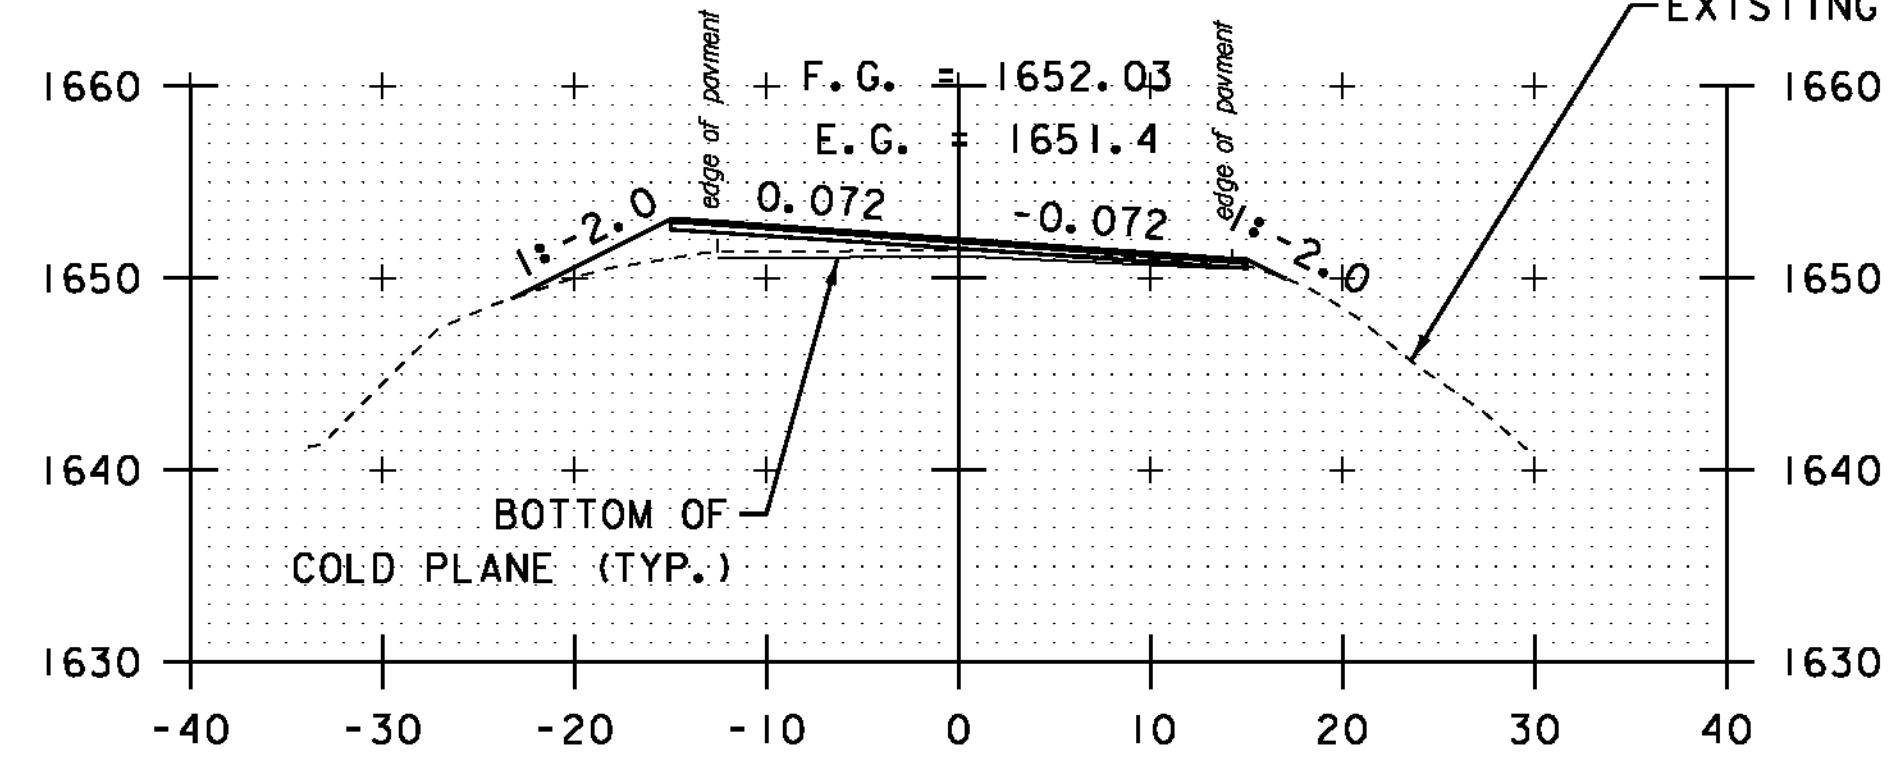


A 75+50

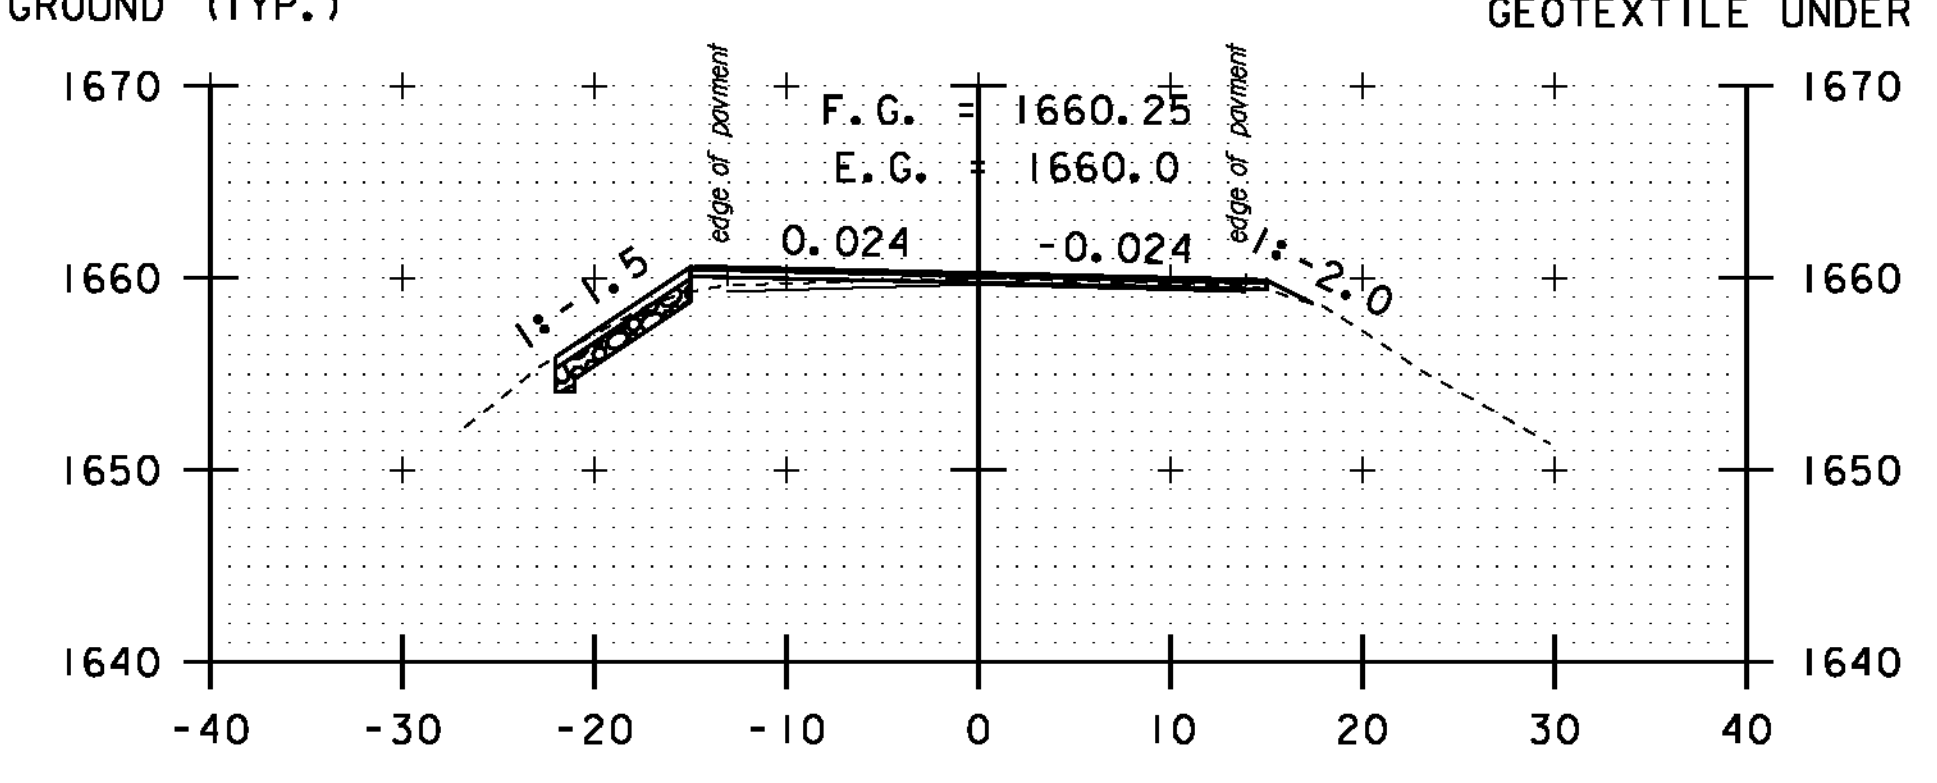


A 77+50

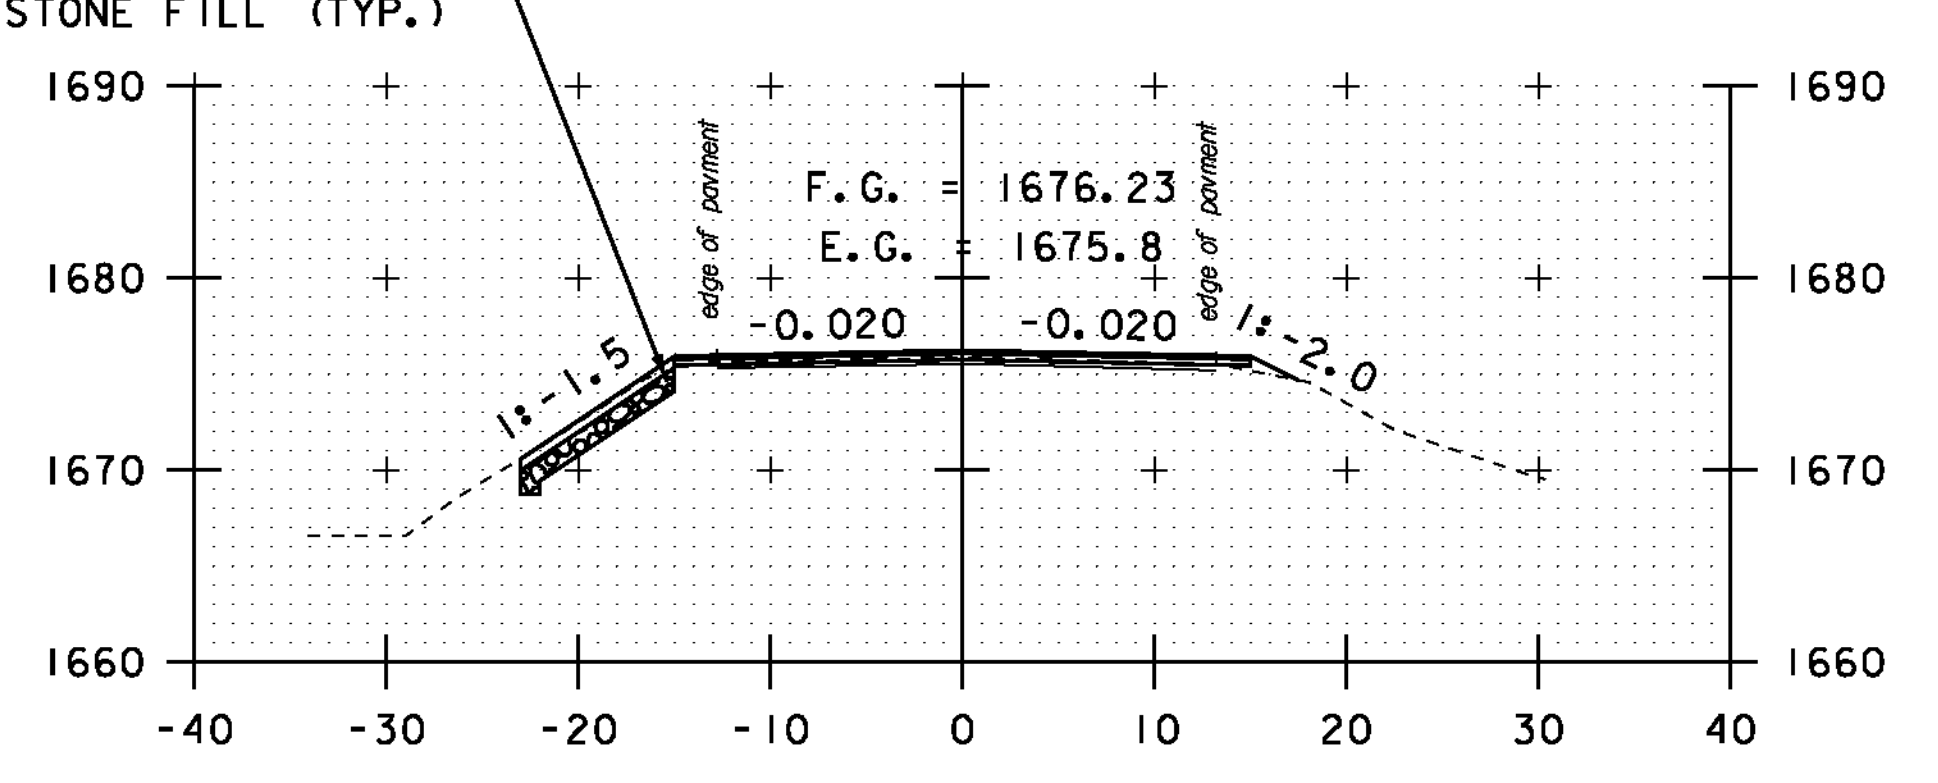


A 79+50

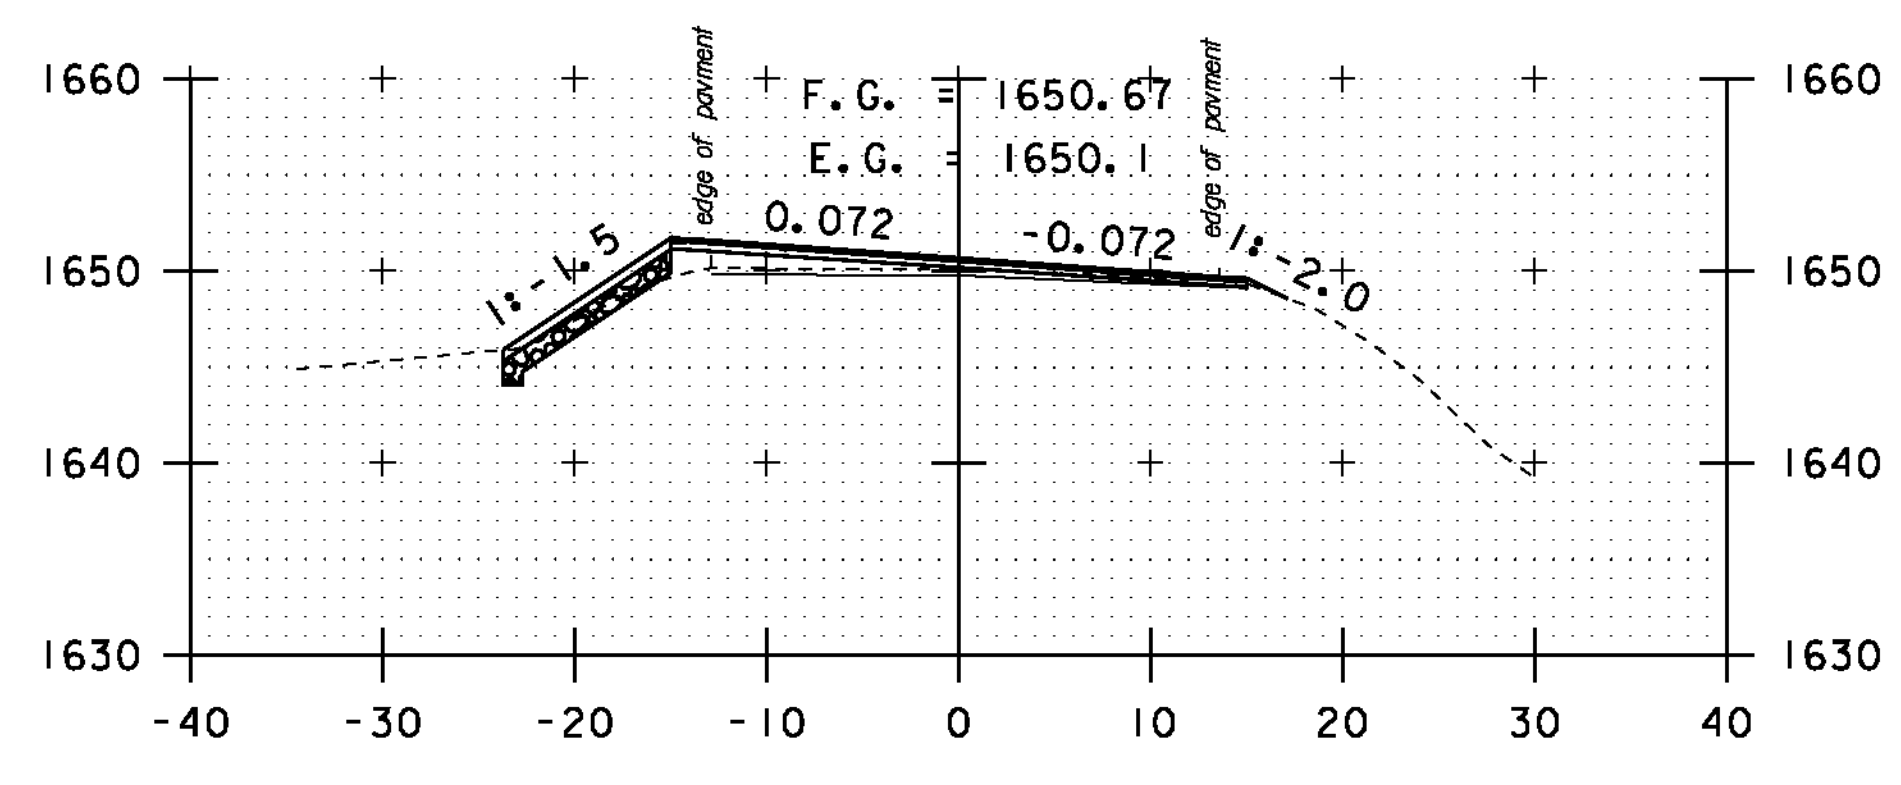

A 75+00

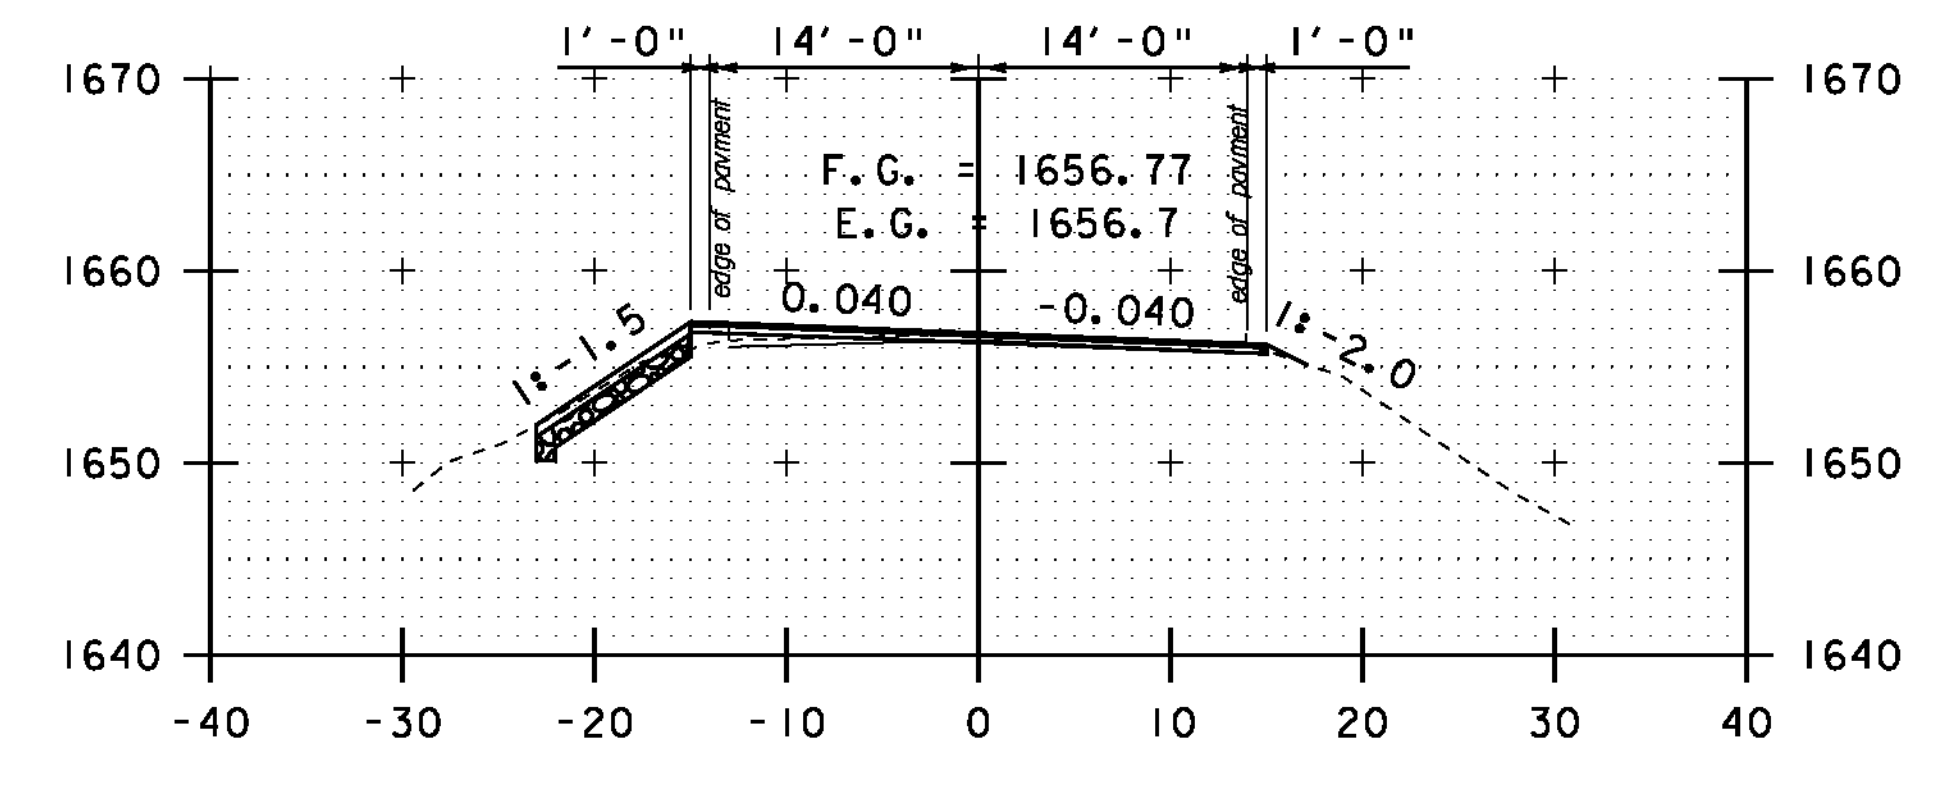


A 76+50

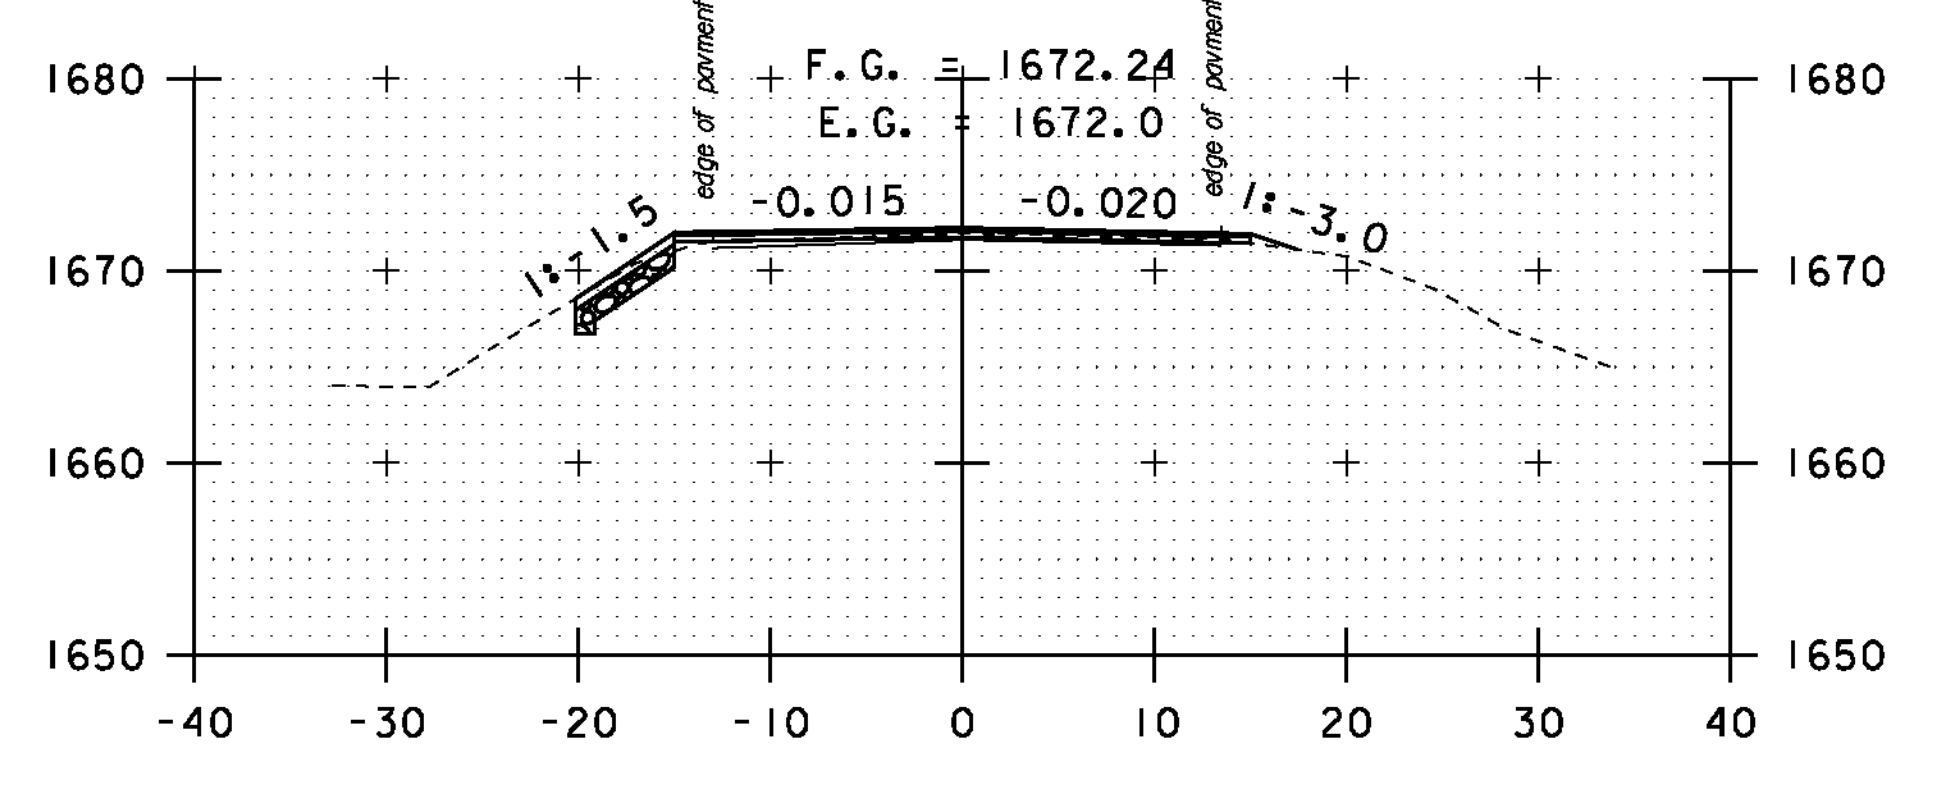

A 78+50

STA. A 75+00 TO STA. A 79+50

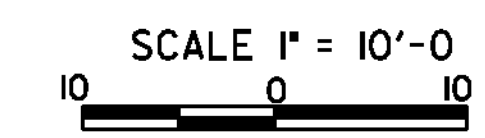

<b>CROSS SECTION SHEET 51</b>	PROJECT NAME: MONTGOMERY-WESTFIELD	PLOT DATE: 9/5/12
	PROJECT NUMBER: STP 2906(1)	DRAWN BY: SJL
	FILE NAME: p10CI90.dgn	CHECKED BY: CDL
	DESIGNED BY: SJL	SHEET 165 OF 178
	PLOT FILE: p10CI90_165.1	