




A 92+00

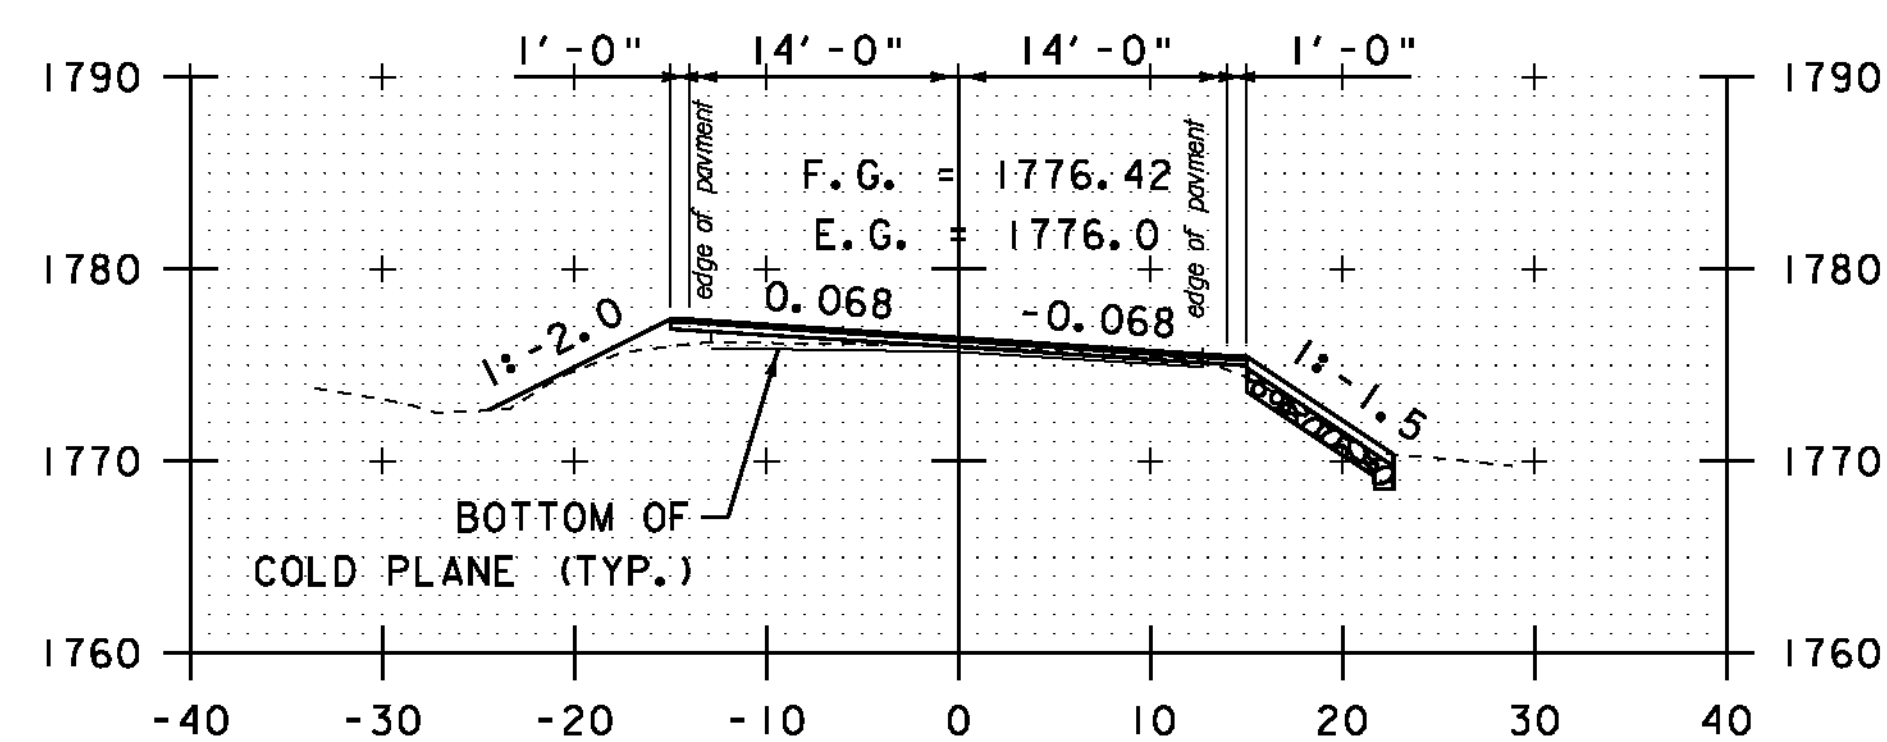


A 91+50

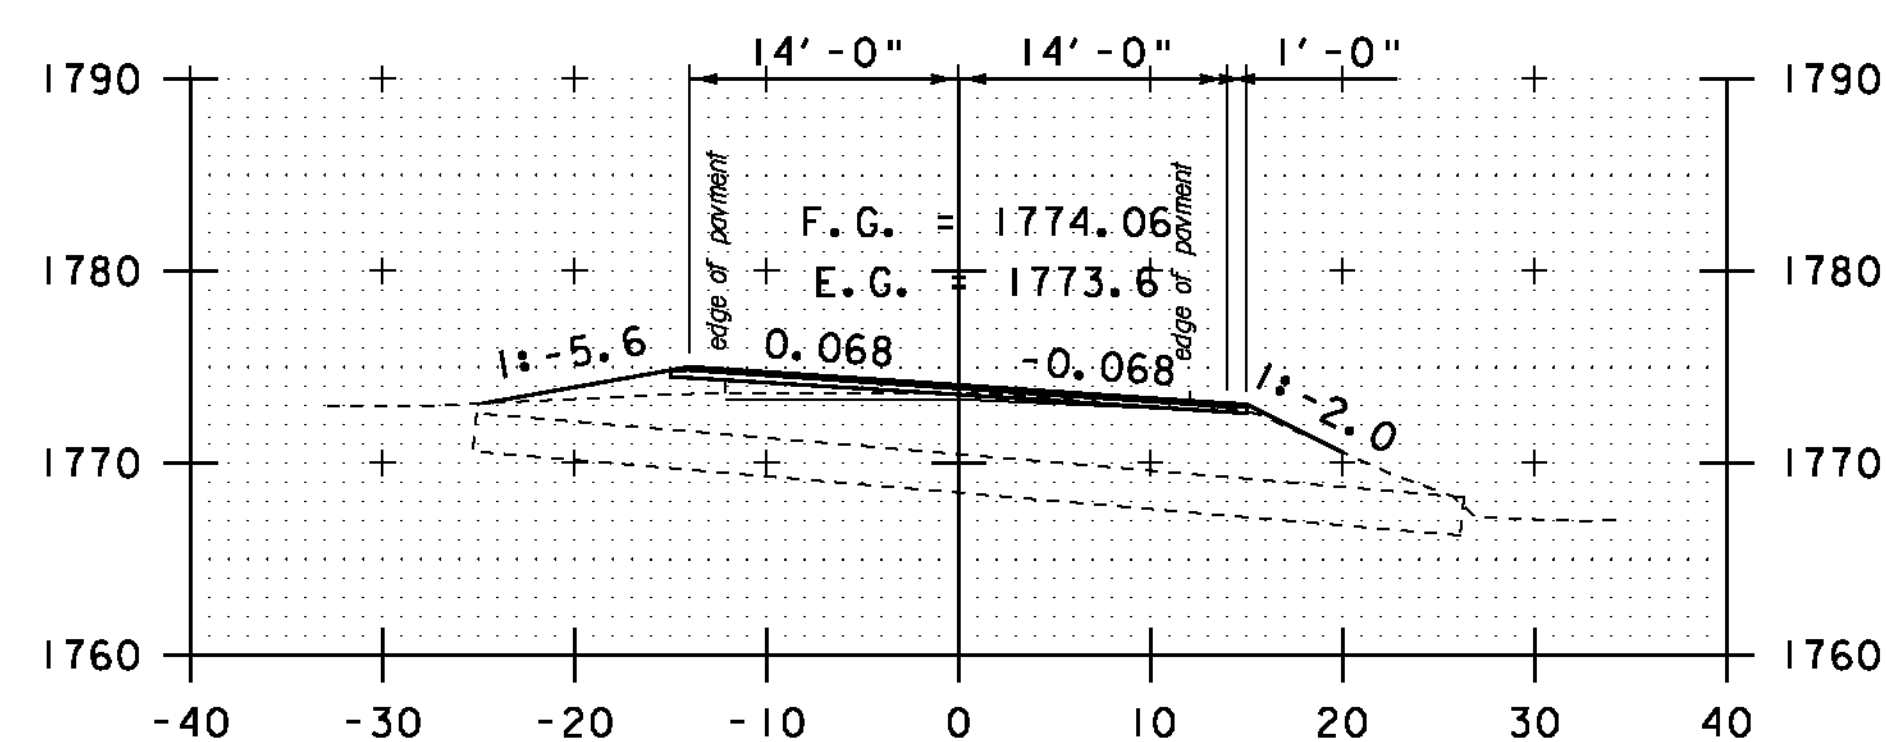


DRIVE LT
A 91+00

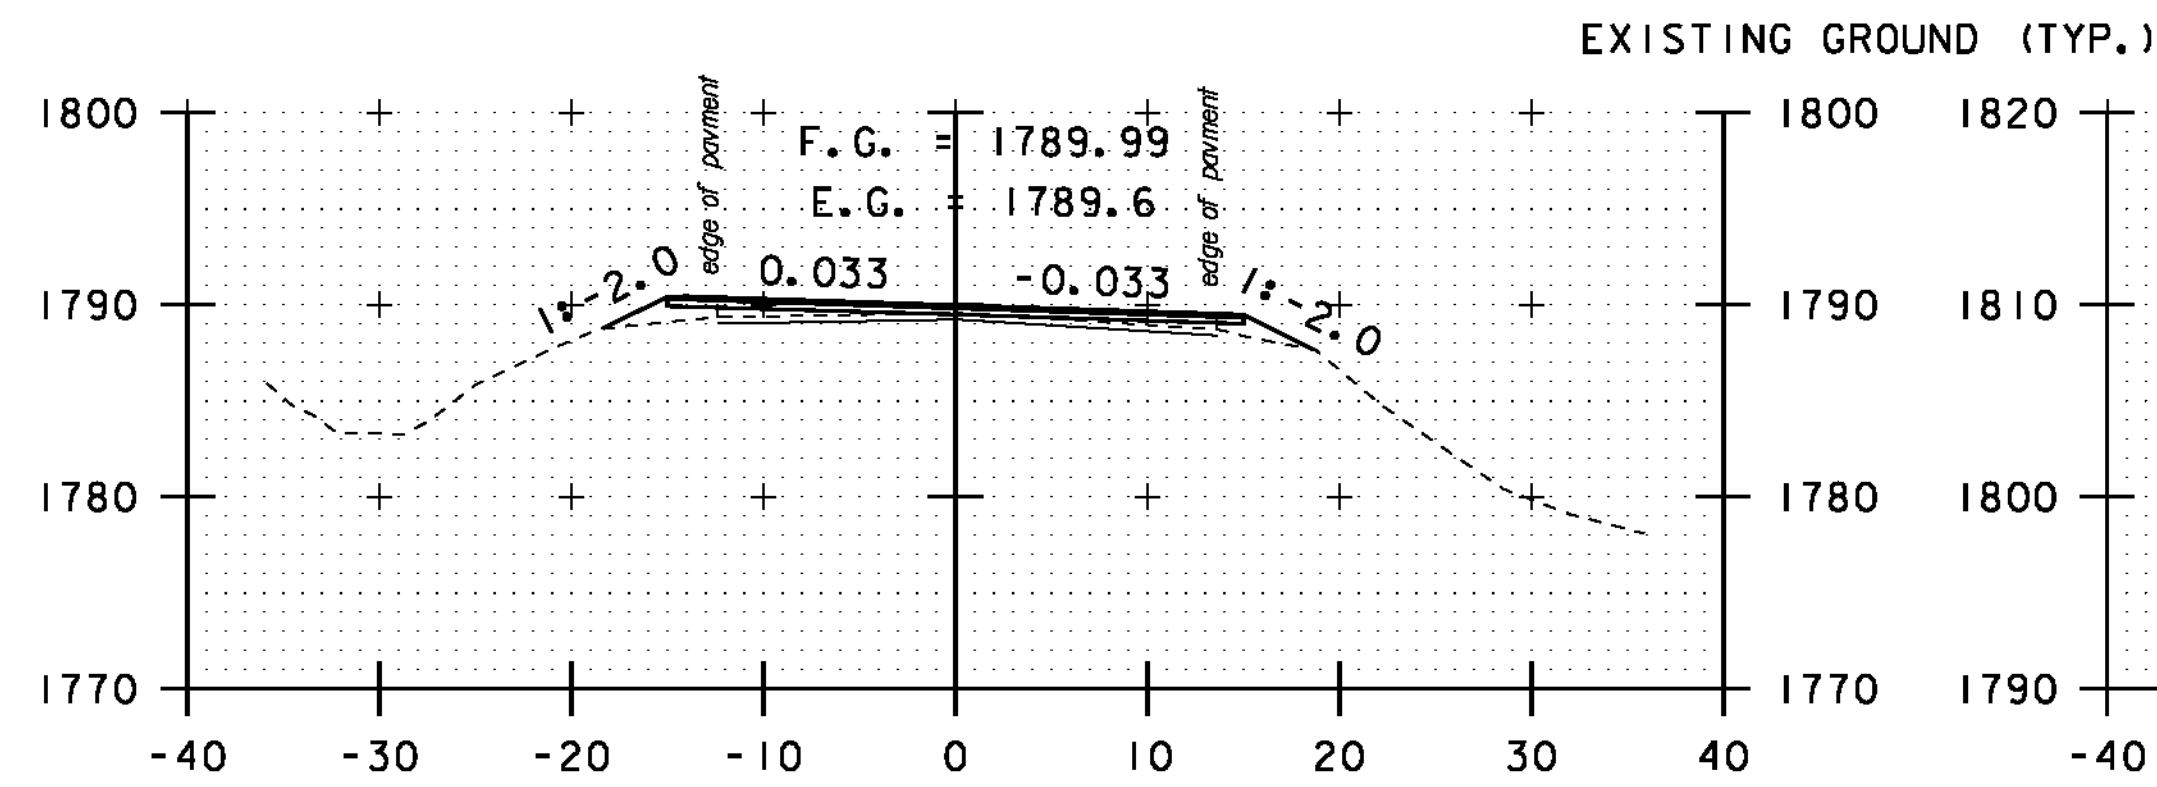


A 93+50

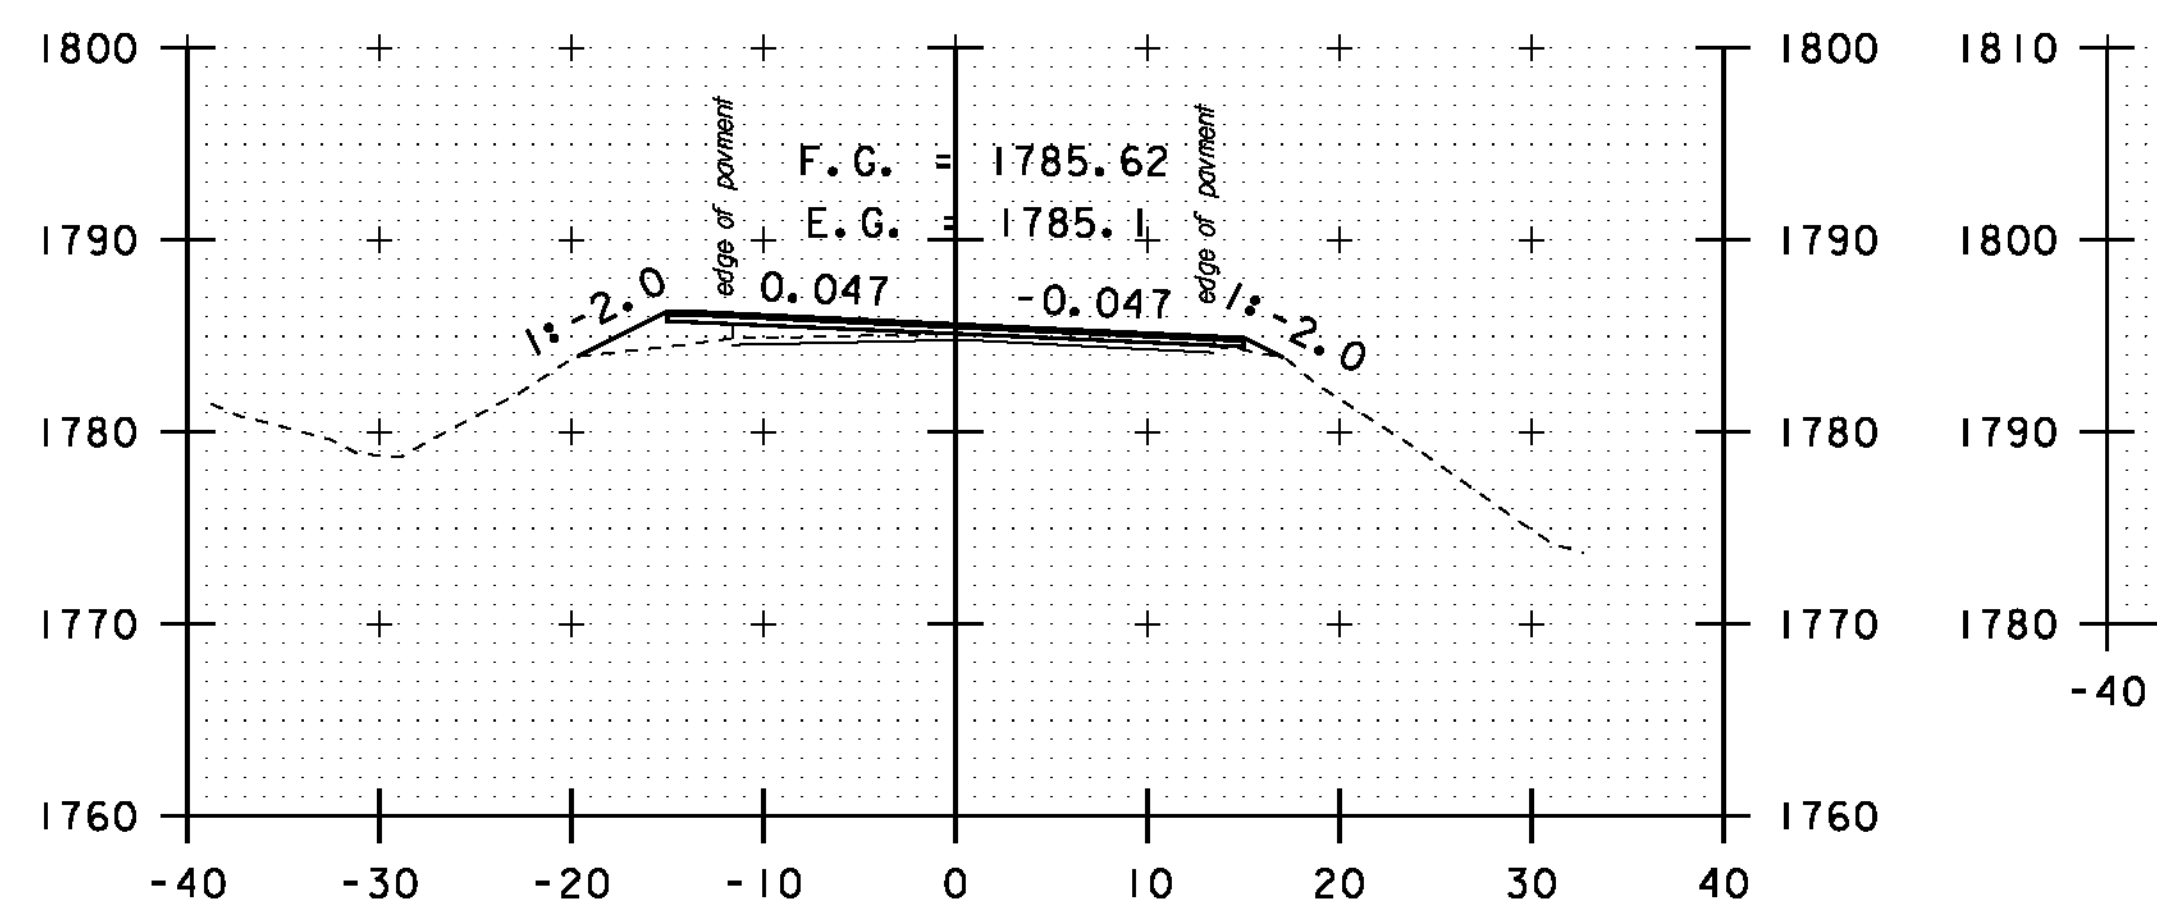


A 93+00

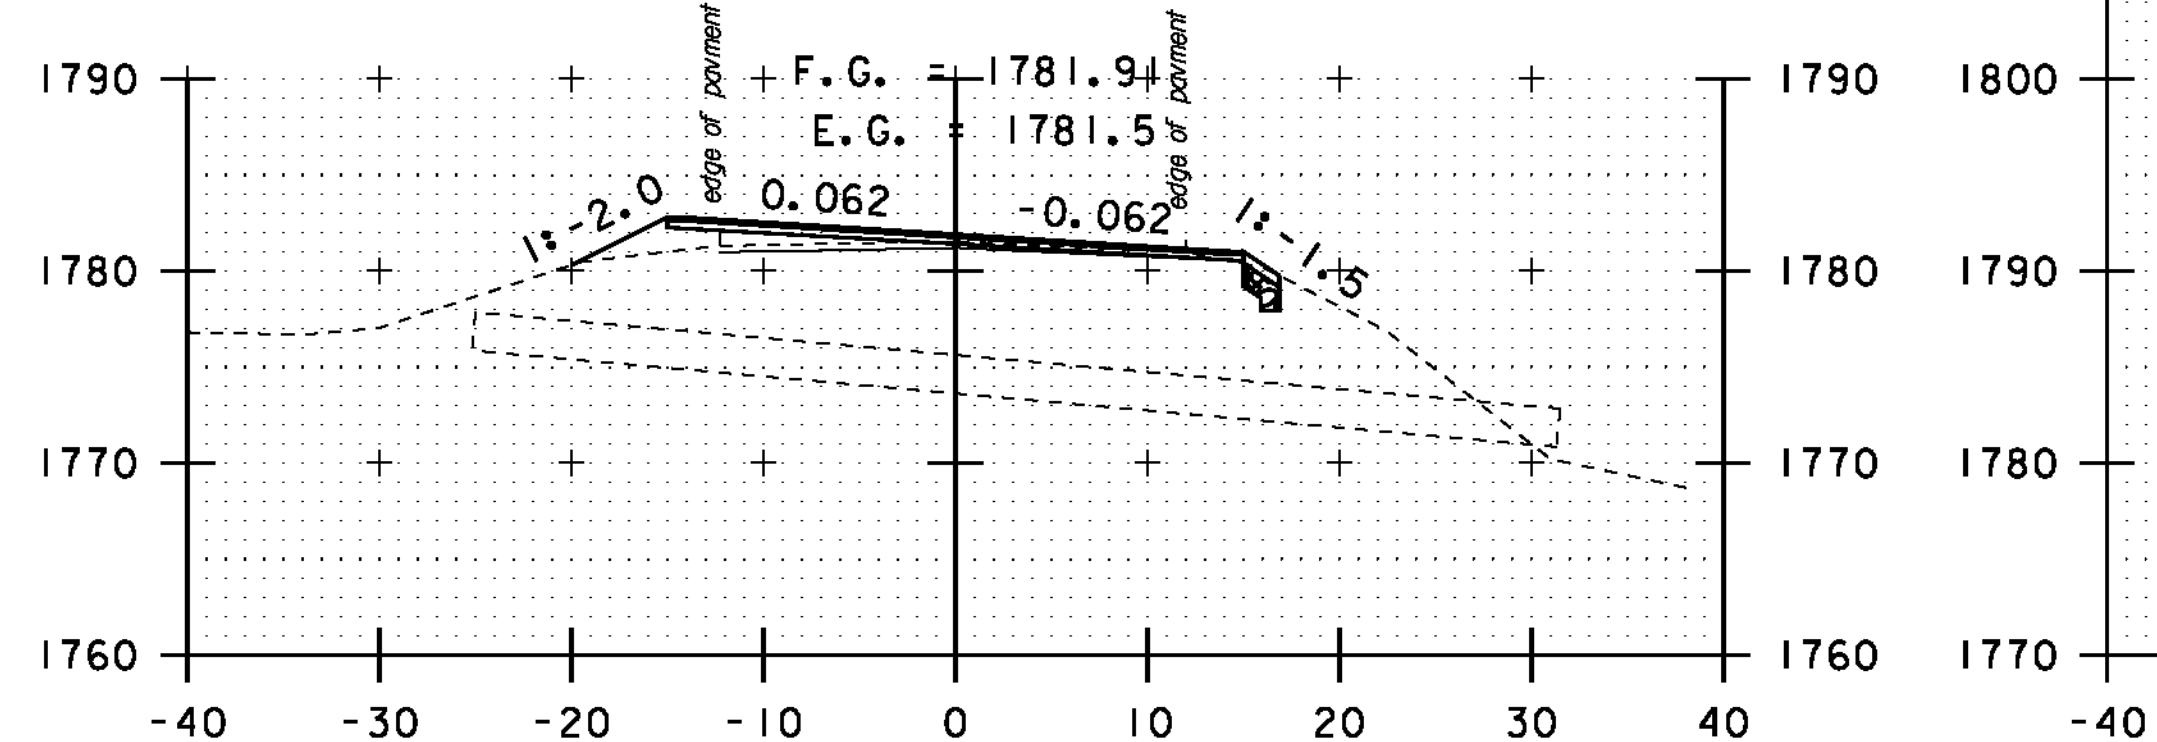


A 92+50

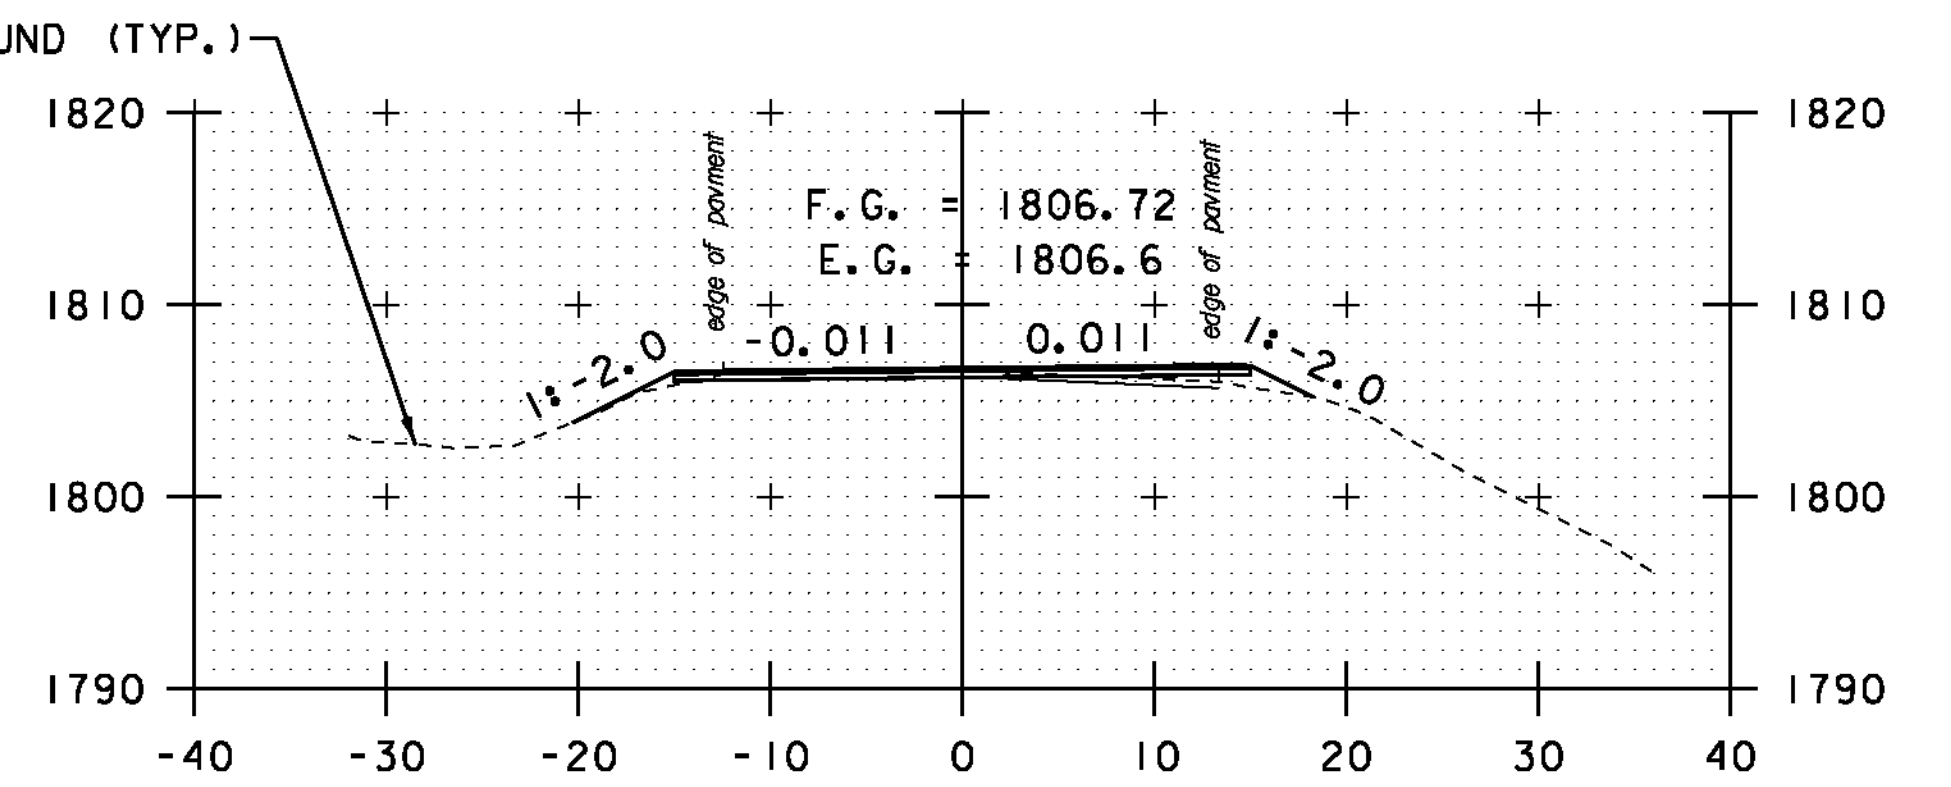

A 95+00

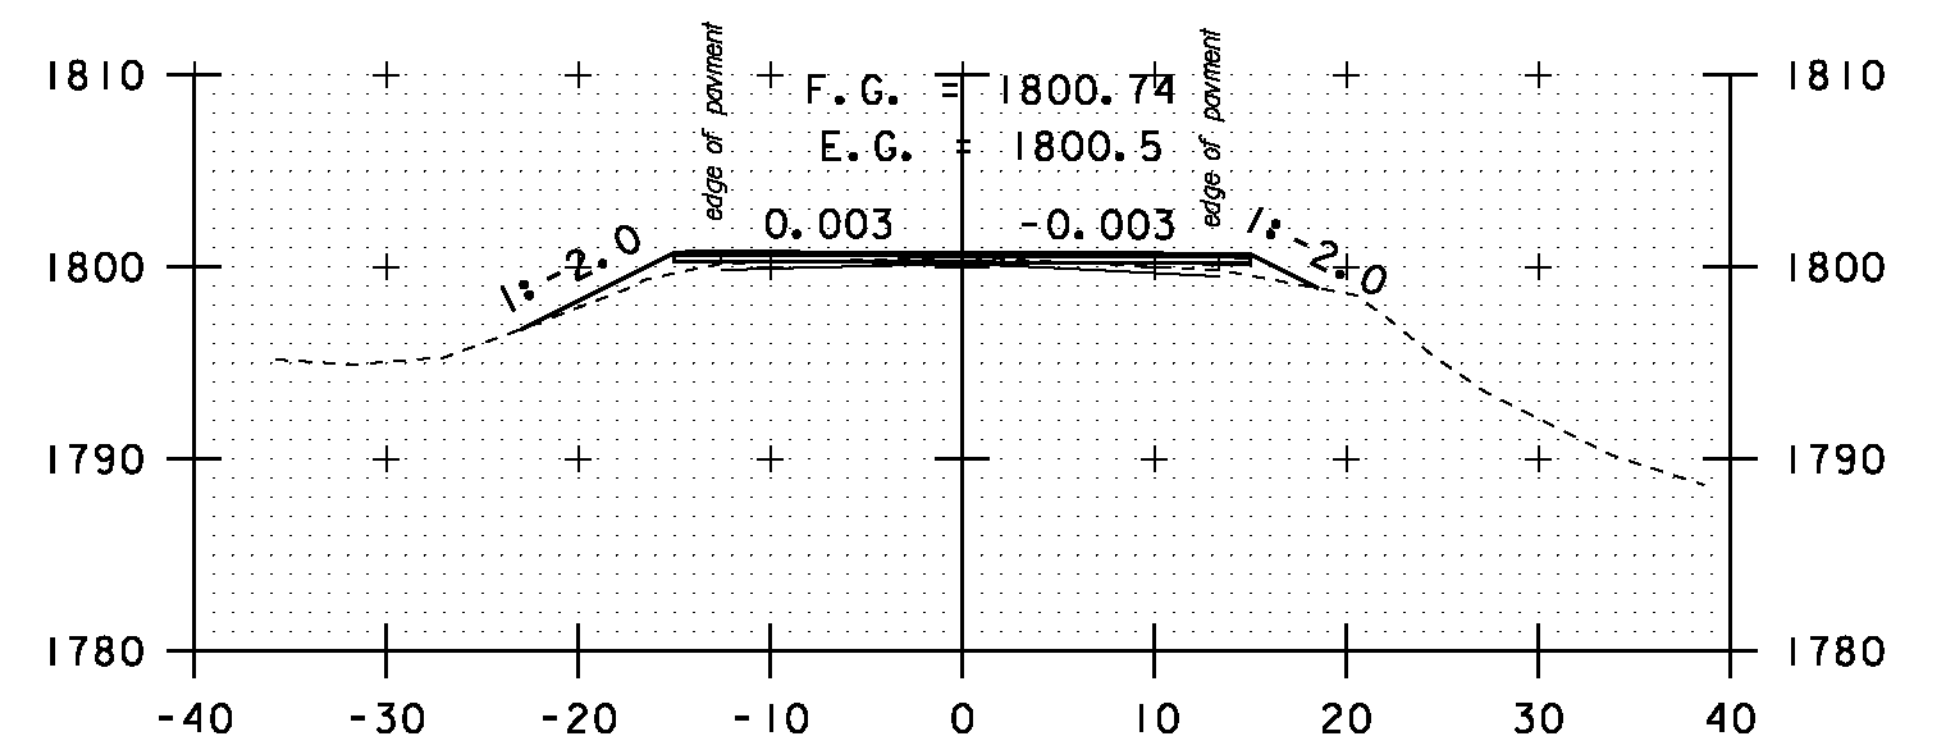

A 94+50

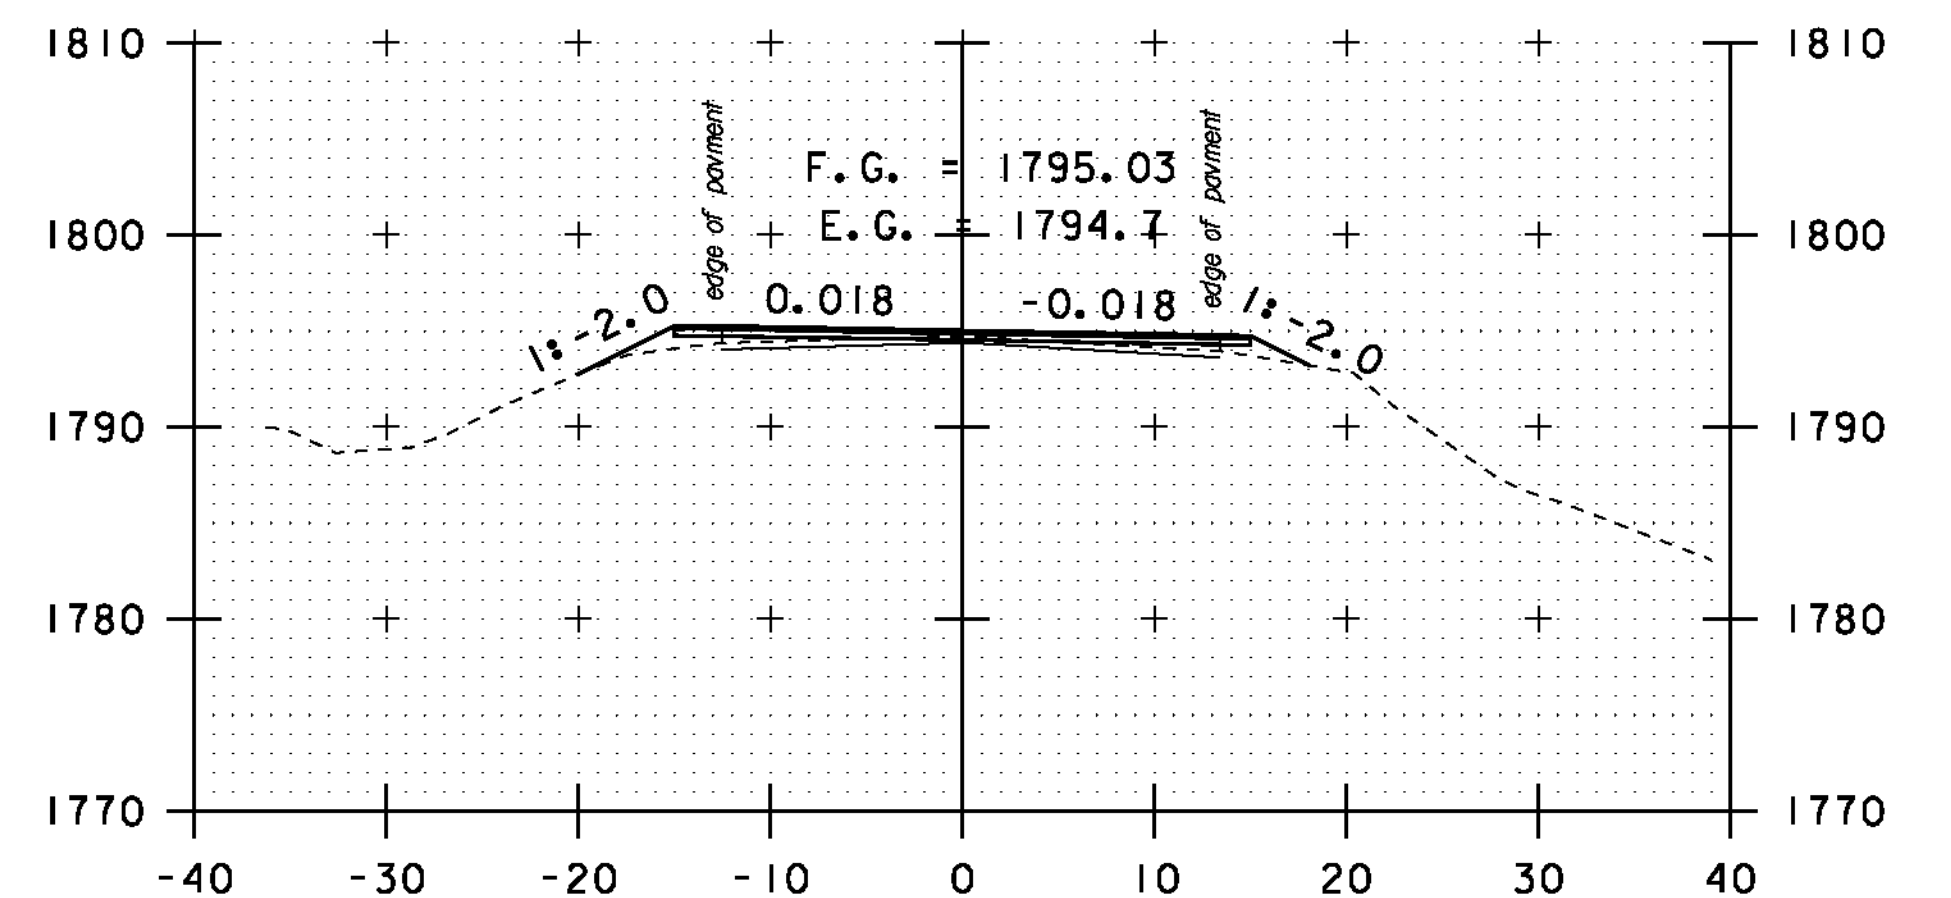

A 94+00

STA. A 91+00 TO STA. A 95+00



CROSS SECTION SHEET 54

PROJECT NAME: MONTGOMERY-WESTFIELD
 PROJECT NUMBER: STP 2906(I)
 FILE NAME: p10CI90.dgn
 PROJECT LEADER: CDL
 DESIGNED BY: SJL
 PLOT FILE: p10CI90_168.1
 PLOT DATE: 9/5/12
 DRAWN BY: SJL
 CHECKED BY: CDL
 SHEET 168 OF 178