




A 98+50

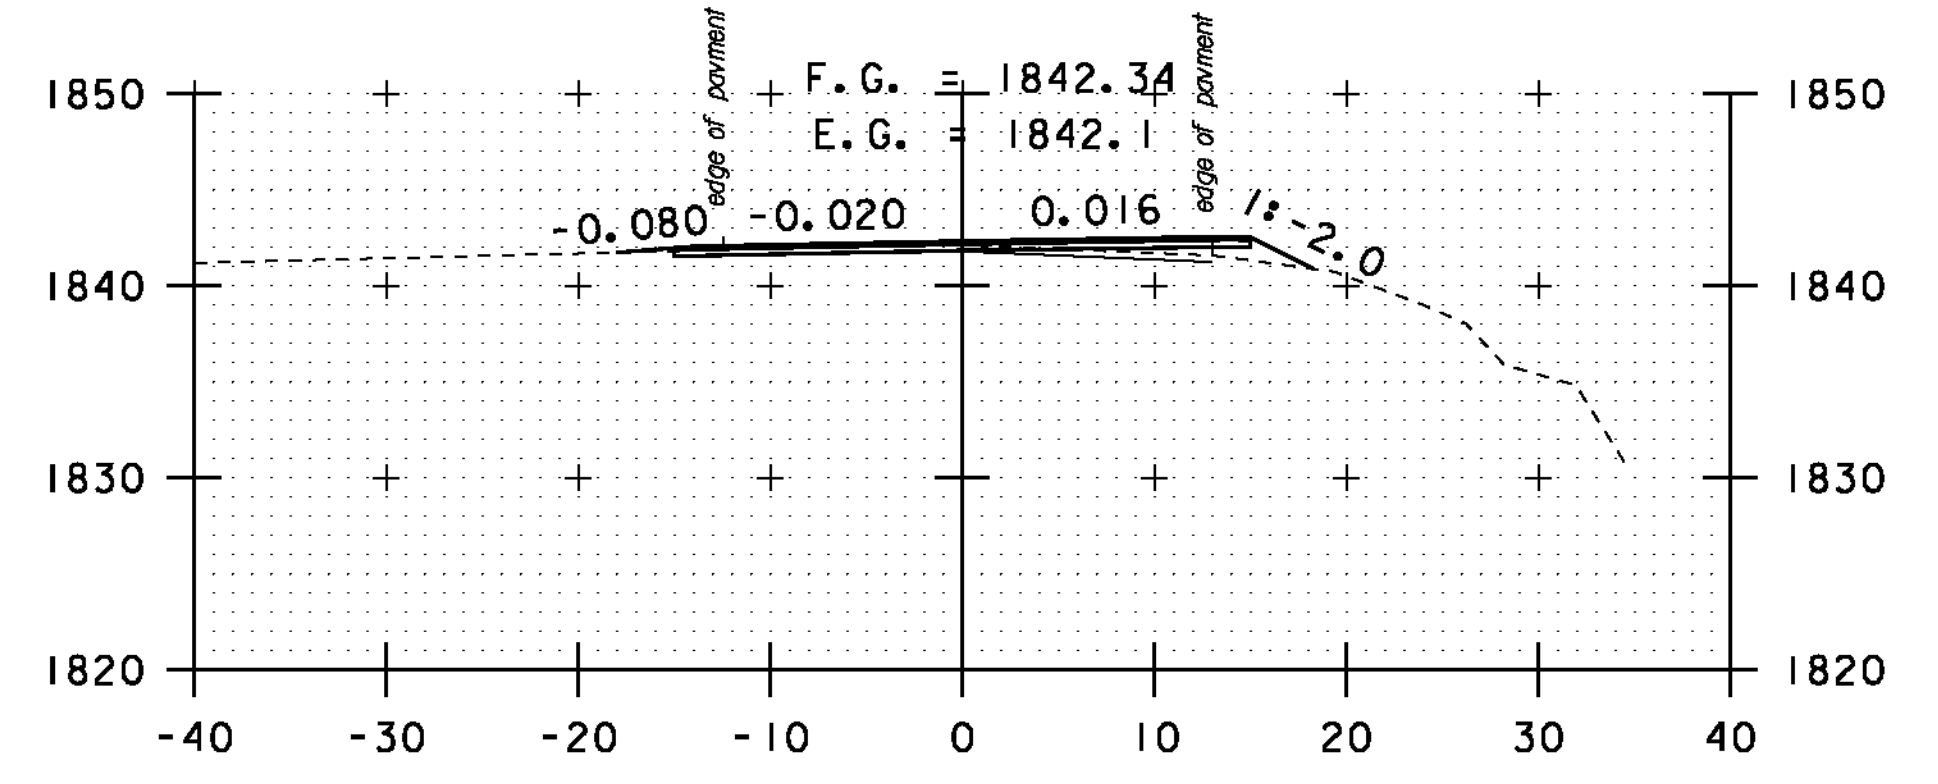


DRIVE LT  
A 100+00

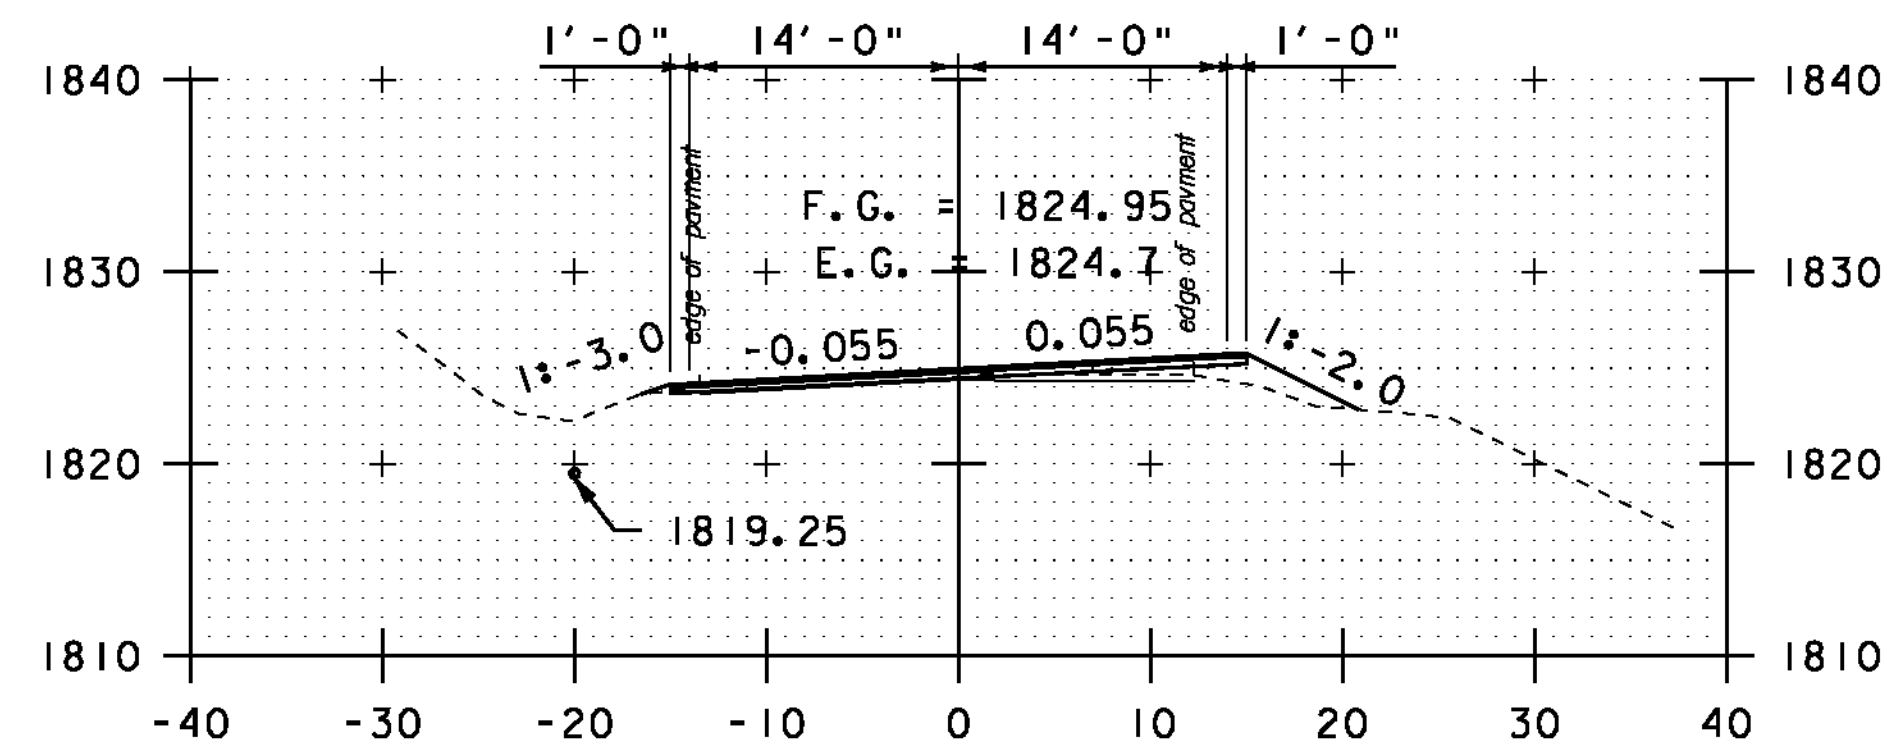


A 96+50

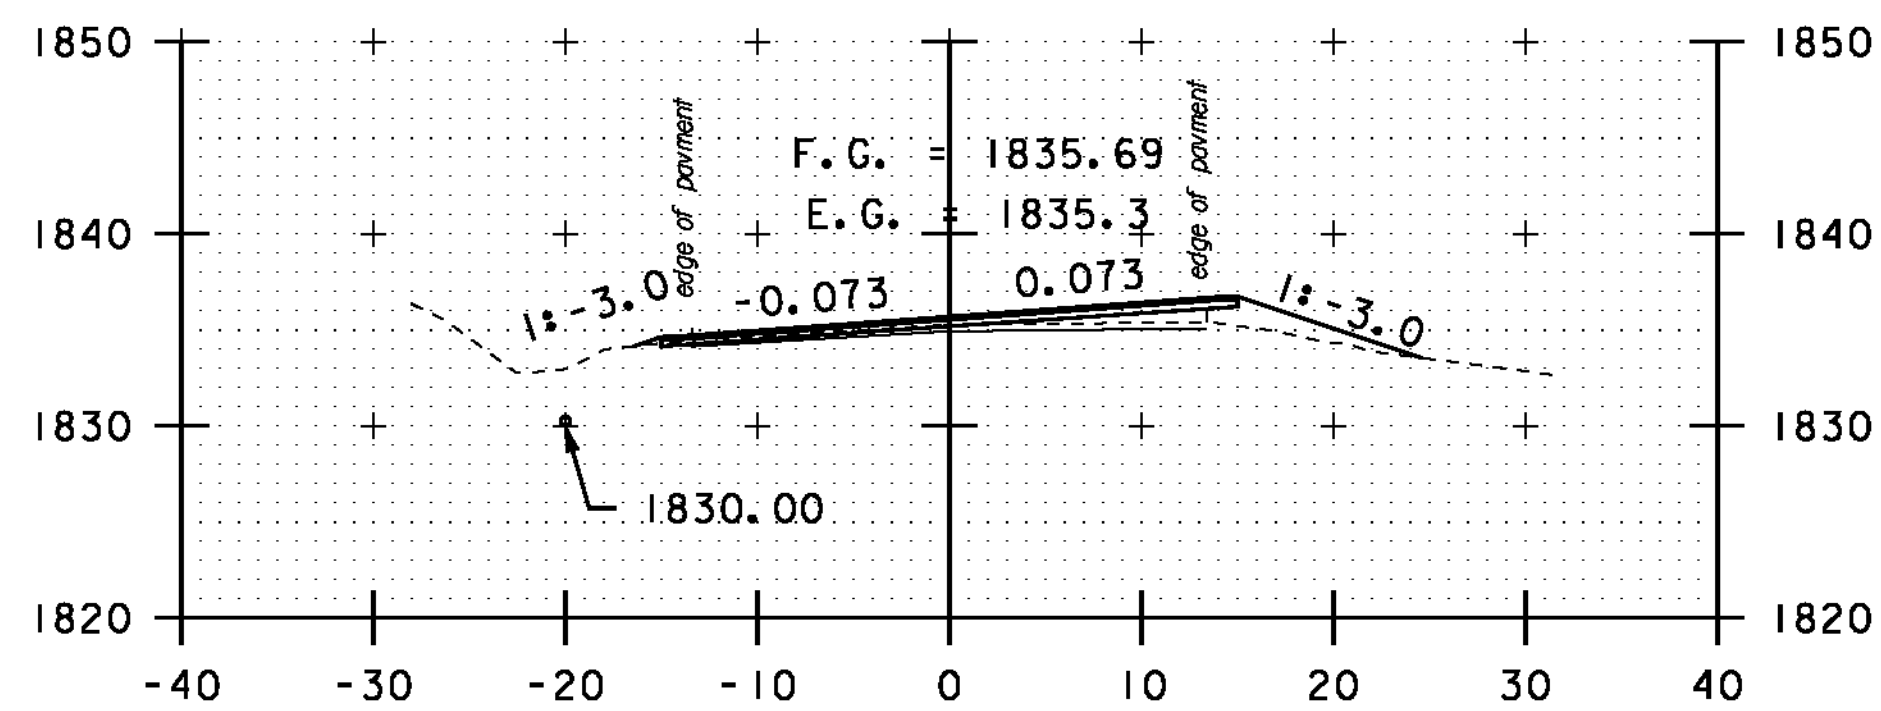


A 98+00

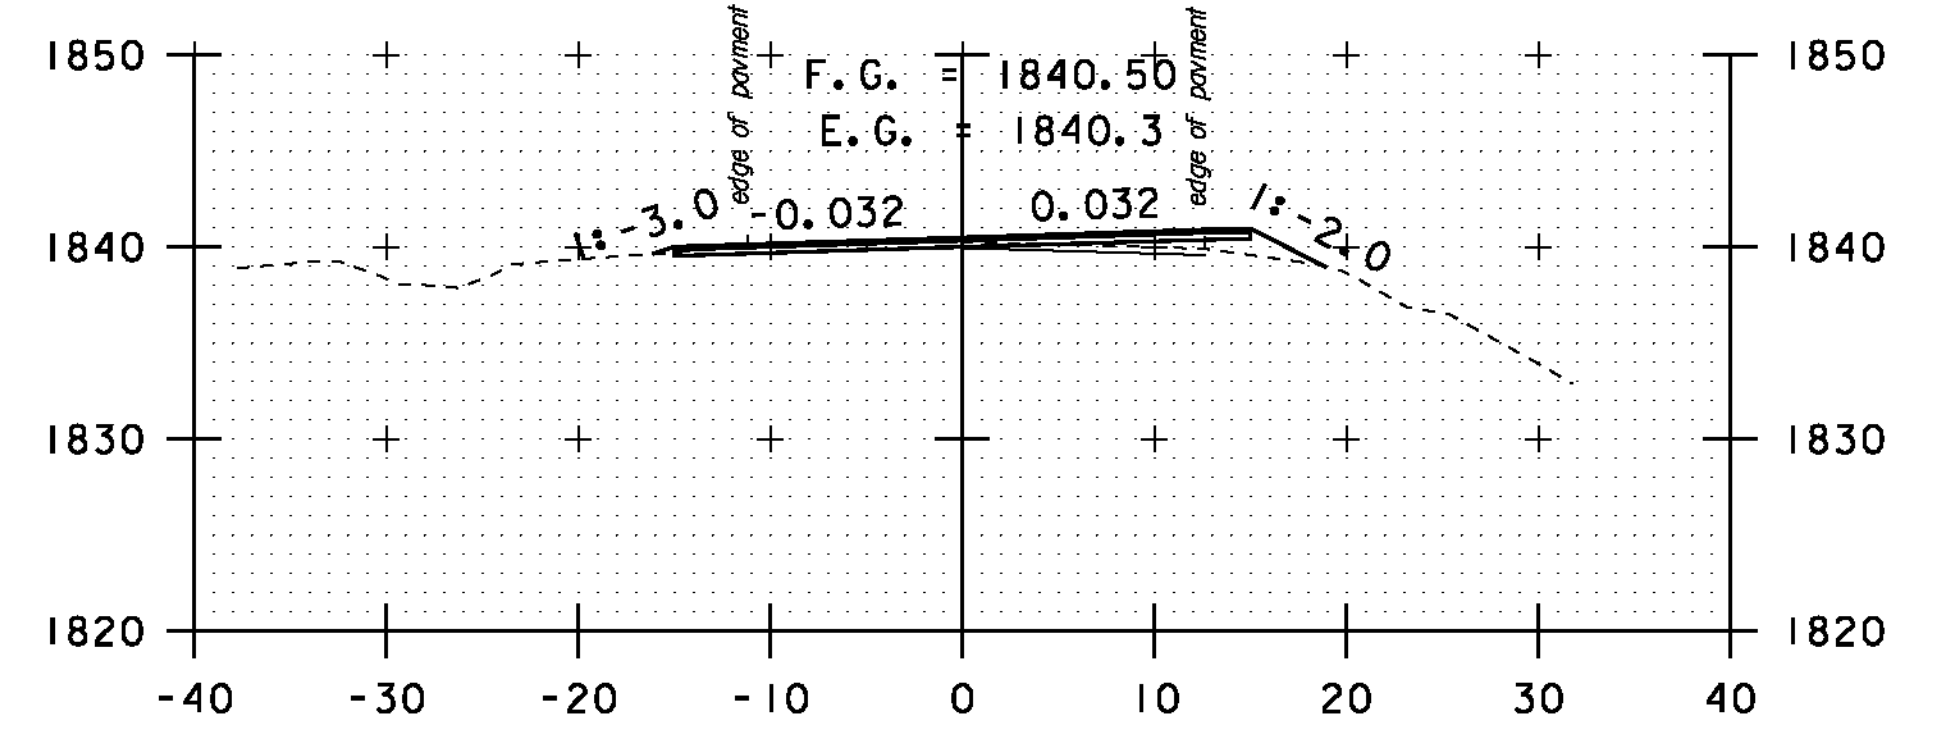


A 99+50

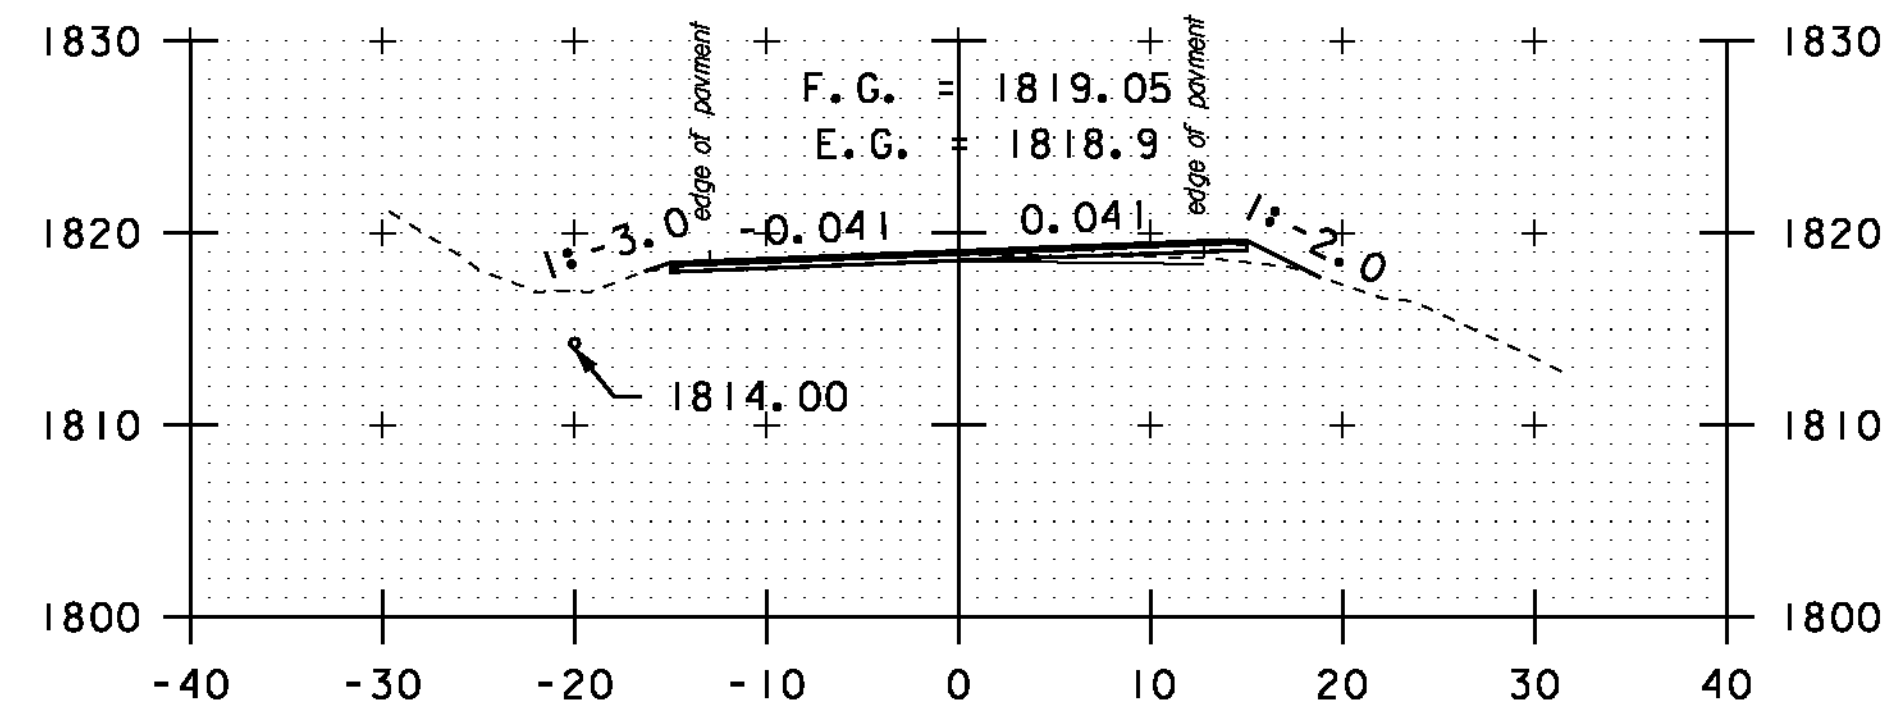


A 96+00

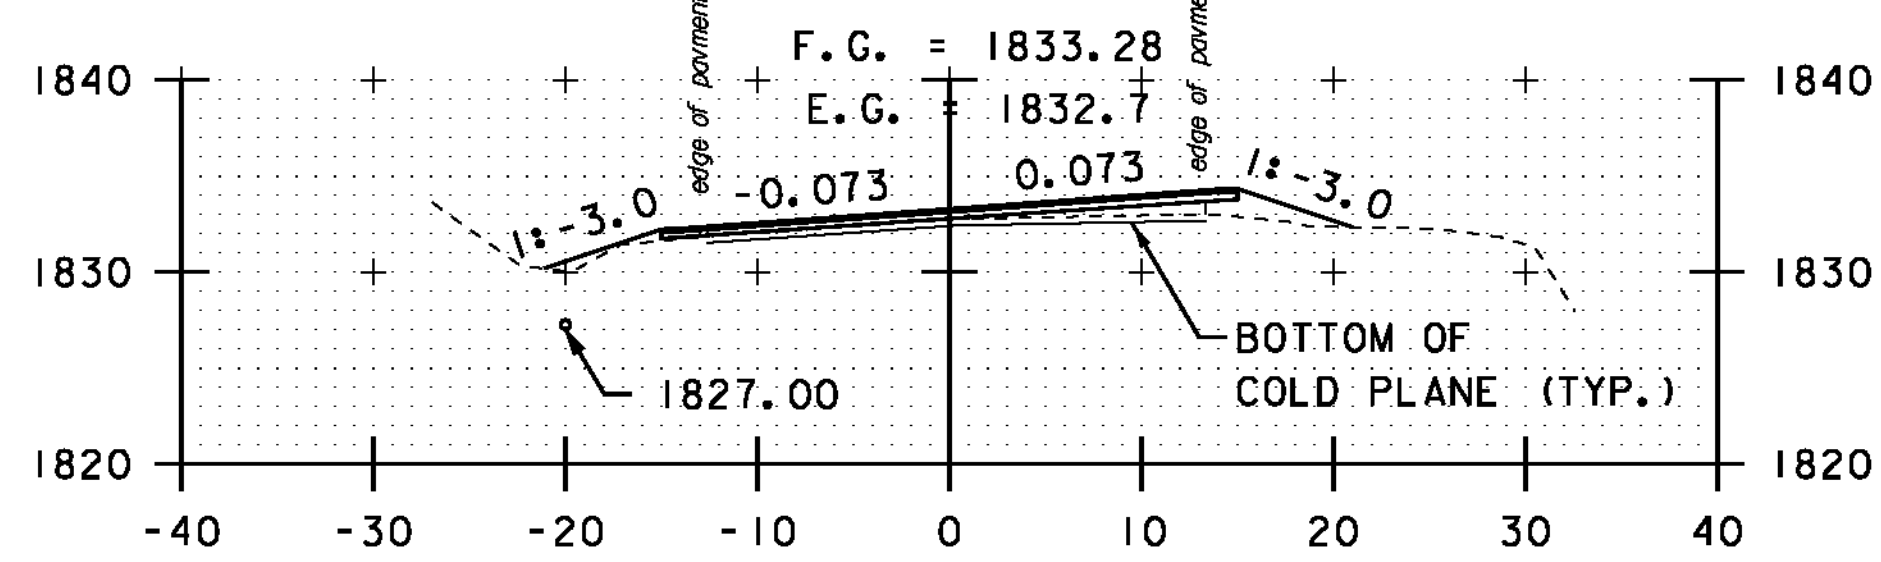


A 97+50

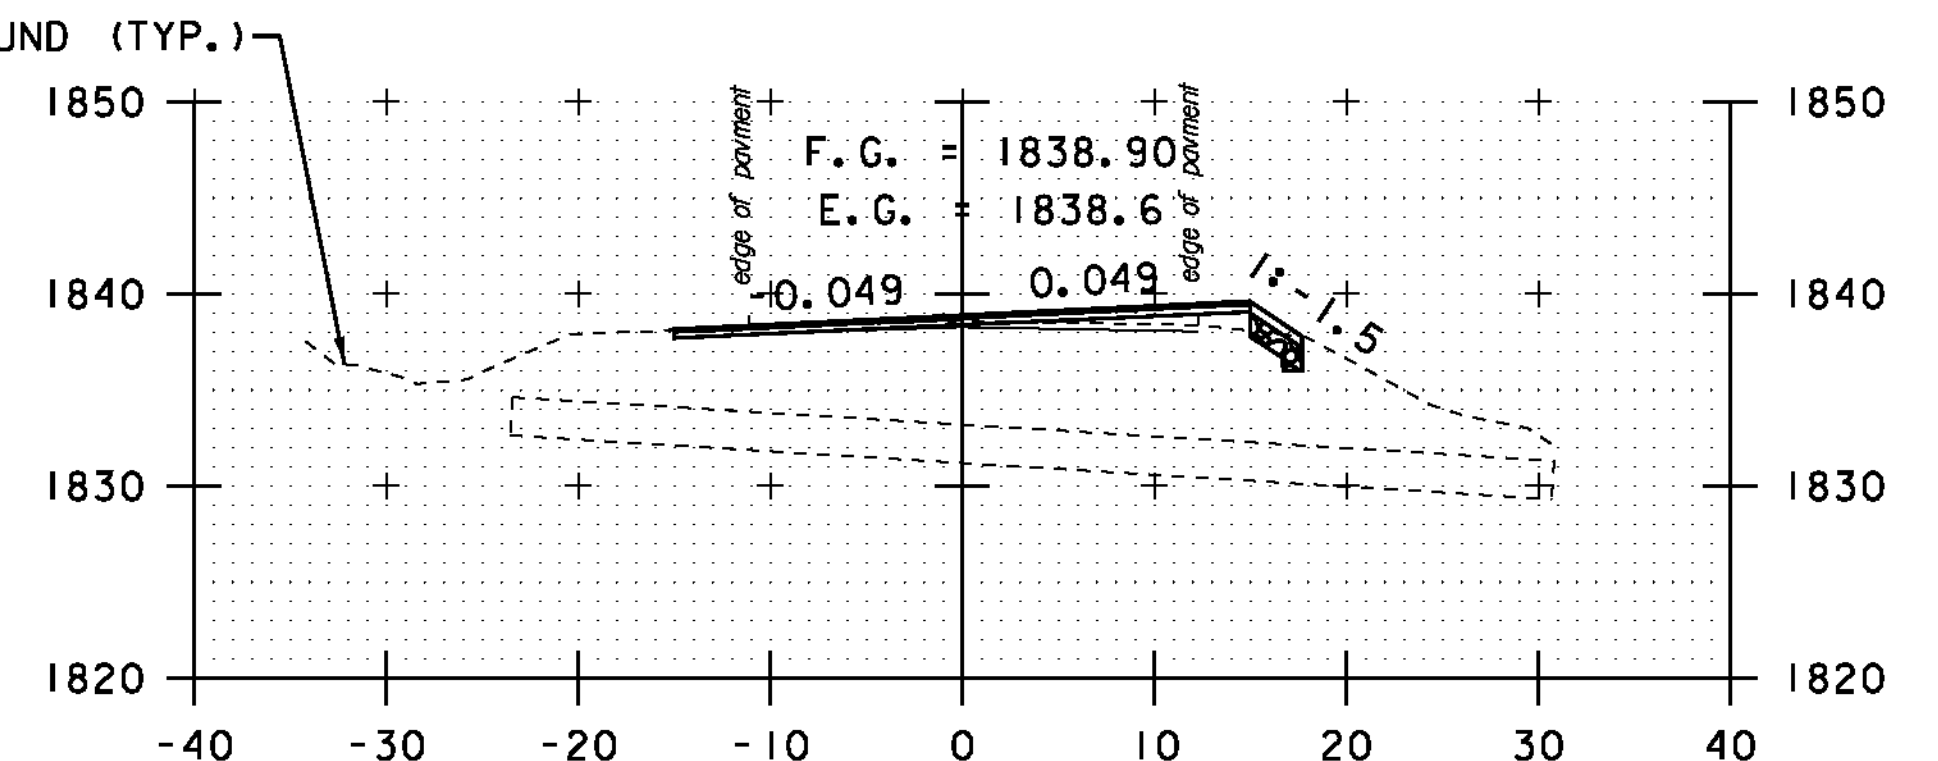

A 99+00

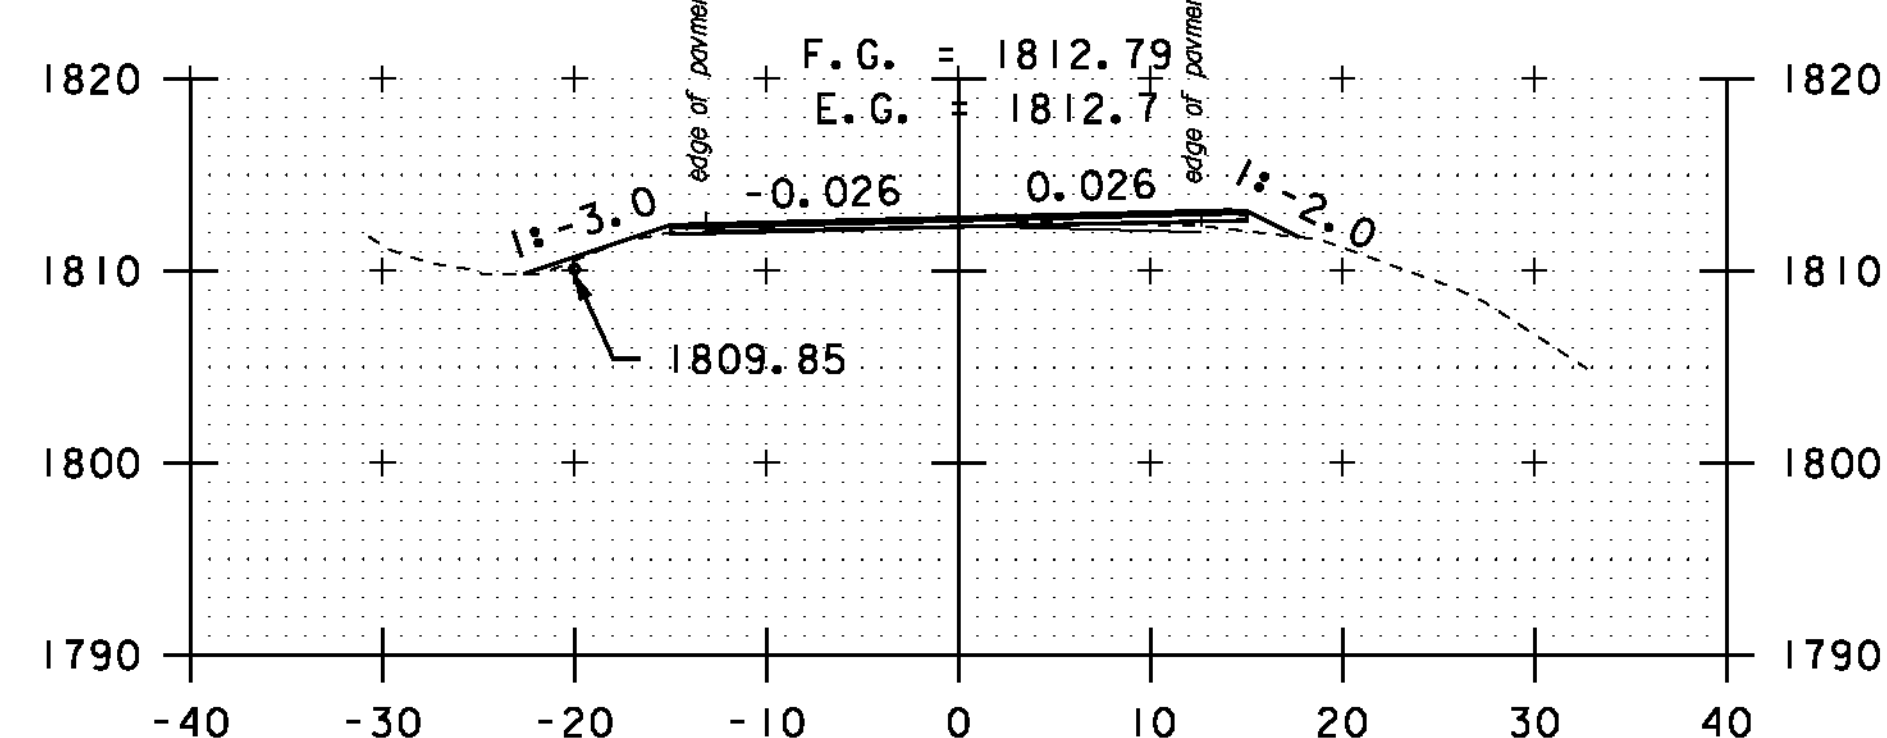


A 95+50

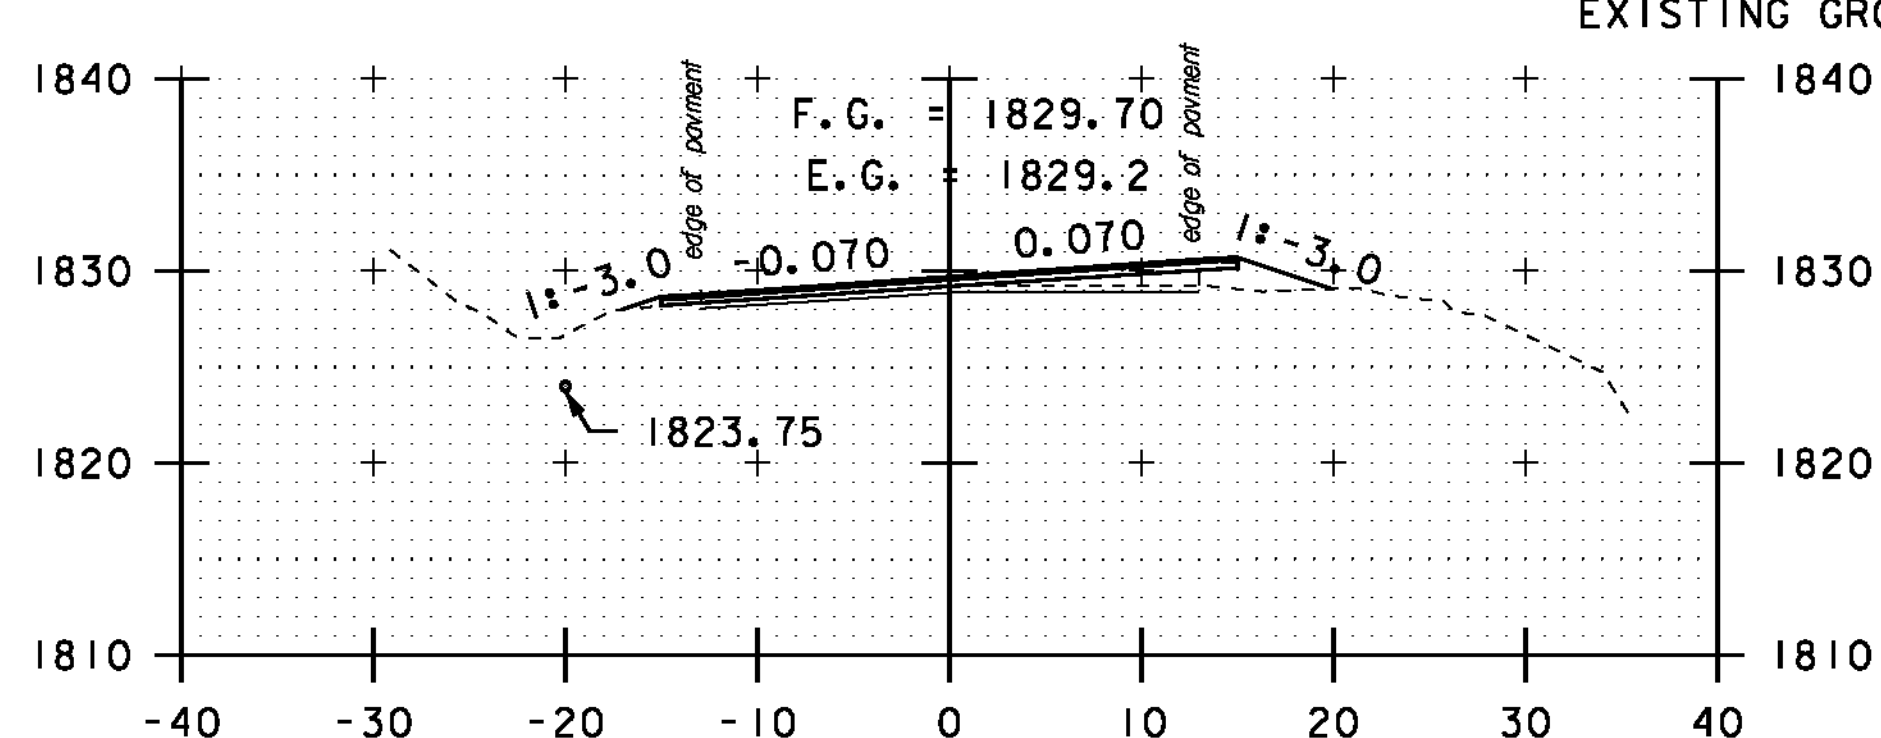

A 97+00

STA. A 95+50 TO STA. A 100+00

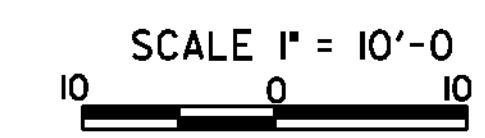

**CROSS SECTION SHEET 55**

PROJECT NAME:	MONTGOMERY-WESTFIELD
PROJECT NUMBER:	STP 2906(I)
FILE NAME:	p10CI90.dgn
PROJECT LEADER:	CDL
DESIGNED BY:	SJL
PLOT FILE:	p10CI90_169.r
PLOT DATE:	9/5/12
DRAWN BY:	SJL
CHECKED BY:	CDL
SHEET	169 OF 178