




A 103+50

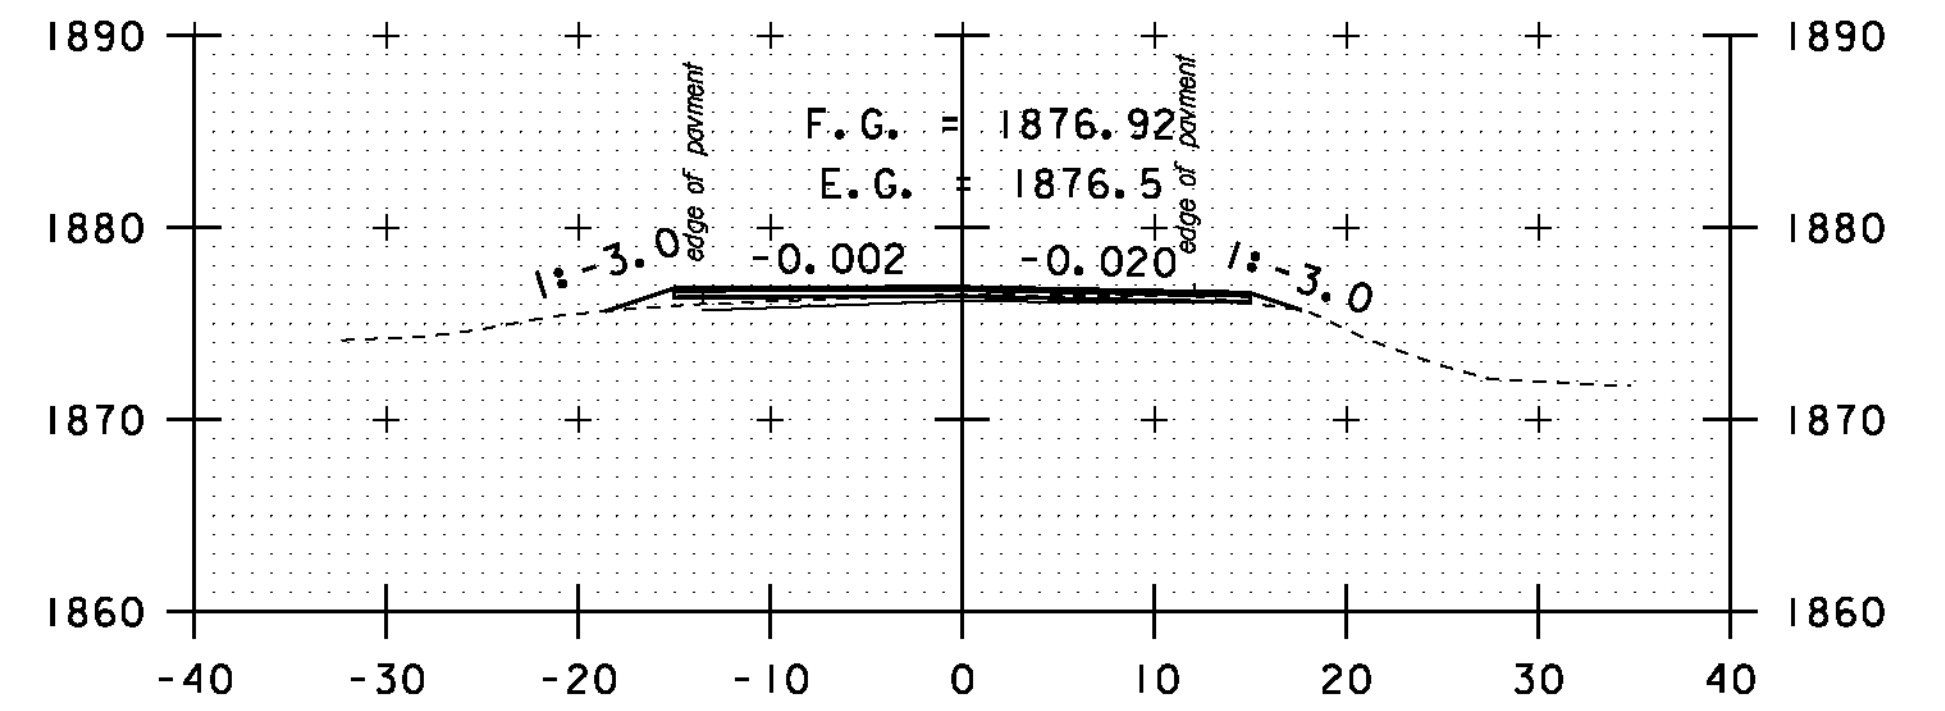


A 105+50

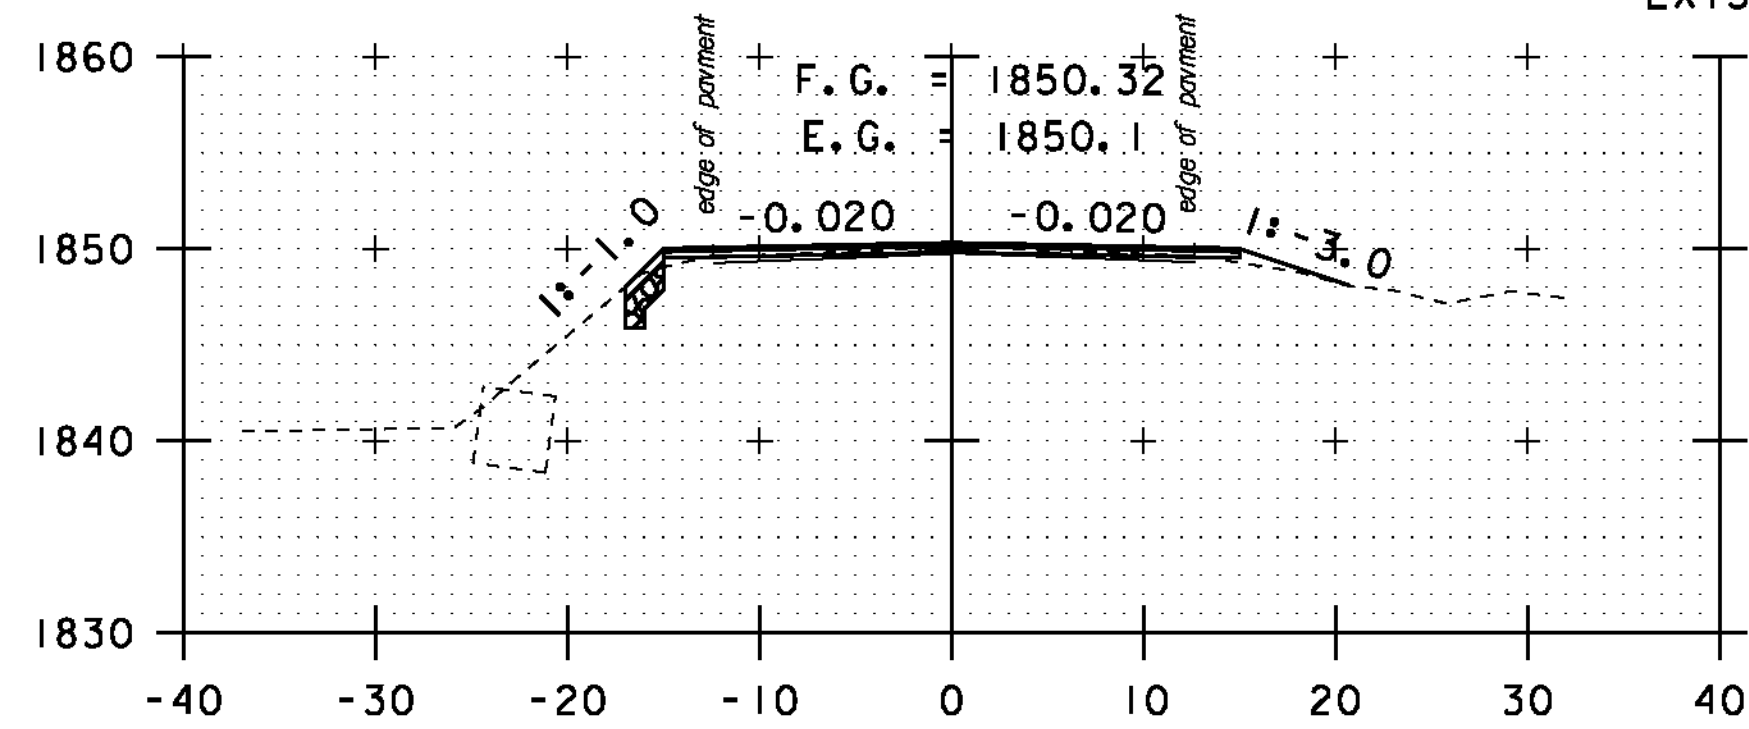


A 101+50

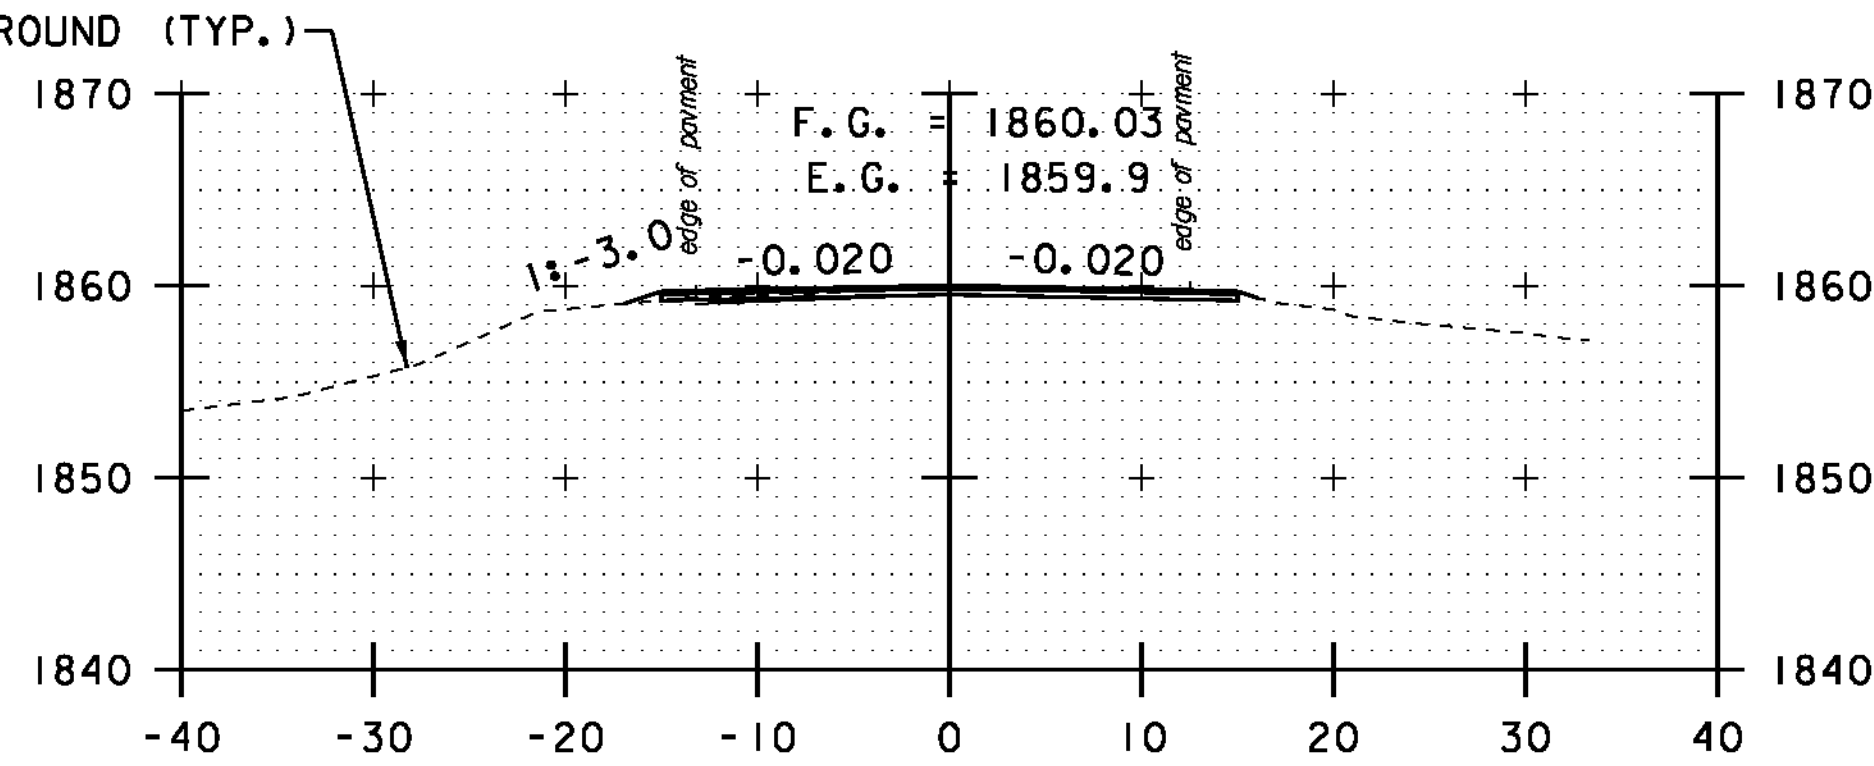


A 103+00

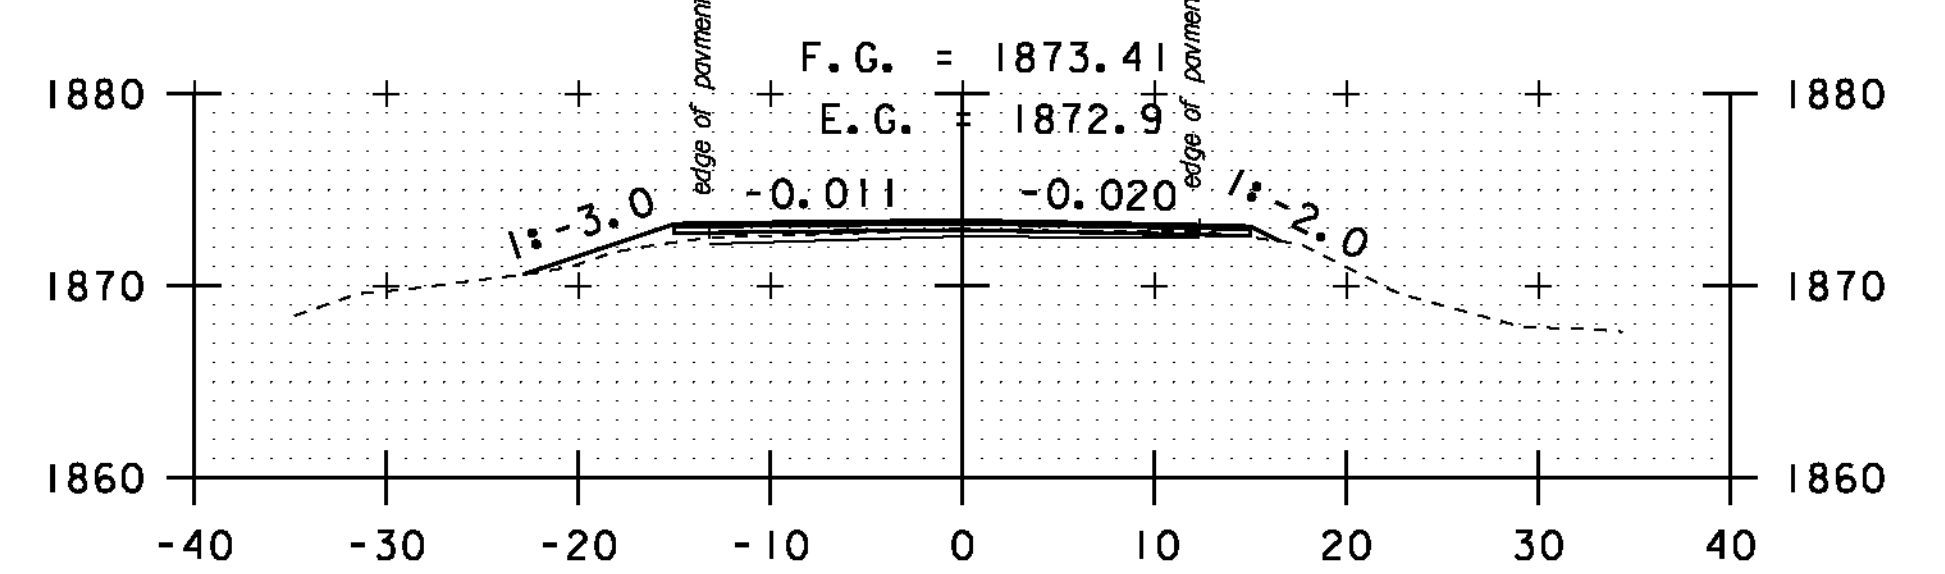


A 105+00

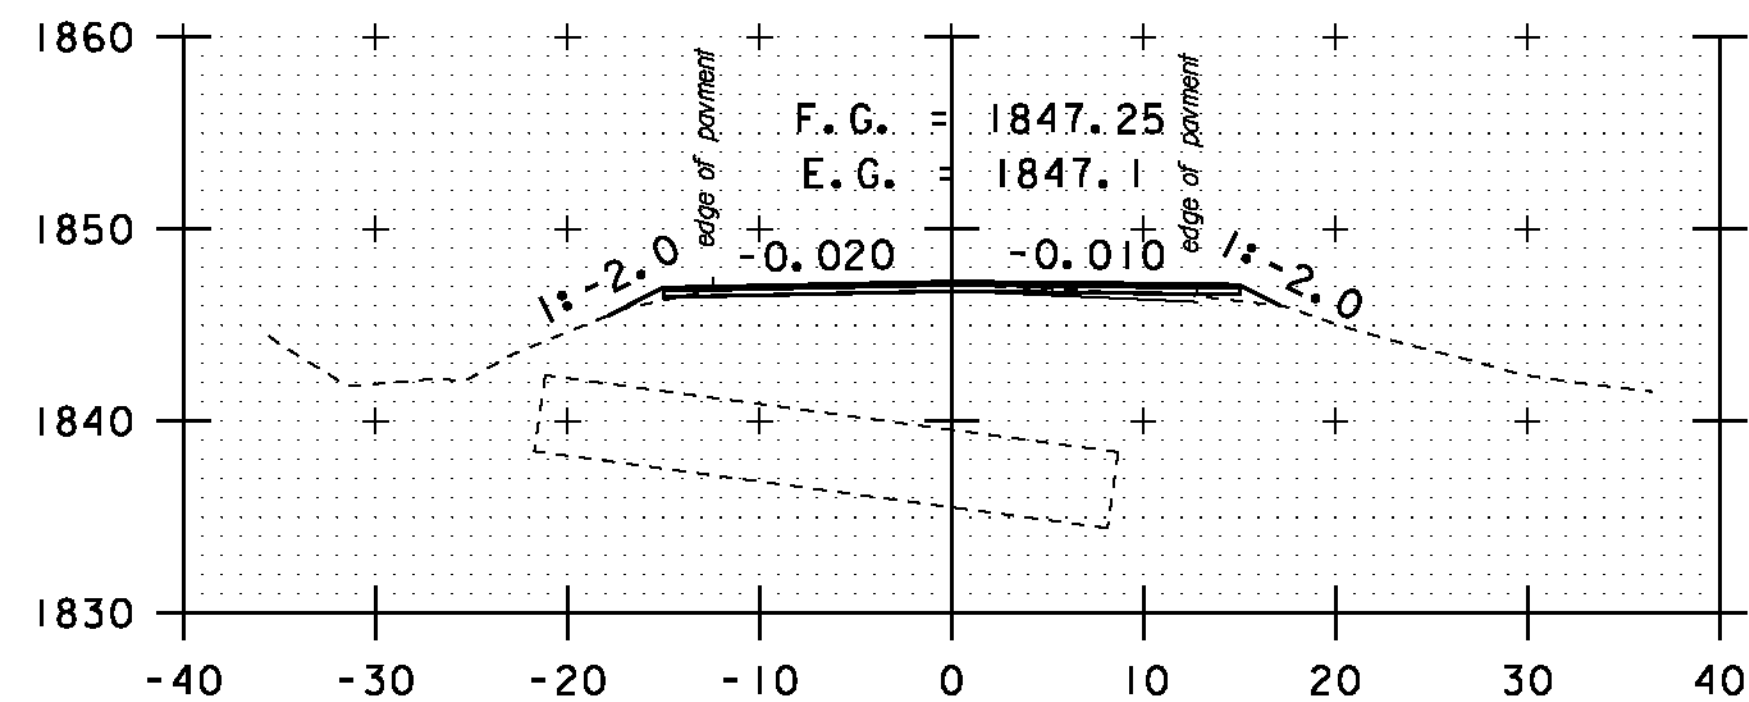


A 101+00

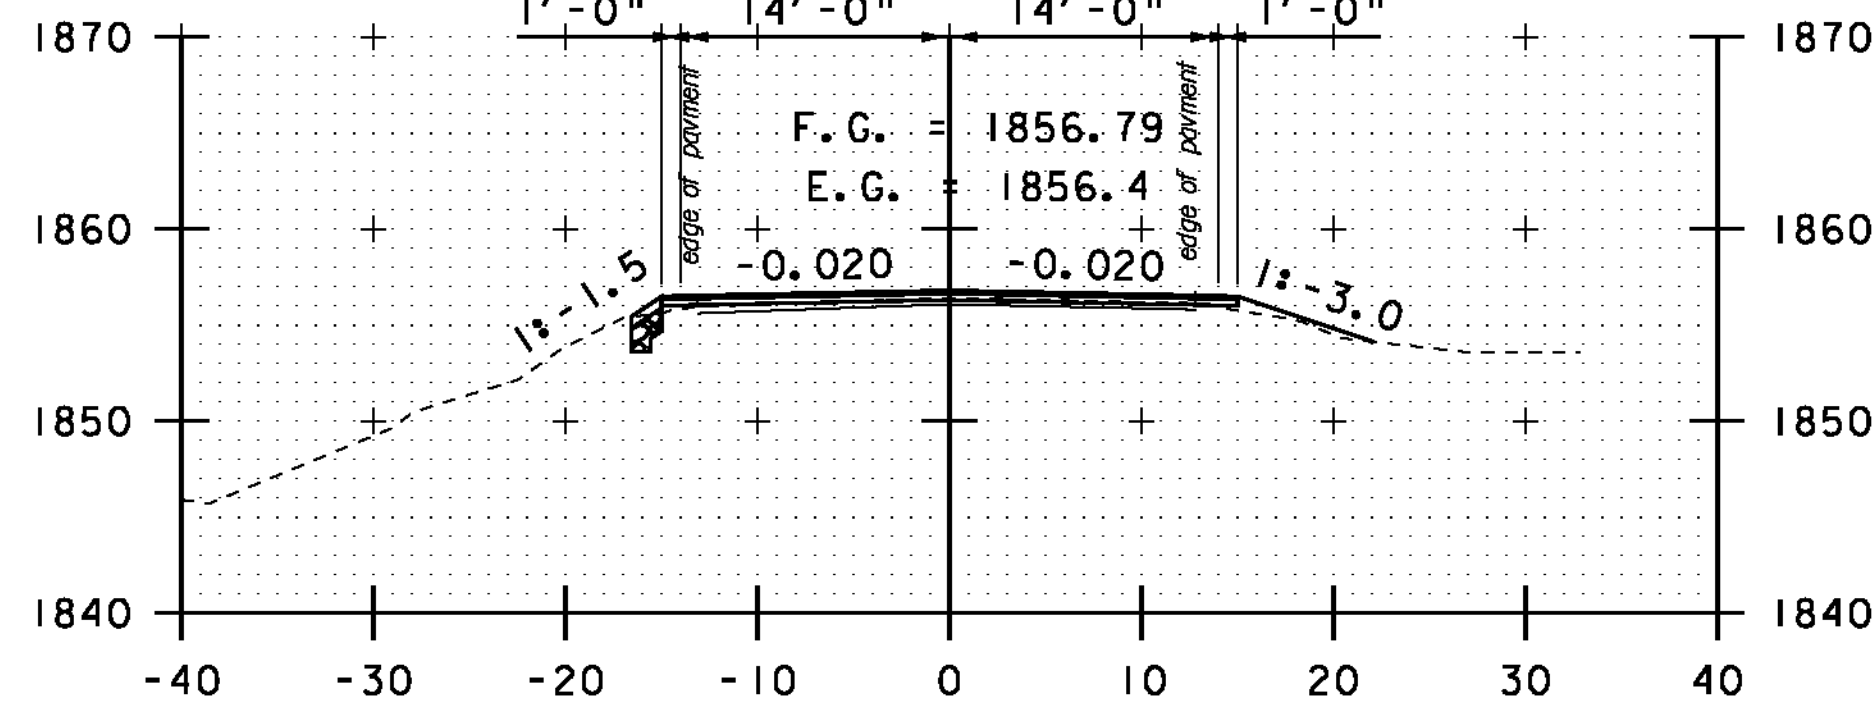


A 102+50

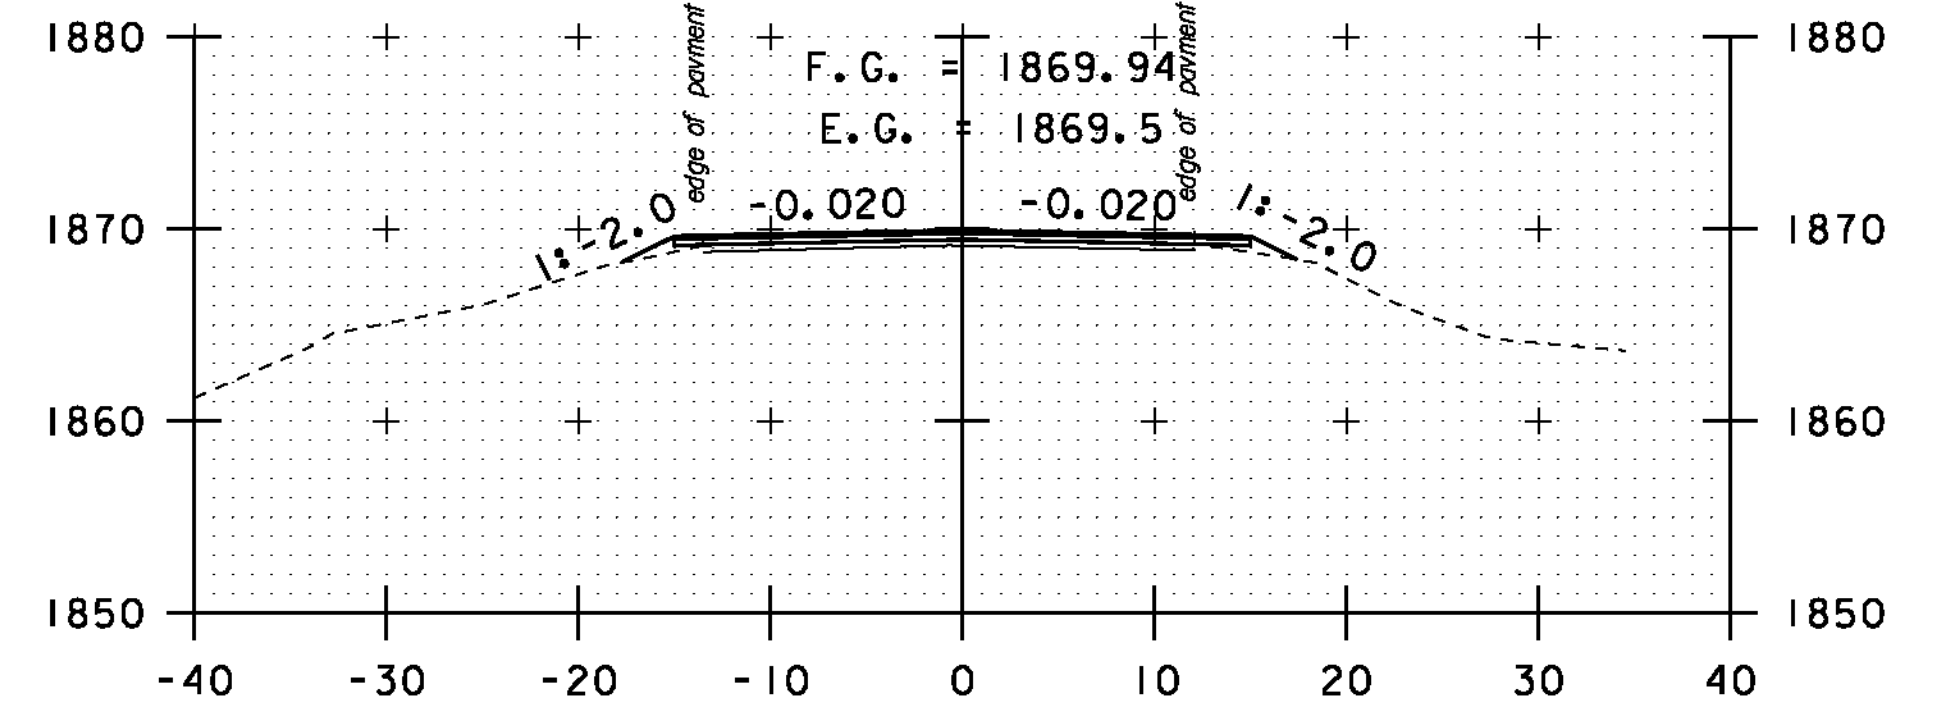


A 104+50

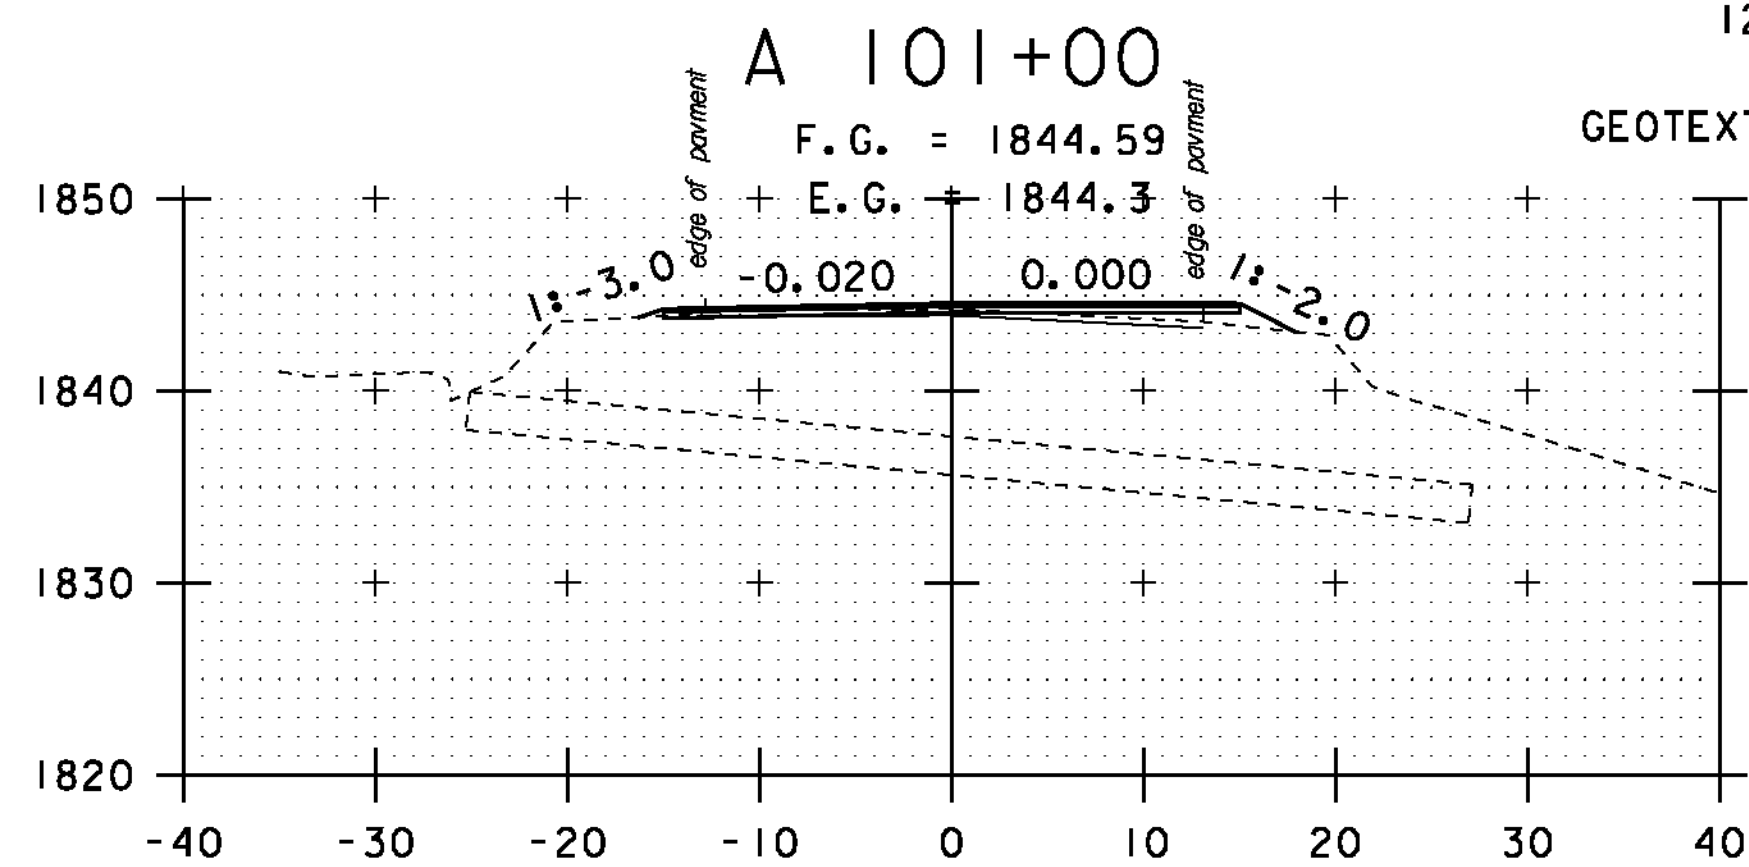

A 100+50

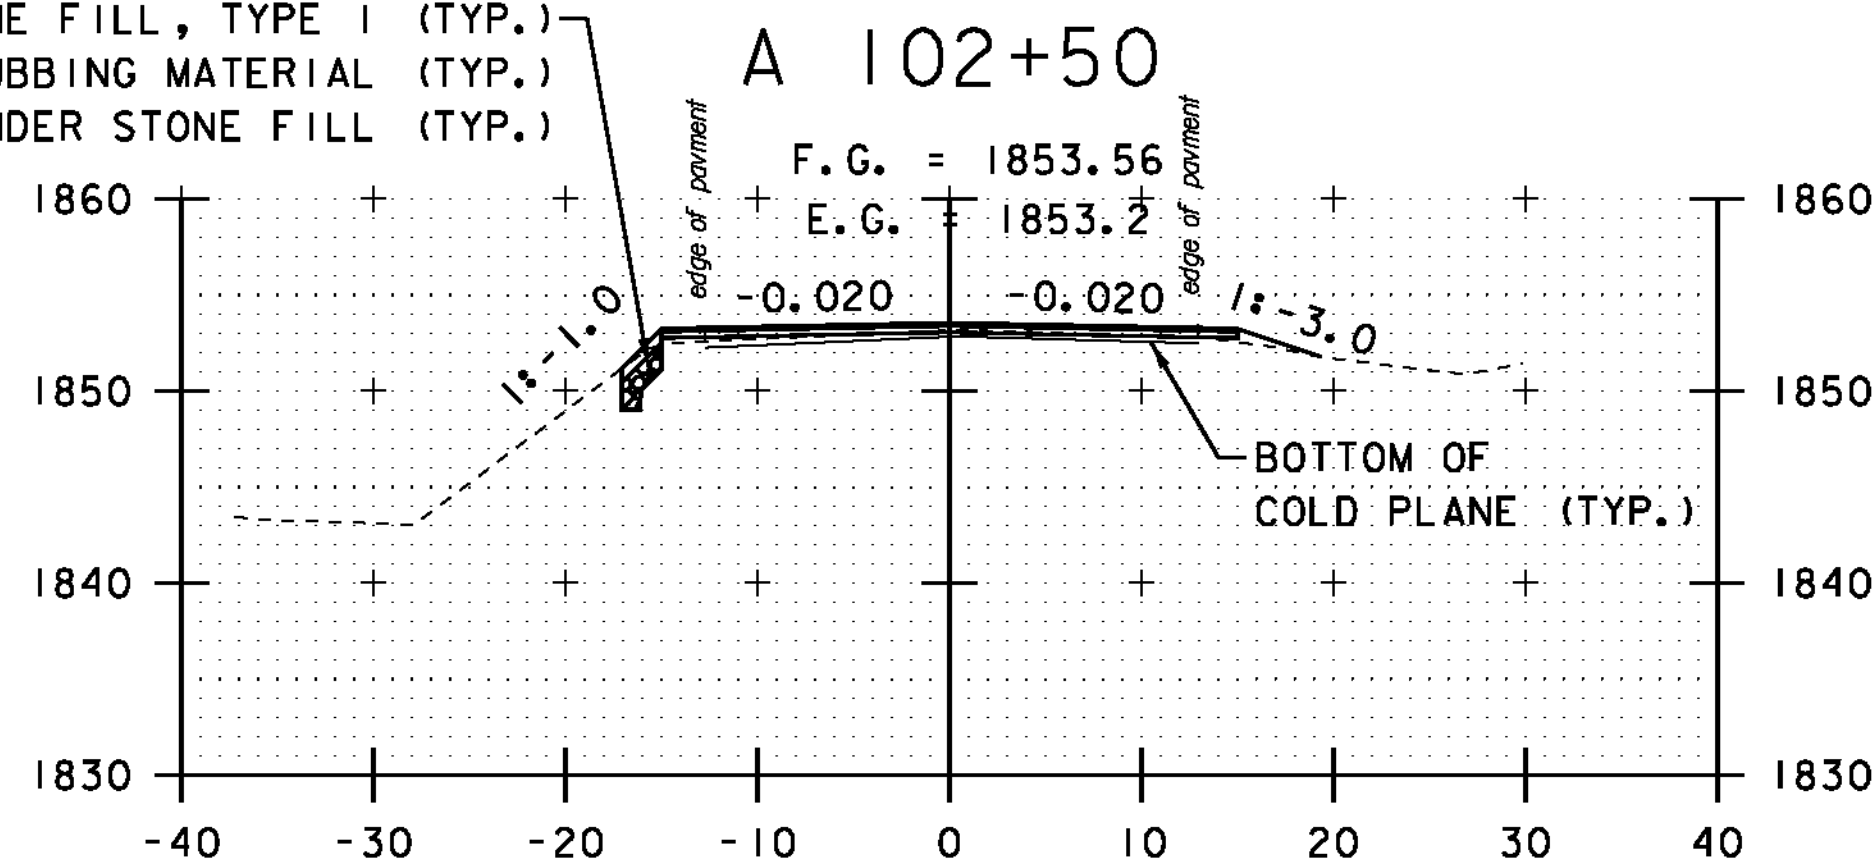

A 102+00

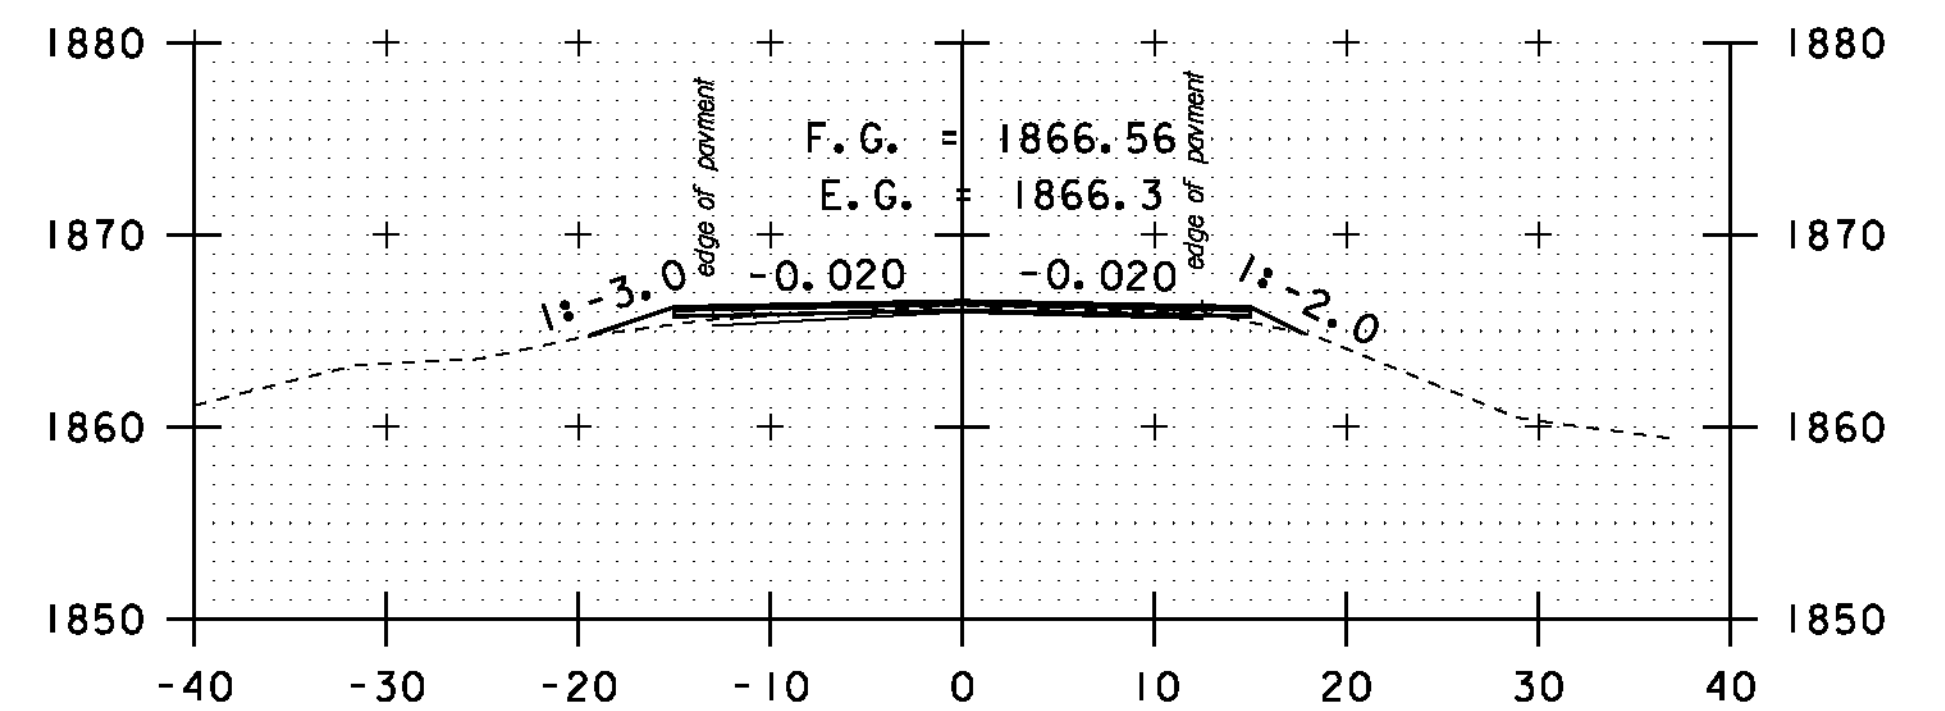

A 104+00

STA. A 100+50 TO STA. A 105+50



CROSS SECTION SHEET 56

PROJECT NAME: MONTGOMERY-WESTFIELD

PROJECT NUMBER: STP 2906(I)

FILE NAME: p10ci90.dgn

PROJECT LEADER: CDL

DESIGNED BY: SJL

PLOT FILE: p10ci90_170.l

PLOT DATE: 9/5/12

DRAWN BY: SJL

CHECKED BY: CDL

SHEET 170 OF 178